

Anschluss an 79319859
X= + 5155
Y= - 926
Z= +3596

45°
121MM Biegeradius
Z= +3842

45°
121MM Biegeradius
Z= +4116

85°
121MM Biegeradius
Z= +2200

80°
121MM Biegeradius
Z= +3691

85°
121MM Biegeradius
Z= +2436

121MM Biegeradius
Z= +1000

Anschluss an AS, 79320077
X= + 5875
Y= + 1550
Z= +1000

Essener Hochdruck-
Rohrleitungsbau
Original
10. OKT. 2005
ist in rot gestempelt


ESSENER HOCHDRUCK-
ROHRLEITUNGSBAU

AS BUILT 2005.06

Stückliste					
Lfd. Nr.	Benennung	DN (MM)	Sachnummer	Menge	Gewicht (kg)
1	ROHR 60,3 X 3,9 ALMG4,5MN W27	50	77038146	9799 MM	18.3
2	Bordscheibe gez. auf 79313040	50	79313042	1	0.6
Summe Masse					18.9

Rohrzuschnitt					
Rohr Stk.	Länge (MM)	DN (MM)	Bemerkung	Rohr Ende 1	Rohr Ende 2
<1>	134	50			
<2>	190	50	PLD BEND(1)		
<3>	325	50			
<4>	168	50	PLD BEND(1)		
<5>	95	50	PLD BEND(1)		
<6>	288	50			
<7>	94	50	PLD BEND(1)		
<8>	488	50			
<9>	189	50	PLD BEND(1)		
<10>	922	50			
<11>	189	50	PLD BEND(1)		
<12>	2107	50			
<13>	180	50	PLD BEND(1)		
<14>	2489	50			
<15>	178	50	PLD BEND(1)		
<16>	969	50			
<17>	190	50	PLD BEND(1)		
<18>	221	50			
<19>	189	50	PLD BEND(1)		
<20>	194	50			

pipng support, piping guides
View from top

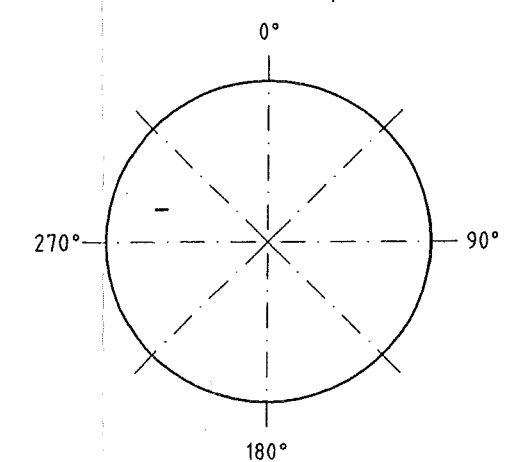

Rohr DN (MM) 50
CL Länge (MM) 9799

MATERIAL: HANAU AL			All components cleaned for oxygen		
Workpiece edges: 1-0.5 outside, 1+0.3 inside			TOLERANCES: DN 28005, DN 8570, DN 7168 mittel		
DATE: 10.08.2005			Similar: MASS kg		
NAME: H.Schneider			Subst: Replaced:		
CHECK: Frickhöfer 10/08/05			AIR LIQUIDE		
JOB CODE / REFERENCE: K70101, ASU No.9 Kosice			SHEET: 1 OF SHEET: 1		
Title: NL 23010			DRAWING No: 79319781		