
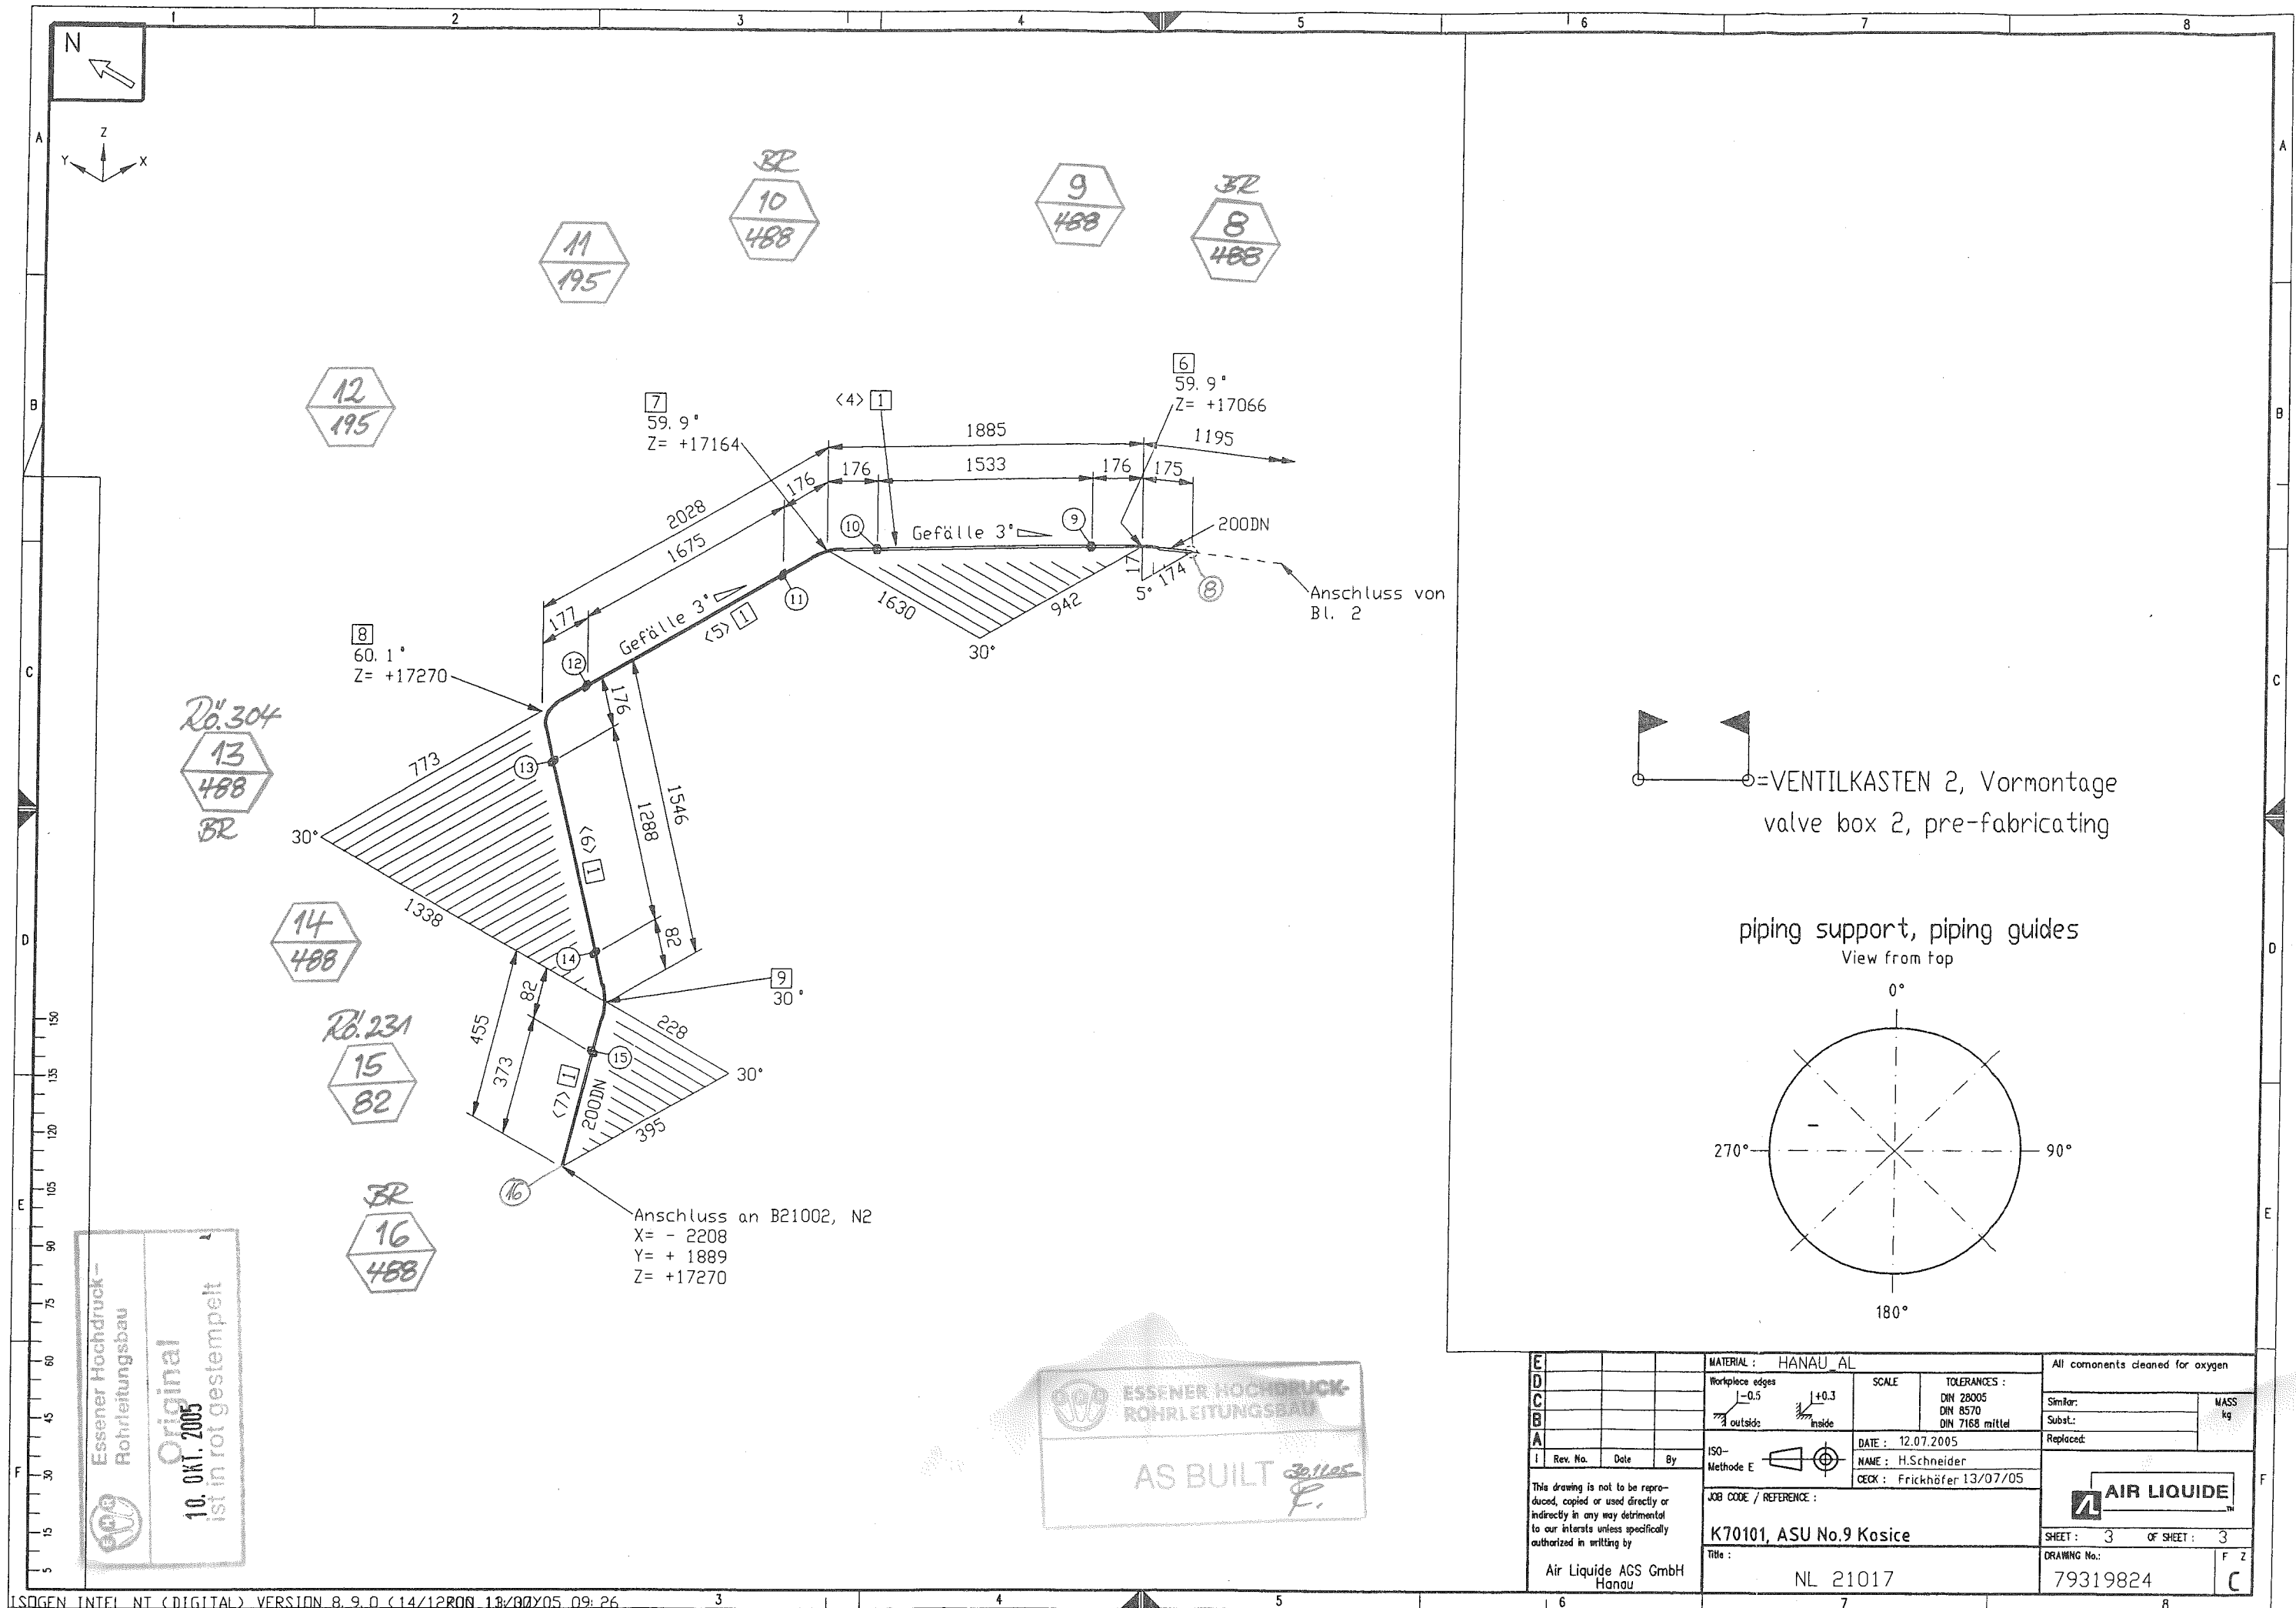
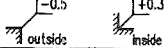


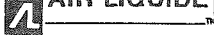

Essener Hochdruck-  
Rohrleitungsbau  
Original  
10. Okt. 2005  
ist in rot gestempelt

ESSENER HOCHDRUCK-  
ROHRLEITUNGSBAU  
AS BUILT

|                                                                                                                                                                                                       |          |      |    |                                                                                                          |                                   |                                                                                       |          |            |
|-------------------------------------------------------------------------------------------------------------------------------------------------------------------------------------------------------|----------|------|----|----------------------------------------------------------------------------------------------------------|-----------------------------------|---------------------------------------------------------------------------------------|----------|------------|
| E                                                                                                                                                                                                     |          |      |    | MATERIAL : HANAU AL                                                                                      | All components cleaned for oxygen |                                                                                       |          |            |
| D                                                                                                                                                                                                     |          |      |    | Workpiece edges<br> | SCALE                             | TOLERANCES :<br>DIN 28005<br>DIN 8570<br>DIN 7168 mittel                              | Similar: | MASS<br>kg |
| C                                                                                                                                                                                                     |          |      |    |                                                                                                          | DATE : 12.07.2005                 | NAME : H.Schneider                                                                    | Subst.:  |            |
| B                                                                                                                                                                                                     |          |      |    | ISO-<br>Methode E   | CECK : Frickhöfer 13/07/05        | Replaced:                                                                             |          |            |
| A                                                                                                                                                                                                     |          |      |    | JOB CODE / REFERENCE :<br><br>K70101, ASU No.9 Kosice                                                    |                                   |  |          |            |
| I                                                                                                                                                                                                     | Rev. No. | Date | By | Title :<br><br>NL 21017                                                                                  |                                   |                                                                                       |          |            |
| This drawing is not to be reproduced, copied or used directly or indirectly in any way detrimental to our interests unless specifically authorized in writing by<br><br>Air Liquide AGS GmbH<br>Hanau |          |      |    | DRAWING No.:                                                                                             |                                   | F Z                                                                                   |          |            |
|                                                                                                                                                                                                       |          |      |    | 79319824                                                                                                 |                                   | C                                                                                     |          |            |