



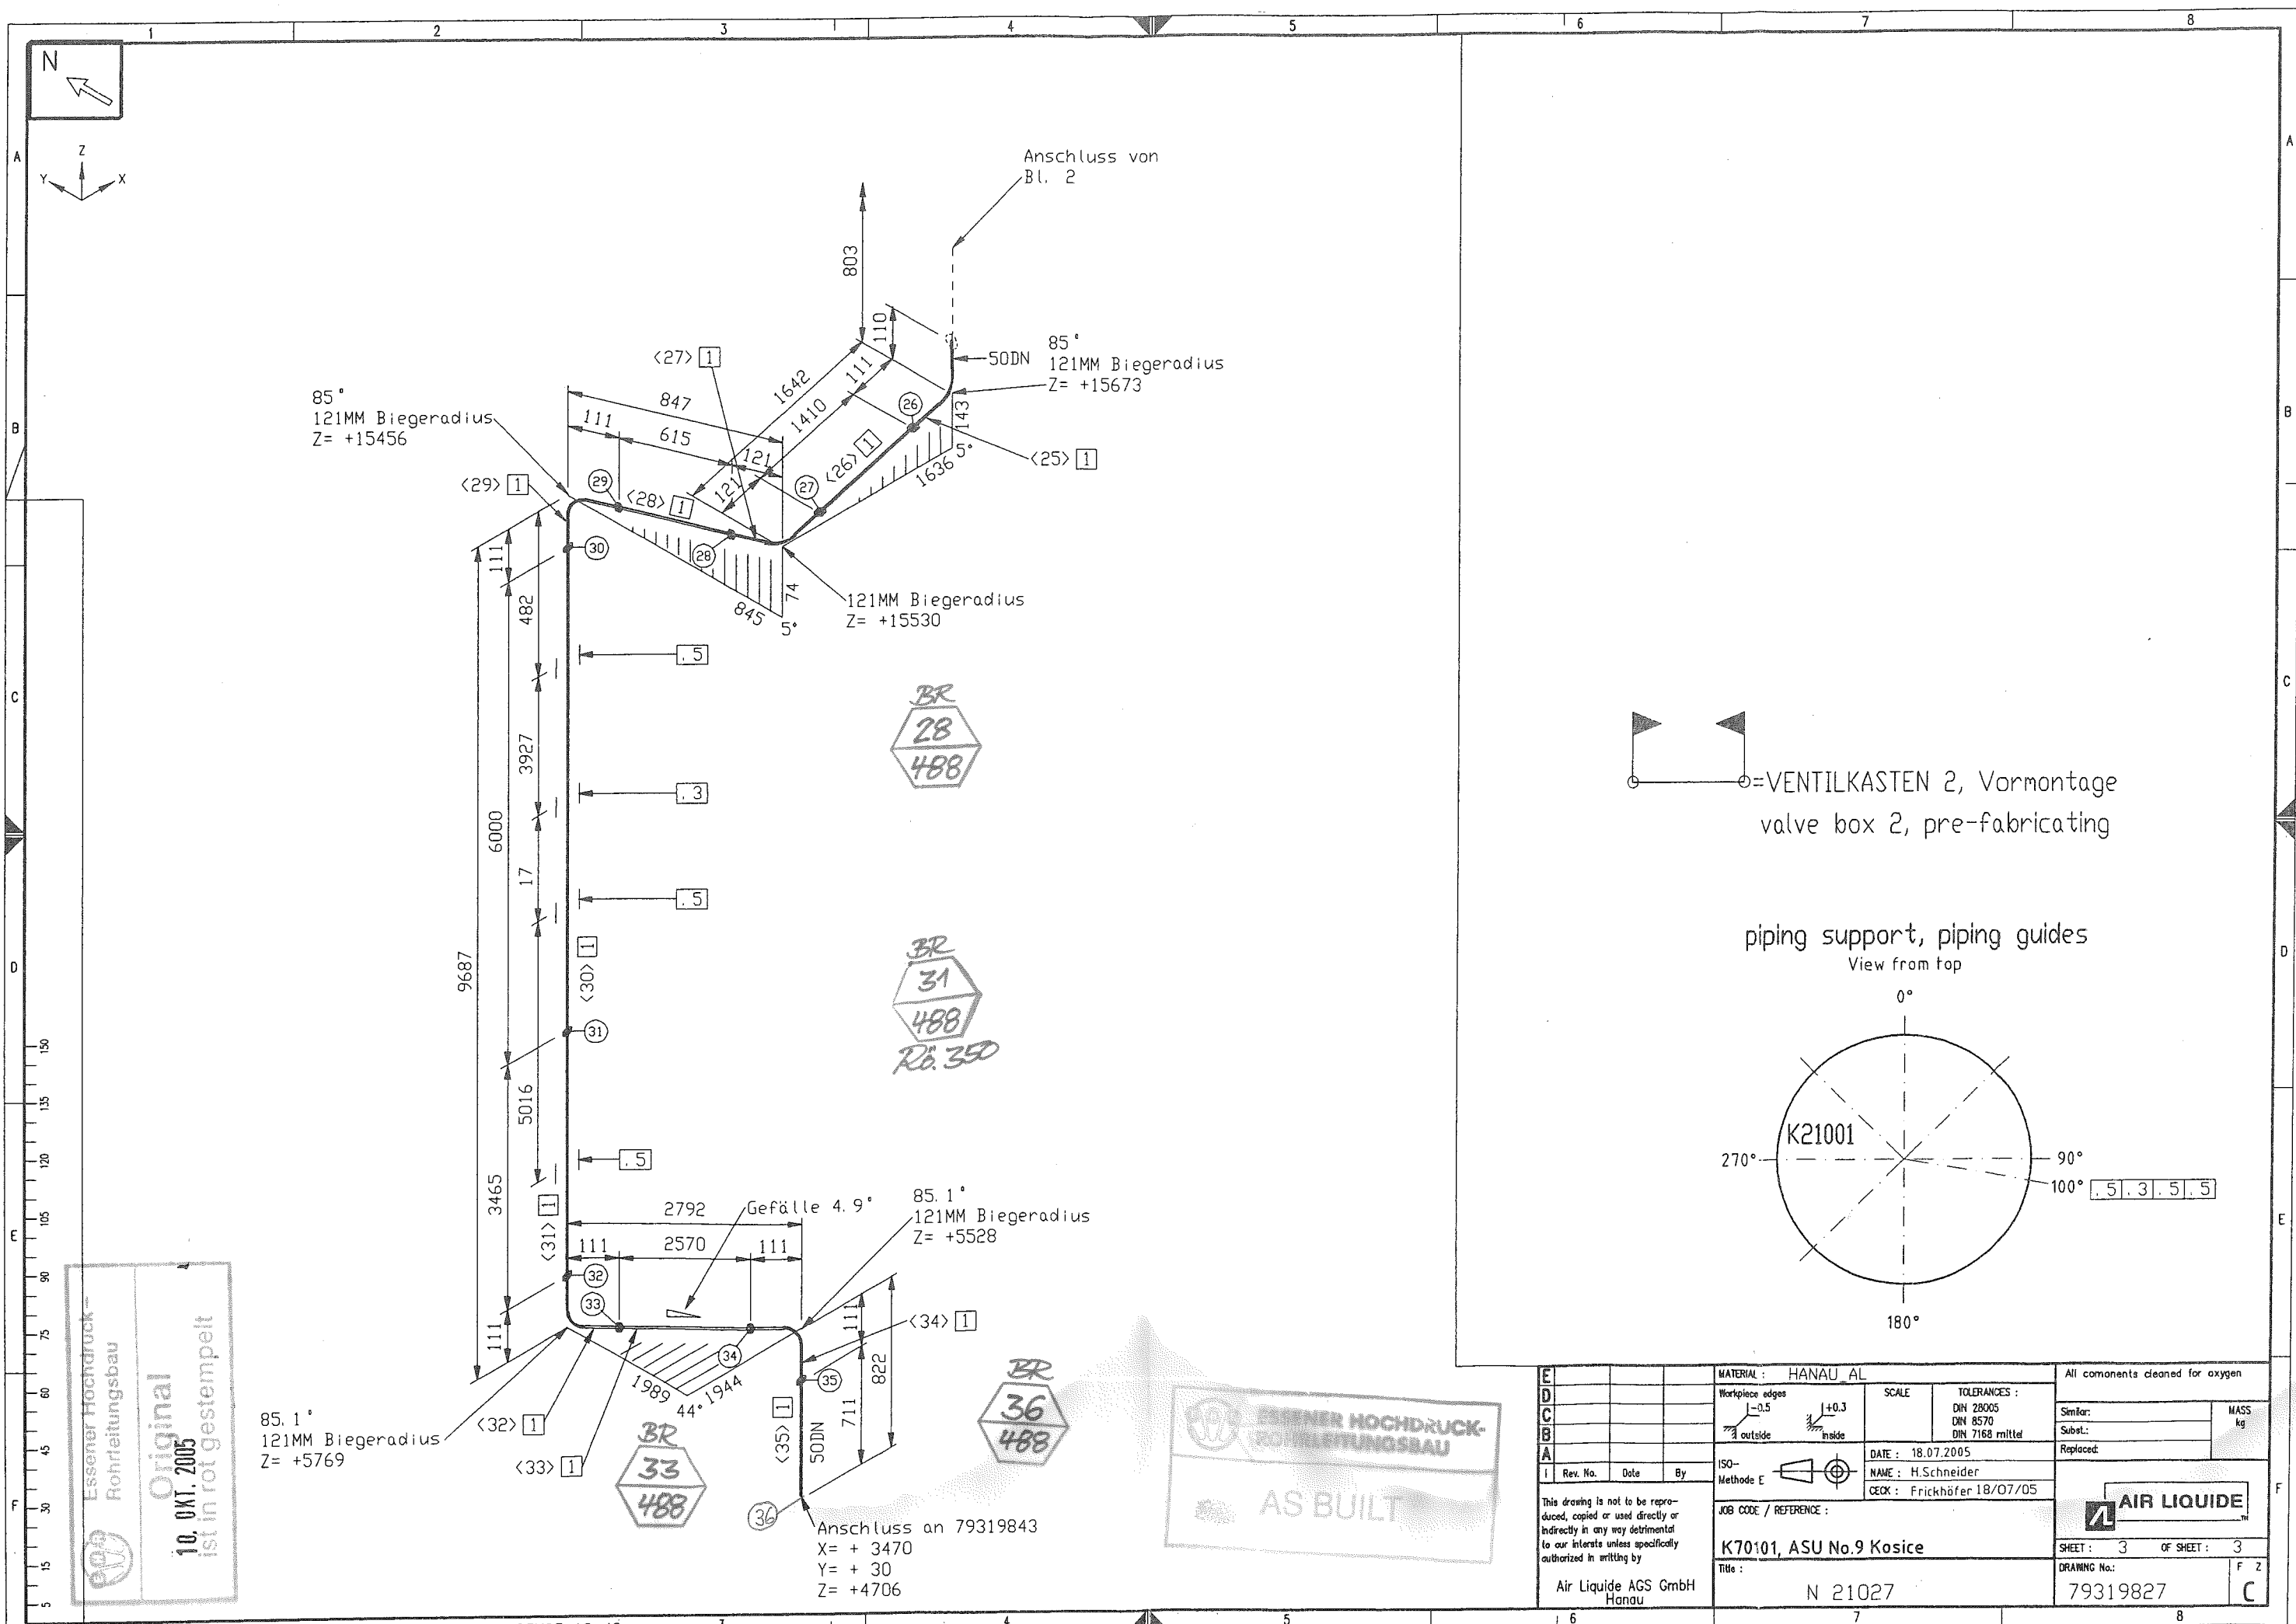


Essener Hochdruck-
Rohrleitungsbau
Original
10. OKT. 2005
ist in rot gestempelt



ESSENER HOCHDRUCK-
ROHRLEITUNGSBAU
AS BUILT

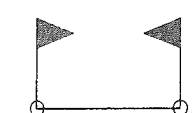

VENTILKASTEN 2, Vormontage
valve box 2, pre-fabricating

piping support, piping guides
View from top

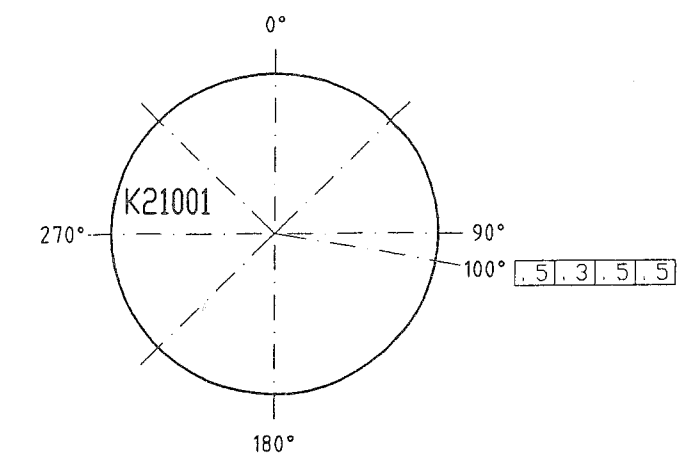

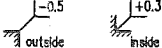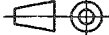E				MATERIAL : HANAU AL			All components cleaned for oxygen			
D				Workpiece edges		SCALE	TOLERANCES :		Similar:	MASS kg
C							DIN 28005 DIN 8570 DIN 7168 mittel			
B				ISO-		DATE : 18.07.2005			Replaced:	
A				Methode E 		NAME : H.Schneider				
I	Rev. No.	Date	By	JOB CODE / REFERENCE :		CHECK : Frickhöfer 18/07/05			 AIR LIQUIDE ™	
This drawing is not to be reproduced, copied or used directly or indirectly in any way detrimental to our interests unless specifically authorized in writing by				K70101, ASU No.9 Kosice						
Air Liquide AGS GmbH Hanau				Title :		DRAWING No.:		F Z		
				N 21027		79319827		C		