
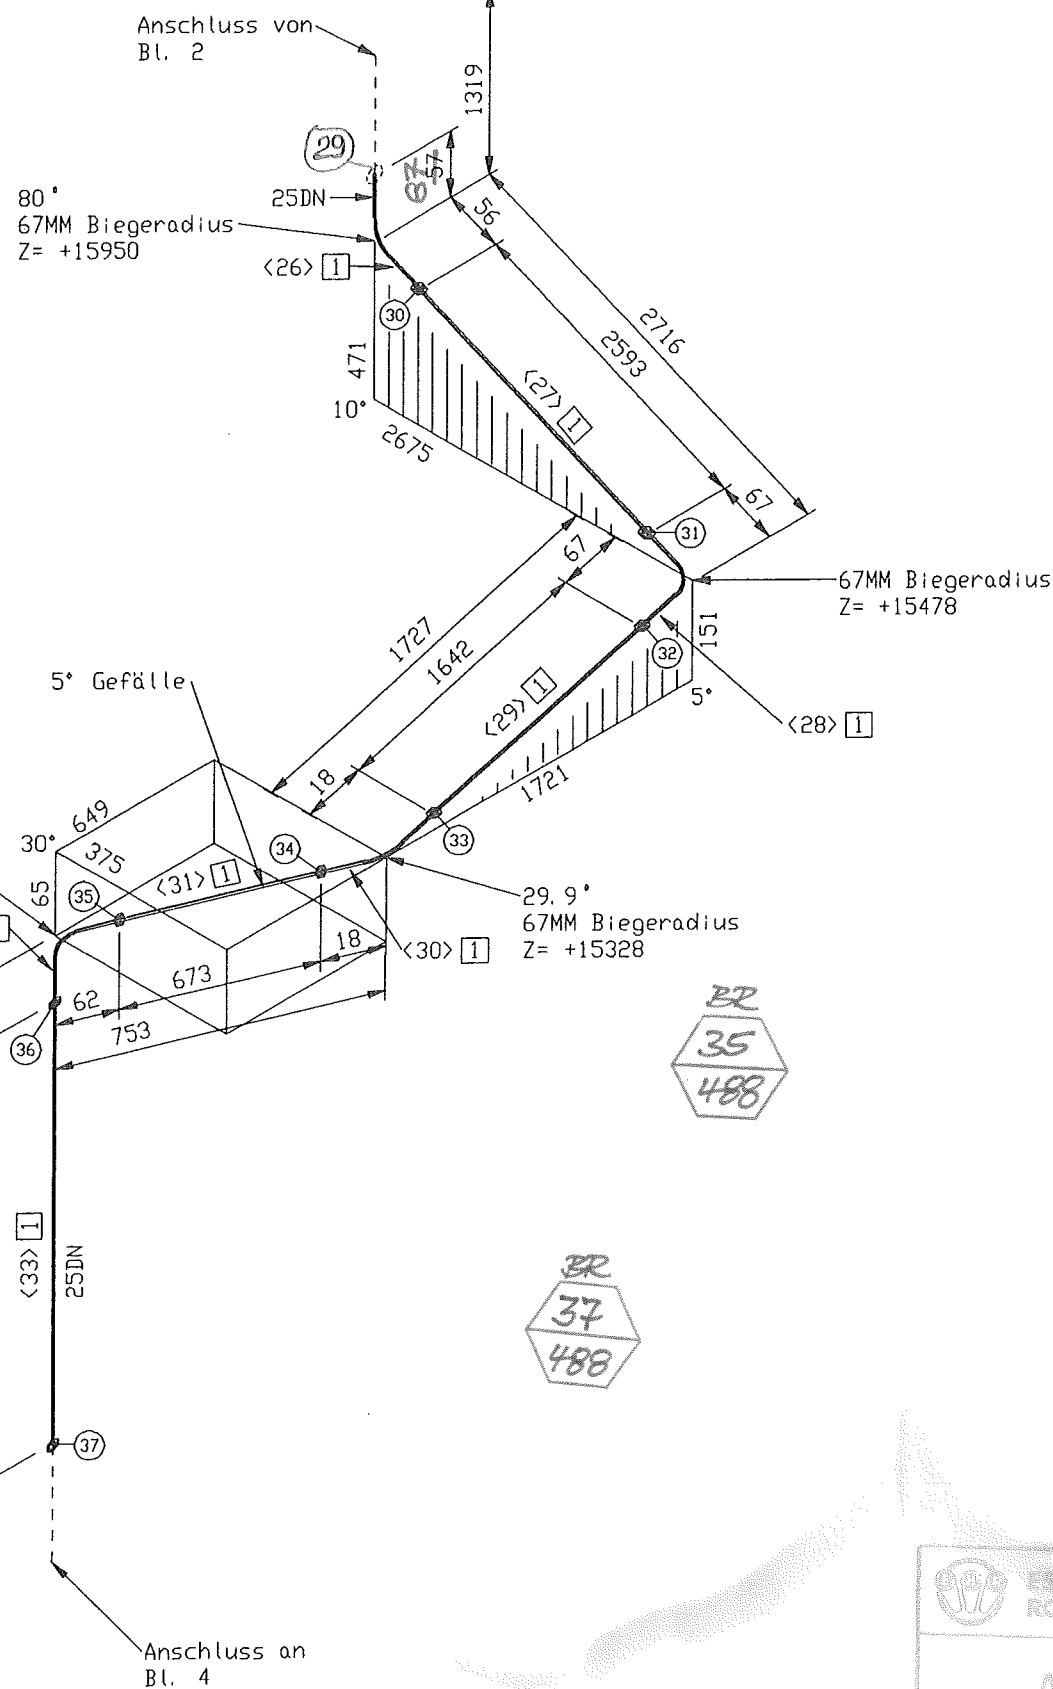
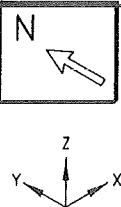



=VENTILKASTEN 2, Vormontage
valve box 2, pre-fabricating

piping support, piping guides
View from top

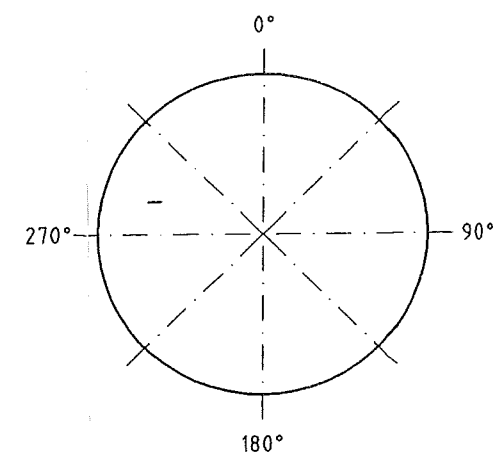

Essener Hochdruck-
Rohrleitungsbau
Original
10. OKT. 2005
ist in rot gestempelt

ESSENER HOCHDRUCK-
ROHRLEITUNGSBAU
AS BUILT

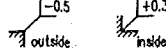E				MATERIAL : HANAU AL		All components cleaned for oxygen		
D				Workpiece edges 	SCALE	TOLERANCES : DIN 28005 DIN 8570 DIN 7168 mittel	Similar: Subst.:	MASS kg
C								
B							Replaced:	
A								
I	Rev. No.	Date	By	ISO-Methode E 	DATE : 19.07.2005	NAME : H.Schneider		
This drawing is not to be reproduced, copied or used directly or indirectly in any way detrimental to our interests unless specifically authorized in writing by Air Liquide AGS GmbH Hanau					CECK : Frickhöfer 19/07/05	 AIR LIQUIDE TM		
				JOB CODE / REFERENCE :				
				K70101, ASU No.9 Kosice				
				Title :				
				RL 43001	SHEET : 3 OF SHEET : 4			
					DRAWING No.:		F Z	
					79319830		C	