
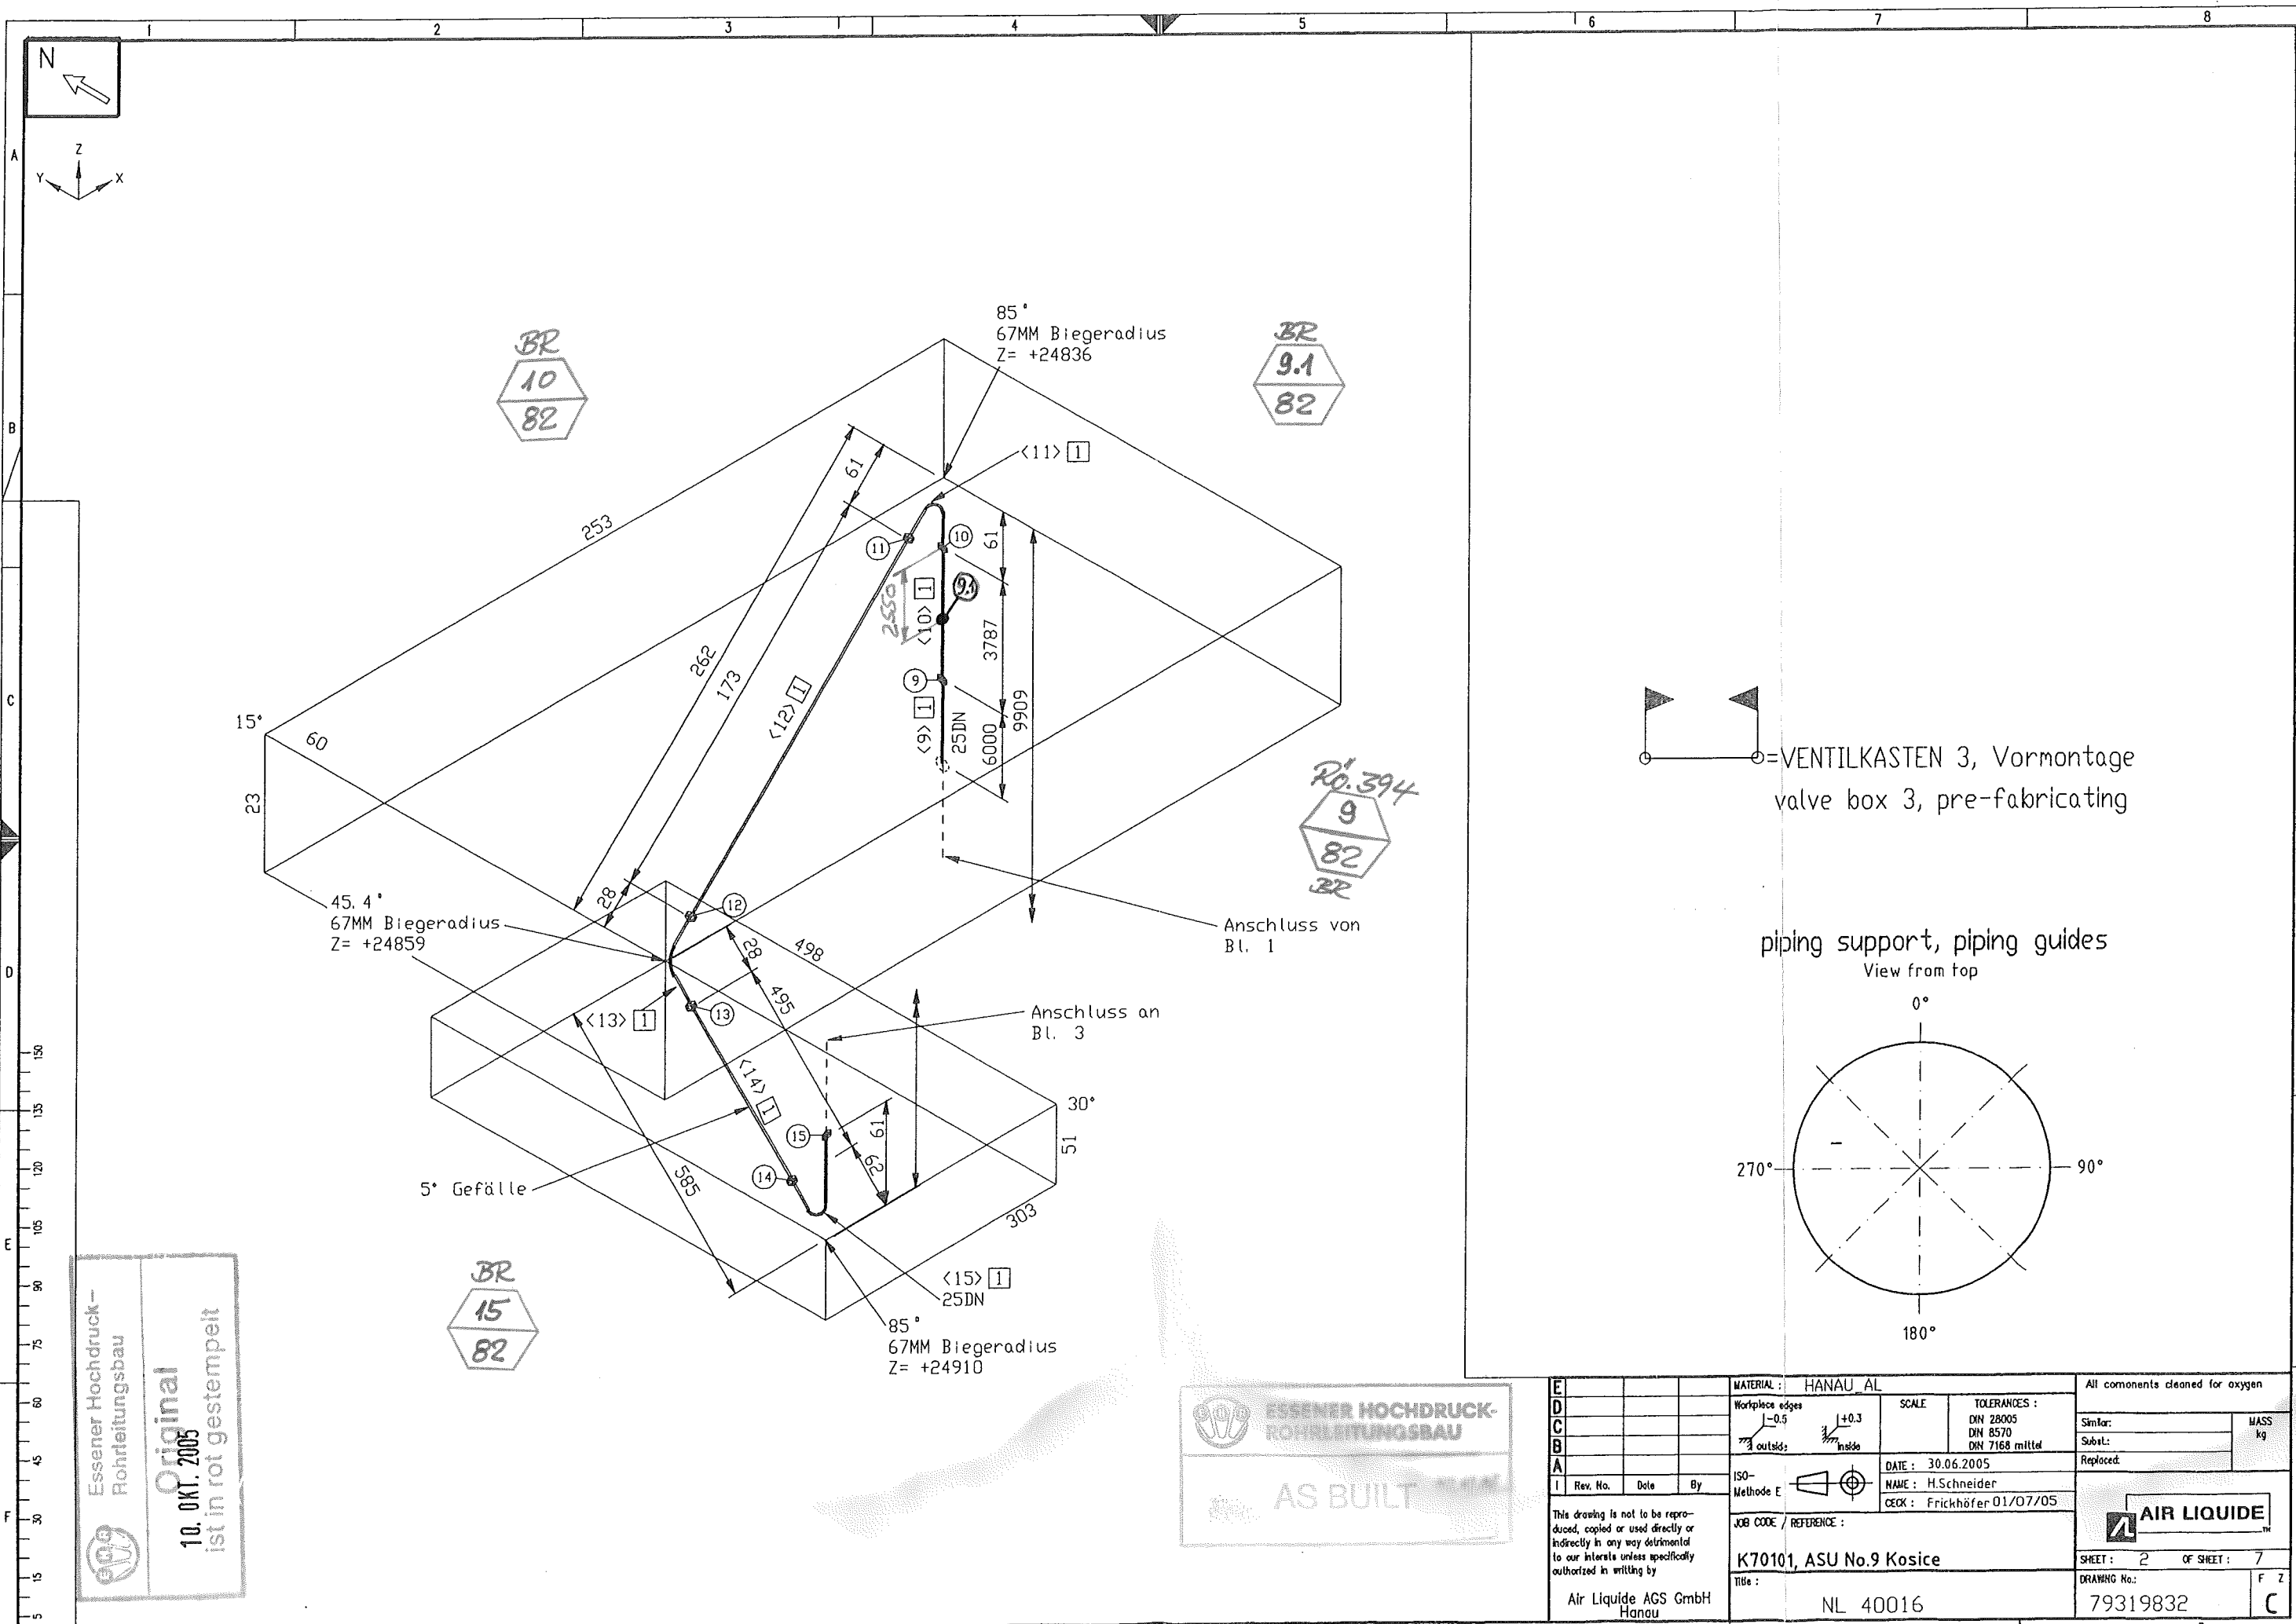



=VENTILKASTEN 3, Vormontage
valve box 3, pre-fabricating

piping support, piping guides
View from top

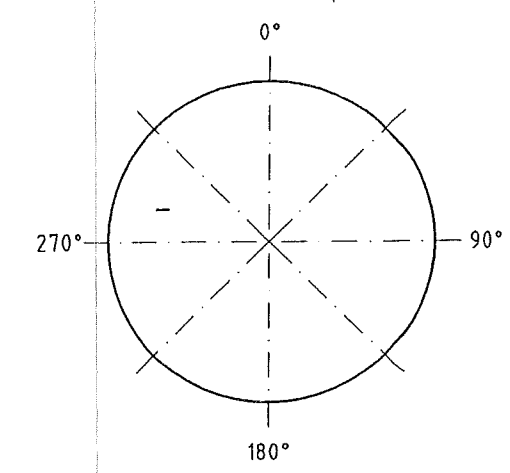

Essener Hochdruck-
Rohrleitungsbau
Original
10. OKT. 2005
ist in rot gestempelt

ESSENER HOCHDRUCK-
ROHRLEITUNGSBAU
AS BUILT

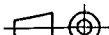E					MATERIAL : HANAU AL	All components cleaned for oxygen					
D					Workplace edges	SCALE	TOLERANCES : DIN 28005 DIN 8570 DIN 7168 mittel	Similar:	MASS kg		
C					 ±0.5 outside	 ±0.3 inside		Subst.:			
B					ISO- Methode E		DATE : 30.06.2005 NAME : H.Schneider CECK : Frickhöfer 01/07/05	Replaced:			
A					This drawing is not to be reproduced, copied or used directly or indirectly in any way detrimental to our interests unless specifically authorized in writing by Air Liquide AGS GmbH Hanau	JOB CODE / REFERENCE : K70101, ASU No.9 Kosice		 AIR LIQUIDE TM			
I	Rev. No.	Date	By								
Title : NL 40016				SHEET : 2 OF SHEET : 7						DRAWING No.: 79319832	F Z C