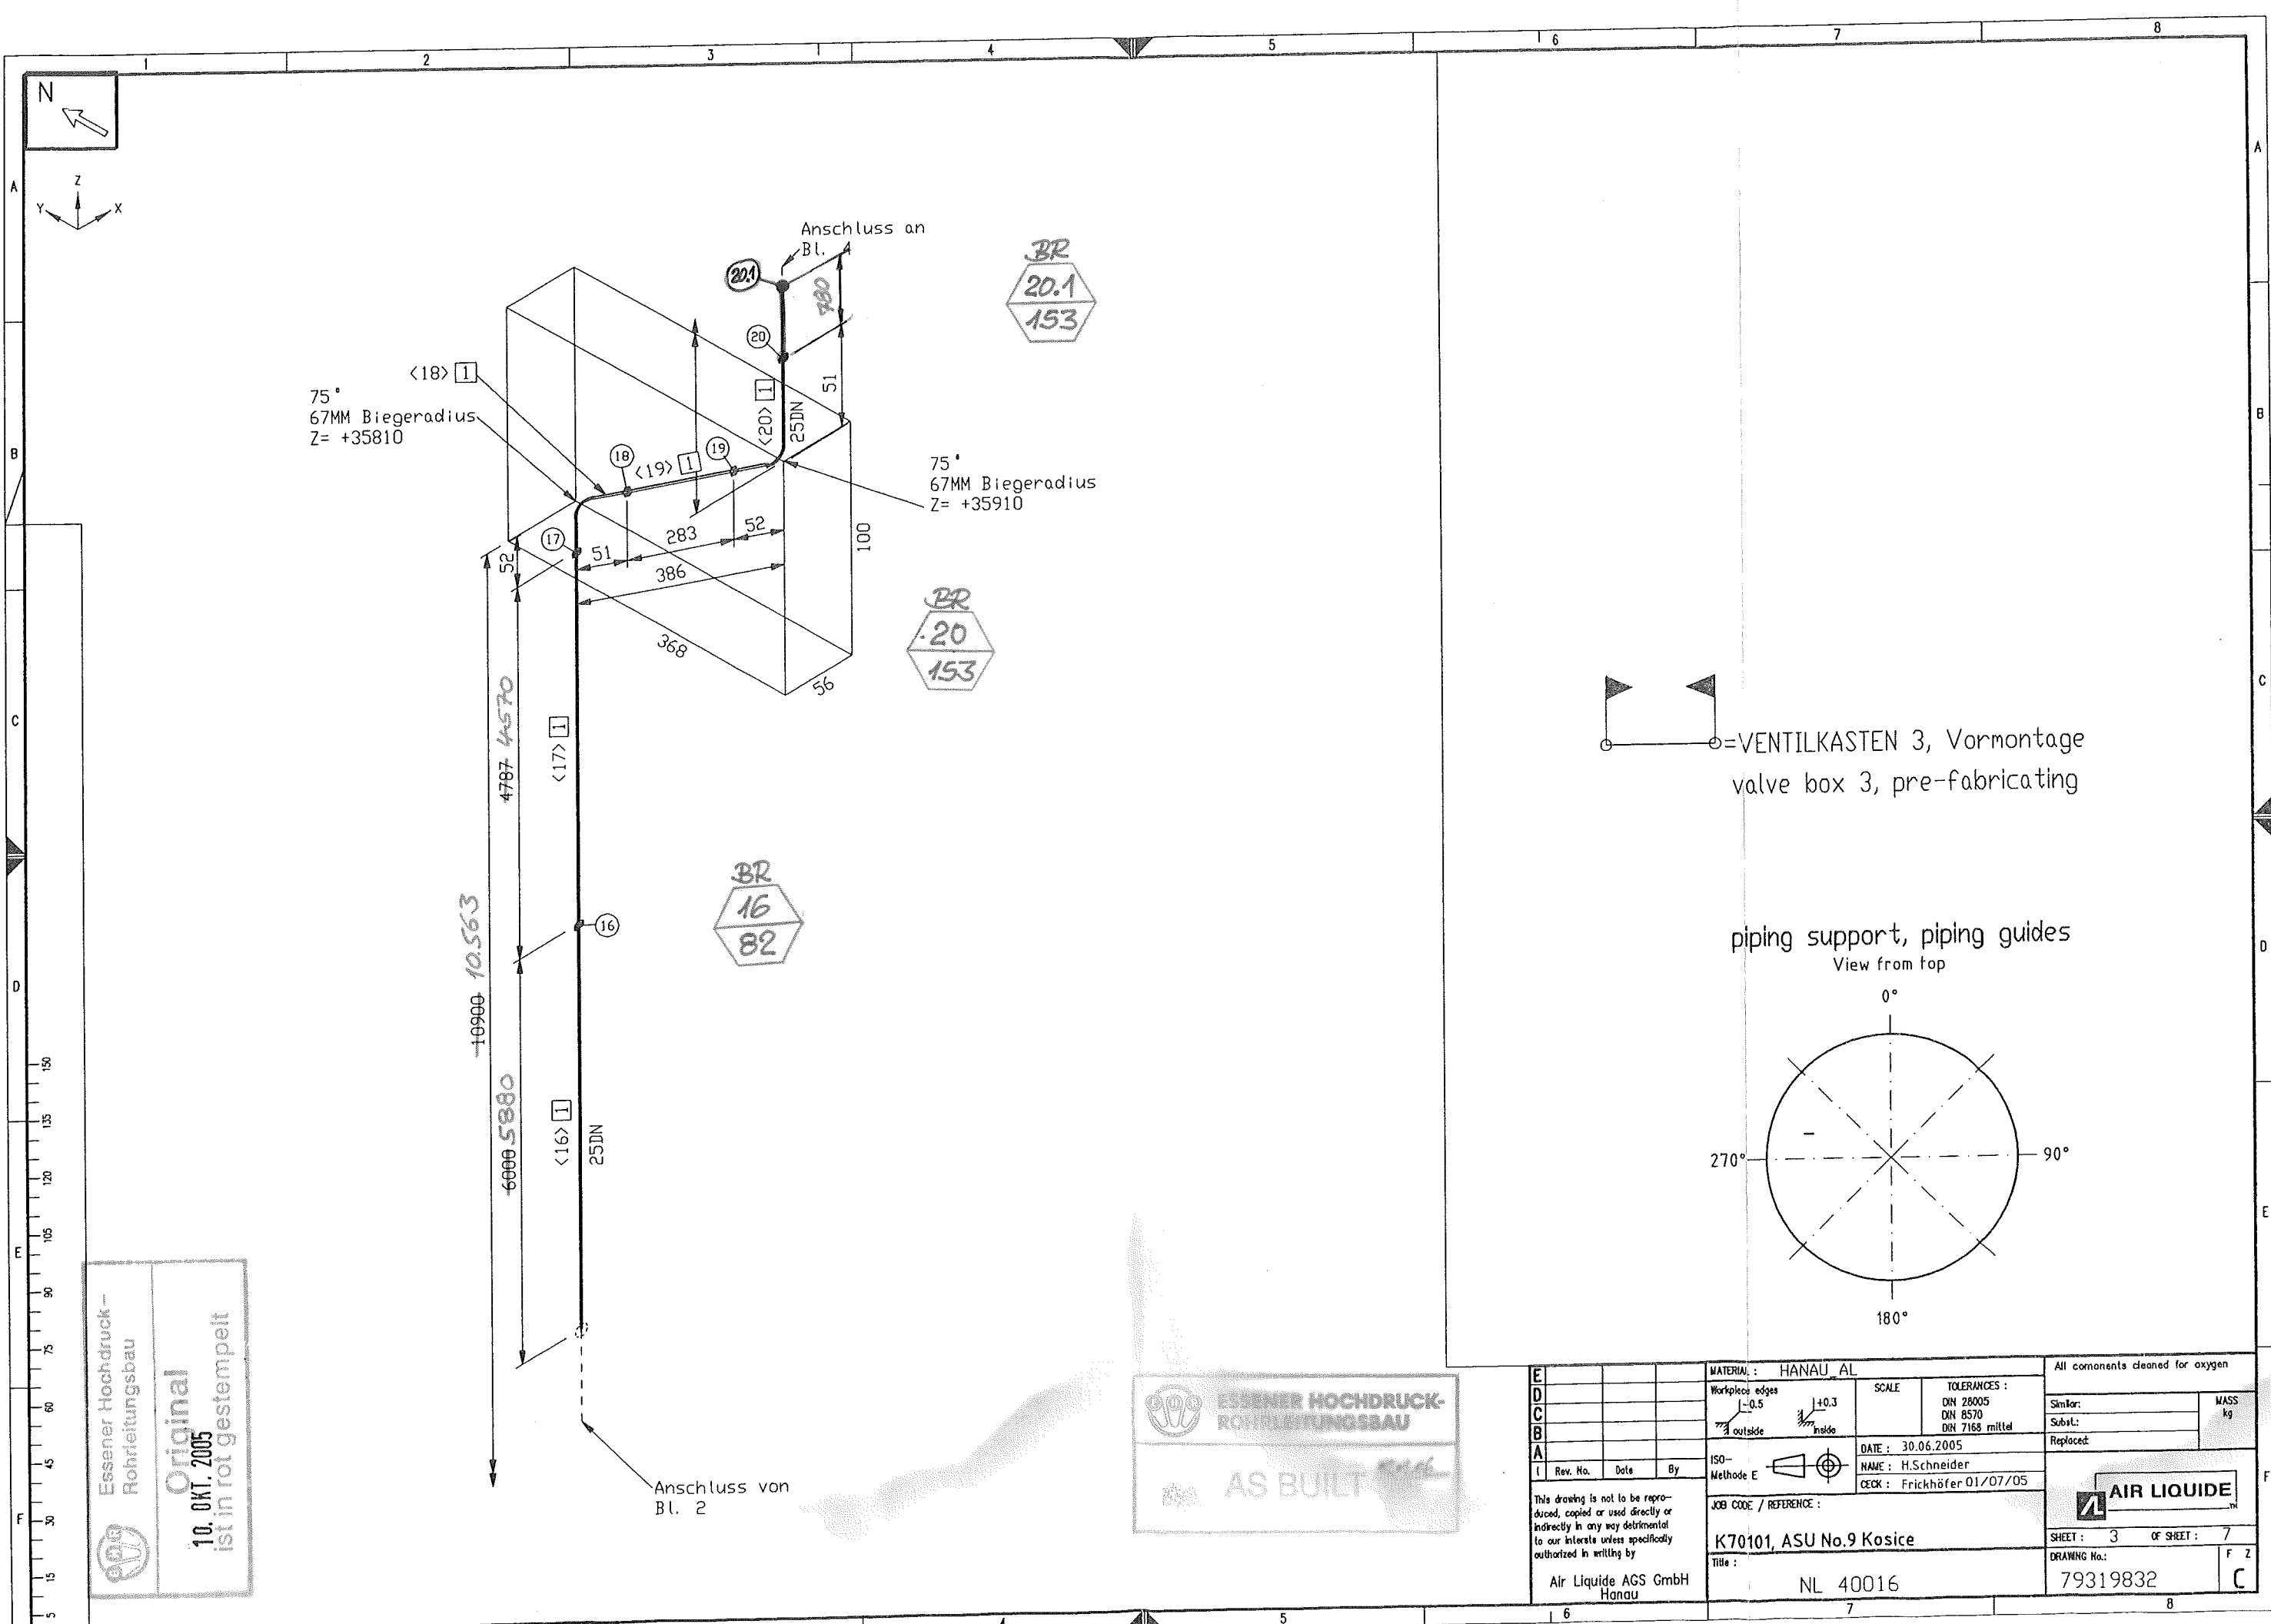


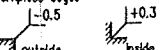
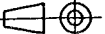


Essener Hochdruck-
Rohrleitungsbau

Original
10. OKT. 2005
ist in rot gestempelt

ESSENER HOCHDRUCK-
ROHRLEITUNGSBAU

AS BUILT

E				MATERIAL : HANAU AL	All components cleaned for oxygen			
D				Workpieces edges 	SCALE	TOLERANCES : DIN 28005 DIN 8570 DIN 7168 mittel	Similar:	MASS kg
C					DATE : 30.06.2005	NAME : H.Schneider CECK : Frickhöfer 01/07/05	Subst:	
B				ISO-Methode E 	JOB CODE / REFERENCE : K70101, ASU No.9 Kosice		SHEET : 3 OF SHEET : 7	Replaced
A				This drawing is not to be reproduced, copied or used directly or indirectly in any way detrimental to our interests unless specifically authorized in writing by Air Liquide AGS GmbH Hanau		Title : NL 40016		
I	Rev. No.	Date	By					