

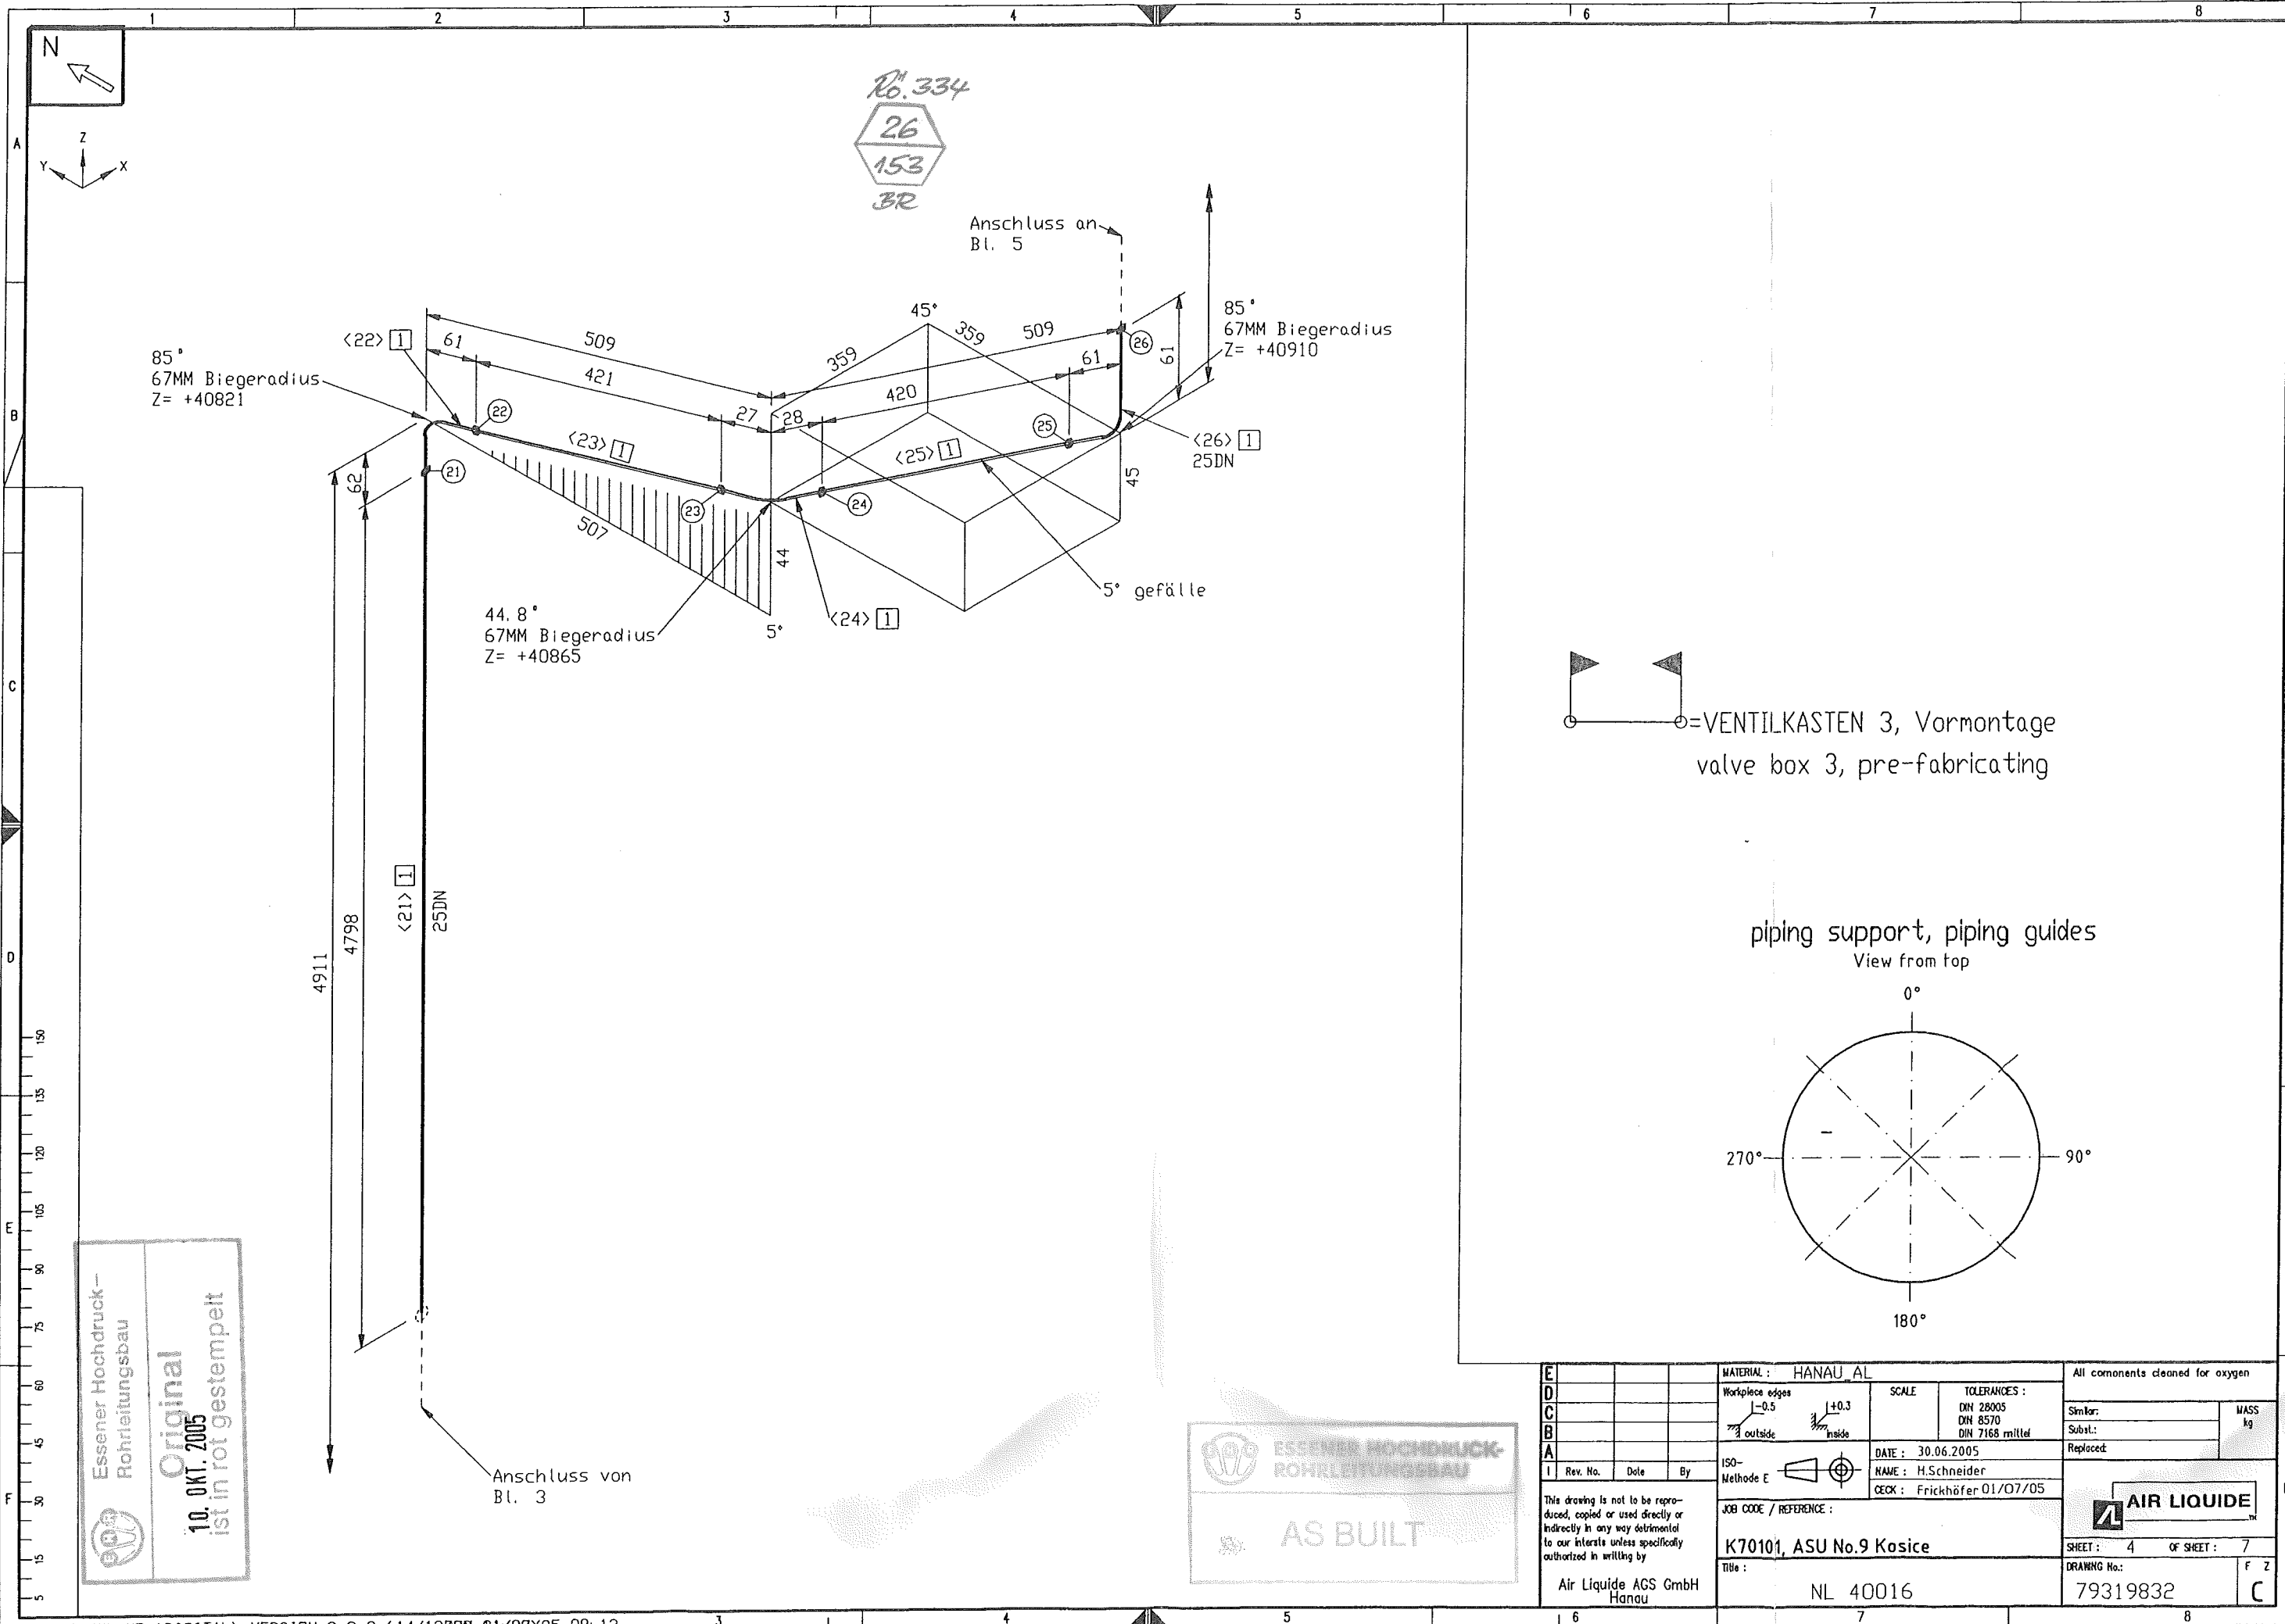


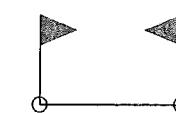


 =VENTILKASTEN 3, Vormontage
 valve box 3, pre-fabricating

piping support, piping guides
 View from top

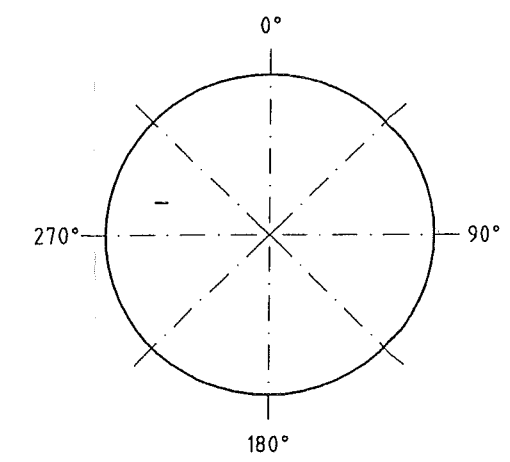

Essener Hochdruck-
 Rohrleitungsbau
 Original
 10. OKT. 2005
 ist in rot gestempelt

ESSENER HOCHDRUCK-
 ROHRLEITUNGSBAU
 AS BUILT

E				MATERIAL: HANAU AL		All components cleaned for oxygen	
D				Workpiece edges -0.5 3 outside	SCALE 1:1	TOLERANCES: DN 28005 DN 8570 DIN 7168 mittel	Similar: Subst.: Replaced:
C				ISO- Methode E	DATE: 30.06.2005 NAME: H.Schneider CECK: Frickhöfer 01/07/05	AIR LIQUIDE	
B				JOB CODE / REFERENCE: K70101, ASU No.9 Kosice			SHEET: 4 OF SHEET: 7
A				Title: Air Liquide AGS GmbH Hanau	NL 40016	DRAWING No.: 79319832	F Z C