
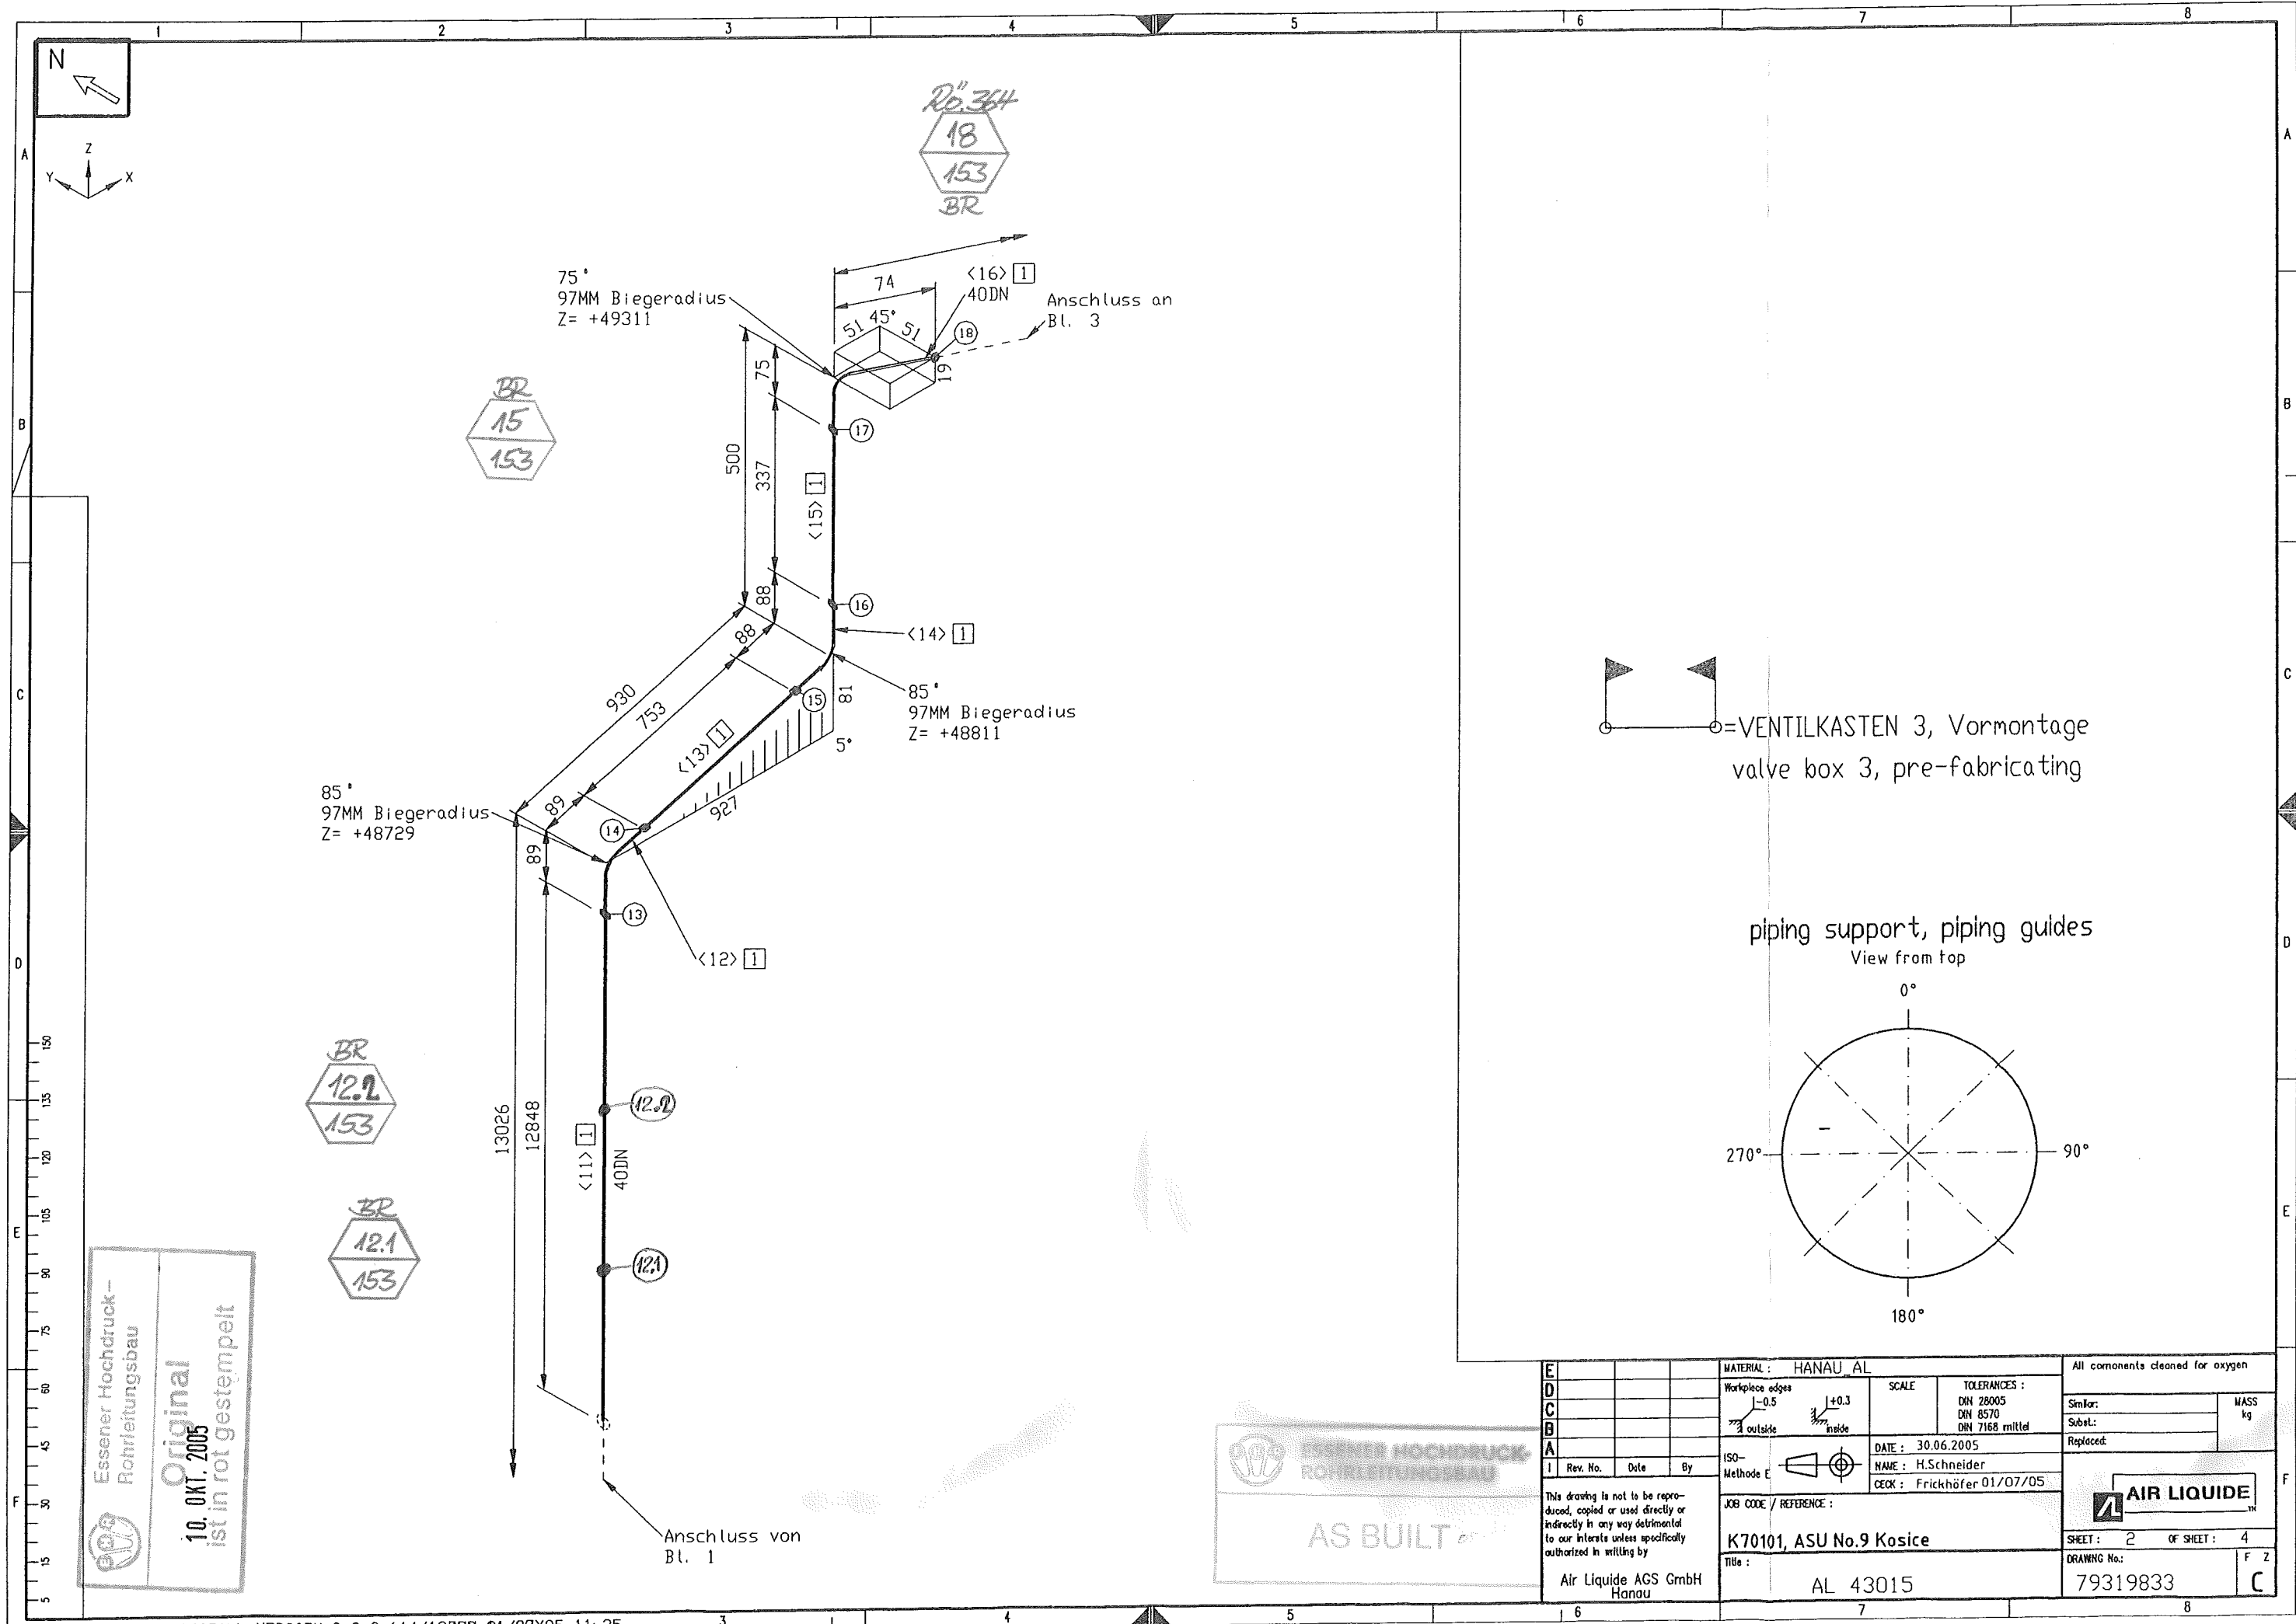
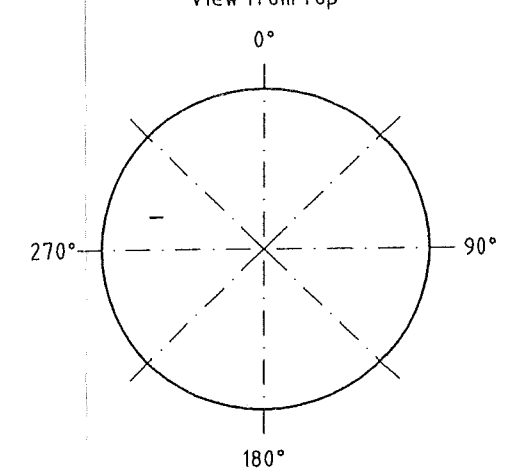


VENTILKASTEN 3, Vormontage
valve box 3, pre-fabricating

piping support, piping guides
View from top

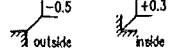

E C B A				MATERIAL : HANAU AL			All components cleaned for oxygen		
	Workpiece edges			SCALE	TOLERANCES :		Similar:		MASS kg
					DN 28005 DN 8570 DN 7168 mittel		Subst.:		
	ISO-Methode E 			DATE : 30.06.2005		Replaced:			
				NAME : H.Schneider					
I	Rev. No.	Date	By	CECK : Frickhöfer 01/07/05					
This drawing is not to be reproduced, copied or used directly or indirectly in any way detrimental to our interests unless specifically authorized in writing by Air Liquide AGS GmbH Hanau				JOB CODE / REFERENCE :			 AIR LIQUIDE TM		
				K70101, ASU No.9 Kosice			SHEET : 2 OF SHEET : 4		
				Title :			DRAWING No.:		F Z
				AL 43015			79319833		C

Essener Hochdruck-
Rohrleitungsbau
Original
10. OKT. 2005
ist in rot gestempelt

ESSENER HOCHDRUCK-
ROHRLEITUNGSBAU
AS BUILT