


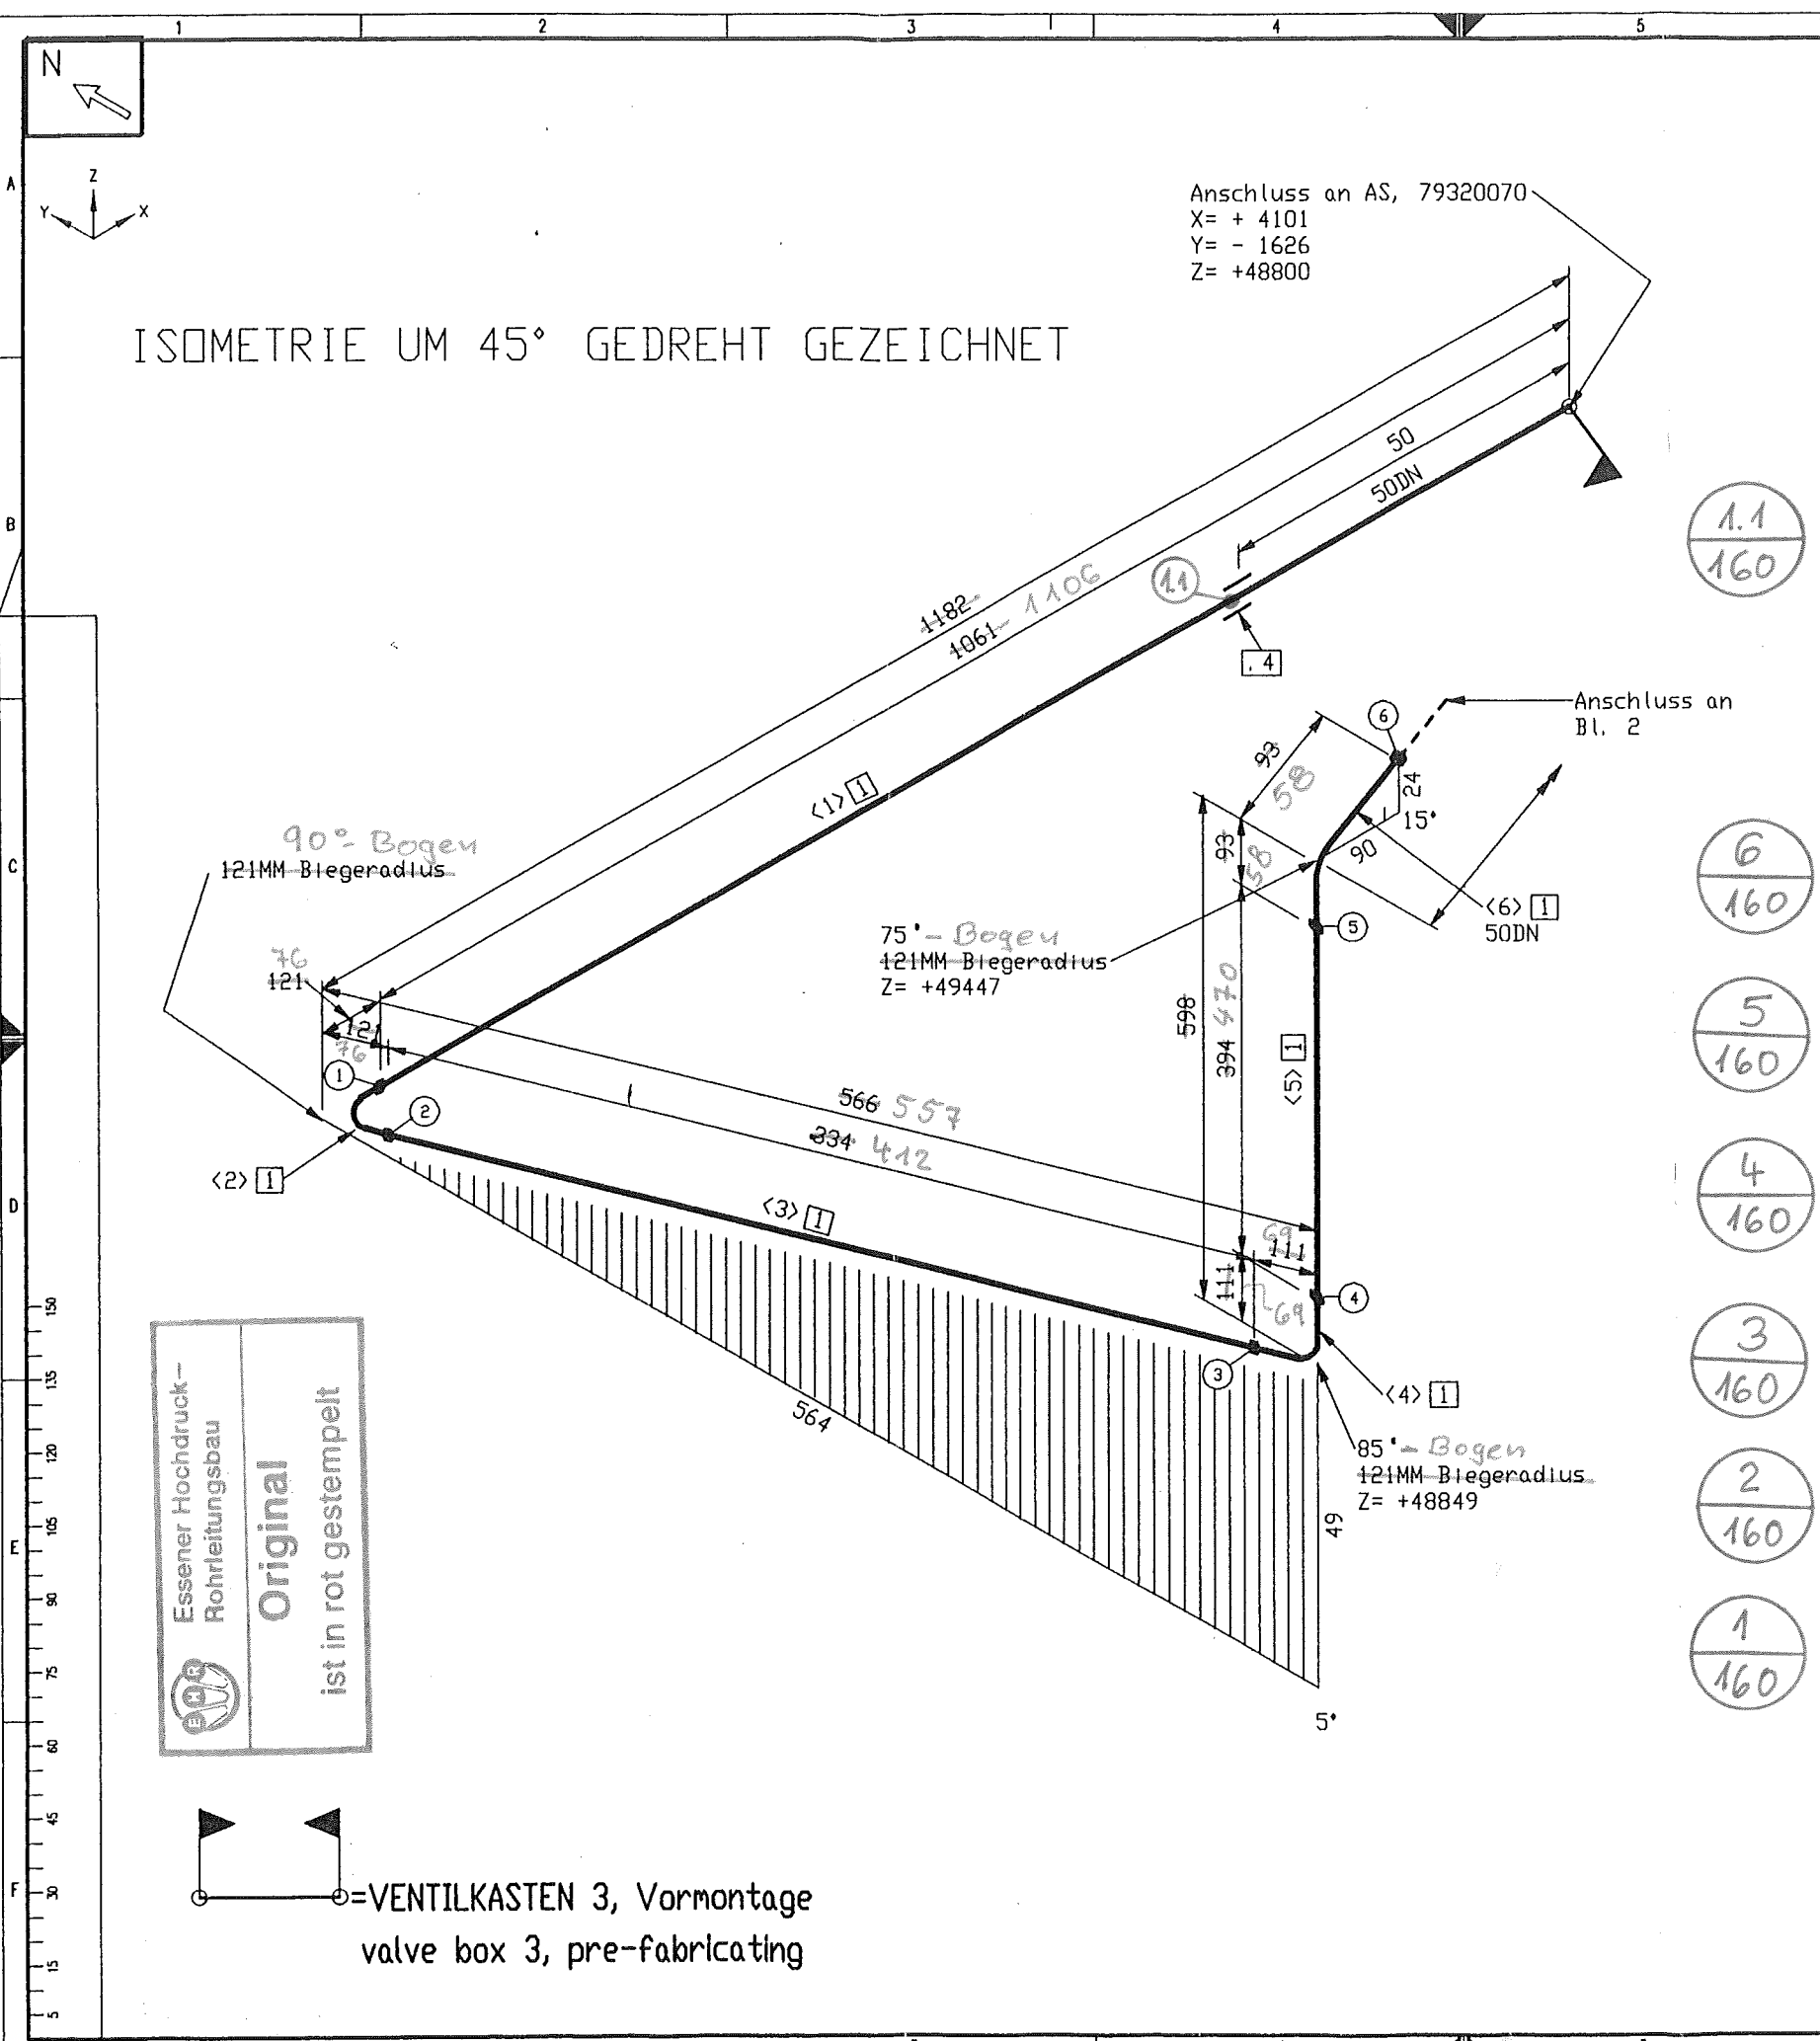

Stückliste					
Lfd Nr.	Benennung	DN (MM)	Sachnummer	Menge	Gewicht (kg)
Rohr					
1	ROHR 60,3 X 3,9 ALMG4,5MN W27	50	77038146	40853-MM	20.2
Fitting					
2	T-Stutzen 60,3x3,9 - 40,3x5,1	50X40	79314295	1	0.1
Ventil					
3	Eck-Ventil AL DN 50 / PN 40 Handrad	50	770.38860	1	50.0
Halterung					
4	Bordscheibe gez. auf 79313040	50	79313042	1	-
Summe Masse					70.3

Rohrzuschnitt						
Rohr Stk.	Länge (MM)	DN (MM)	Bemerkung	Rohr Ende 1	Rohr Ende 2	Sachnummer
<1>	1061	50				77038146
<2>	190	50	PLD BEND(1)			77038146
<3>	334	50				77038146
<4>	180	50	PLD BEND(1)			77038146
<5>	394	50				77038146
<6>	159	50	PLD BEND(1)			77038146
<7>	463	50				77038146
<8>	190	50	PLD BEND(1)			77038146
<9>	394	50				77038146
<10>	222	50	PLD BEND(1)			77038146
<11>	455	50				77038146
<12>	180	50	PLD BEND(1)			77038146
<13>	772	50				77038146
<14>	190	50	PLD BEND(1)			77038146
<15>	408	50				77038146
<16>	190	50	PLD BEND(1)			77038146
<17>	772	50				77038146
<18>	180	50	PLD BEND(1)			77038146
<19>	4119	50				77038146

ESSENER HOCHDRUCK-ROHRLEITUNGSBAU

AS BUILT

View from top

0°

180°

MATERIAL KONTR.	CECK OF MAT.	SCHWEISSEN	WELDING	MECHAN. FERTIGST.	MECHAN. COMPL.	DRUCKPROBE	PRESSURE TEST

EHR-PROJ.-NO.: C-13005

ESSENER HOCHDRUCK-ROHRLEITUNGSBAU GMBH

Air Liquide AGS GmbH

MATERIAL	SCALE	TOLERANCES	DATE	NAME	CECK
HANAU AL		DN 28005 DN 6570 DN 7168 millit	05.07.2005	H.Schneider	Frickhöfer 05/07/05

ISO-Methode E

JOB CODE / REFERENCE: K70101, ASU No.9 Kosice

This drawing is not to be reproduced, copied or used directly or indirectly in any way detrimental to our interests unless specifically authorized in writing by Air Liquide AGS GmbH Hanau

RL 40004

79319837

Sheet 1 of 3