



ISOMETRIE UM 45° GEDREHT GEZEICHNET

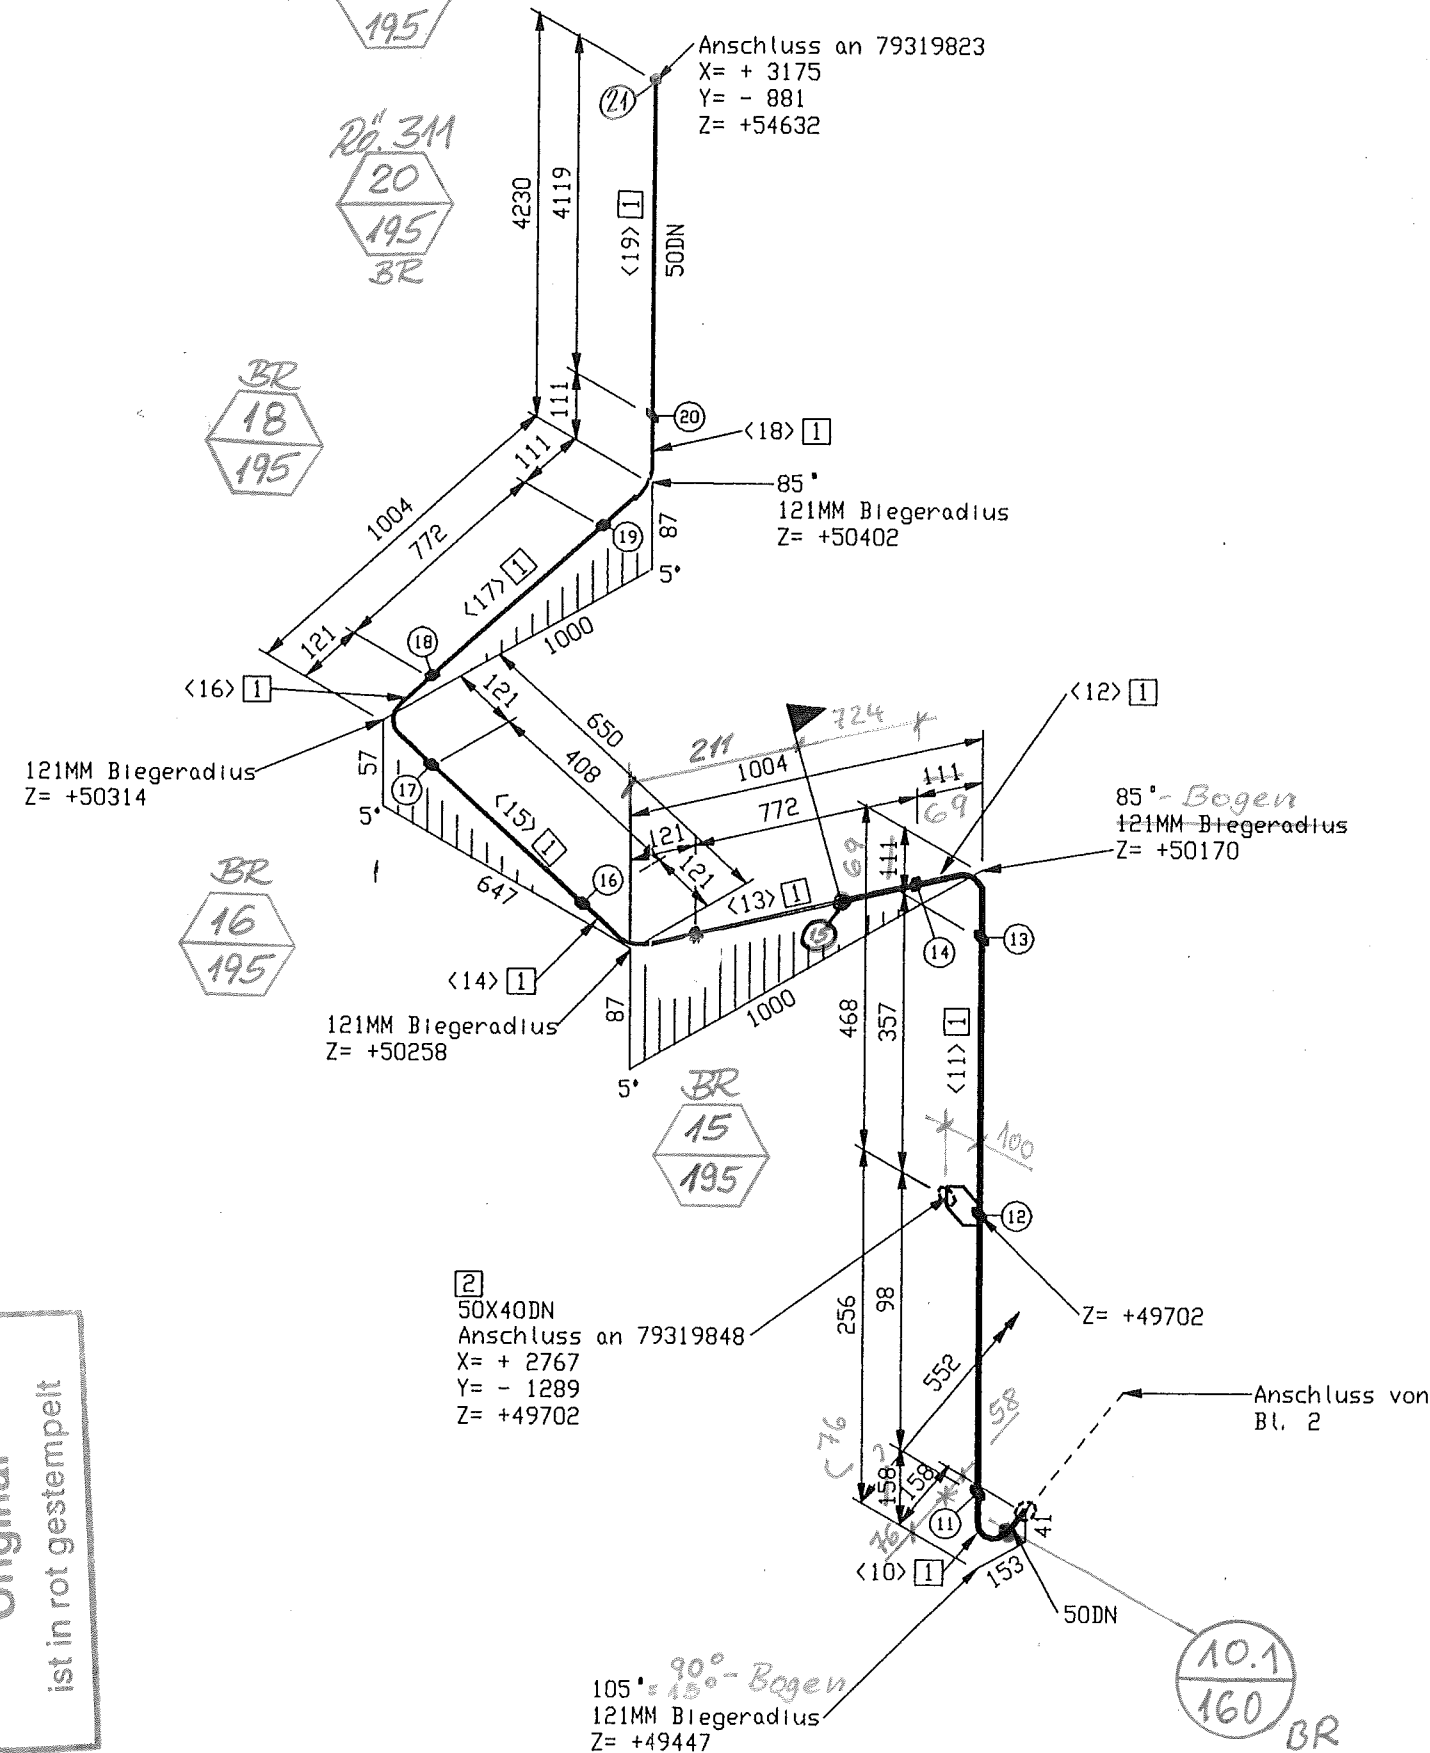

MATERIAL KONTR.		
CHECK OF MAT.		
SCHWEISSEN		
WELDING		
MECHAN. FERTIGST.		
MECHAN. COMPL.		
DRUCKPROBE		
PRESSURE TEST		
EHR-PROJ.-NO.:	C-13005	
	ESSENER HOCHDRUCK-ROHRLEITUNGSBAU GMBH	Air Liquide AGS GmbH

= VENTILKASTEN 3, Vormontage
valve box 3, pre-fabricating

pipng support, piping guides
View from top

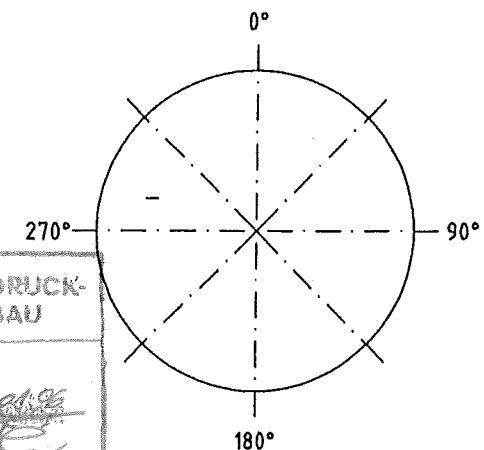

ESSENER HOCHDRUCK-ROHRLEITUNGSBAU
AS BUILT

E D C B A	Rev. No.	Date	By	MATERIAL: HANAU, AL	SCALE	TOLERANCES:	All components cleaned for oxygen	
				Workpiece edges	1:0.5	DN 28005	Similar:	MASS
				1:0.3	1:0.3	DN 6570	Subst:	kg
				1:0.1	1:0.1	DN 7168 mittel	Replaced:	
This drawing is not to be reproduced, copied or used directly or indirectly in any way detrimental to our interests unless specifically authorized in writing by				ISO-Methode E	DATE: 05.07.2005	NAME: H.Schneider		
Air Liquide AGS GmbH Hanau				JOB CODE / REFERENCE:	CHECK: Frickhöfer 05/07/05	NAME: H.Schneider		
				K70101, ASU No.9 Kosice			SHEET: 3	OF SHEET: 3
				Title: RL 40004			DRAWING No.:	F Z
							79319837	C

Essener Hochdruck-Rohrleitungsbau
Original
ist in rot gestempelt