



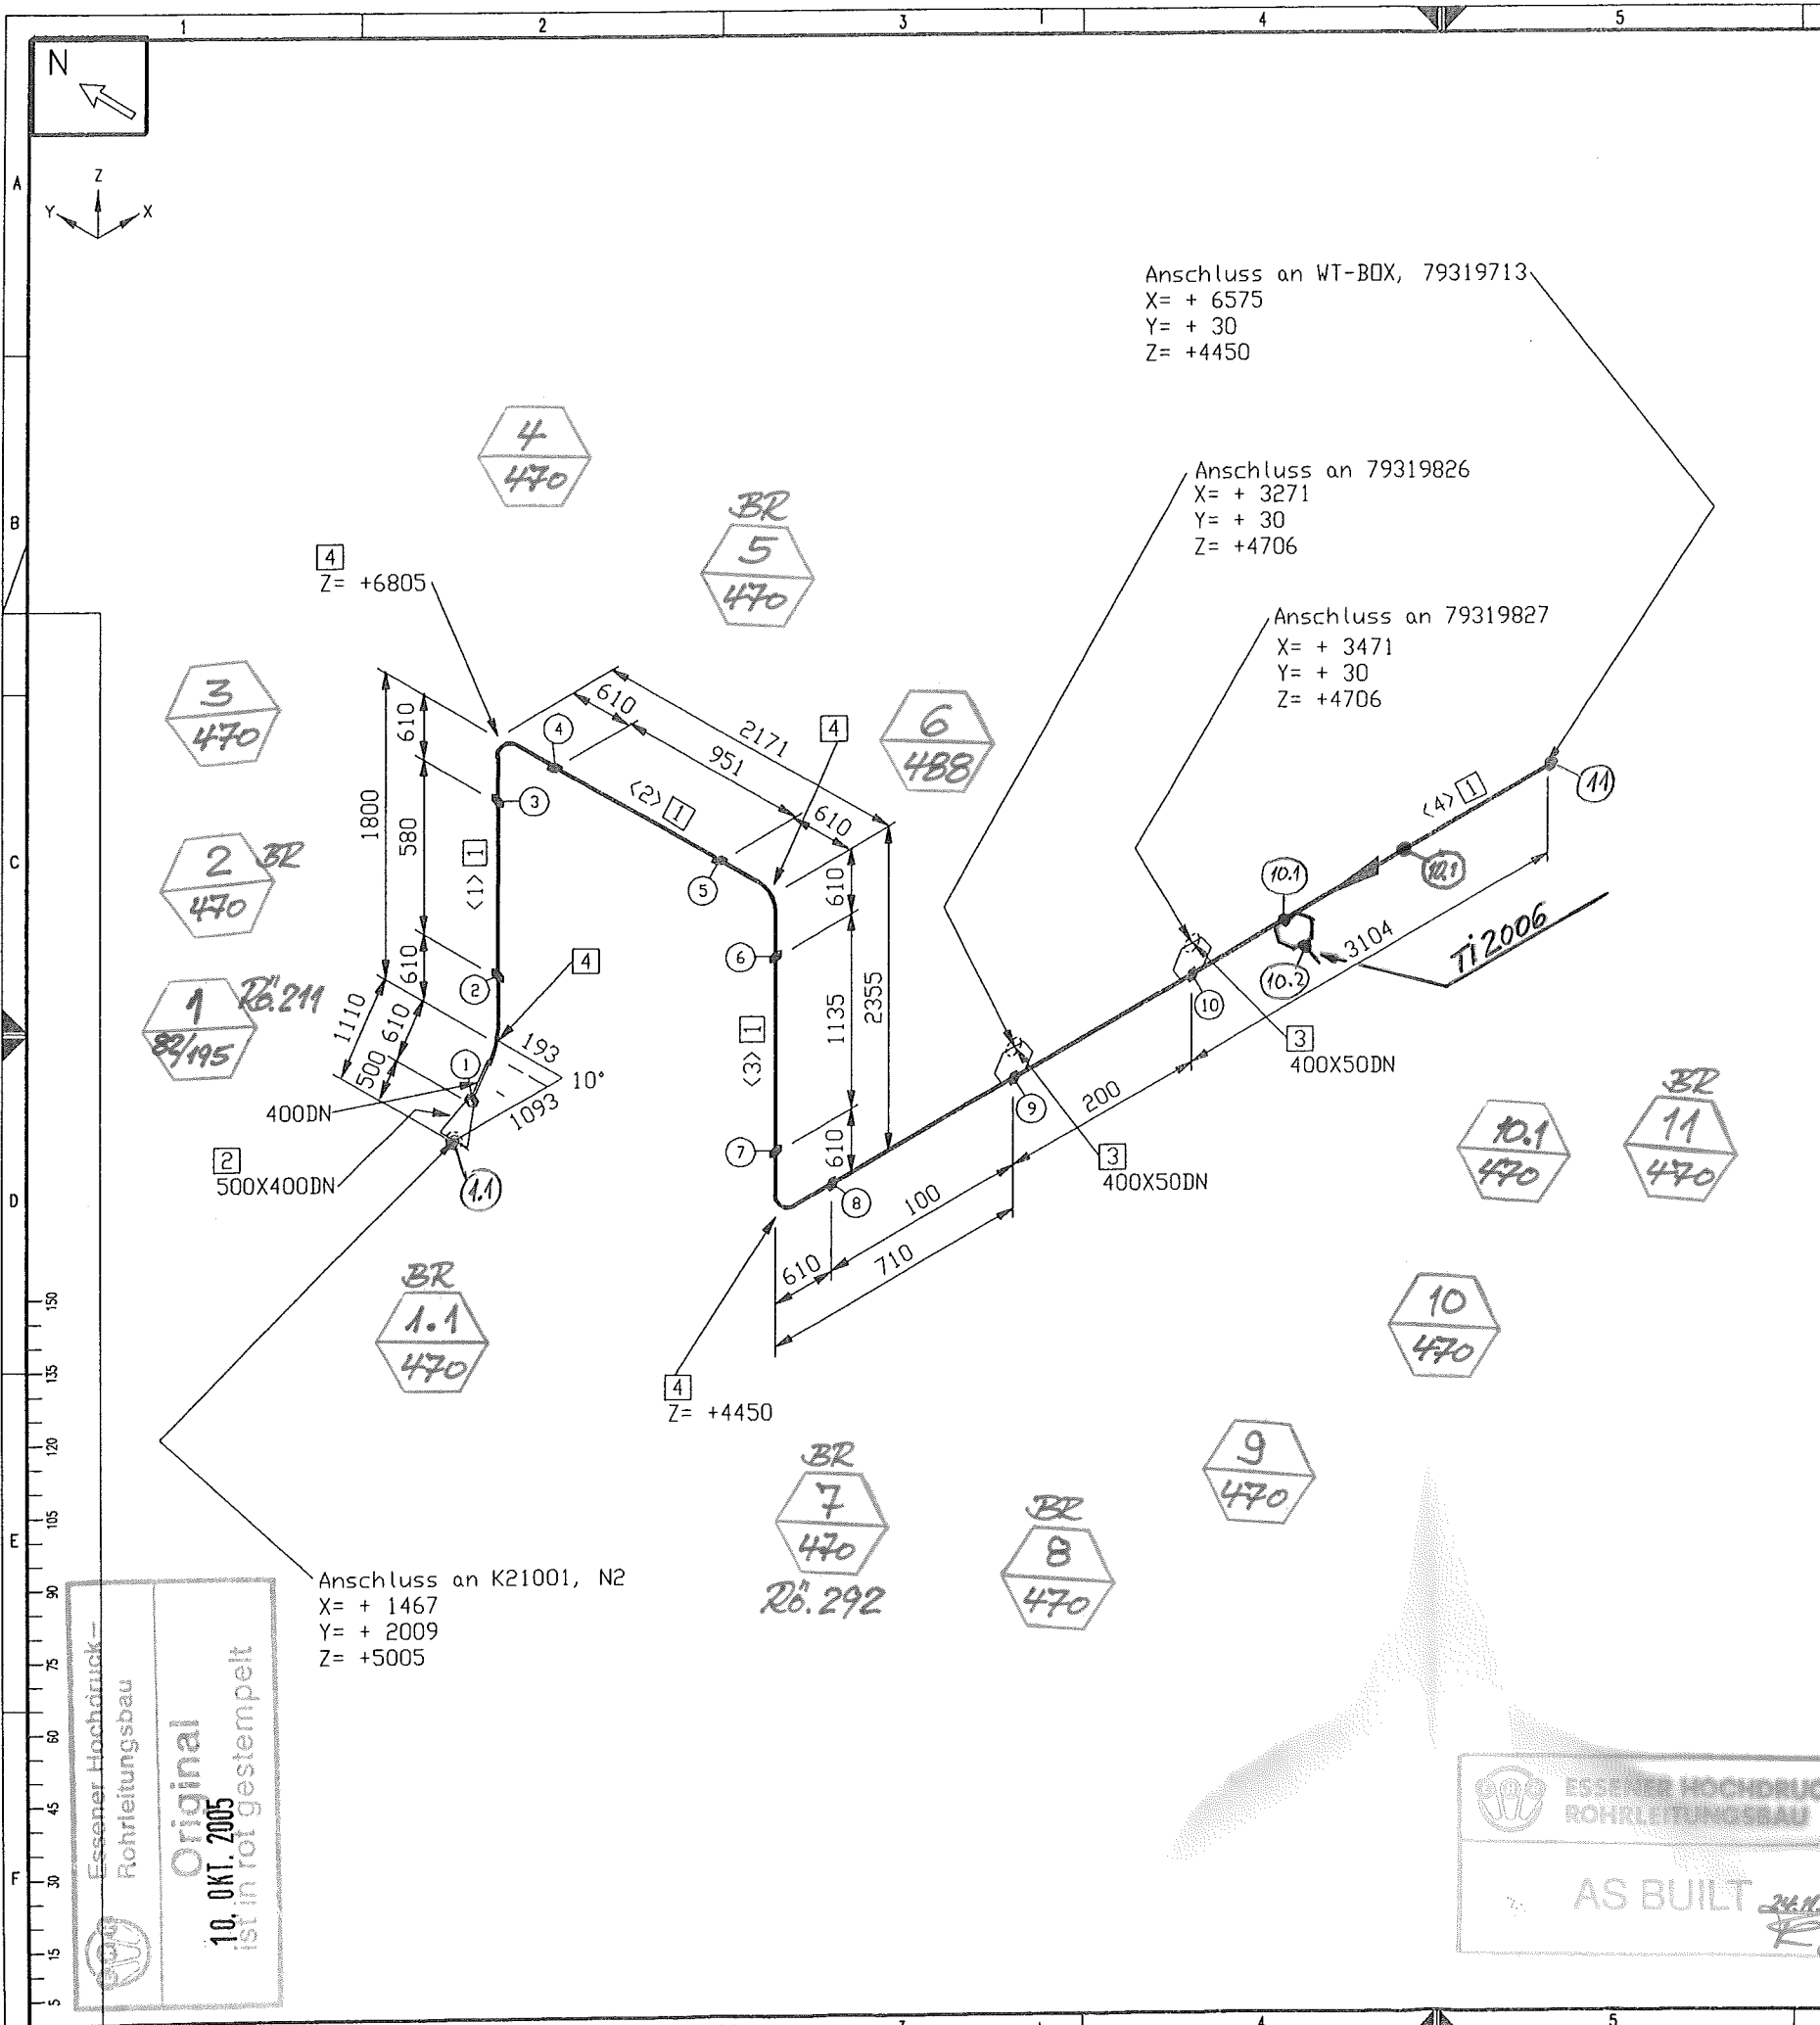

Stückliste					
Lfd. Nr.	Rohr	Benennung	DN (MM)	Sachnummer	Menge
1	ROHR 406	X 6 ALMG4, 5MN W27	400	77038231	6071 MM
Fitting					
2	RED. -STÜCK-K-508	0 x 6,0-406,0 x 6,0	500X400	79313146	1
3	T-Stutzen 406x6	- 60,3 x 3,9	400X50	79319844	2
4	BOGEN 406	x6 DIN2605-2-90-3 ALMG4, 5MN	400	77038237	4
Summe Masse					213.4

Rohrzuschnitt						
Rohr Stk.	Länge (MM)	DN (MM)	Bemerkung	Rohr Ende 1	Rohr Ende 2	Sachnummer
<1>	580	400				77038231
<2>	951	400				77038231
<3>	1135	400				77038231
<4>	3405	400				77038231

pipng support, piping guides
View from top

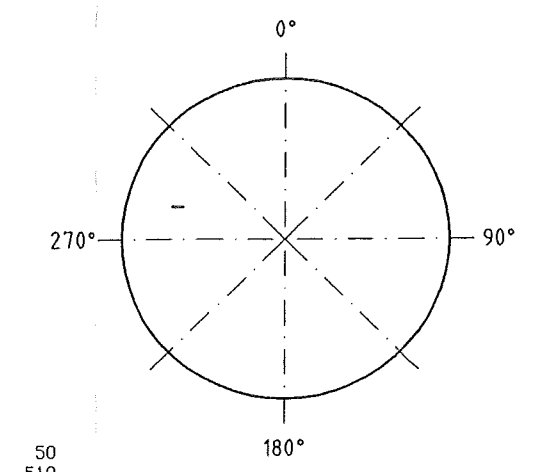

Rohr DN (MM)	500	400	50
CL Länge (MM)	500	10951	510

Essener Hochdruck-
Rohrleitungsbau
Original
10. OKT. 2005
ist in rot gestempelt

ESSENER HOCHDRUCK-
ROHRLEITUNGSBAU
AS BUILT

MATERIAL: HANAU_AL			All components cleaned for oxygen			
D	C	B	Workpiece edges	SCALE		
			±0.5	TOLERANCES:		
A	I	Rev. No.	±0.3	DN 28005		
			outside	DN 8570		
I	Date	By	inside	DIN 7168 mittel		
			ISO-Methode E	DATE: 04.08.2005		
This drawing is not to be reproduced, copied or used directly or indirectly in any way detrimental to our interests unless specifically authorized in writing by			NAME: H.Schneider			
Air Liquide AGS GmbH Hanau			CHECK: Frickhöfer 04/08/05			
JOB CODE / REFERENCE:			Replaced:			
K70101, ASU No.9 Kosice			AIR LIQUIDE			
Title:			SHEET: 1 OF SHEET: 1			
A 20015			DRAWING No.: 79319843			
			F Z C			