


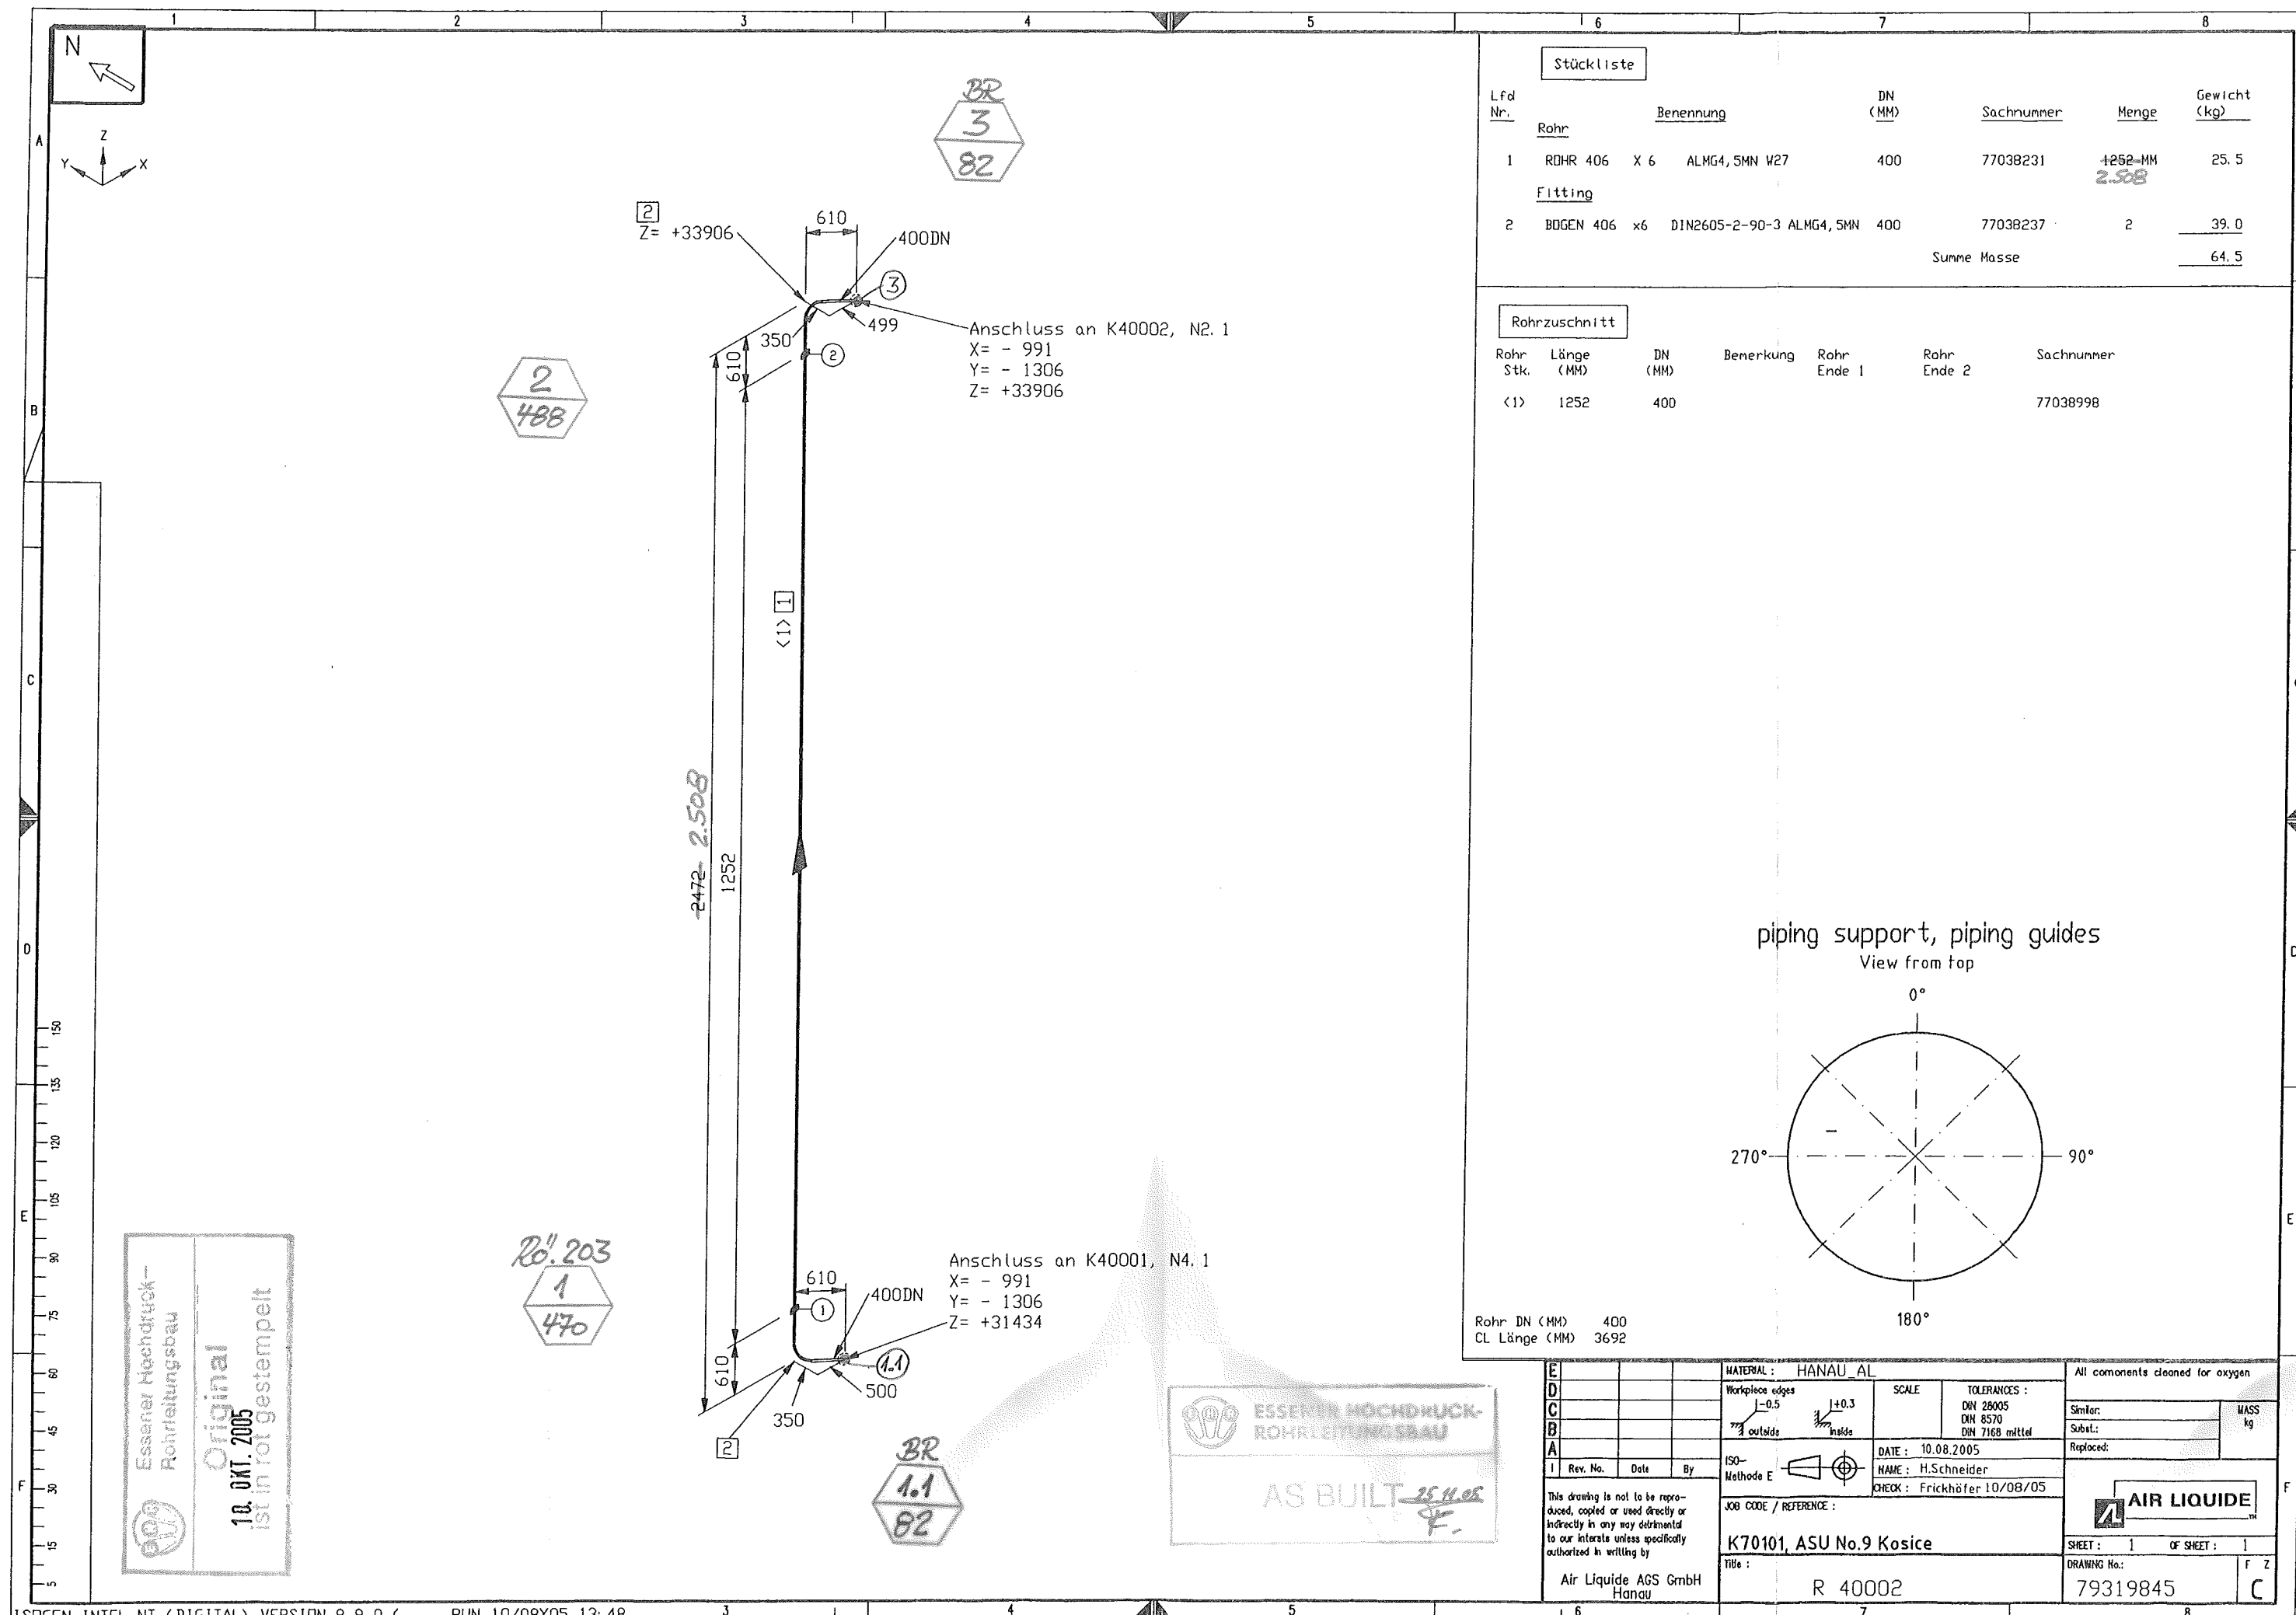


Stückliste

Lfd Nr.	Rohr	Benennung	DN (MM)	Sachnummer	Menge	Gewicht (kg)
1	RDHR 406 X 6	ALMG4, 5MN W27	400	77038231	1252 MM 2.508	25.5
Fitting						
2	BOGEN 406 x6	DIN2605-2-90-3 ALMG4, 5MN	400	77038237	2	39.0
Summe Masse						64.5

Rohrzuschnitt

Rohr Stk.	Länge (MM)	DN (MM)	Bemerkung	Rohr Ende 1	Rohr Ende 2	Sachnummer
<1>	1252	400				77038998

piping support, piping guides
View from top

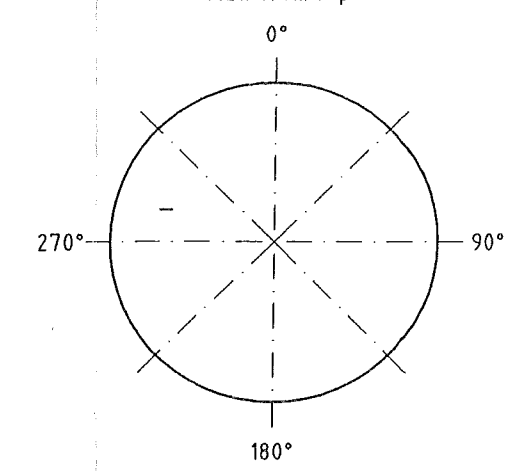

Rohr DN (MM) 400
CL Länge (MM) 3692

Essener Hochdruck-
Rohrleitungsbau
Original
18. Okt. 2005
ist in rot gestempelt

ESSENER HOCHDRUCK-
ROHRLEITUNGSBAU
AS BUILT 25.11.05
F.

E		MATERIAL : HANAU AL		All components cleaned for oxygen	
D		Workpiece edges	SCALE	TOLERANCES :	
C		1-0.5		DN 28005	Similar:
B		outside		DN 8570	Subst.:
A		inside		DN 7168 mittel	Replaced:
I	Rev. No.	Date	By	DATE : 10.08.2005	
				NAME : H.Schneider	
				CHECK : Frickhöfer 10/08/05	
ISO- Methode E				JOB CODE / REFERENCE :	
This drawing is not to be reproduced, copied or used directly or indirectly in any way detrimental to our interests unless specifically authorized in writing by				K70101, ASU No.9 Kosice	
Air Liquide AGS GmbH Hanau				Tüte : R 40002	
				SHEET : 1 OF SHEET : 1	
				DRAWING No.: 79319845	
				F Z C	