



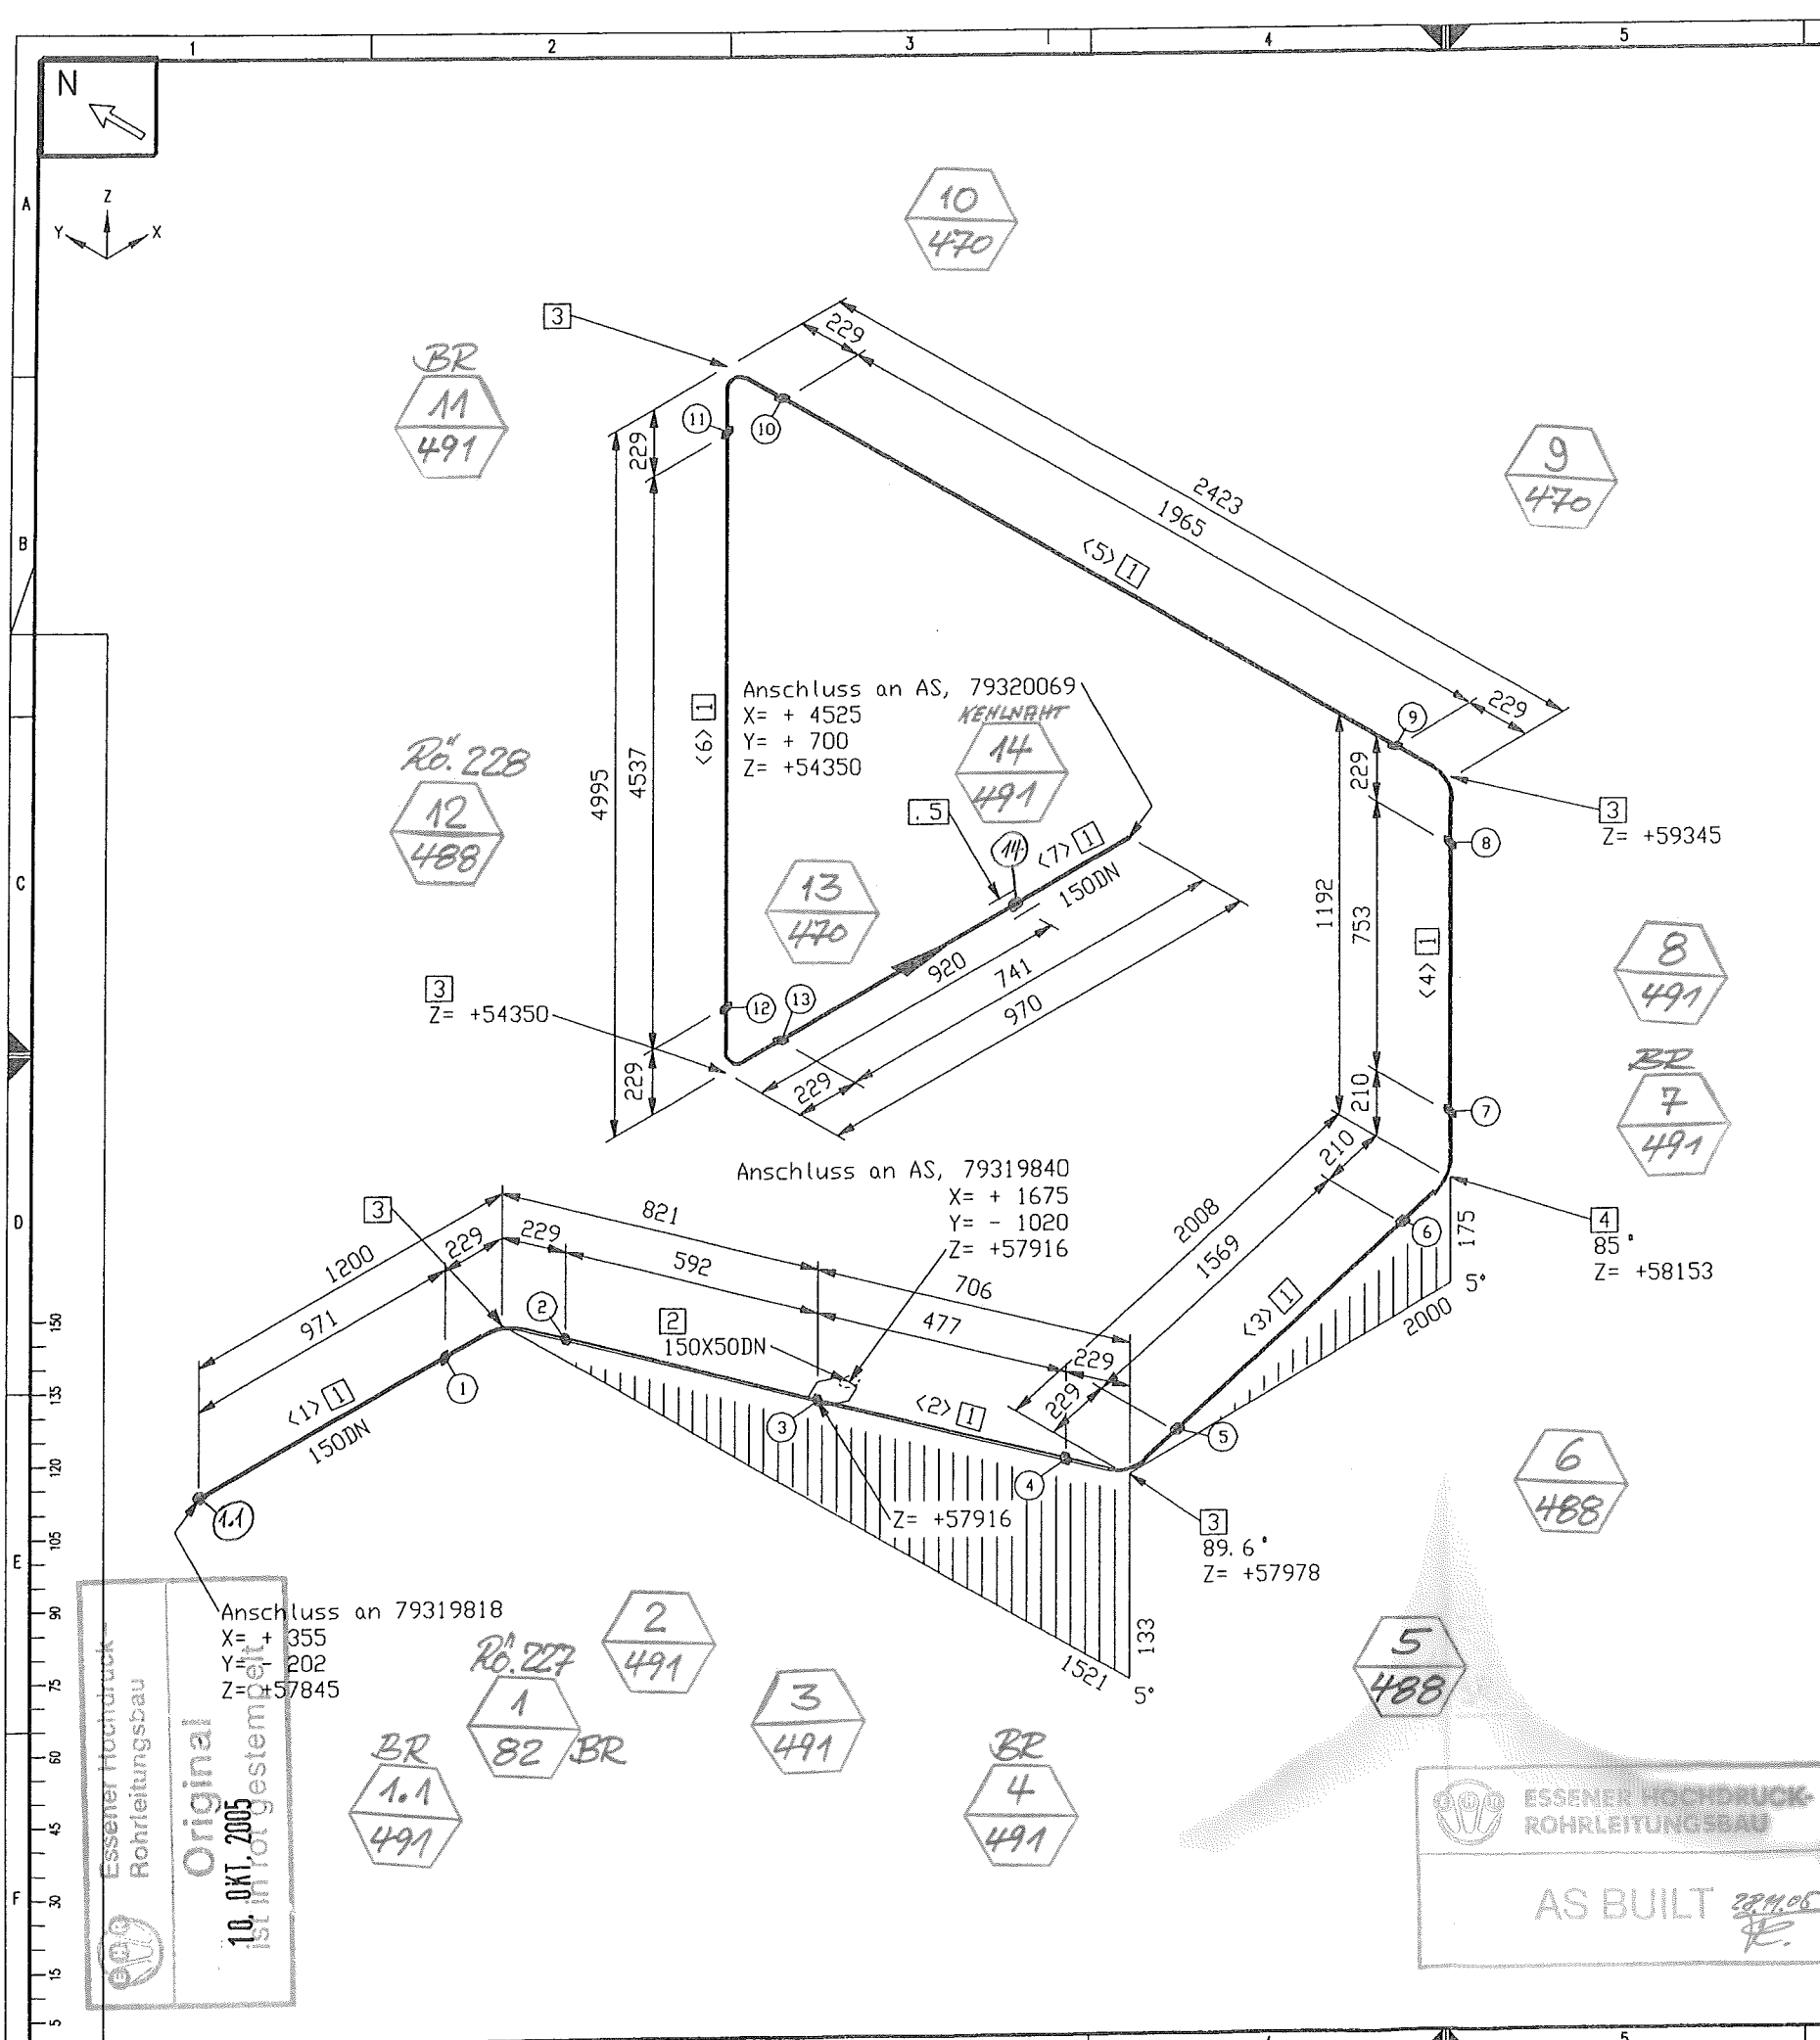

Stückliste					
Lfd. Nr.	Benennung	DN (MM)	Sachnummer	Menge	Gewicht (kg)
Rohr					
1	ROHR 168,3 X 7,1 ALMG4,5MN W27	150	77038150	11605 MM	112.7
Fitting					
2	T-Stutzen 168,3x7,1 - 60,3x3,9	150X50	79310708	1	0.1
3	BOGEN 168,3x7,1 DIN2605-2-90-3 ALMG4,5MN	150	77038158	5	17.5
4	BOGEN 168,3x7,1 DIN2605-2-90-3 ALMG4,5MN	150	77038158_1	1	3.5
Halterung					
5	Bordscheibe gez. auf 79313040	150	79313046	1	1.1
Summe Masse					134.7

Rohrzuschnitt						
Rohr Stk.	Länge (MM)	DN (MM)	Bemerkung	Rohr Ende 1	Rohr Ende 2	Sachnummer
<1>	971	150				77038150
<2>	1069	150				77038150
<3>	1569	150				77038150
<4>	753	150				77038150
<5>	1965	150				77038150
<6>	4537	150				77038150
<7>	741	150				77038150

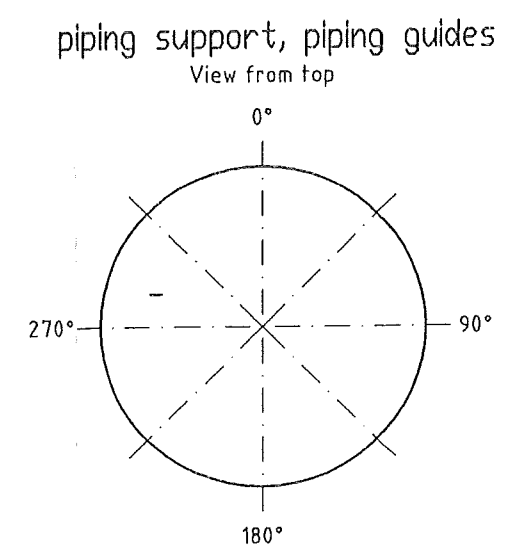

Rohr DN (MM) 150 50
CL Länge (MM) 14315 120

Essener Hochdruck
Rohrleitungsbau
Original
10. Okt. 2005
1st mal gestempelt

ESSENER HOCHDRUCK-
ROHRLEITUNGSBAU
AS BUILT 22.10.05

MATERIAL: HANAU AL		SCALE		TOLERANCES:		All components cleaned for oxygen	
Workpiece edges		+0.3		DN 28005		Similar:	
-0.5		inside		DN 8570		Subst.:	
outside				DN 7168 mittel		Replaced:	
ISO-Methode E		DATE: 11.08.2005		NAME: H.Schneider		AIR LIQUIDE	
JOB CODE / REFERENCE:		CHECK: Frickhöfer 11/08/05		SHEET: 1		OF SHEET: 1	
Title:		K70101, ASU No.9 Kosice		DRAWING No.:		F 2	
Air Liquide AGS GmbH Hanau		R 40015		79319849		C	