
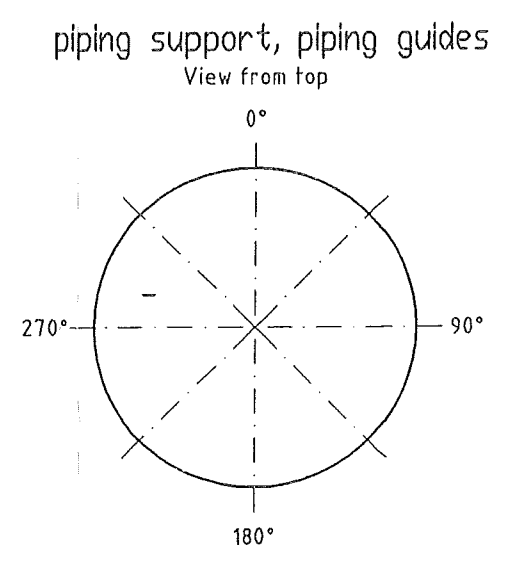
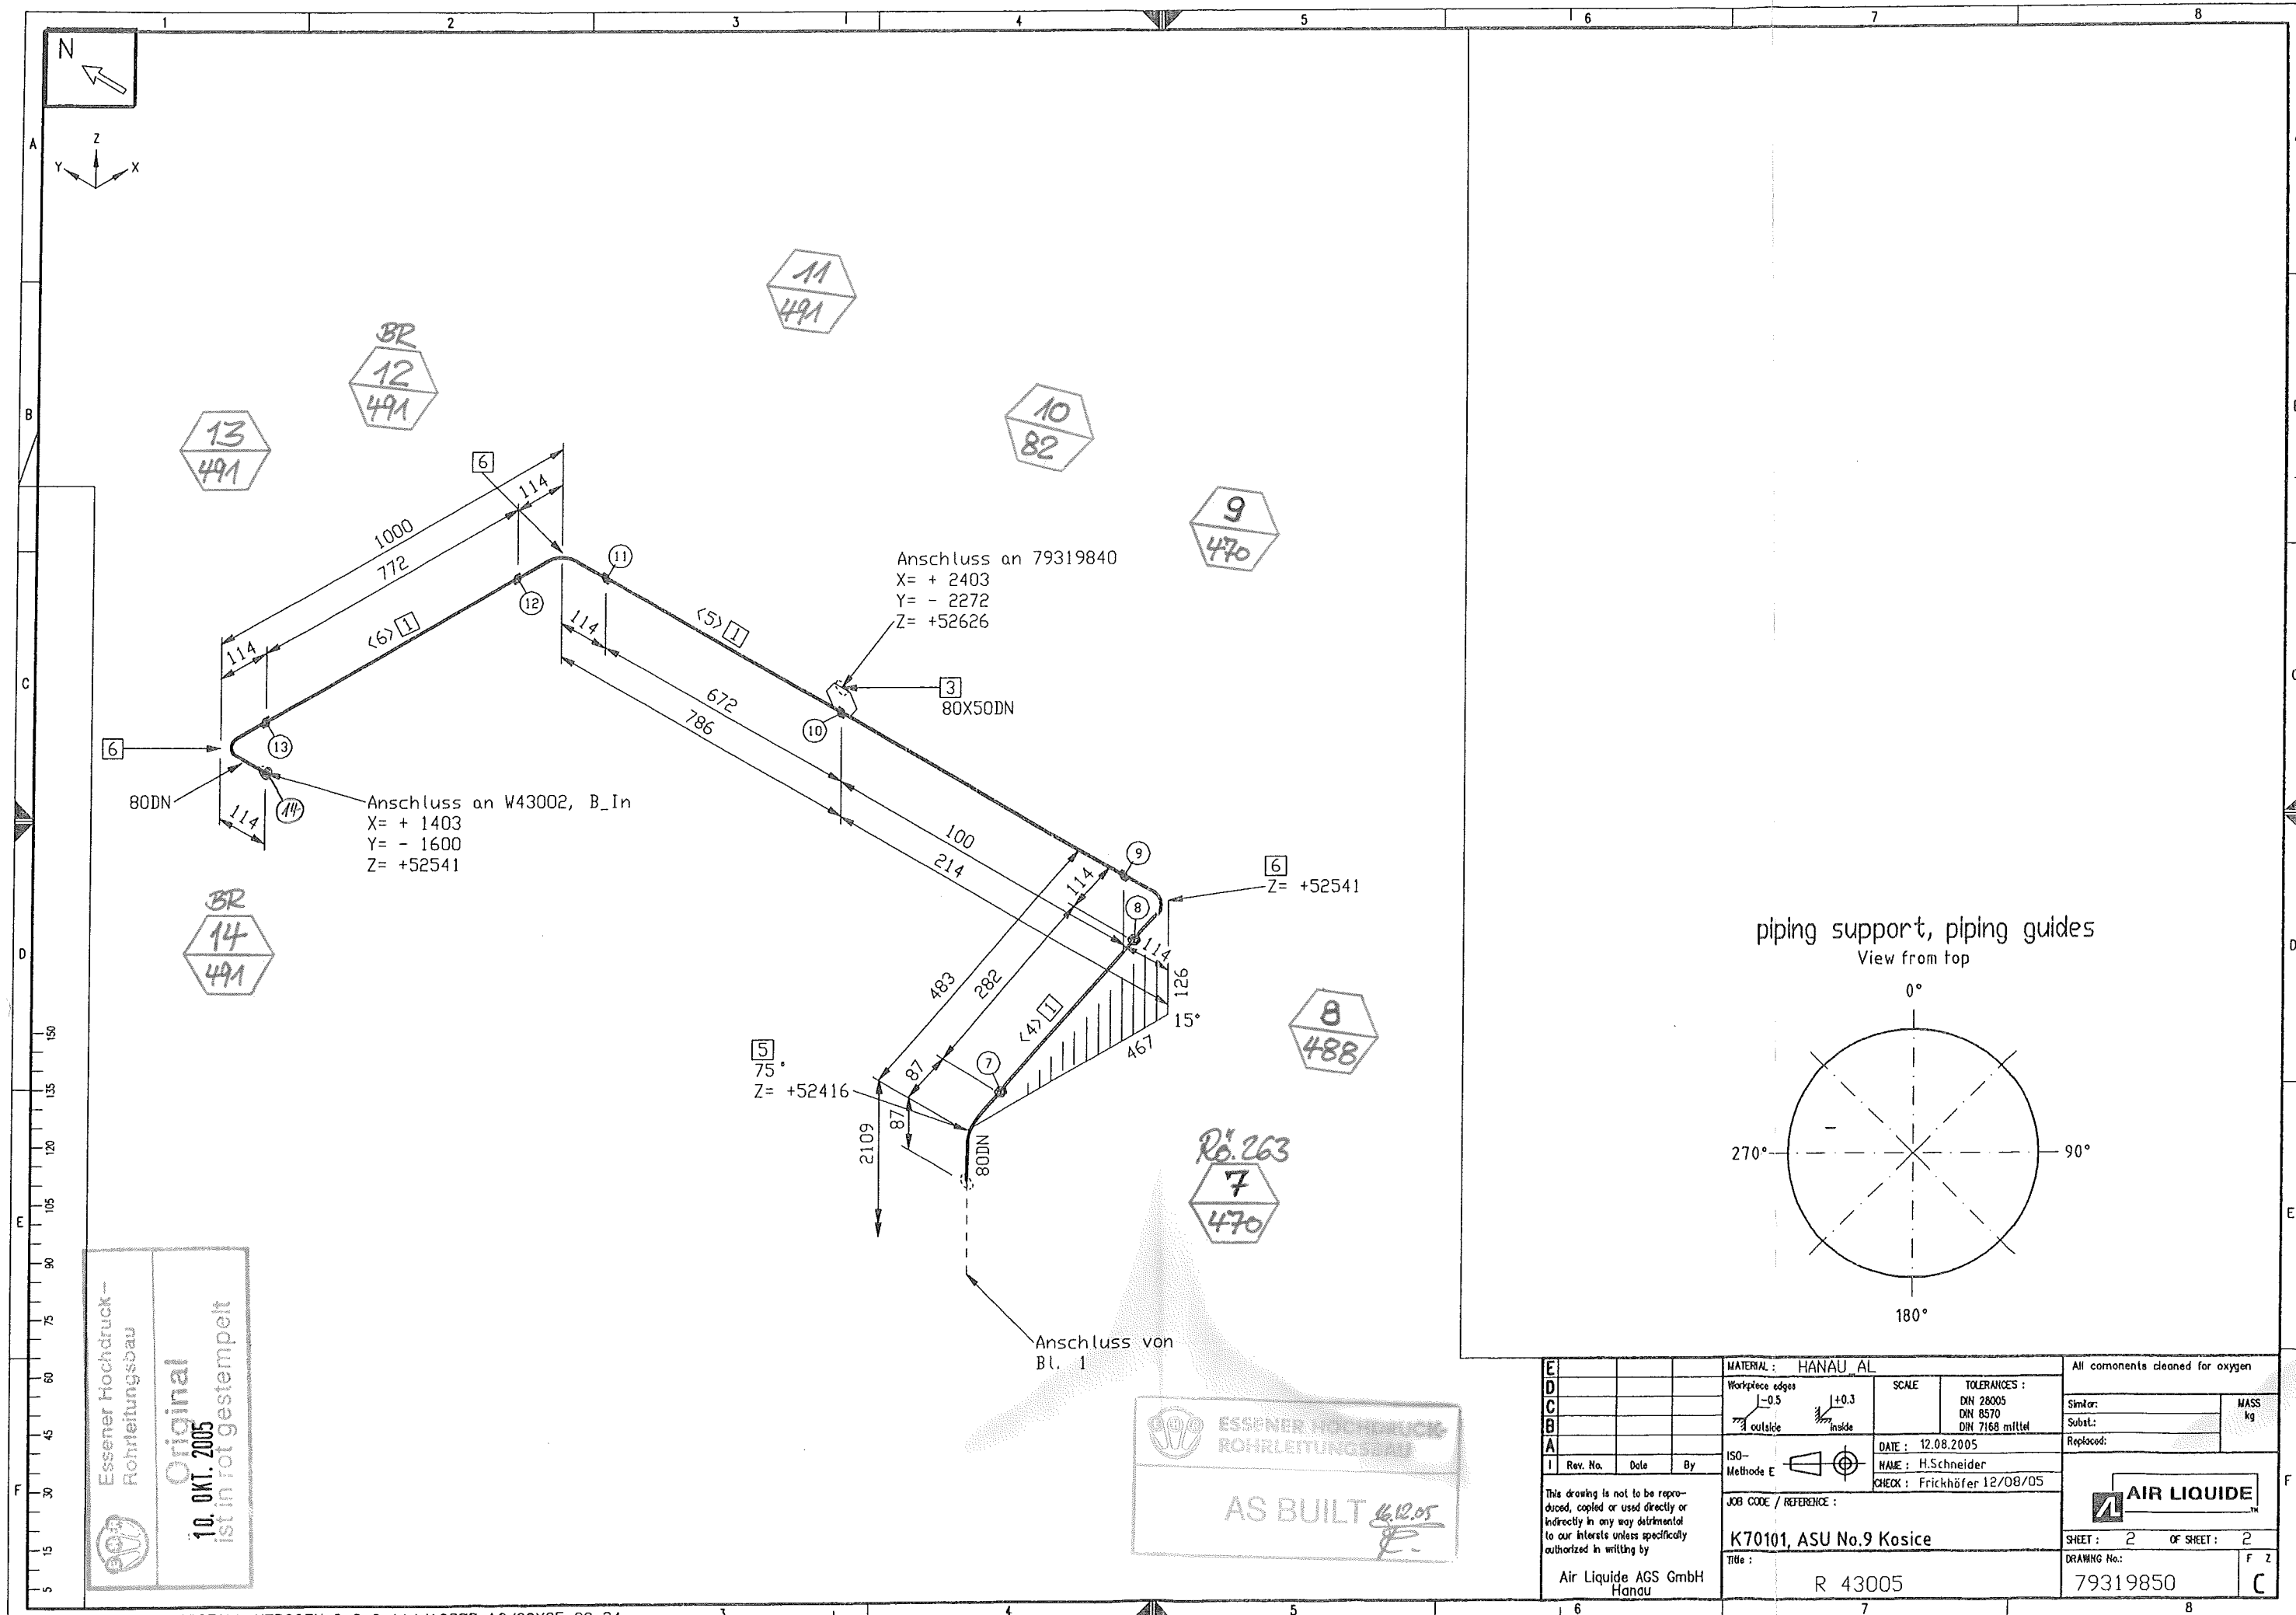 




E				MATERIAL : HANAU AL	All components cleaned for oxygen			
D				Workpiece edges -0.5 outside +0.3 inside	SCALE	TOLERANCES : DIN 28005 DIN 8570 DIN 7168 mittel	Similar: Subst.:	MASS kg
C					DATE : 12.08.2005 NAME : H.Schneider CHECK : Frickhöfer 12/08/05			
B				ISO-Methode E		Replacod:	 AIR LIQUIDE TM	F Z
A				JOB CODE / REFERENCE : K70101, ASU No.9 Kosice				
I	Rev. No.	Date	By	Title : R 43005		DRAWING No.: 79319850	C	
This drawing is not to be reproduced, copied or used directly or indirectly in any way detrimental to our interests unless specifically authorized in writing by Air Liquide AGS GmbH Hanau								
6				7		8		

Essener Hochdruck-
 Rohrleitungsbau
 Original
 10. OKT. 2005
 ist in rot gestempelt

ESSENER HOCHDRUCK-
 ROHRLEITUNGSBAU
 AS BUILT 16.12.05