


ISOMETRIE UM 45° GEDREHT GEZEICHNET

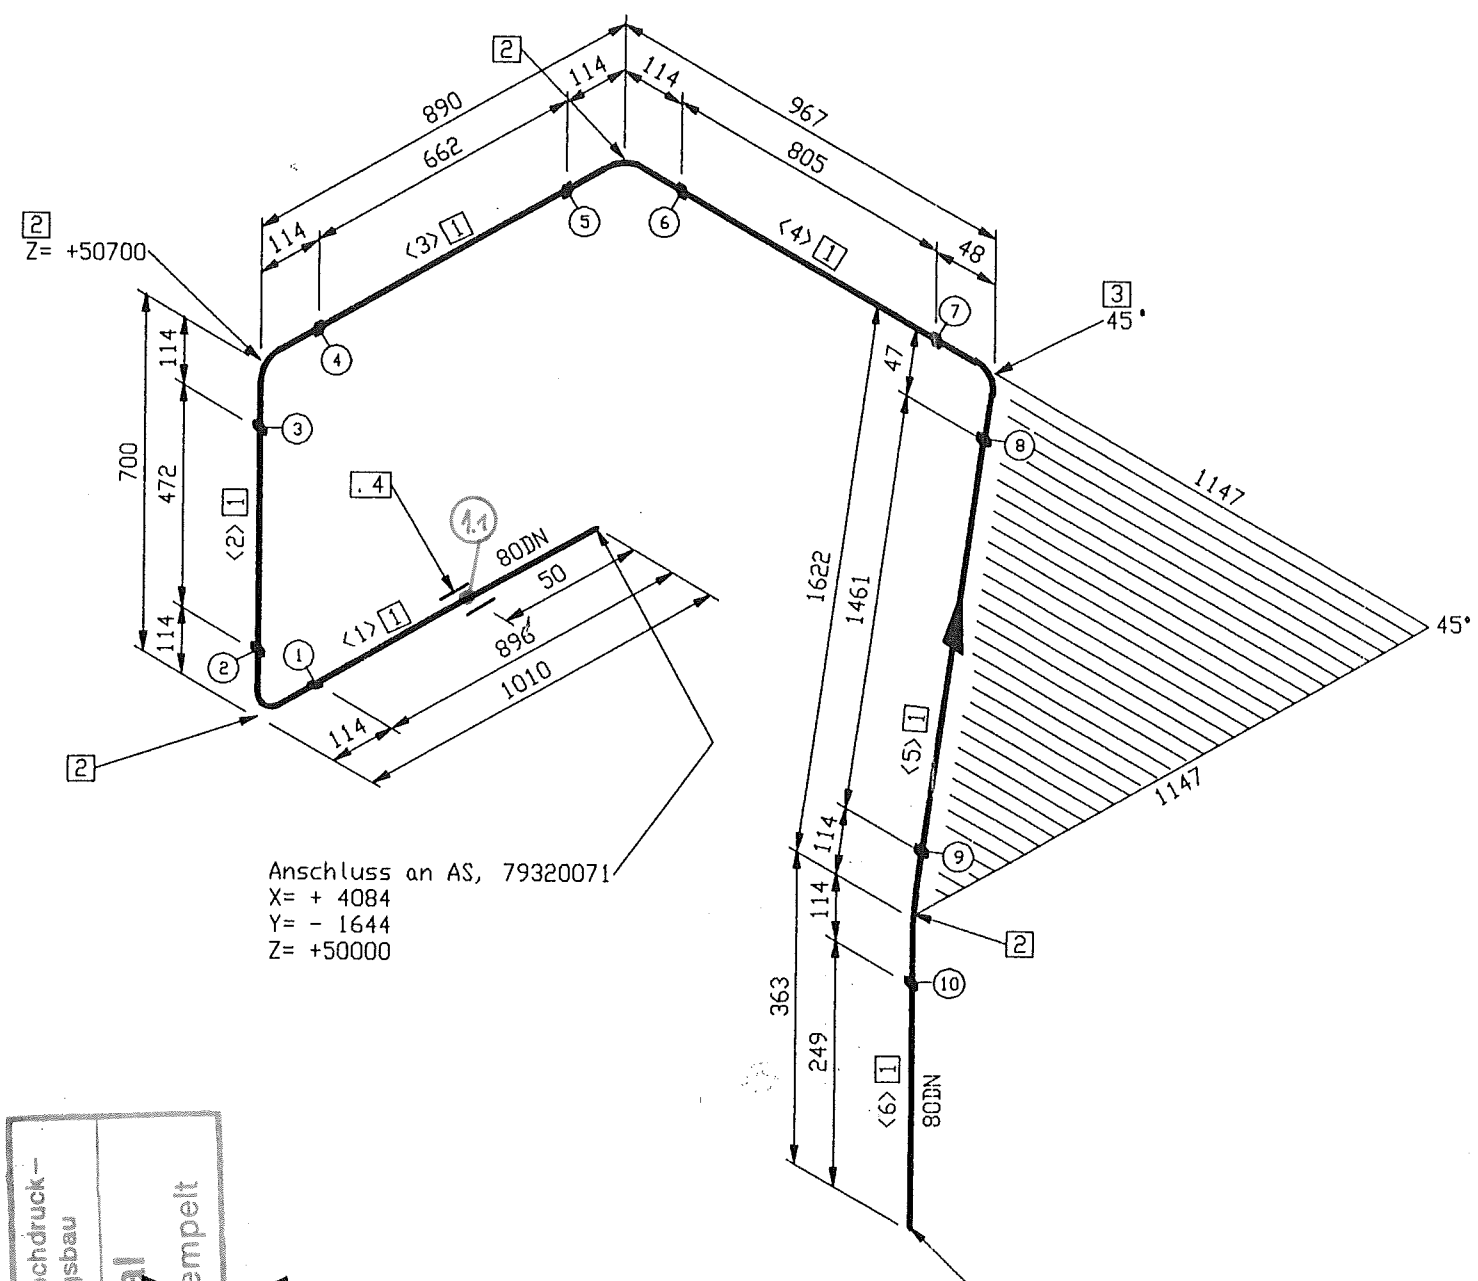

Anschluss an AS, 79320071
X= + 4084
Y= - 1644
Z= +50000

Anschluss an 79319850
X= + 1693
Y= - 2243
Z= +50337

=VENTILKASTEN 3, Vormontage
valve box 3, pre-fabricating

Essener Hochdruck-
Rohrleitungsbau
Original
ist in rot gestempelt

- 1.1
160
- 1
160 BR
- 2
160
- 3
160
- 4
160
- 5
160
- 6
160 BR
- 7
160
- 8
160 BR
- 9
160
- 10
160

Stückliste

Lfd. Nr.	Benennung	DN (MM)	Sachnummer	Menge	Gewicht (kg)
1	ROHR 88,9 X 5,5 ALMG4, 54N V27	80	77038147	4545 MM	17.7
Fitting					
2	BOGEN 88,9x5,5 DIN2605-2-90-3 ALMG4, 54N	80	77038156	4	2.8
3	BOGEN 88,9x5,5 DIN2605-2-90-3 ALMG4, 54N	80	77038156_1	1	0.7
Stützen auf 45					
Halterung					
4	Bordscheibe gez. auf 79313040	80	79313043	1	-
Summe Masse					21.2


Rohrzuschnitt

Rohr Stk.	Länge (MM)	DN (MM)	Bemerkung	Rohr Ende 1	Rohr Ende 2	Sachnummer
<1>	896	80				77038147
<2>	472	80				77038147
<3>	662	80				77038147
<4>	805	80				77038147
<5>	1461	80				77038147
<6>	249	80				77038147

MATERIAL KONTR.		
CHECK OF MAT.		
SCHWEISSEN		
WELDING		
MECHAN. FERTIGST.		
MECHAN. COMPL.		
DRUCKPROBE		
PRESSURE TEST		
EHR-PROJ.-NO.:	C-13005	
	ESSENER HOCHDRUCK- ROHRLEITUNGSBAU GMBH	Air Liquide AGS GmbH

ESSENER HOCHDRUCK-
ROHRLEITUNGSBAU
AS BUILT

piping support, piping guides
View from top

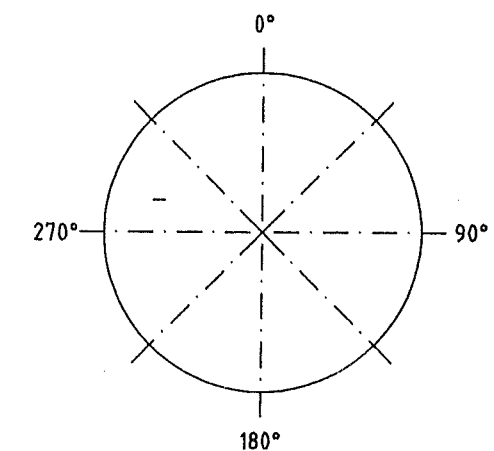

Rohr DN (MM) 80
CL Länge (MM) 5552

MATERIAL: HANAU_AL		SCALE		TOLERANCES:		All components cleaned for oxygen	
Workpiece edges		1-0.5		DN 28005		Similar:	
3 outside		1+0.3 inside		DN 8570		Subst:	
				DN 7168 millal		Replaced:	
Rev. No.		Date		By		DATE: 06.07.2005	
1						NAME: H.Schnelder	
						CHECK: Frickhöfer 06/07/05	
						JOB CODE / REFERENCE:	
						K70101, ASU No.9 Kosice	
						Title:	
						A 15046	
						SHEET: 1 OF SHEET: 1	
						DRAWING No:	
						79319851	
						F Z	
						C	