
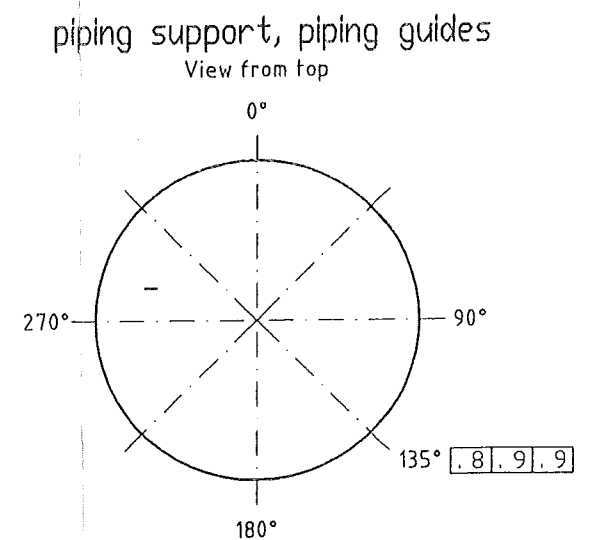


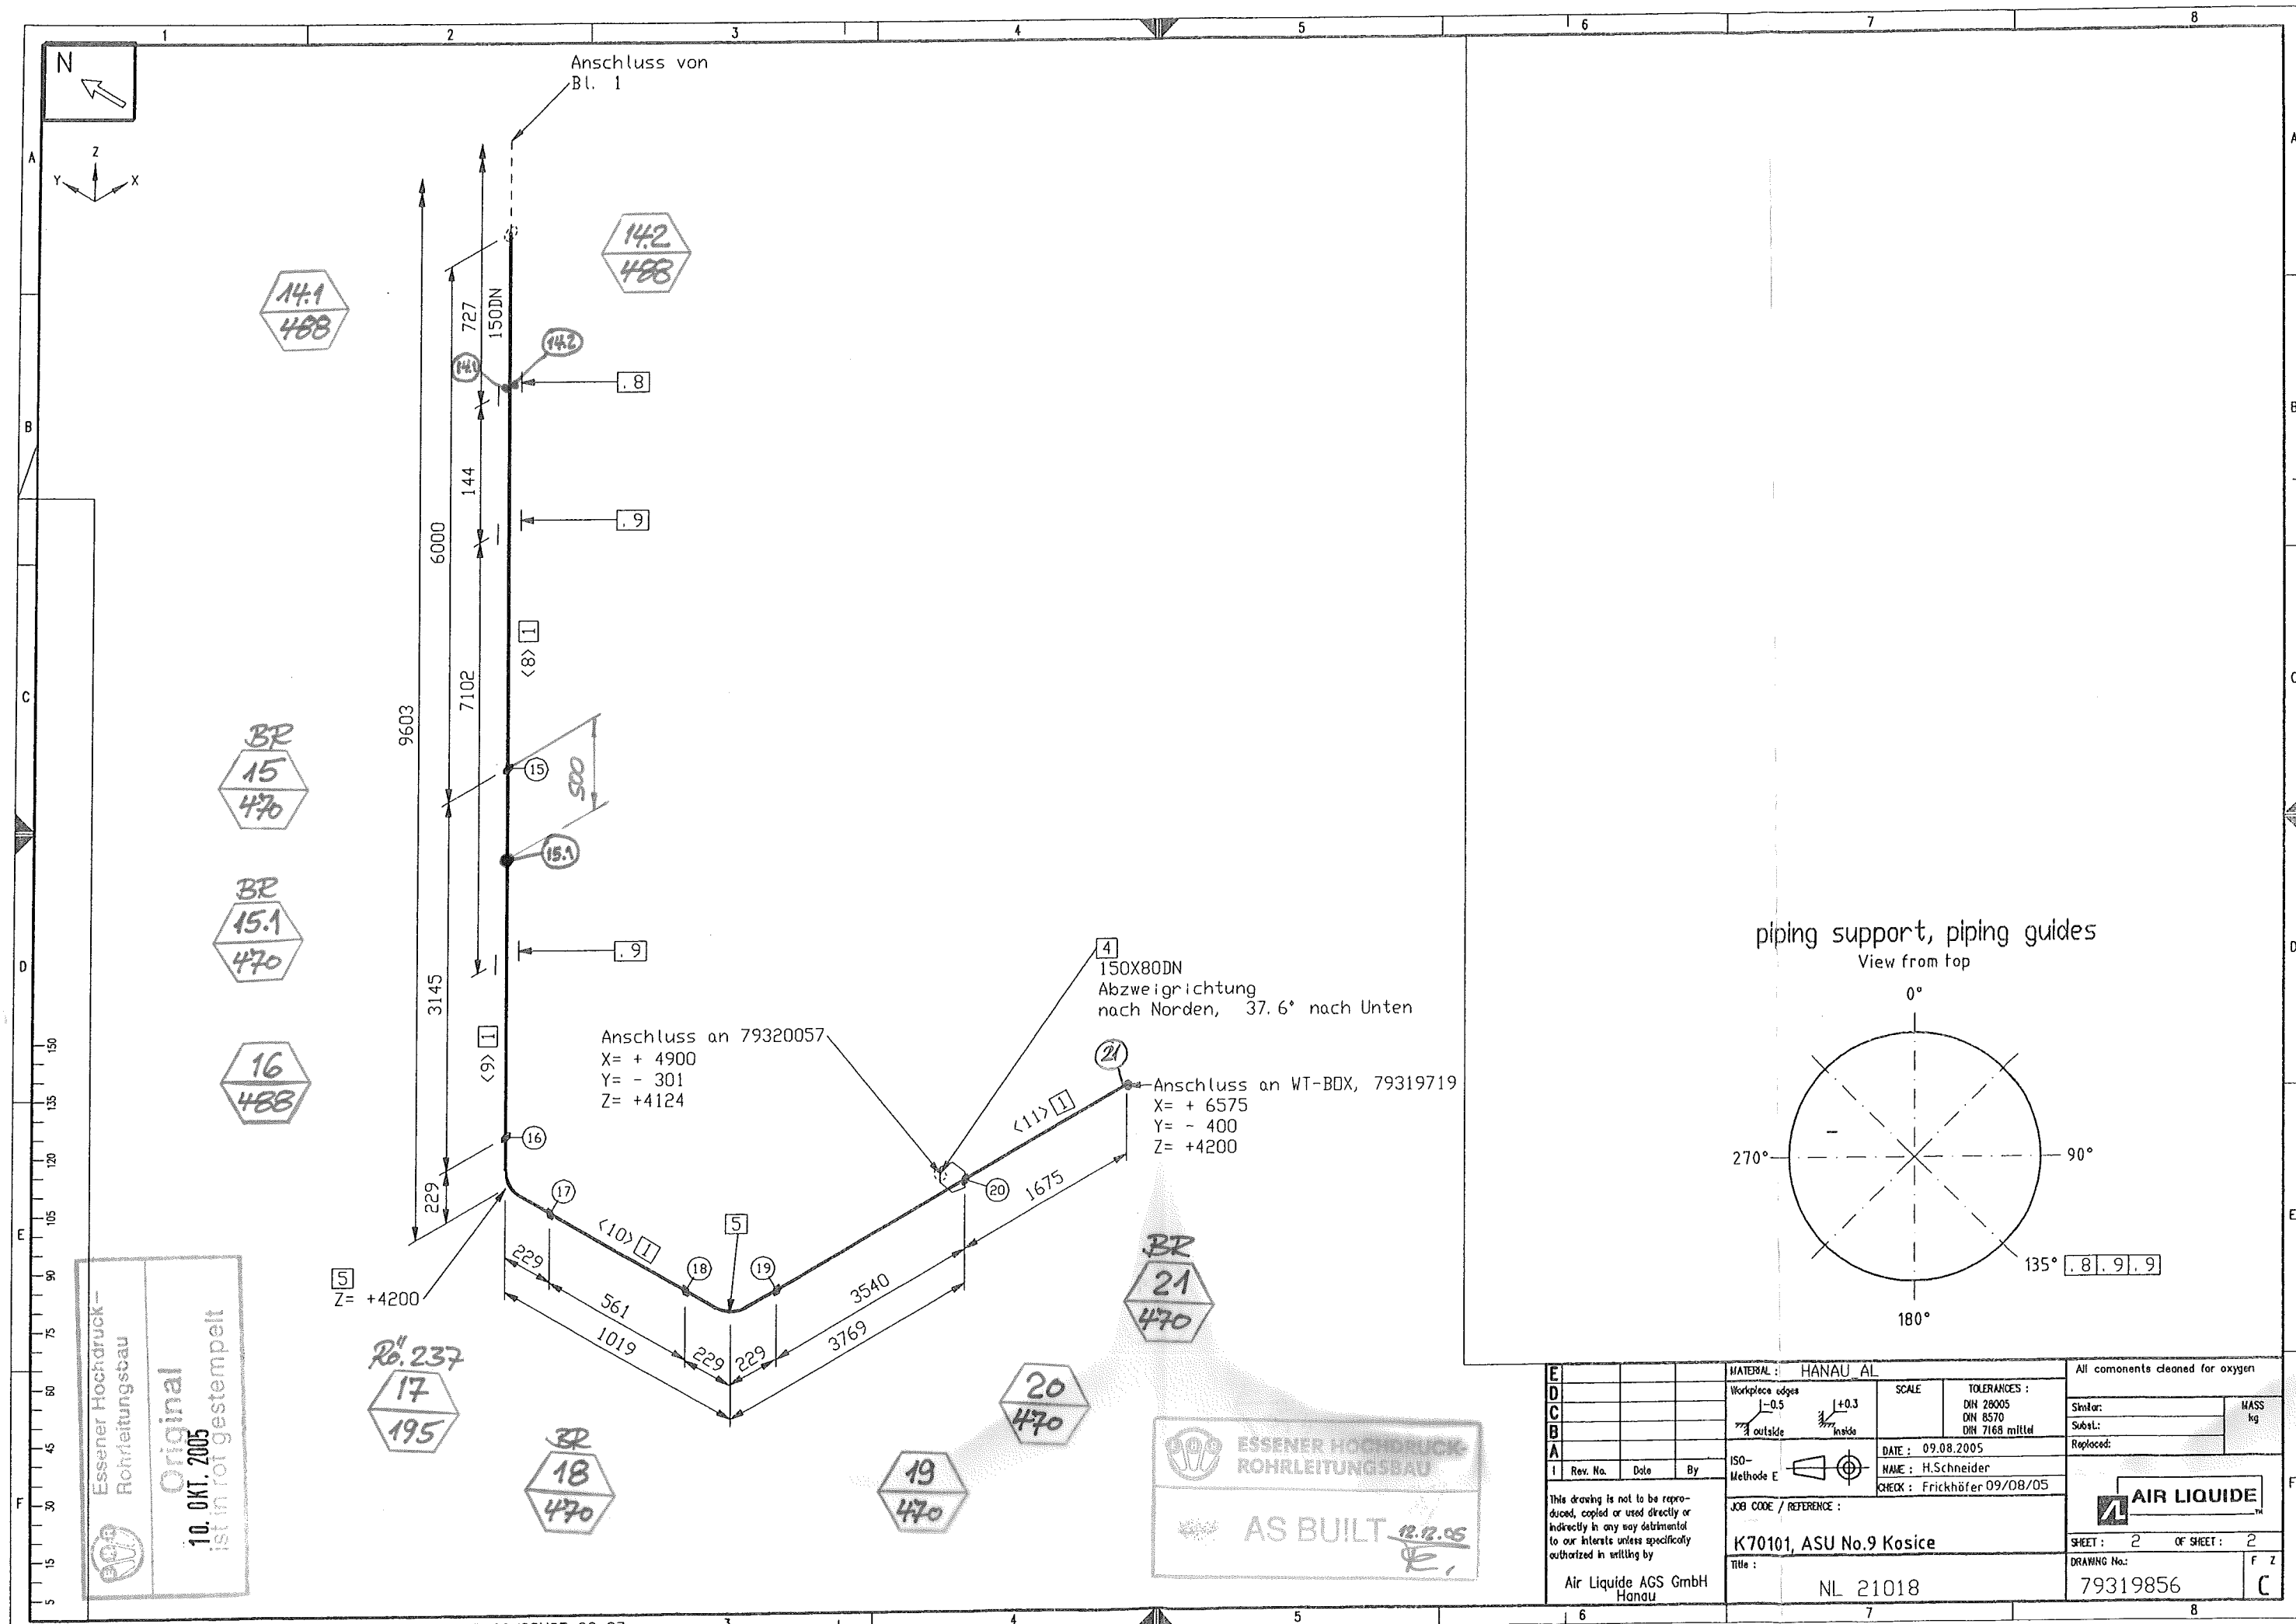

Essener Hochdruck-
Rohrleitungsbau
Original
10. OKT. 2005
ist in rot gestempelt

ESSENER HOCHDRUCK-
ROHRLEITUNGSBAU
AS BUILT 12.12.05

E				MATERIAL : HANAU AL	All components cleaned for oxygen	
D				Workpiece edges	SCALE	TOLERANCES :
C						DIN 28005 DIN 8570 DIN 7168 mittel
B				ISO-	DATE : 09.08.2005	Similar: Subst: Replaced:
A				Methode E 	NAME : H.Schneider CHECK : Frickhöfer 09/08/05	
I	Rev. No.	Date	By	JOB CODE / REFERENCE :		SHEET : 2 OF SHEET : 2
This drawing is not to be reproduced, copied or used directly or indirectly in any way detrimental to our interests unless specifically authorized in writing by				K70101, ASU No.9 Kosice		
				TITLE :		F Z C
Air Liquide AGS GmbH Hanau				NL 21018		