

Anschluss von
Bl. 1

65°
97MM Biegeradius
Z= +6428

75° **BOGEN**
67MM Biegeradius
Z= +5603

Z= +5429

Anschluss an
Bl. 3

97MM Biegeradius
Z= +5283

Anschluss an
Bl. 4

Essener Hochdruck
Rohrleitungsbau
Original
10. OKT. 2005
ist in rot gestempelt


ESSENER HOCHDRUCK-
ROHRLEITUNGSBAU
AS BUILT

Rohrzuschnitt

Rohr Stk.	Länge (MM)	DN (MM)	Bemerkung	Rohr Ende 1	Rohr Ende 2	Sachnummer
<1>	190	50	PLD BEND<1>			77038146
<2>	6000	40				77038145
<3>	1664	40				77038145
<4>	127	40	PLD BEND<1>			77038145
<5>	484	40				77038145
<6>	74	40	PLD BEND<1>			77038145
<7>	1074	40				77038145
<8>	142	40	PLD BEND<1>			77038145
<9>	1958	40				77038145
<10>	43	40	PLD BEND<1>			77038145
<11>	1920	40				77038145
<12>	152	40	PLD BEND<1>			77038145
<13>	1374	40				77038145
<14>	110	40	PLD BEND<1>			77038145
<15>	582	40				77038145
<16>	23	25				77038144
<17>	87	25	PLD BEND<1>			77038144
<18>	263	25				77038144
<19>	104	25	PLD BEND<1>			77038144
<20>	171	25				77038144
<21>	87	25	PLD BEND<1>			77038144
<22>	435	25				77038144
<23>	87	25	PLD BEND<1>			77038144
<24>	526	25				77038144
<25>	103	25	PLD BEND<1>			77038144
<26>	17	25				77038144
<27>	105	25	PLD BEND<1>			77038144
<28>	50	25				77038144
<29>	80	25				0002063
<30>	67	25	PLD BEND<1>			0002063
<31>	188	25				0002063
<32>	109	40				77038145
<33>	151	40	PLD BEND<1>			77038145
<34>	339	40				77038145
<35>	152	40	PLD BEND<1>			77038145
<36>	69	40				77038145
<37>	152	40	PLD BEND<1>			77038145
<38>	250	40				77038145
<39>	153	40	PLD BEND<1>			77038145
<40>	689	40				77038145
<41>	151	40	PLD BEND<1>			77038145
<42>	75	40				77038145
<43>	126	40	PLD BEND<1>			77038145
<44>	176	40				77038145
<45>	19	40				77038145
<46>	151	40	PLD BEND<1>			77038145
<47>	158	40				77038145

* Anschluss von Bl. 1 *

piping support, piping guides
View from top

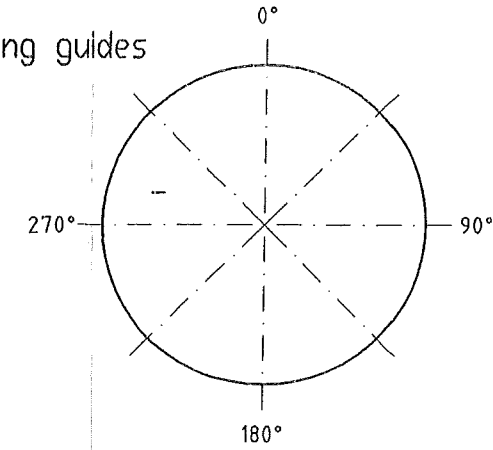

E		MATERIAL: HANAU_AL		All components cleaned for oxygen	
D		Workpiece edges		SCALE	
C		-0.5		TOLERANCES:	
B		outside		DIN 28005	
A		inside		DIN 8570	
I		ISO-Methode E		DIN 7168 mittel	
Rev. No.		Date		By	
1		22.08.2005		H. Schneider	
CHECK		Frickhöfer 22/08/05		Replaced:	
This drawing is not to be reproduced, copied or used directly or indirectly in any way detrimental to our interests unless specifically authorized in writing by		JOB CODE / REFERENCE:		SHEET: 2 OF SHEET: 5	
Air Liquide AGS GmbH Hanau		K70101, ASU No.9 Kosice		DRAWING No.: 79319858	
Title:		NL 73001		F Z C	