
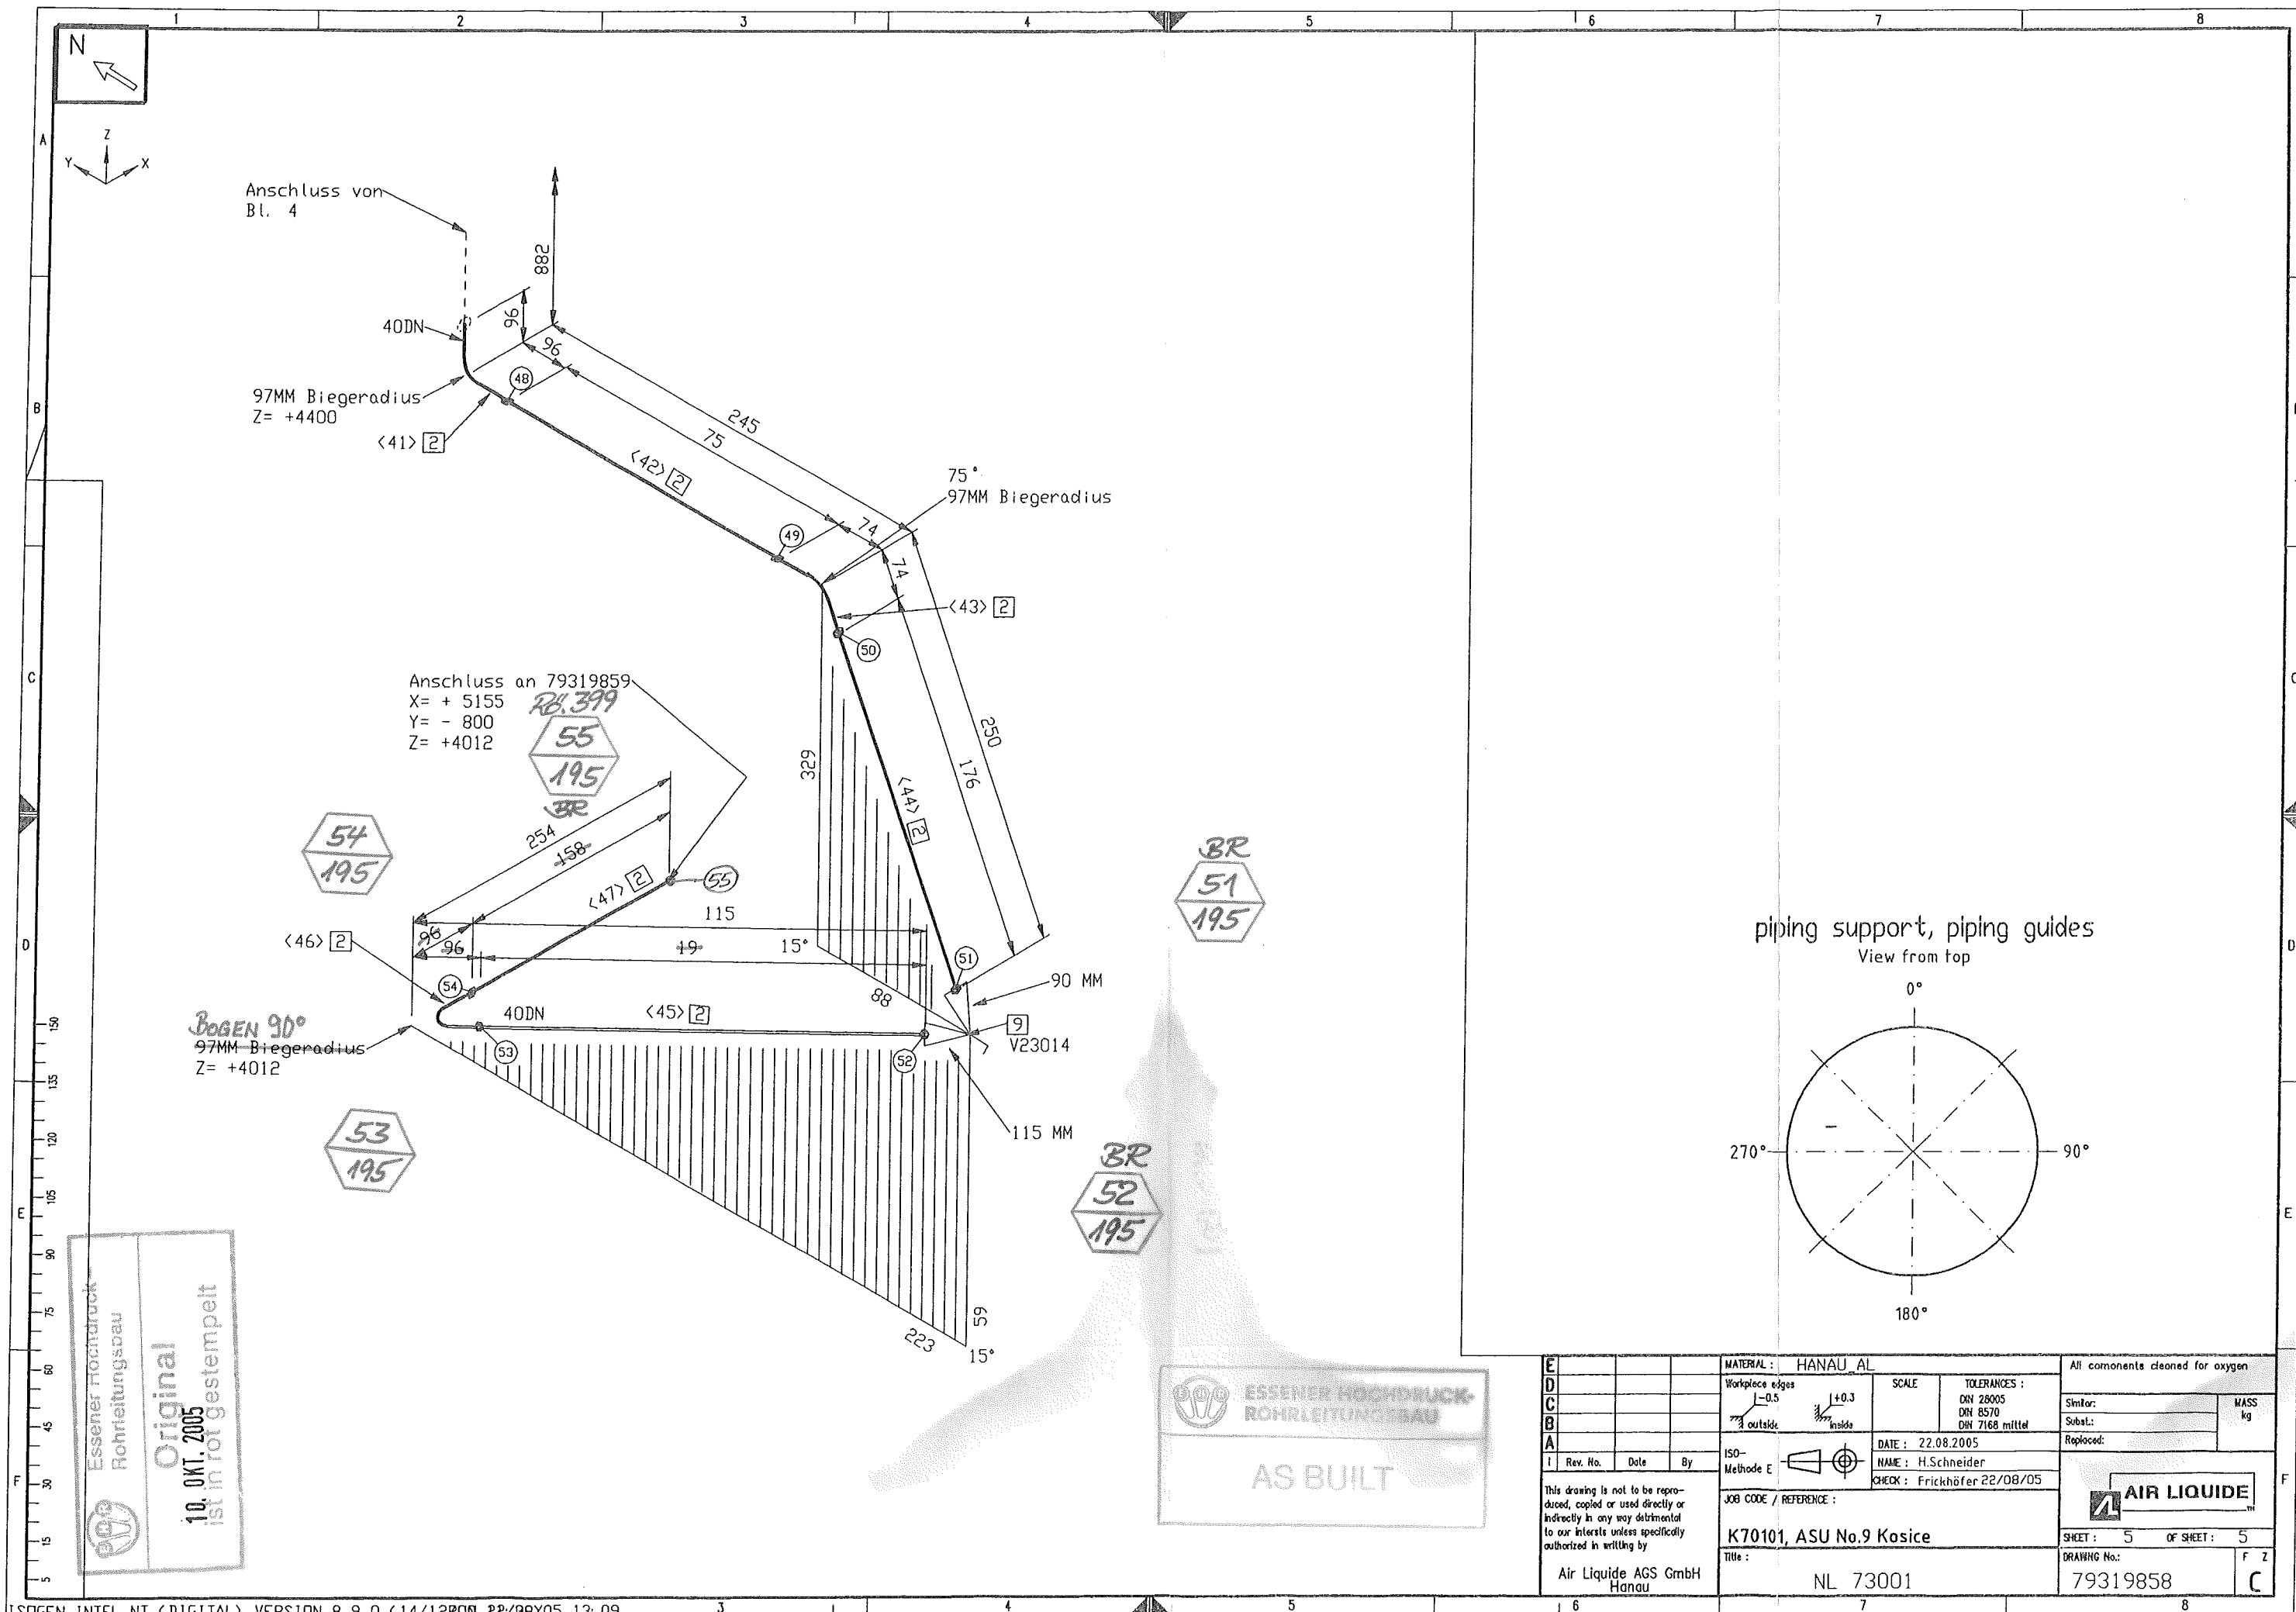


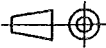

ESSENER HOCHDRUCK-
RÖHRLEITUNGSBAU

AS BUILT

E				MATERIAL :	HANAU AL		All comonents cleaned for oxygen		
D				Workplace edges		SCALE	TOLERANCES :	Similar:	MASS kg
C							DIN 28005 DIN 8570 DIN 7168 mittel		
B								Replaced:	
A				ISO-Methode E		DATE : 22.08.2005	NAME : H.Schneider		
I	Rev. No.	Date	By			CHECK : Frickhöfer 22/08/05			
This drawing is not to be reproduced, copied or used directly or indirectly in any way detrimental to our interests unless specifically authorized in writing by Air Liquide AGS GmbH Hanau				JOB CODE / REFERENCE :		 AIR LIQUIDE™			
				K70101, ASU No.9 Kosice					
				Title :		NL 73001		SHEET : 5 OF SHEET : 5	
						79319858		C	

Essener Hochdruck-
Rohrleitungsbau

Original

10. OKT. 2005
ist in rot gestempelt