



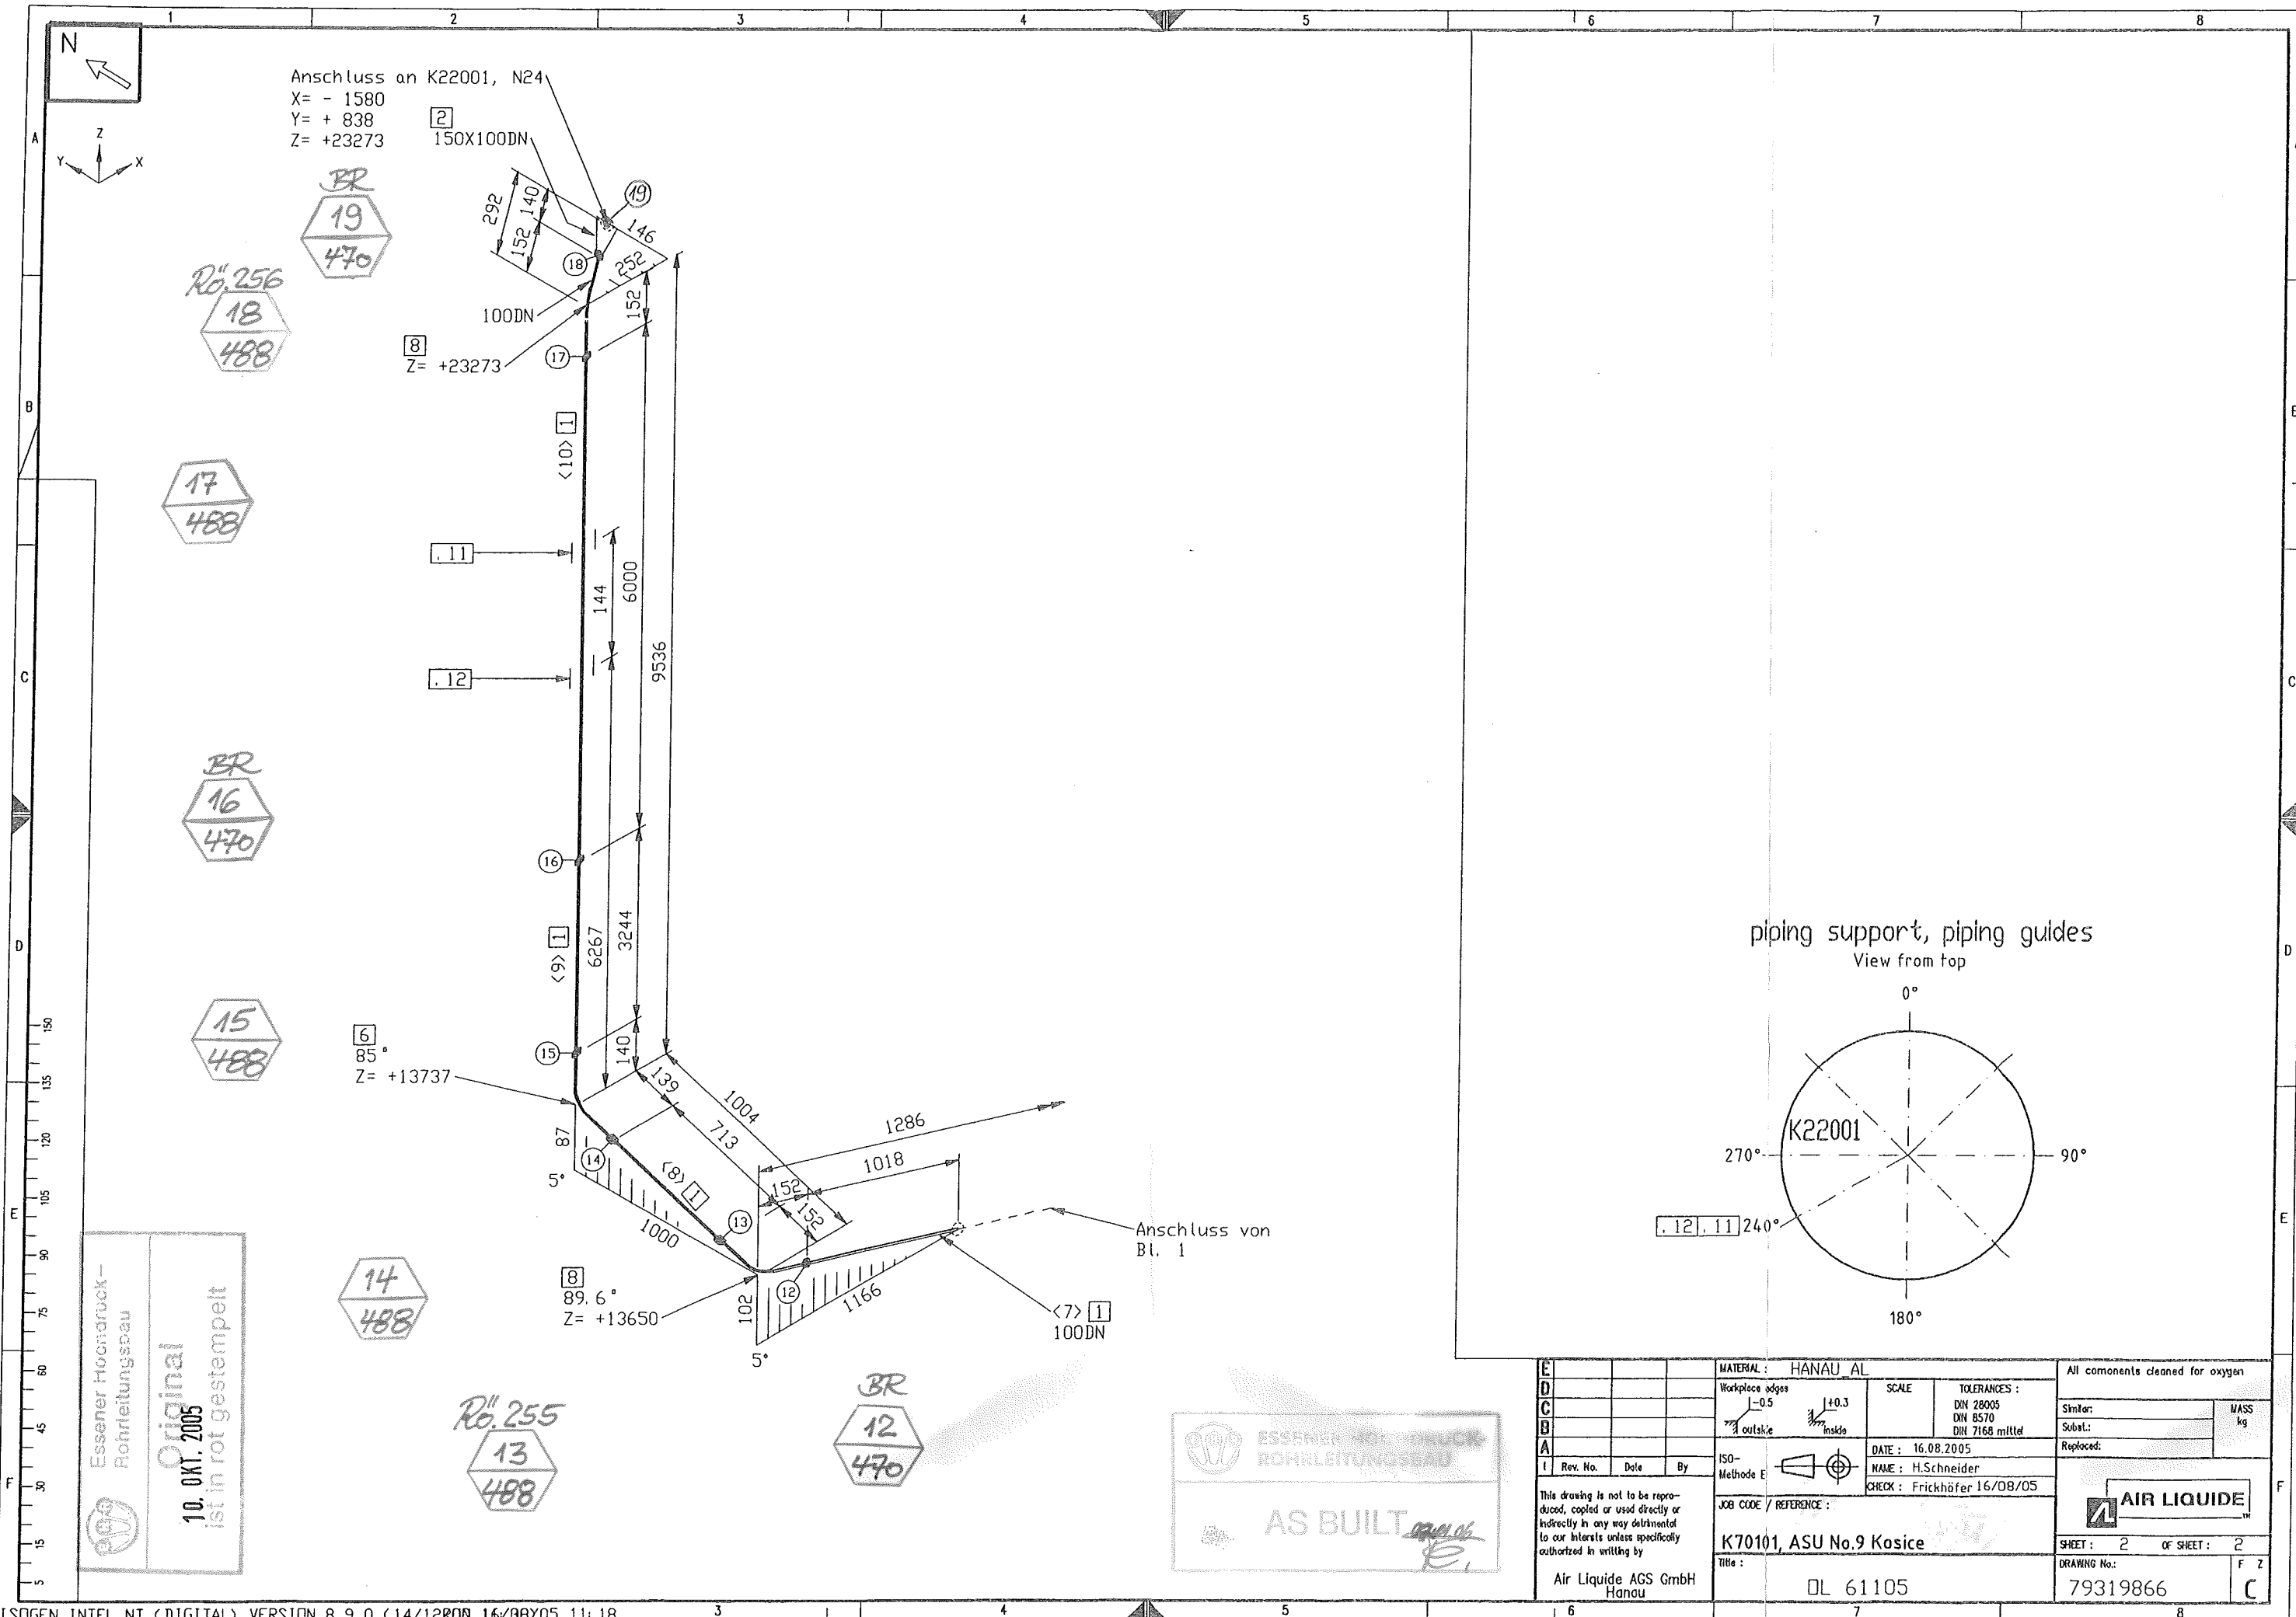

piping support, piping guides
 View from top

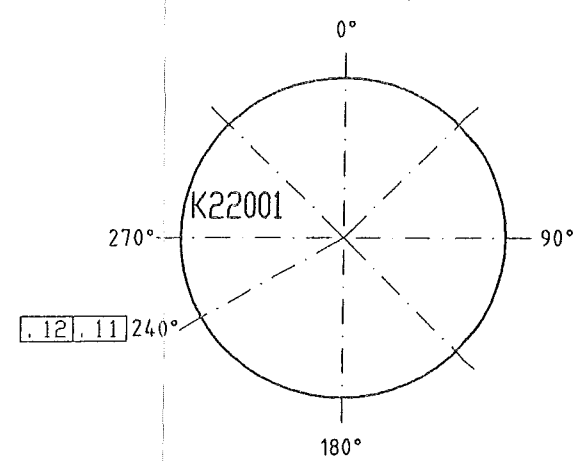

Essener Hochdruck-
 Rohrleitungsbau
 Original
 10. Okt. 2005
 ist in rot gestempelt

ESSENER HOCHDRUCK-
 ROHRLEITUNGSBAU
 AS BUILT

MATERIAL: HANAU AL Workpiece edges -0.5 outside inside			SCALE TOLERANCES: DIN 28005 DIN 8570 DIN 7168 mittel		All components cleaned for oxygen Similar: Subst.: Replaced:	
DATE: 16.08.2005 NAME: H.Schneider CHECK: Frickhöfer 16/08/05			JOB CODE / REFERENCE: K70101, ASU No.9 Kosice		SHEET: 2 OF SHEET: 2 DRAWING No.: 79319866	
This drawing is not to be reproduced, copied or used directly or indirectly in any way detrimental to our interests unless specifically authorized in writing by Air Liquide AGS GmbH Hanau			Title: DL 61105		F Z C	