

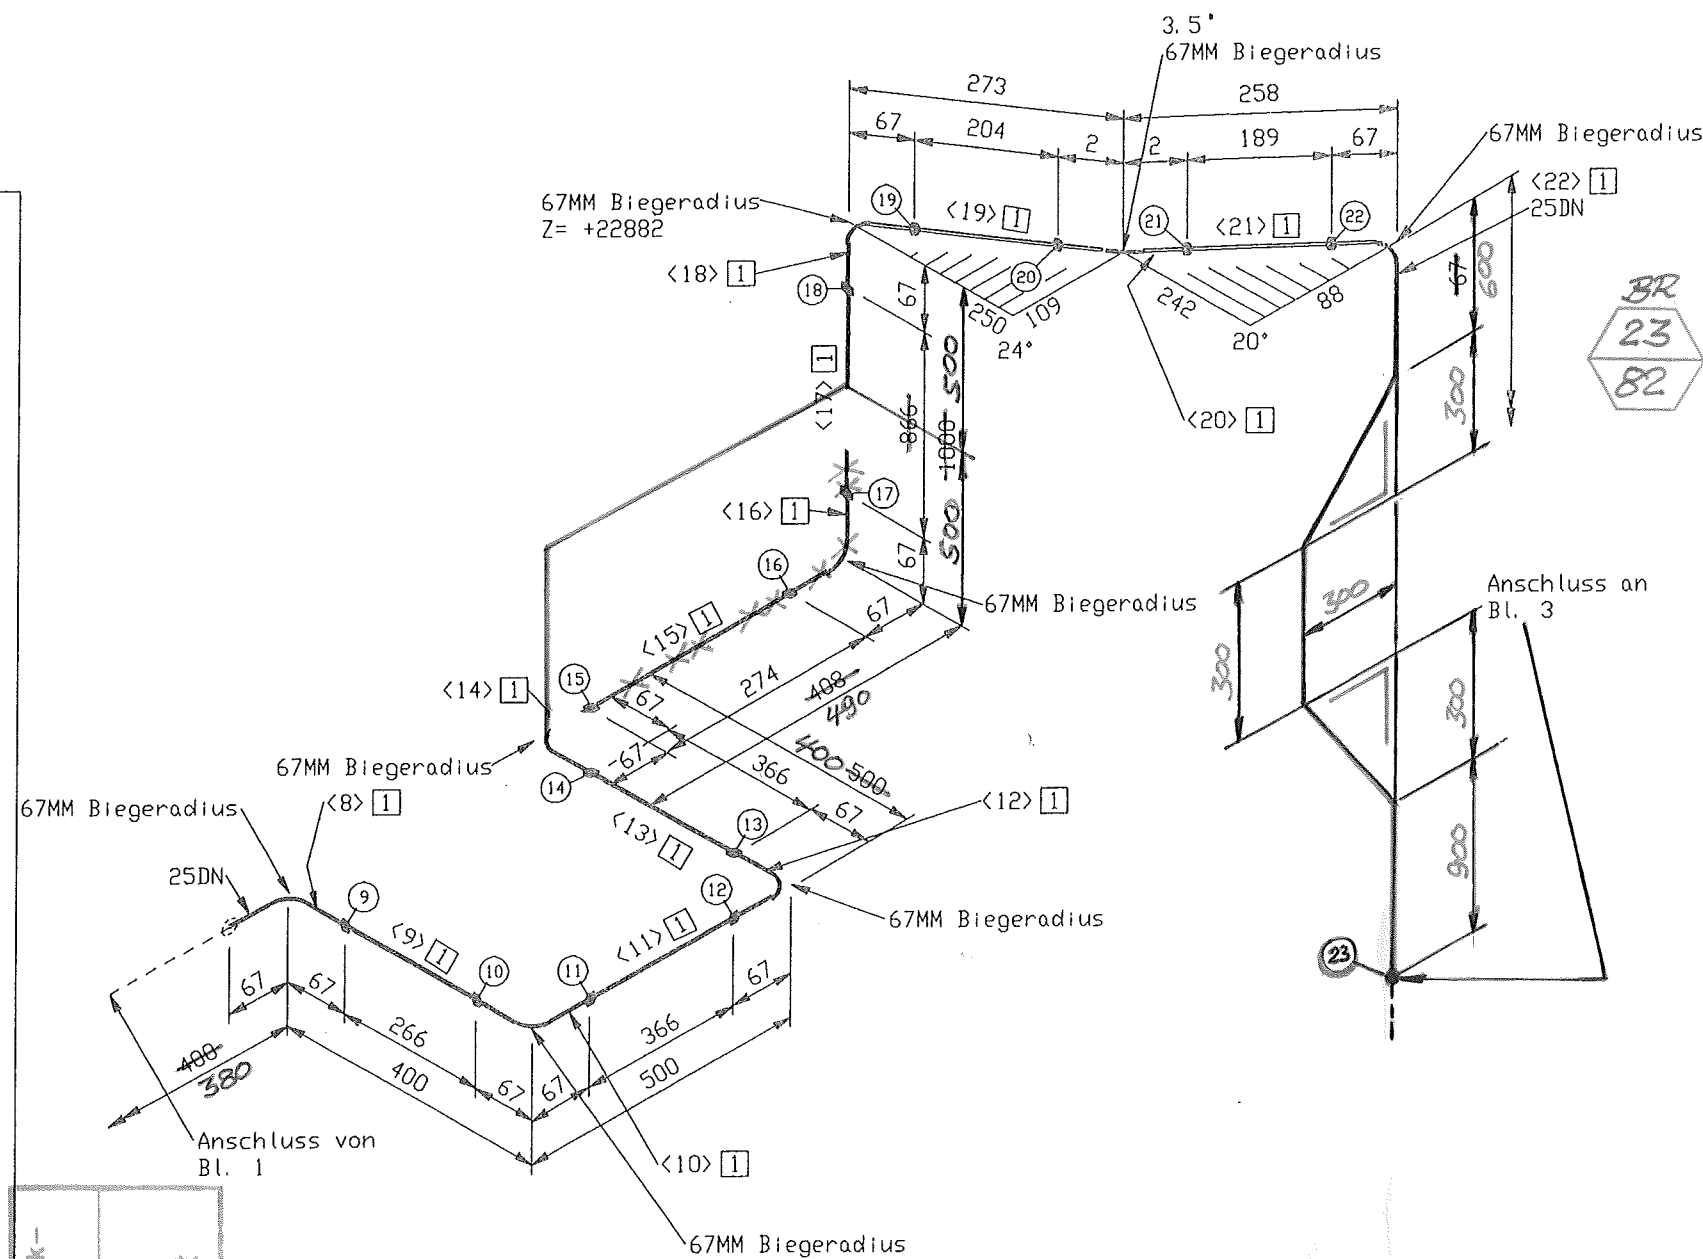


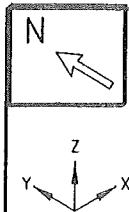



VENTILKASTEN 2, Vormontage
valve box 2, pre-fabricating

piping support, piping guides
View from top

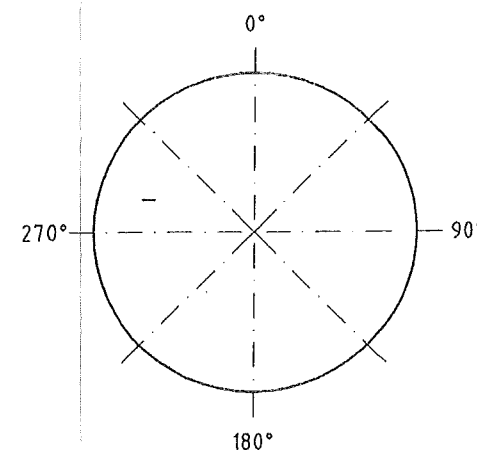

Essener Hochdruck-
Rohrleitungsbau
Original
10. OKT. 2005
ist in rot gestempelt

ESSENER HOCHDRUCK-
ROHRLEITUNGSBAU
AS BUILT

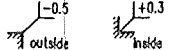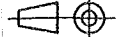E					MATERIAL : HANAU_AL		All components cleaned for oxygen		
D						SCALE	TOLERANCES : DIN 28005 DIN 8570 DIN 7168 mittel	Similar: Subst.:	MASS kg
C									
B						DATE : 20.07.2005	Replaced:		
A									
I	Rev. No.	Date	By		ISO-Methode E	NAME : H.Schneider	 AIR LIQUIDE TM		
This drawing is not to be reproduced, copied or used directly or indirectly in any way detrimental to our interests unless specifically authorized in writing by Air Liquide AGS GmbH Hanau					JOB CODE / REFERENCE :	CECK : Frickhöfer 20/07/05			
					K70101, ASU No.9 Kosice				
					Title :		N 21025	DRAWING No.:	79319871
							SHEET : 2	OF SHEET : 3	C