



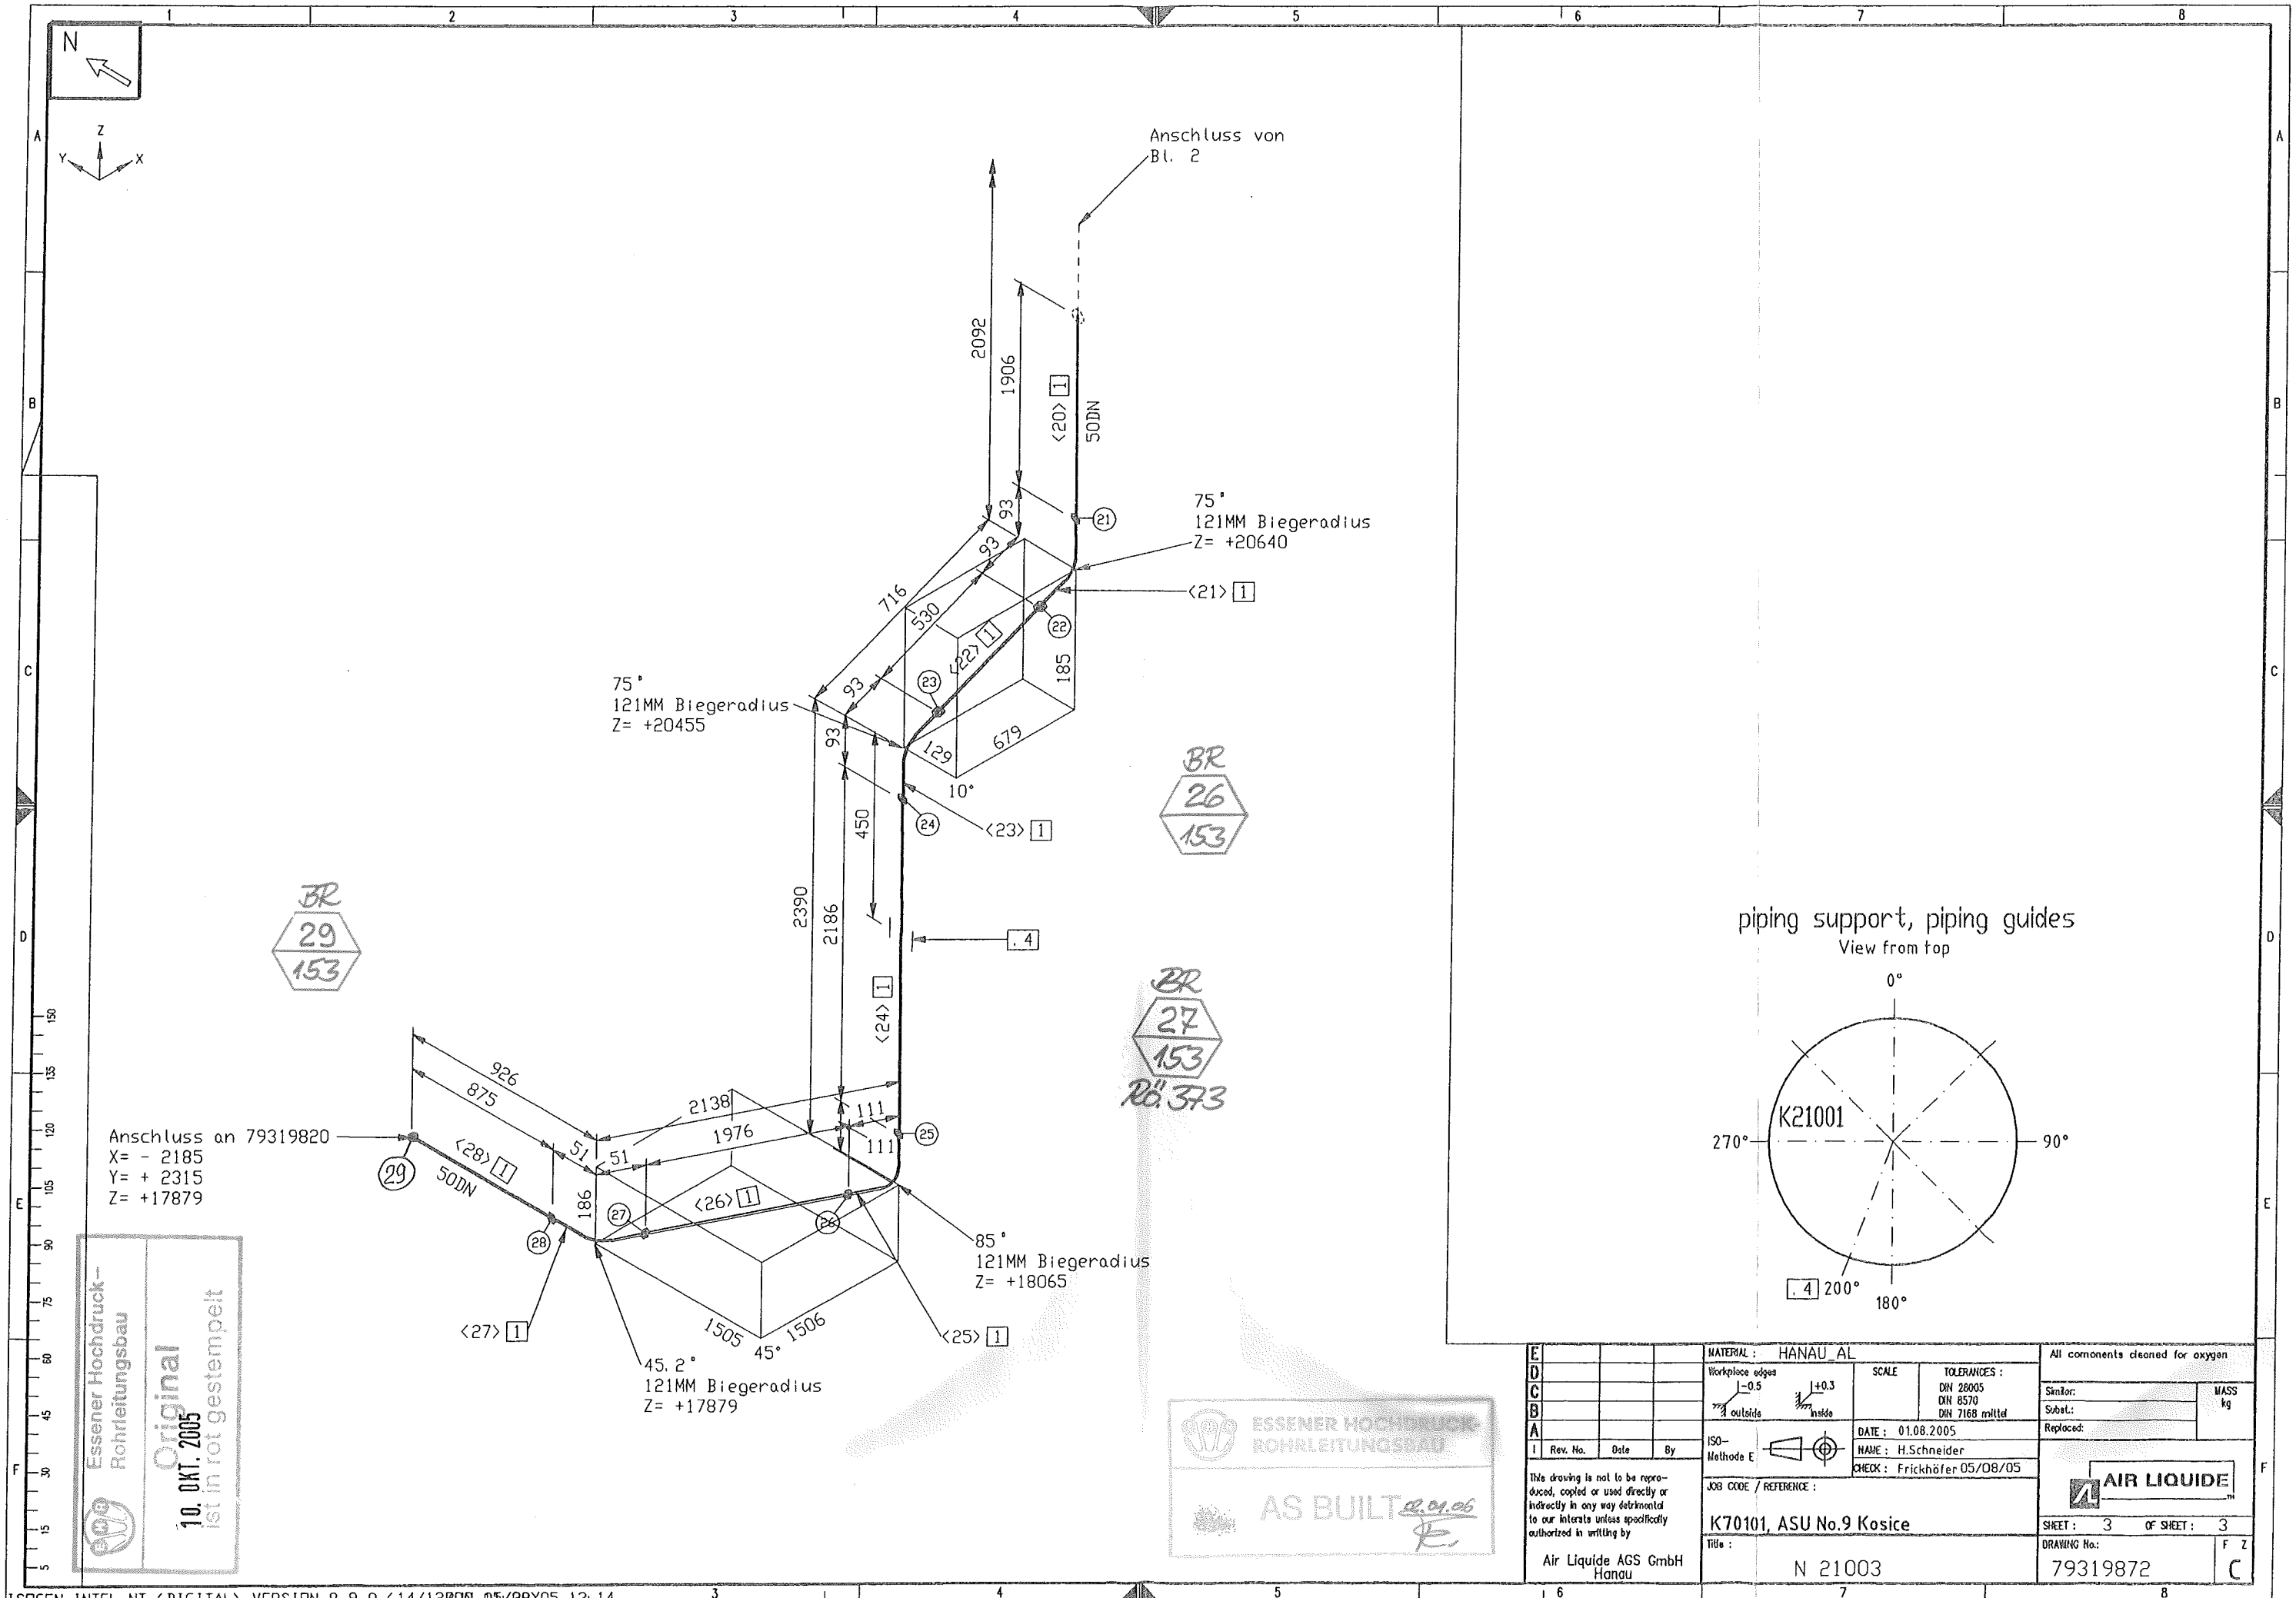

piping support, piping guides  
View from top

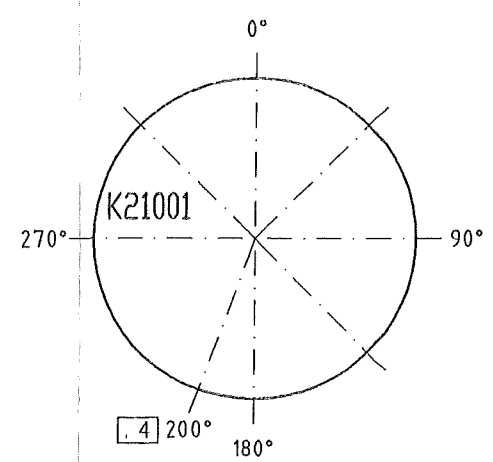

Essener Hochdruck-  
Rohrleitungsbau  
Original  
10. OKT. 2005  
ist in rot gestempelt

ESSENER HOCHDRUCK-  
ROHRLEITUNGSBAU  
AS BUILT 2.04.06  
E.

|                               |          |      |    |  |                                                                                                                                                                  |       |                                                                        |                                  |                           |
|-------------------------------|----------|------|----|--|------------------------------------------------------------------------------------------------------------------------------------------------------------------|-------|------------------------------------------------------------------------|----------------------------------|---------------------------|
| E                             |          |      |    |  | MATERIAL : HANAU AL                                                                                                                                              |       | All components cleaned for oxygen                                      |                                  |                           |
| D                             |          |      |    |  | Workpiece edges<br>-0.5<br>outside<br>+0.3<br>inside                                                                                                             | SCALE | TOLERANCES :<br>DIN 28005<br>DIN 8570<br>DIN 7168 mittel               | Similar:<br>Subst.:<br>Replaced: | MASS<br>kg                |
| C                             |          |      |    |  |                                                                                                                                                                  |       |                                                                        |                                  |                           |
| B                             |          |      |    |  | ISO-<br>Methode E                                                                                                                                                |       | DATE : 01.08.2005<br>NAME : H.Schneider<br>CHECK : Frickhöfer 05/08/05 |                                  | AIR LIQUIDE <sup>TM</sup> |
| A                             |          |      |    |  |                                                                                                                                                                  |       |                                                                        |                                  |                           |
| I                             | Rev. No. | Date | By |  | This drawing is not to be reproduced, copied or used directly or indirectly in any way detrimental to our interests unless specifically authorized in writing by |       | JOB CODE / REFERENCE :<br>K70101, ASU No.9 Kosice                      |                                  | SHEET : 3 OF SHEET : 3    |
| Air Liquide AGS GmbH<br>Hanau |          |      |    |  | Title :<br>N 21003                                                                                                                                               |       | DRAWING No.:<br>79319872                                               |                                  | F Z<br>C                  |