

Rohr DN 400, 406,4x6
CH.: 4164B2

Anschluss an 79319813
X= + 1392
Y= + 2554
Z= +25213

Anschluss an WT-BDX, 79319708
X= + 6575
Y= + 362
Z= +1492


Stückliste

Lfd Nr.	Benennung	DN (MM)	Sachnummer	Menge	Gewicht (kg)
1	Rohr 406 X 4 ALMG4, 5MN V27	400	77038998	32476 27931 MM	381.0
Fitting					
2	BOGEN 406 x6 DIN2605-2-90-3 ALMG4, 5MN	400	77038237	1	19.5
3	Stutzen auf 75				
4	BOGEN 406 x6 DIN2605-2-90-3 ALMG4, 5MN	400	77038237_1	1	19.5
5	Stutzen auf 15				
6	BOGEN 406 x6 DIN2605-2-90-3 ALMG4, 5MN	400	77038237_2	2	39.0
Halterung					
7	Führung B gezeichnet auf 79318176, L1=1010	400	79320084	2	73.2
Summe Masse					532.2

Rohrzuschnitt

Rohr Stk.	Länge (MM)	DN (MM)	Benennung	Rohr Ende 1	Rohr Ende 2	Sachnummer
<1>	3620	400				77038998
<2>	1454	400				77038998
<3>	3055	400				77038998
<4>	6000	400				77038998
<5>	6000	400				77038998
<6>	6000	400				77038998
<7>	1802	400				77038998

pipng support, piping guides
View from top

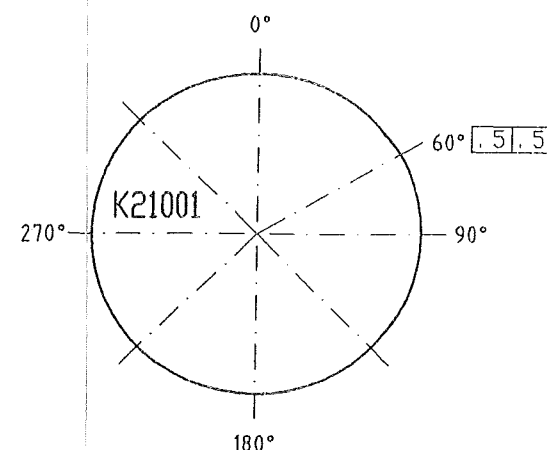

Rohr DN (MM) 400
CL Länge (MM) 30408

E			MATERIAL: HANAU AL		All components cleaned for oxygen	
D			Workplace edges	SCALE	TOLERANCES:	Similar:
C			±0.5		DIN 28005	MASS
B			outside	±0.3	DIN 8570	kg
A			inside		DIN 7168 mittel	Replaced:
I	Rev. No.	Date	By	ISO-Methode E	DATE: 29.07.2005	
					NAME: H.Schneider	
					CECK: Frickhöfer 29/07/05	
This drawing is not to be reproduced, copied or used directly or indirectly in any way detrimental to our interests unless specifically authorized in writing by				JOB CODE / REFERENCE:		AIR LIQUIDE
Air Liquide AGS GmbH Hanau				K70101, ASU No.9 Kosice		
Title:				N 22001		SHEET: 1 OF SHEET: 1
						DRAWING No.: 79319893
						F Z C

Essener Hochdruck-
Rohrleitungsbau
Original
10. OKT. 2005
ist nicht gestempelt

ESSENER HOCHDRUCK-
ROHRLEITUNGSBAU
AS BUILT 01.12.05