



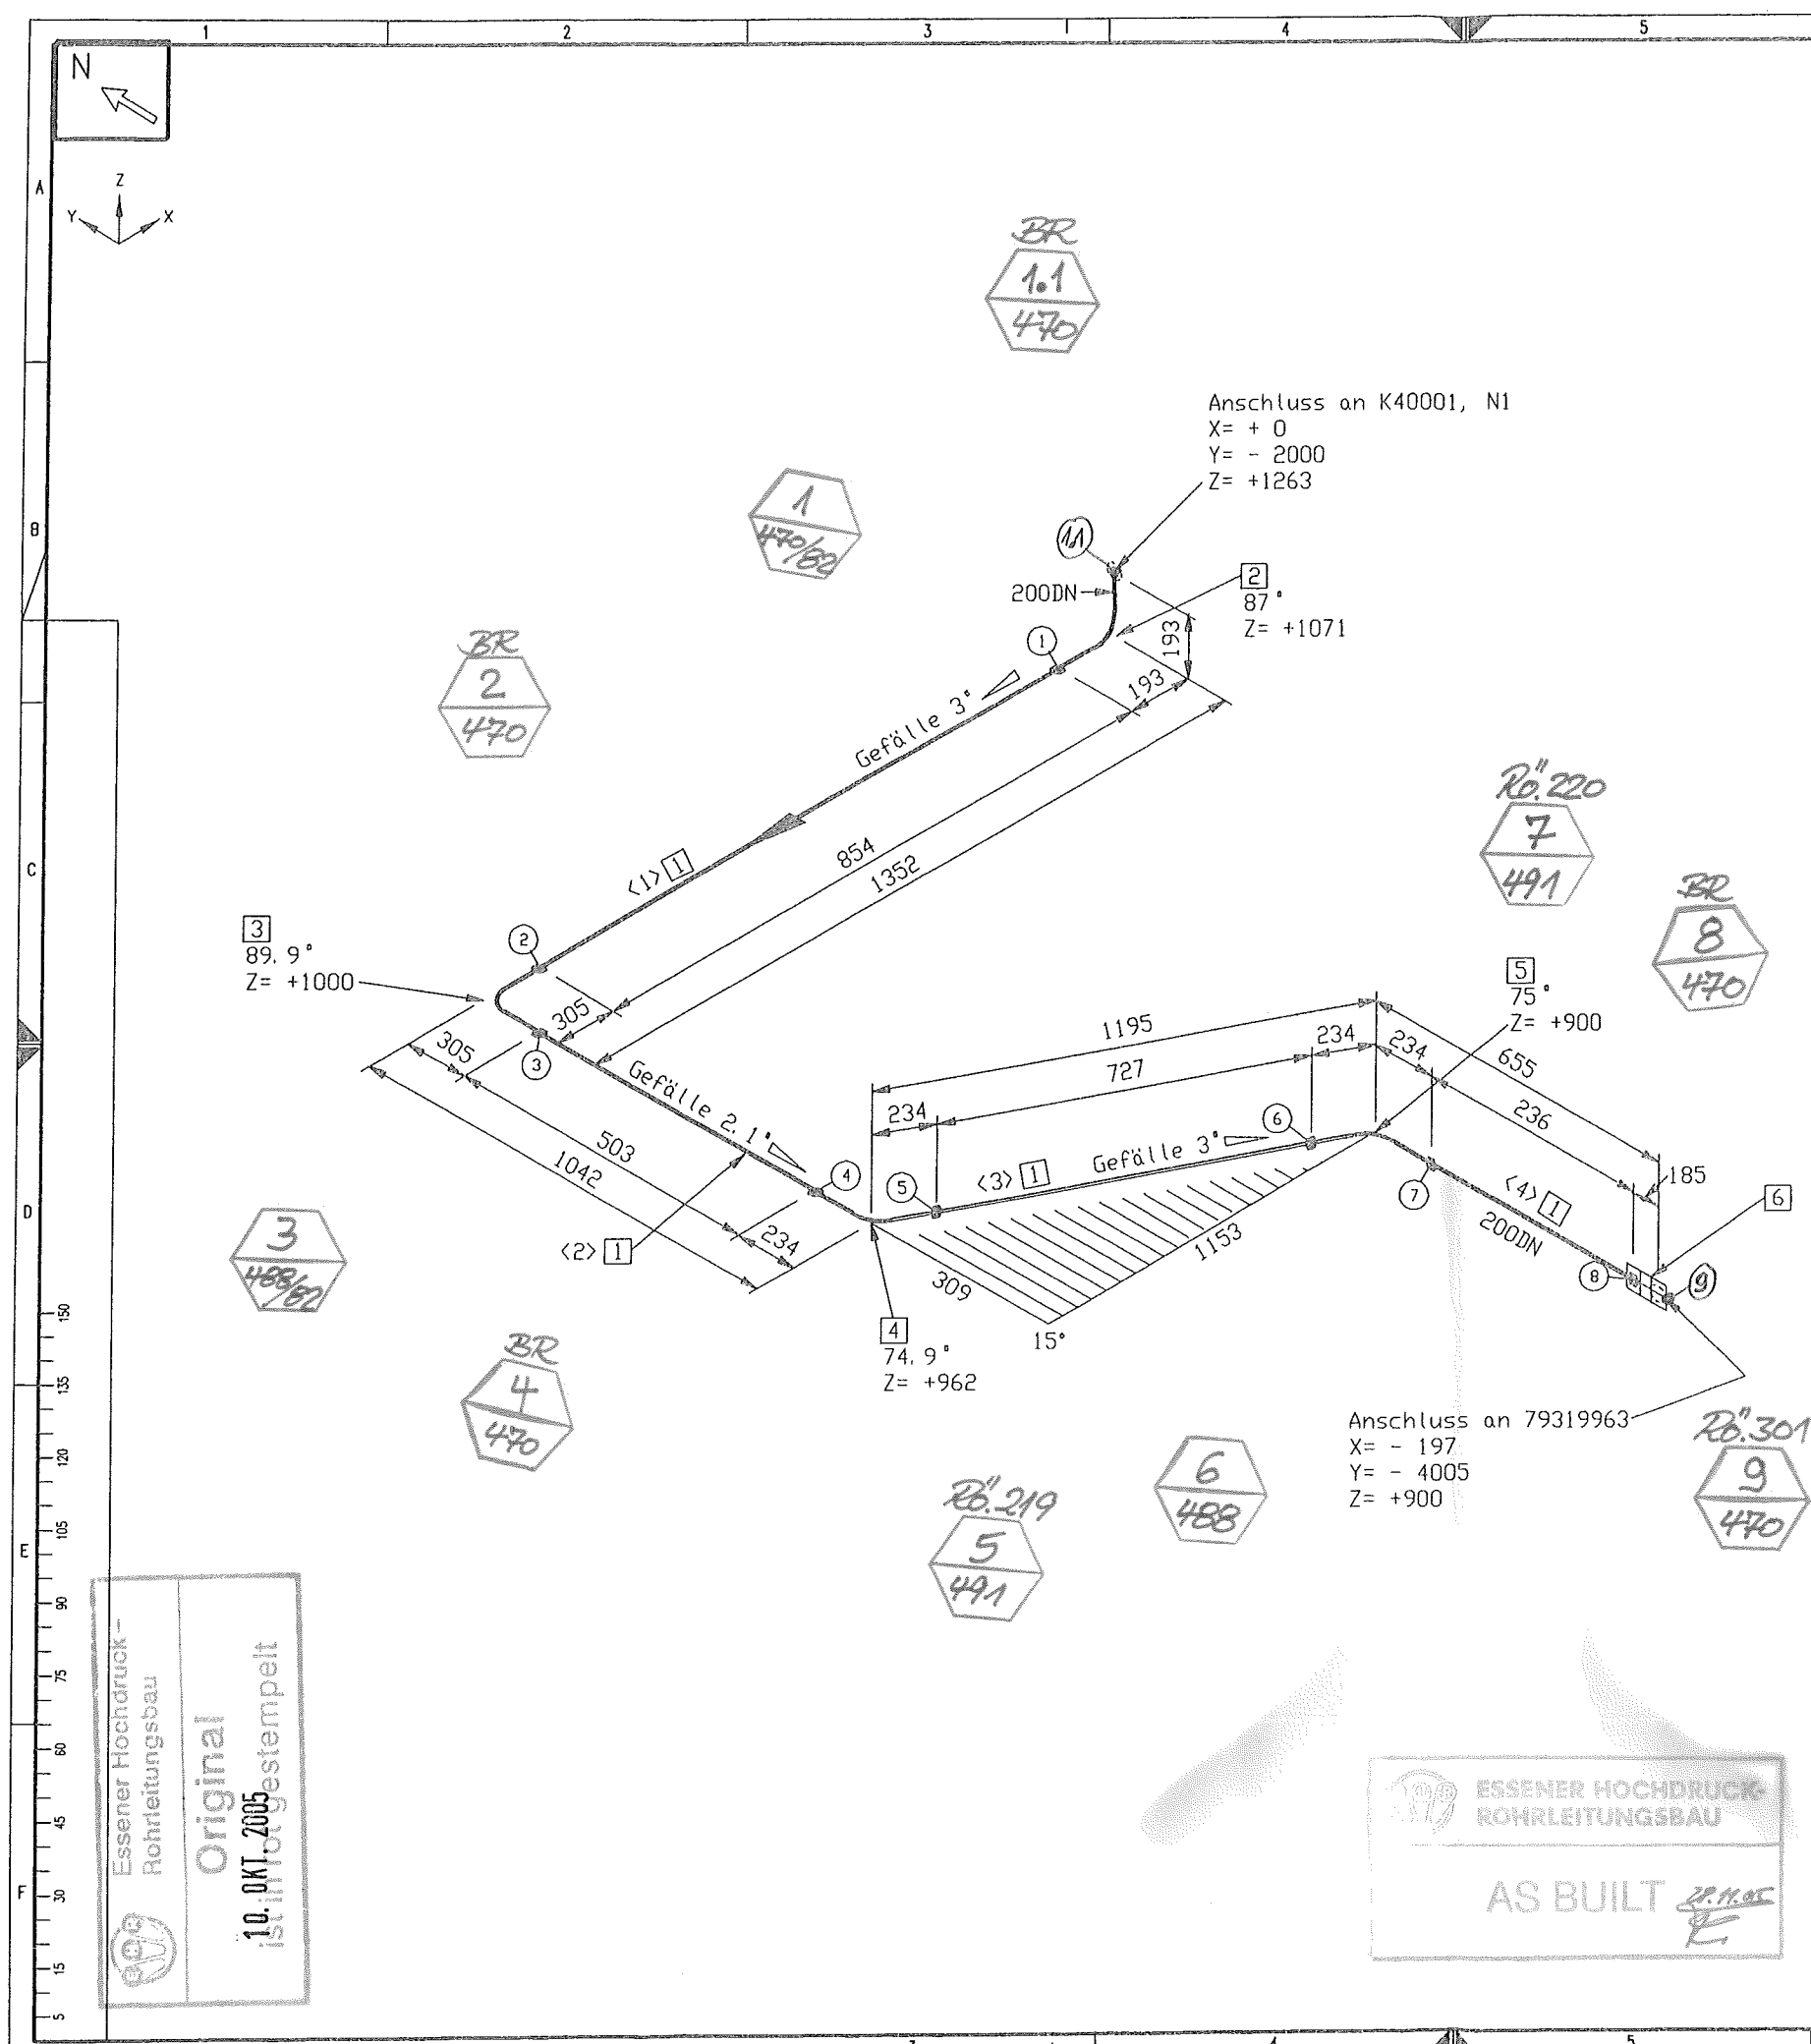

Stückliste					
Lfd Nr.	Benennung	DN (MM)	Sachnummer	Menge	Gewicht (kg)
Rohr					
1	ROHR 219,1 X 6,4 ALMG4,5MN V27	200	77038151	2320 MM	26.8
Fitting					
2	BOGEN 219,1x6,4 DIN2605-2-90-2 ALMG4,5MN	200	77039826	1	5.2
3	Stutzen auf 87				
3	BOGEN 219,1x6,4 DIN2605-2-90-3 ALMG4,5MN	200	77038159	1	5.5
4	BOGEN 219,1x6,4 DIN2605-2-90-3 ALMG4,5MN	200	77038159_1	1	5.5
	Stutzen auf 74.92				
5	BOGEN 219,1x6,4 DIN2605-2-90-3 ALMG4,5MN	200	77038159_2	1	5.5
	Stutzen auf 75.02				
6	TRANSITIONJOINT DN 200/PN100	200	770.38701	1	9.0
Summe Masse					57.6

Rohrzuschnitt					
Rohr Stk.	Länge (MM)	DN (MM)	Bemerkung	Rohr Ende 1	Rohr Ende 2
<1>	854	200			77038151
<2>	503	200			77038151
<3>	727	200			77038151
<4>	236	200			77038151

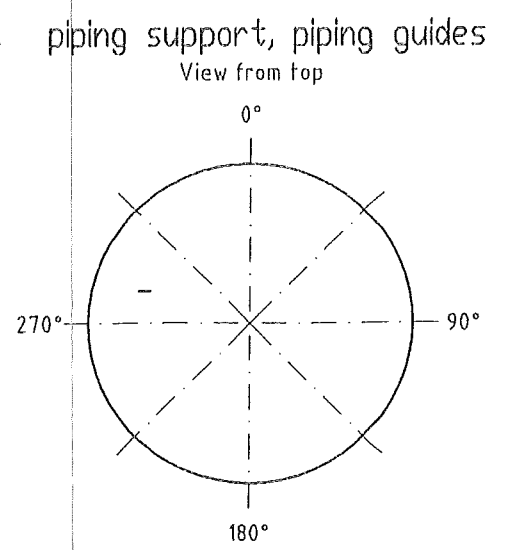

Rohr DN (MM) 200
CL Länge (MM) 4437

Essener Hochdruck-
Rohrleitungsbau
Original
10.0KT.2005
ist nicht gestempelt

ESSENER HOCHDRUCK-
ROHRLEITUNGSBAU
AS BUILT

E		WATER: HANAU AL		All components cleaned for oxygen	
D		Workplace edges	SCALE	TOLERANCES:	Similar:
C		1-0.5		DIN 28005	MASS
B		outside		DIN 8570	kg
A		inside		DIN 7168 mittel	Replaced:
1	Rev. No.	Date	By	DATE: 06.09.2005	
				NAME: H.Schneider	
				CHECK: Frickhöfer 06/09/05	
This drawing is not to be reproduced, copied or used directly or indirectly in any way detrimental to our interests unless specifically authorized in writing by				AIR LIQUIDE	
Air Liquide AGS GmbH Hanau				SHEET: 1 OF SHEET: 1	
JOB CODE / REFERENCE: K70101, ASU No.9 Kosice				DRAWING No: 79319896	
Title: DL 40001				F Z C	