



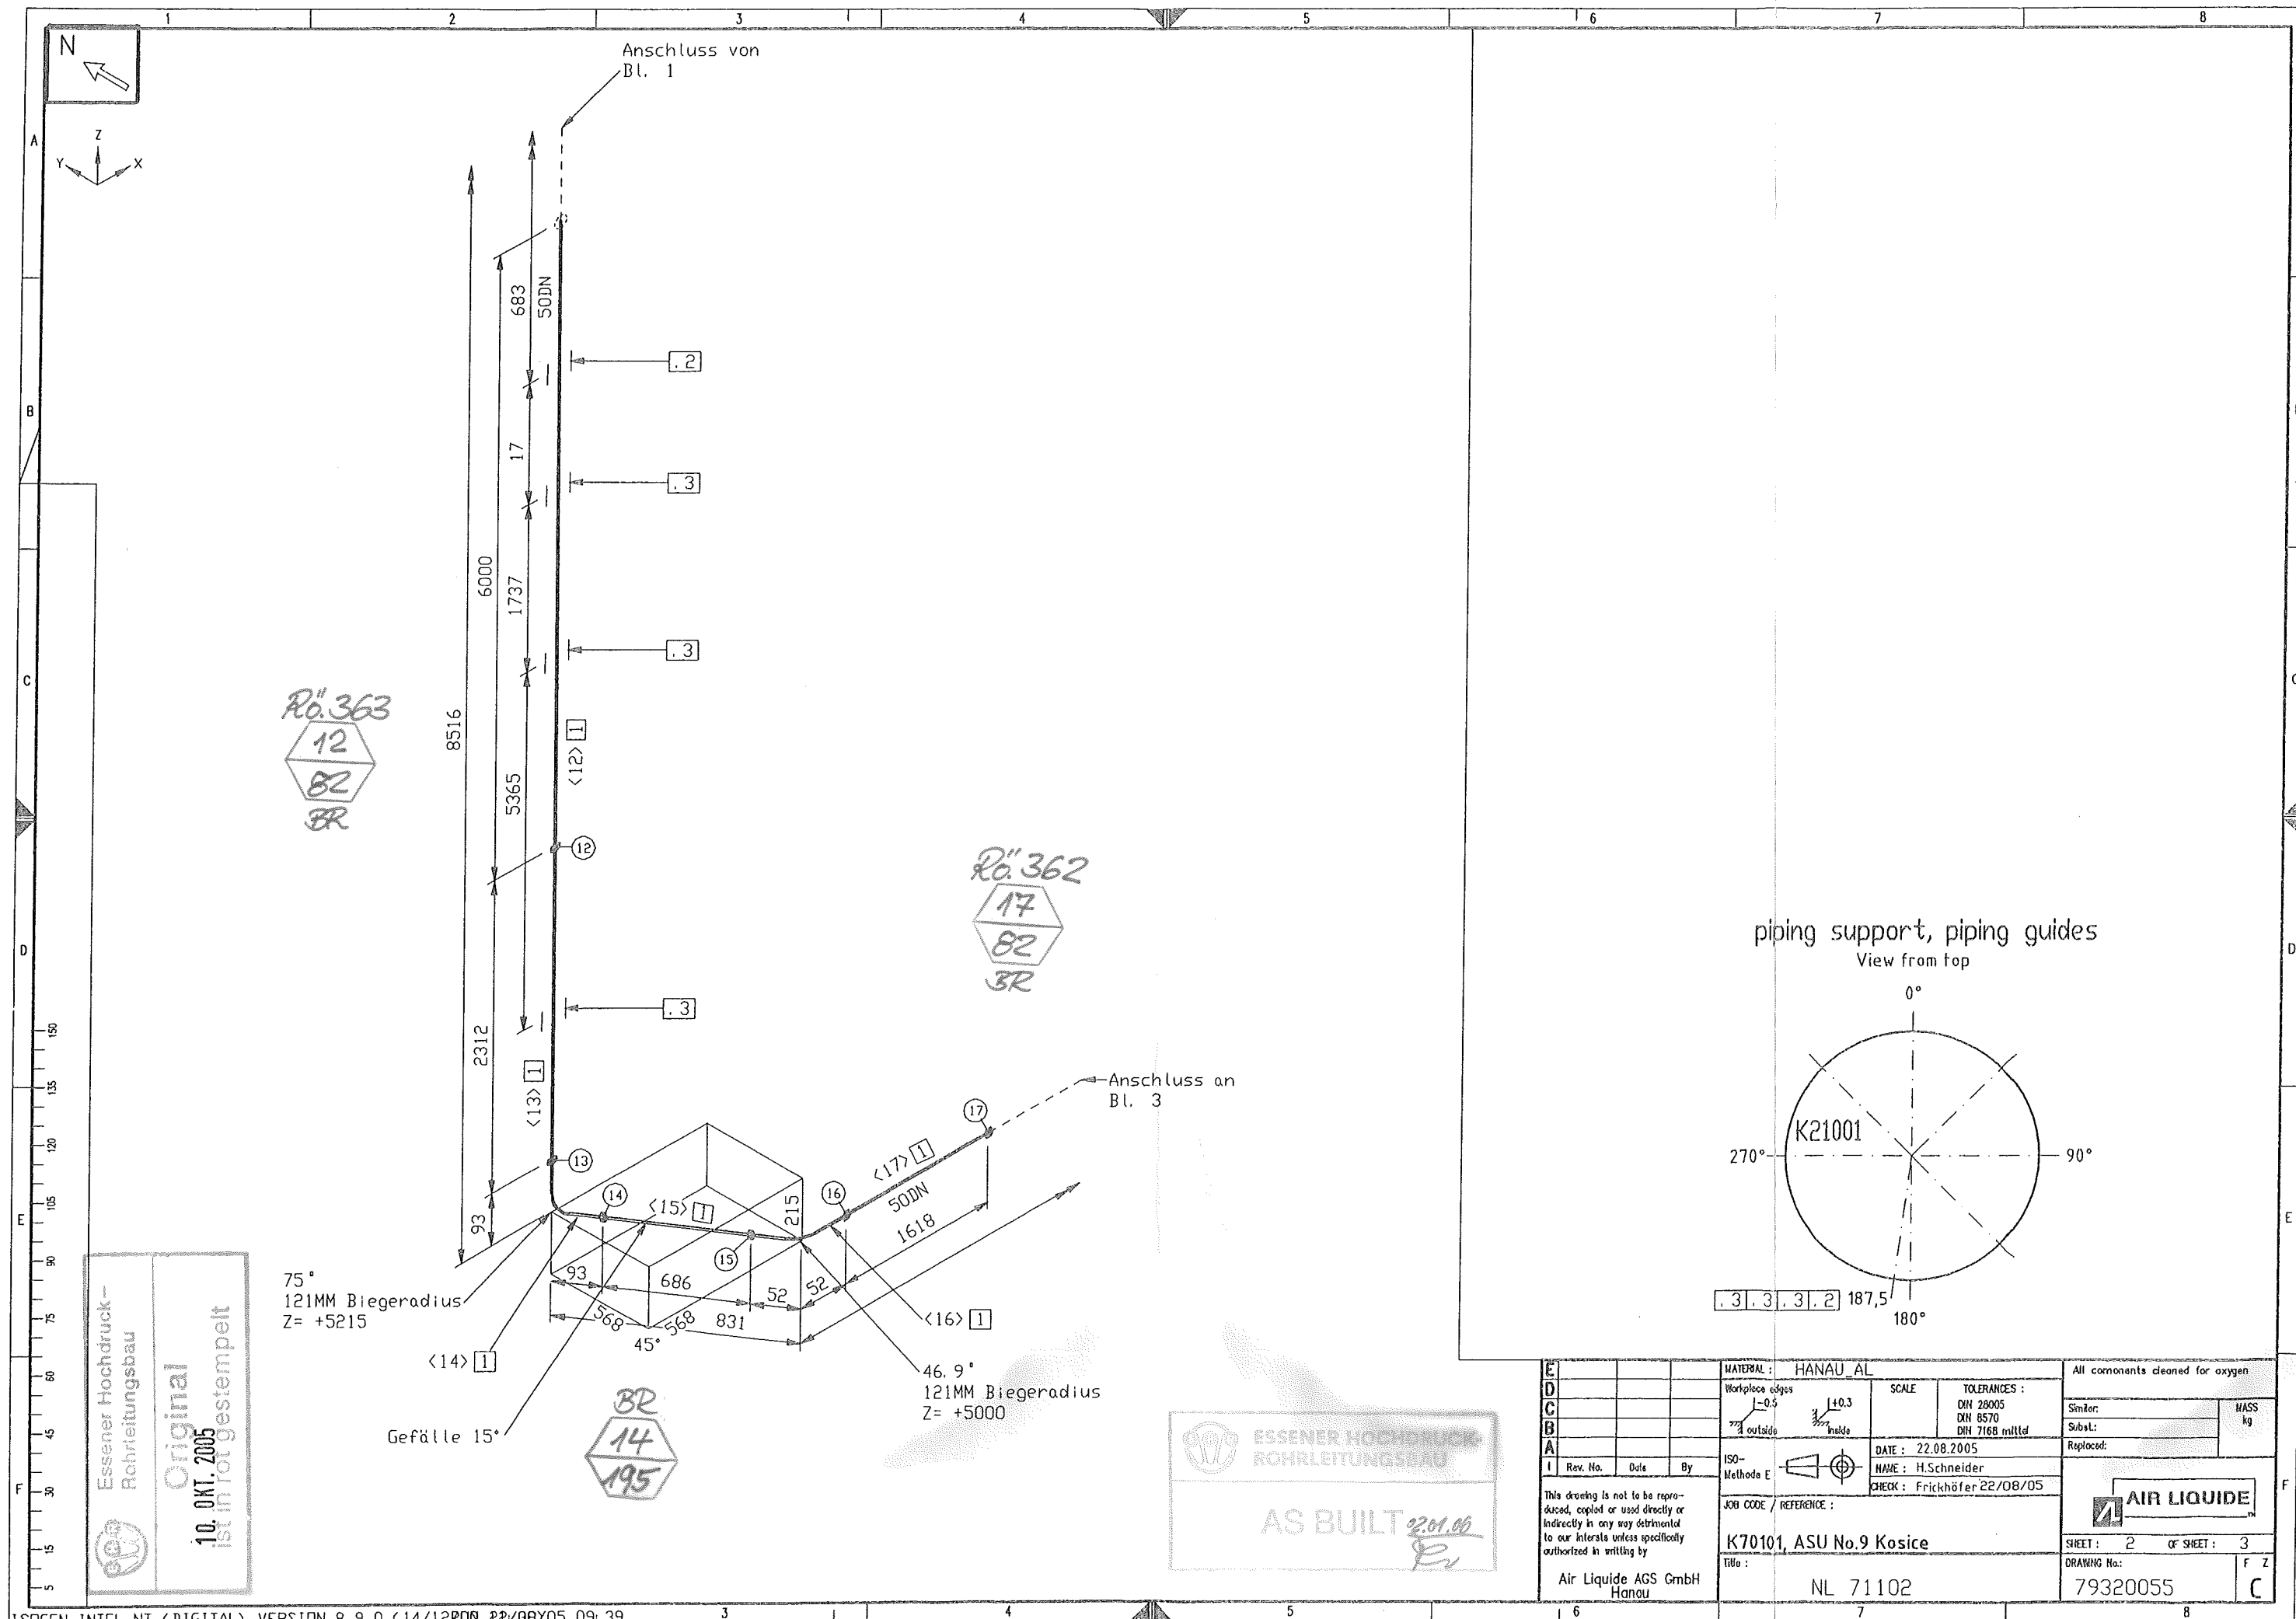

Essener Hochdruck-
Rohrleitungsbau
Original
10. OKT. 2005
ist in rot gestempelt

ESSENER HOCHDRUCK-
ROHRLEITUNGSBAU
AS BUILT 22.01.06

piping support, piping guides
View from top

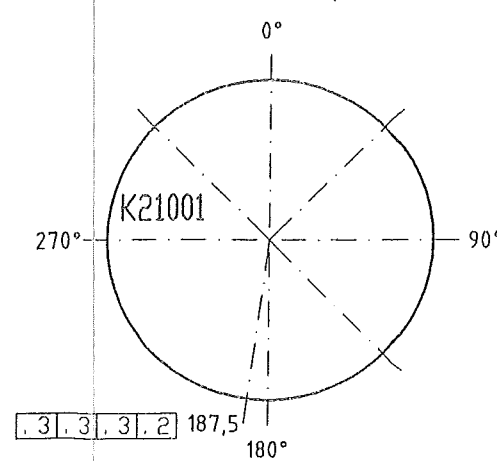

E			MATERIAL: HANAU AL		All components cleaned for oxygen	
D			Workpiece edges	SCALE	TOLERANCES:	Similar:
C			±0.5	1:0.3	DIN 28005	MASS
B			outside	inside	DIN 8570	kg
A			ISO-Methode E	DATE: 22.08.2005	DIN 7168 mittel	Replaced:
I			Rev. No.	Dts	By	
			HAME: H.Schneider			
			CHECK: Frickhöfer 22/08/05			
			JOB CODE / REFERENCE:			
			K70101, ASU No.9 Kosice			
			TITLE:			
			Air Liquide AGS GmbH Hanau			
			NL 71102			
			SHEET: 2 OF SHEET: 3			
			DRAWING No.: 79320055			
			F Z			C