

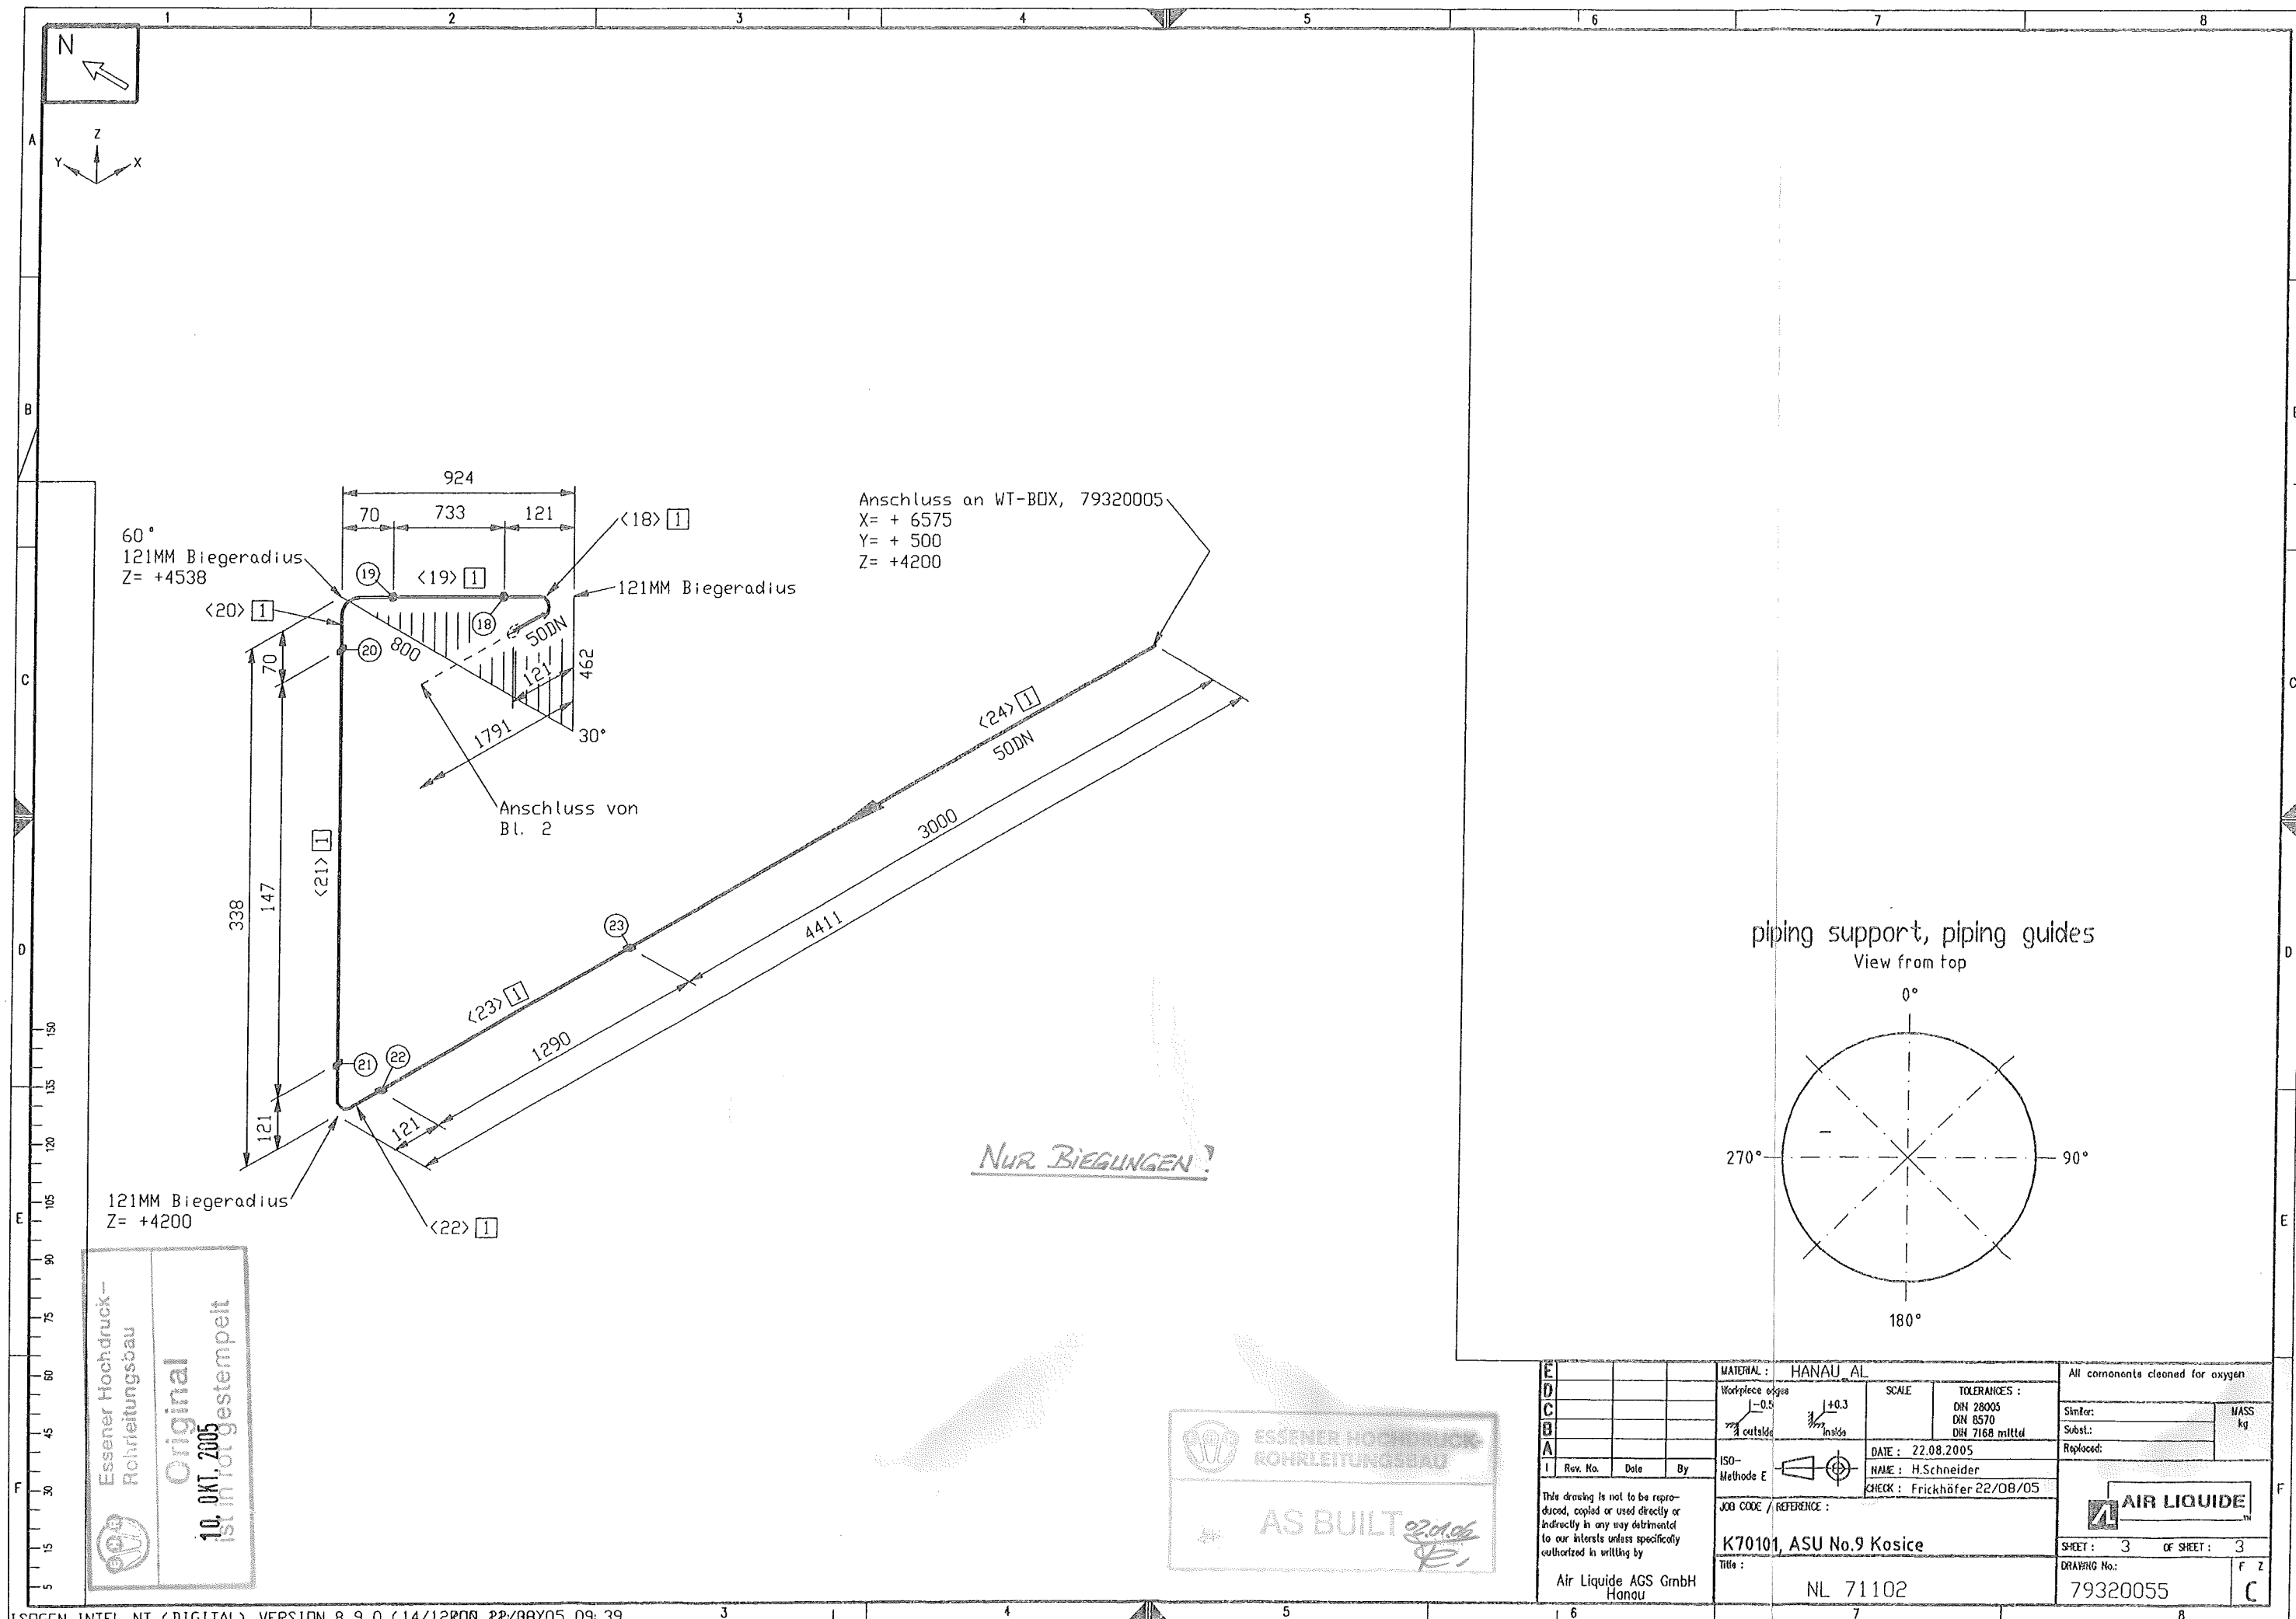


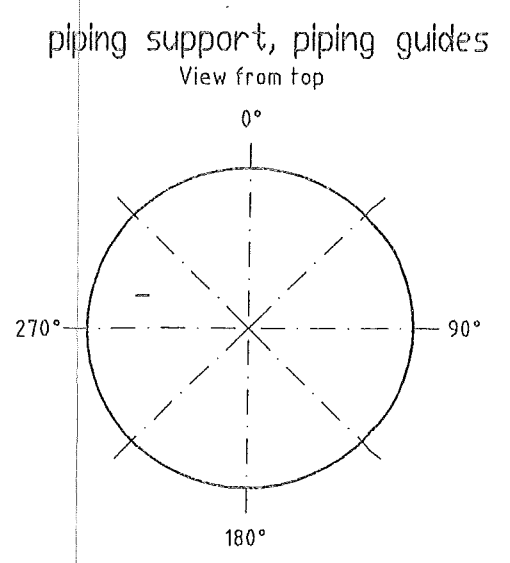

Essener Hochdruck-
Rohrleitungsbau
Original
10. OKT. 2005
ist in rot gestempelt

ESSENER HOCHDRUCK-
ROHRLEITUNGSBAU
AS BUILT 22.01.06

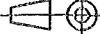

E				MATERIAL : HANAU AL		All components cleaned for oxygen			
D				Workpiece edges -0.5 outside +0.3 inside	SCALE	TOLERANCES : DN 28005 DN 8570 DN 7168 mittl	Similar: Subst.: Replaced:	MASS kg	
C									
B				ISO- Methode E		DATE : 22.08.2005 NAME : H.Schneider CHECK : Frickhöfer 22/08/05	 AIR LIQUIDE TM	F Z	
A									
I	Rev. No.	Date	By	JOB CODE / REFERENCE :		SHEET : 3 OF SHEET : 3		DRAWING No.: 79320055	C
This drawing is not to be reproduced, copied or used directly or indirectly in any way detrimental to our interests unless specifically authorized in writing by				K70101, ASU No.9 Kosice					
Air Liquide AGS GmbH Hanau				Title : NL 71102					