



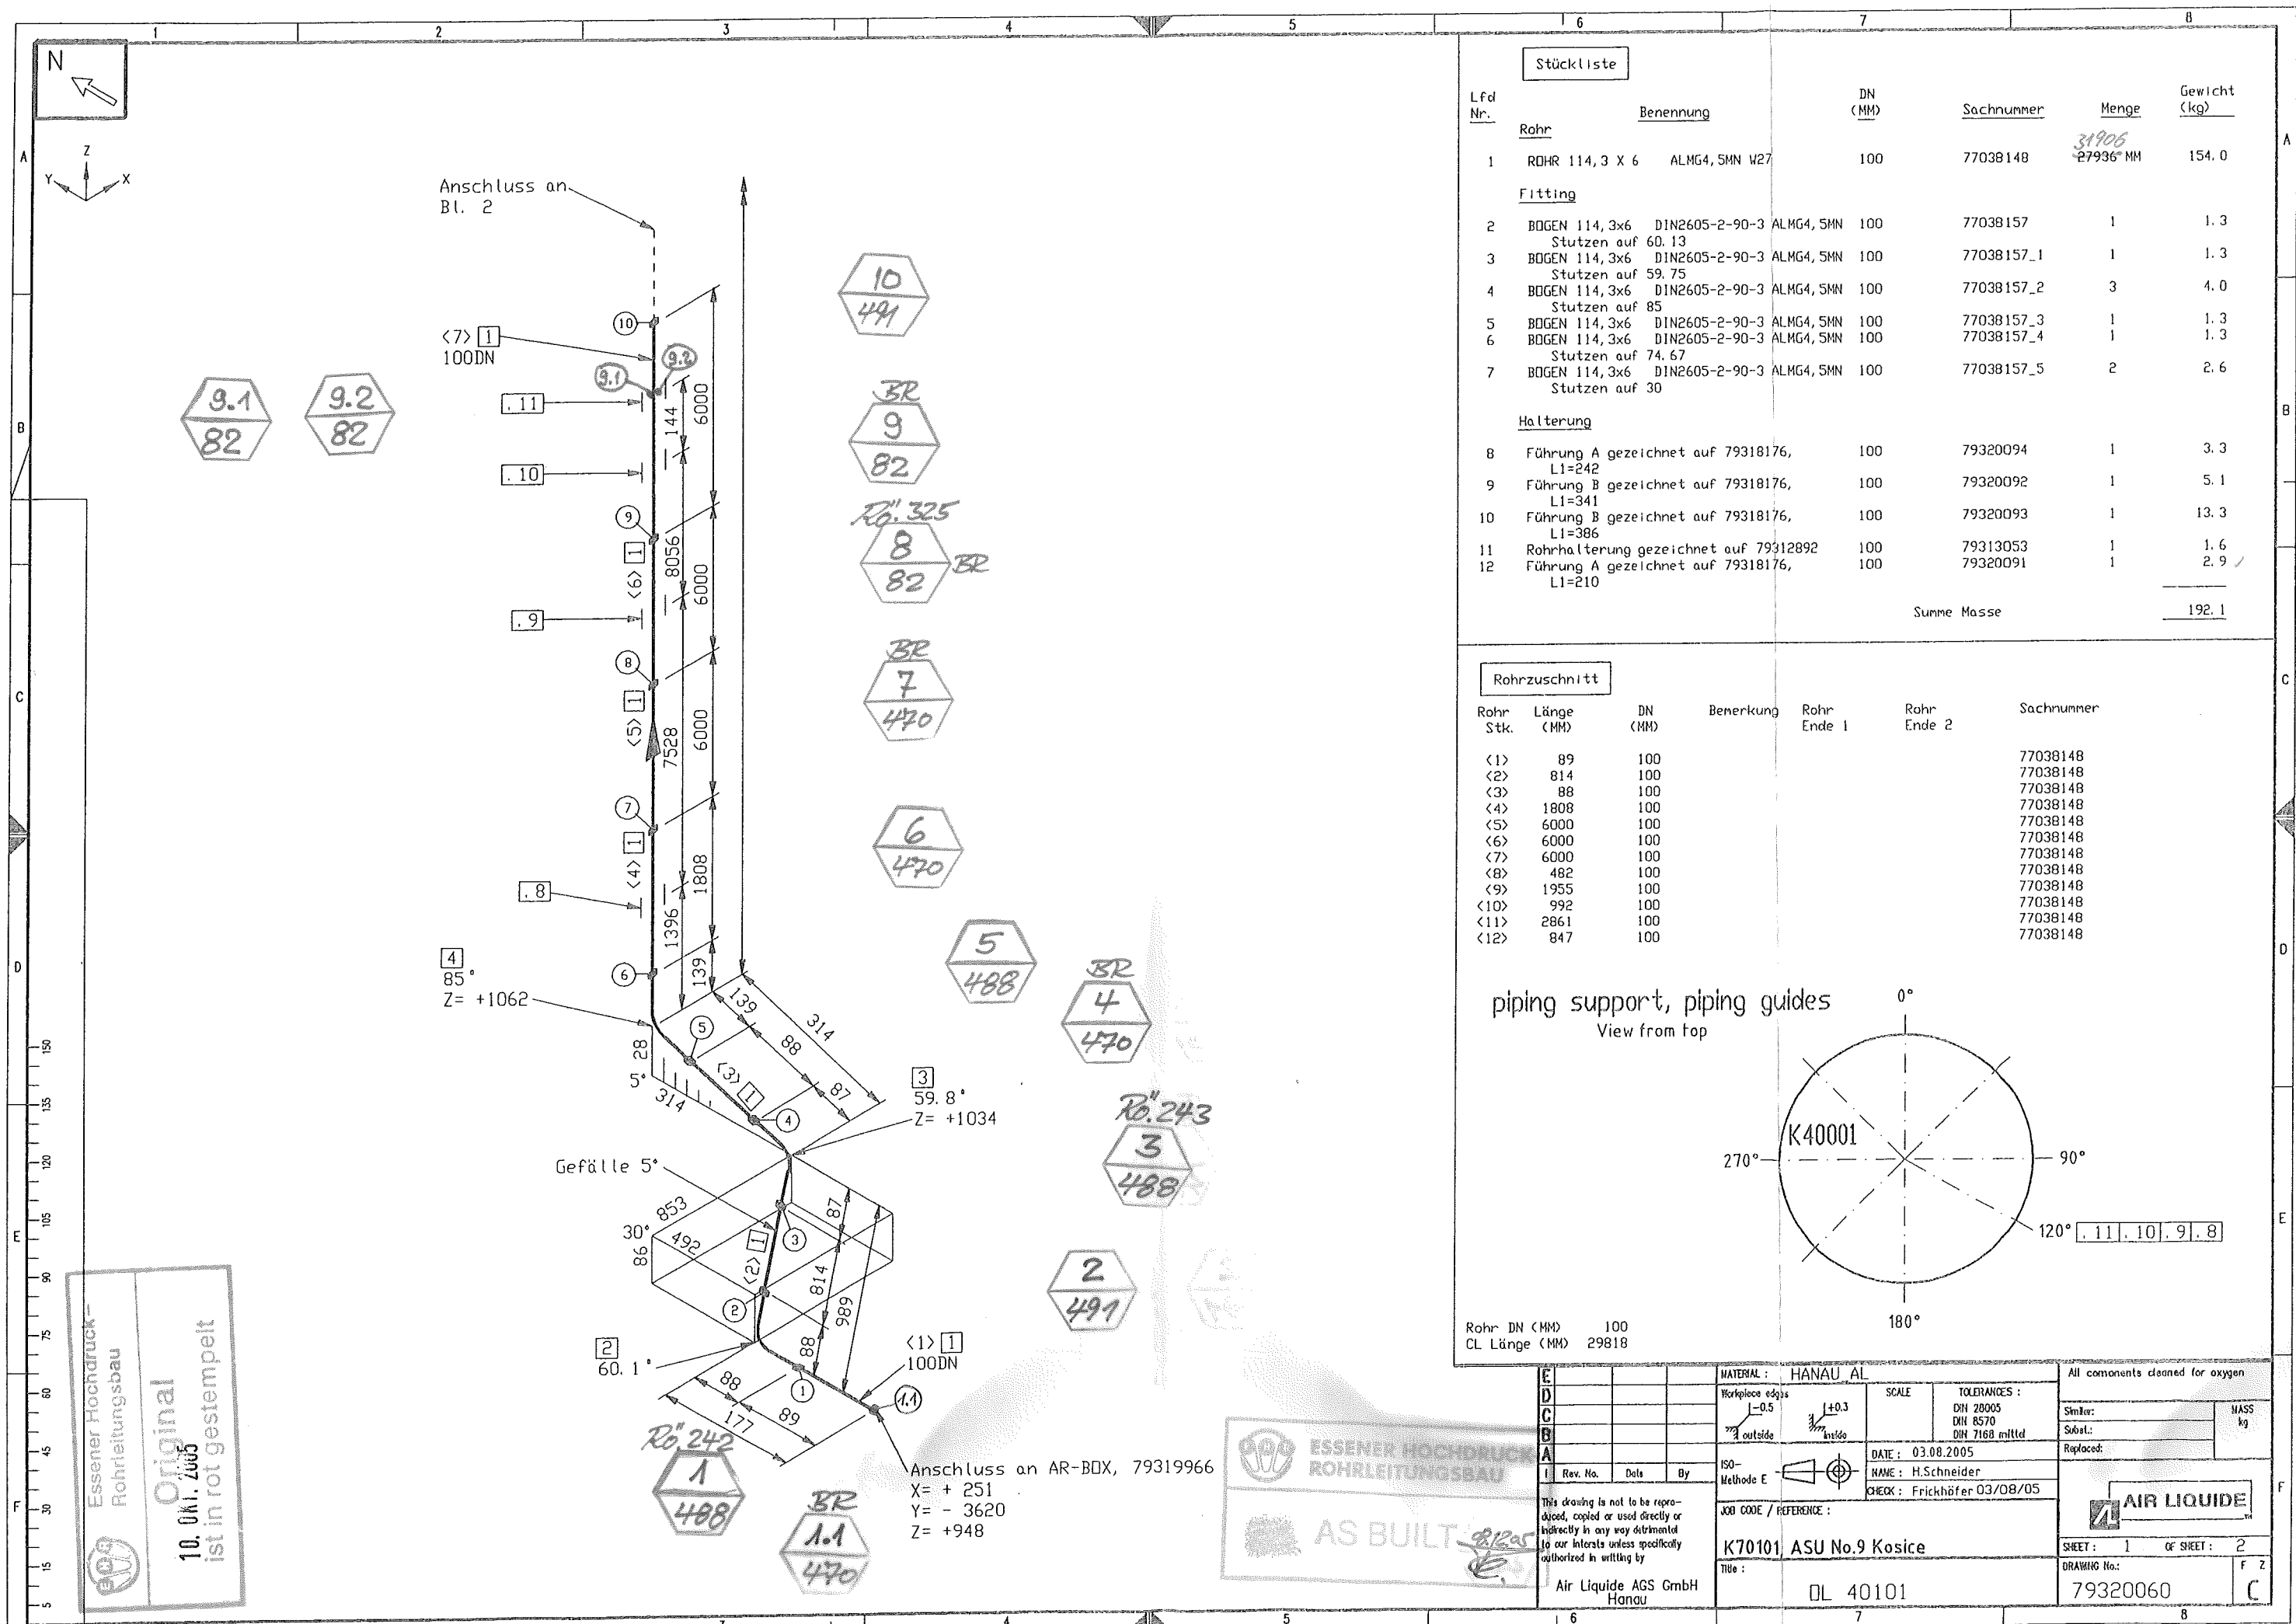

Stückliste					
Lfd. Nr.	Benennung	DN (MM)	Sachnummer	Menge	Gewicht (kg)
1	ROHR 114,3 X 6 ALMG4, 5MN W27	100	77038148	31906 27936 MM	154.0
Fitting					
2	BOGEN 114,3x6 DIN2605-2-90-3 ALMG4, 5MN	100	77038157	1	1.3
3	Stutzen auf 60.13		77038157_1	1	1.3
4	BOGEN 114,3x6 DIN2605-2-90-3 ALMG4, 5MN	100	77038157_2	3	4.0
5	Stutzen auf 85		77038157_3	1	1.3
6	BOGEN 114,3x6 DIN2605-2-90-3 ALMG4, 5MN	100	77038157_4	1	1.3
7	Stutzen auf 74.67		77038157_5	2	2.6
Halterung					
8	Führung A gezeichnet auf 79318176, L1=242	100	79320094	1	3.3
9	Führung B gezeichnet auf 79318176, L1=341	100	79320092	1	5.1
10	Führung B gezeichnet auf 79318176, L1=386	100	79320093	1	13.3
11	Rohrhalterung gezeichnet auf 79312892	100	79313053	1	1.6
12	Führung A gezeichnet auf 79318176, L1=210	100	79320091	1	2.9
Summe Masse					192.1

Rohrzuschnitt						
Rohr Stk.	Länge (MM)	DN (MM)	Benennung	Rohr Ende 1	Rohr Ende 2	Sachnummer
<1>	89	100				77038148
<2>	814	100				77038148
<3>	88	100				77038148
<4>	1808	100				77038148
<5>	6000	100				77038148
<6>	6000	100				77038148
<7>	6000	100				77038148
<8>	482	100				77038148
<9>	1955	100				77038148
<10>	992	100				77038148
<11>	2861	100				77038148
<12>	847	100				77038148

pipng support, piping guides
View from top

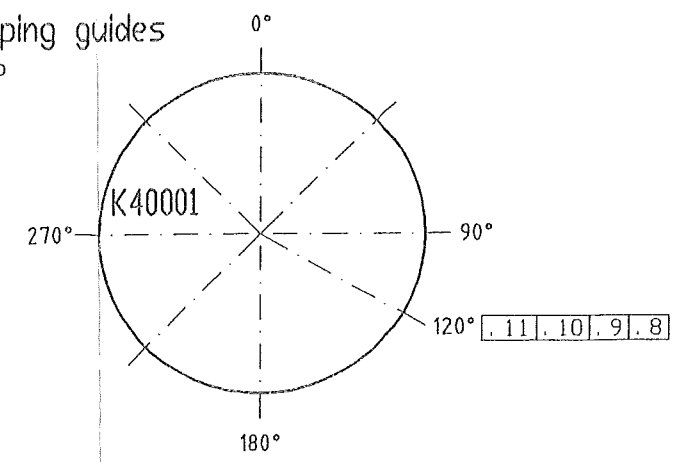

Rohr DN (MM) 100
CL Länge (MM) 29818

E		MATERIAL: HANAU AL		All components cleaned for oxygen	
D		Workpiece edges	SCALE	TOLERANCES:	Similar:
C		±0.5		DIN 28005	Subst.:
B		outside		DIN 8570	Replaced:
A		inside		DIN 7168 mittl	
Rev. No.	Dats	By	ISO-Methode E	DATE: 03.08.2005	
				NAME: H.Schneider	
				CHECK: Frickhöfer 03/08/05	
This drawing is not to be reproduced, copied or used directly or indirectly in any way detrimental to our interests unless specifically authorized in writing by			JOB CODE / REFERENCE:		
Air Liquide AGS GmbH Hanau			K70101 ASU No.9 Kosice		
			Tite: DL 40101		
			SHEET: 1 OF SHEET: 2		
			DRAWING No.: 79320060		
			F Z C		

Essener Hochdruck-Rohrleitungsbau
Original
10. Okt. 2005
ist in rot gestempelt

ESSENER HOCHDRUCK-ROHRLEITUNGSBAU
AS BUILT