



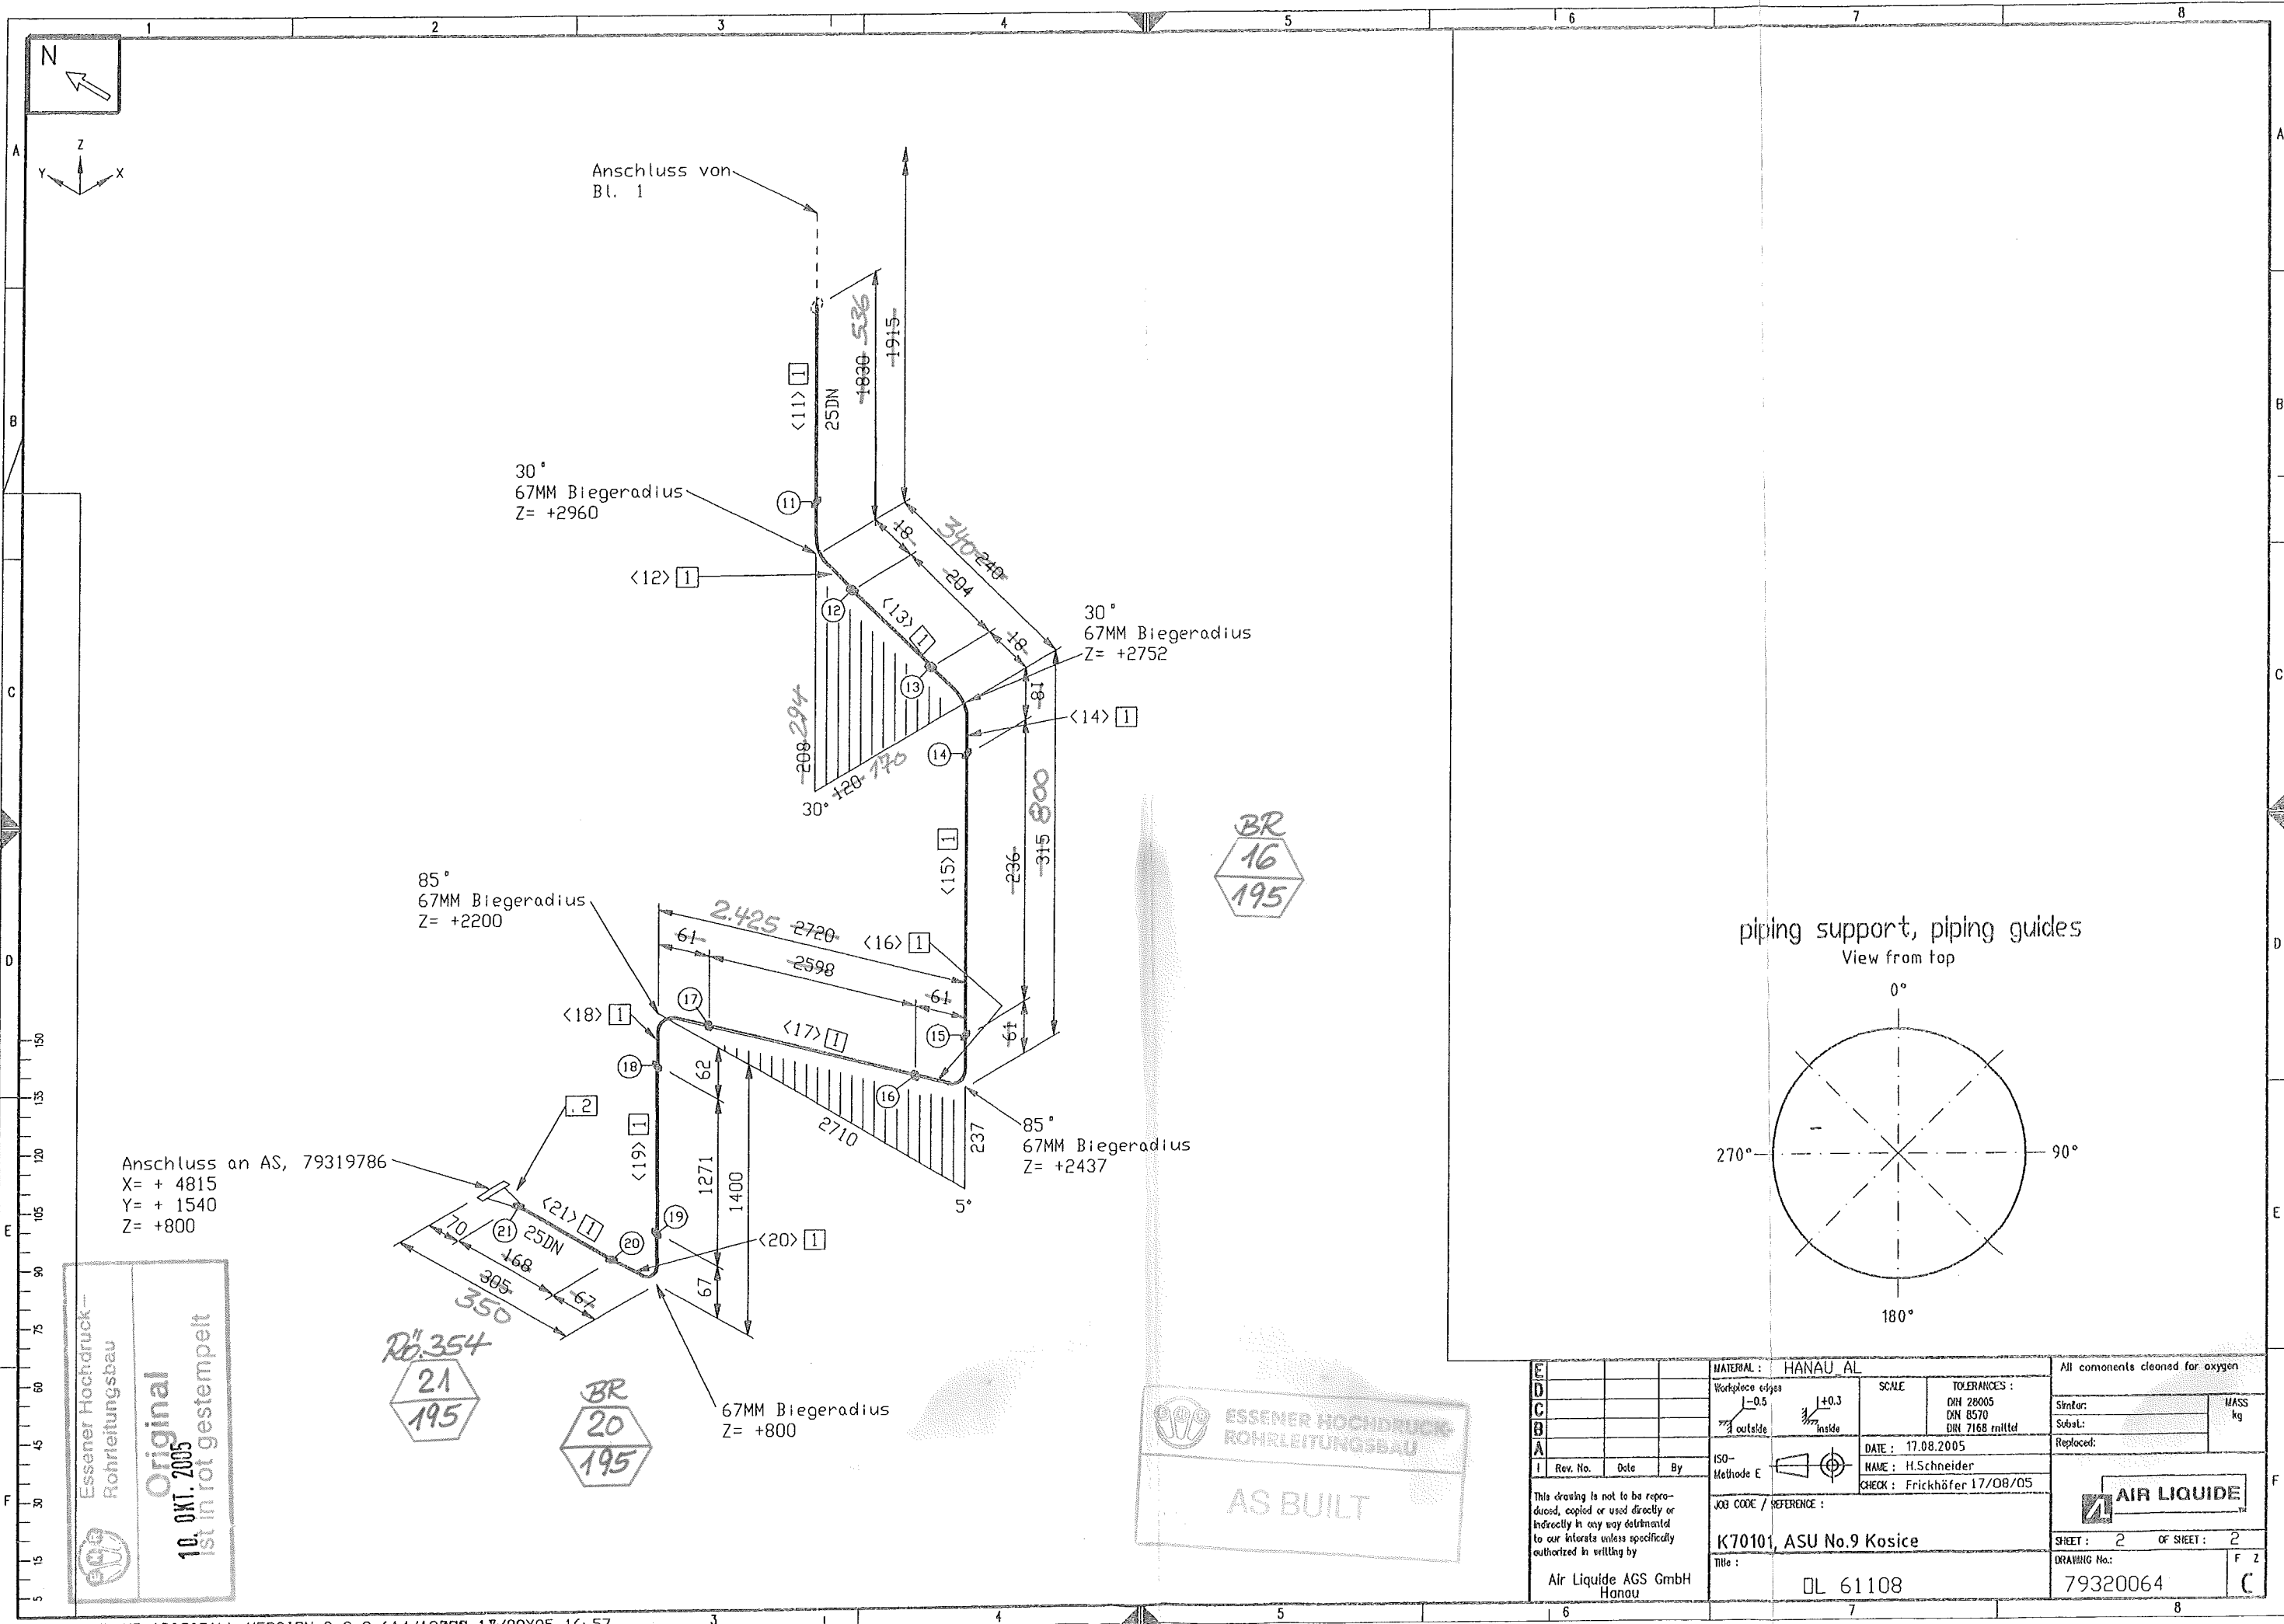

piping support, piping guides
View from top

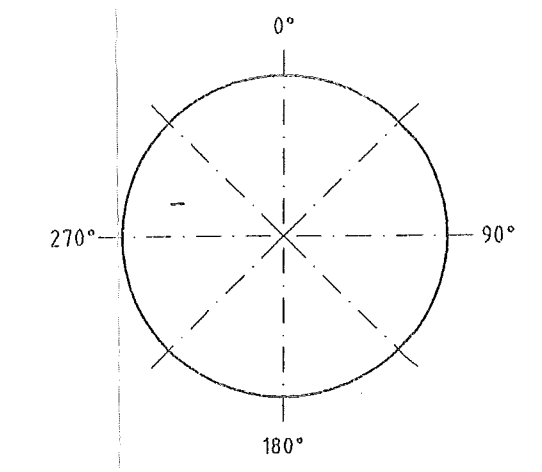

MATERIAL : HANAU AL			SCALE		TOLERANCES :		All components cleaned for oxygen	
Workpiece edges			±0.5		DIN 28005		Sinker:	
±0.3			±0.3		DIN 8570		Subst:	
±0.3			±0.3		DIN 7168 milled		Replaced:	
ISO-Methode E			DATE : 17.08.2005		NAME : H.Schneider		AIR LIQUIDE	
JOB CODE / REFERENCE :			CHECK : Frickhöfer 17/08/05		SHEET : 2		OF SHEET : 2	
K70101, ASU No.9 Kosice			Title :		DRAWING No.:		79320064	
Air Liquide AGS GmbH Hanau			DL 61108		F Z		C	

Essener Hochdruck-
Rohrleitungsba
Original
10.0KT. 2005
ist in rot gestempelt

ESSENER HOCHDRUCK-
ROHRLEITUNGSBAU
AS BUILT