



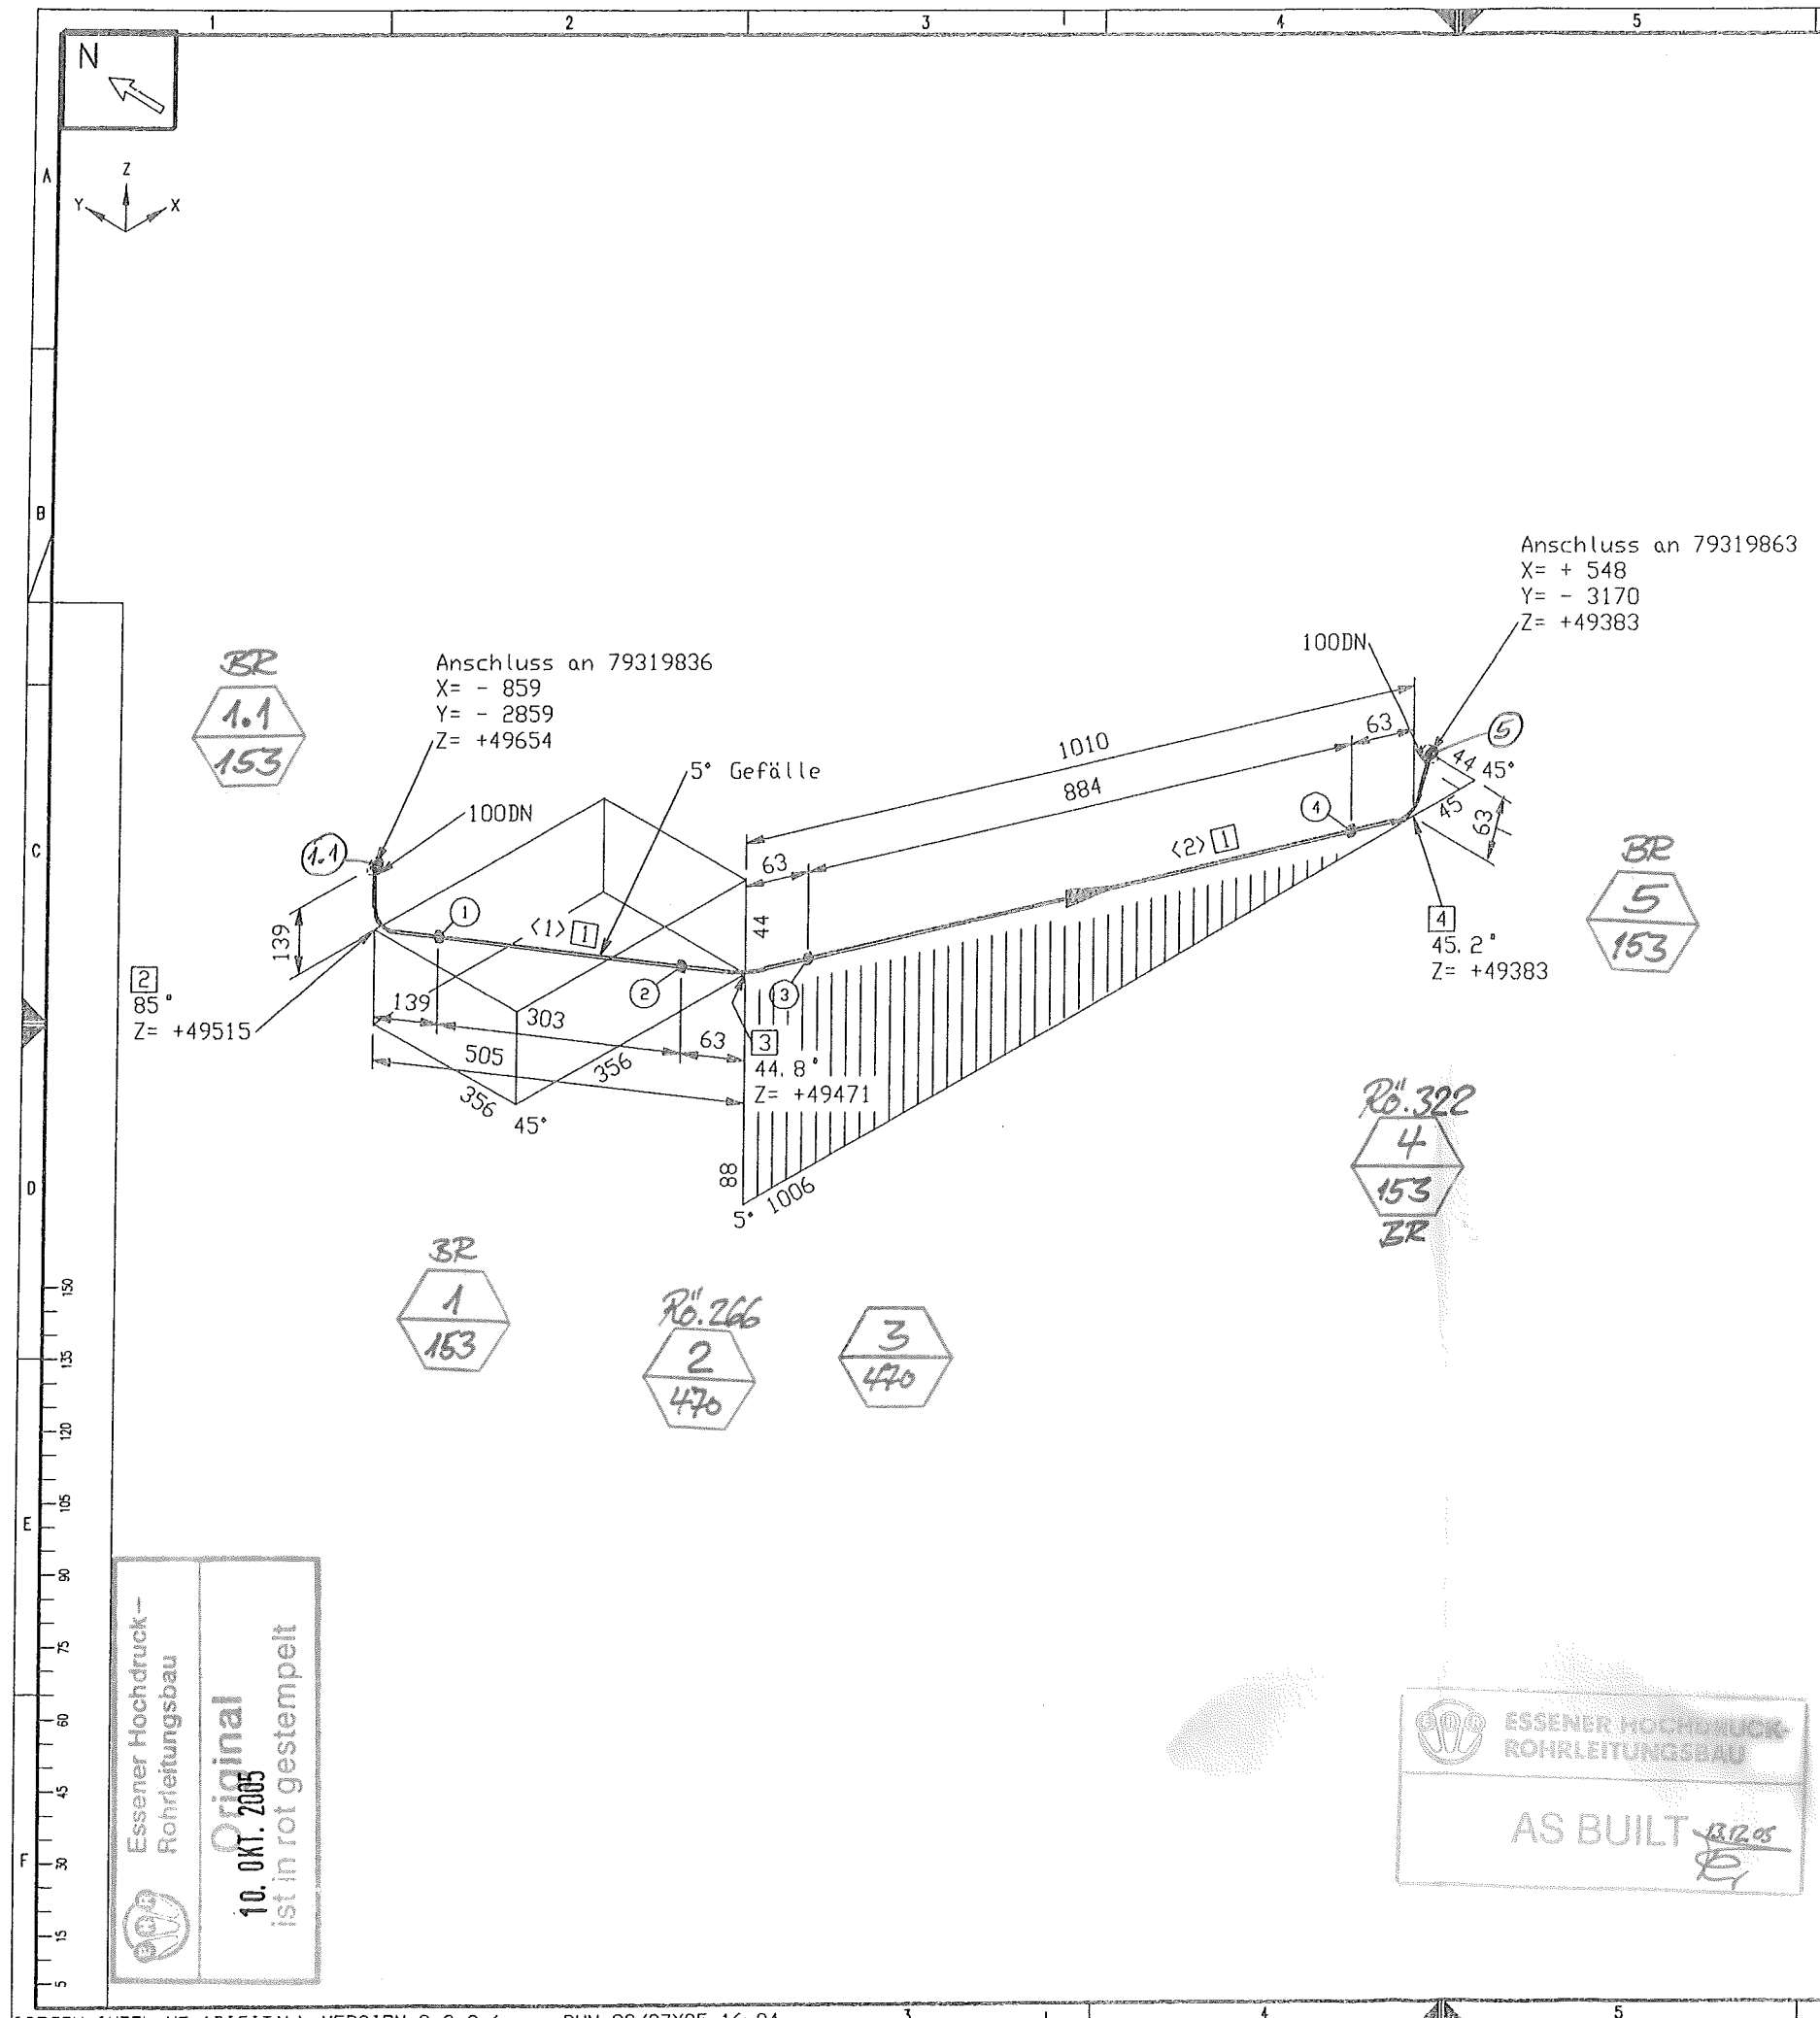

Stückliste						
Lfd Nr.	Benennung	DN (MM)	Sachnummer	Menge	Gewicht (kg)	
	<u>Rohr</u>					
1	ROHR 114,3 X 6 ALMG4, 5MN W27	100	77038148	1187 MM	6.5	
	<u>Fitting</u>					
2	BOGEN 114,3x6 DIN2605-2-90-3 ALMG4, 5MN Stutzen auf 85	100	77038157	1	1.3	
3	BOGEN 114,3x6 DIN2605-2-90-3 ALMG4, 5MN Stutzen auf 44.82	100	77038157_1	1	1.3	
4	BOGEN 114,3x6 DIN2605-2-90-3 ALMG4, 5MN Stutzen auf 45.22	100	77038157_2	1	1.3	
Summe Masse					10.5	

Rohrzuschnitt						
Rohr Stk.	Länge (MM)	DN (MM)	Bemerkung	Rohr Ende 1	Rohr Ende 2	Sachnummer
<1>	303	100				77038148
<2>	884	100				77038148

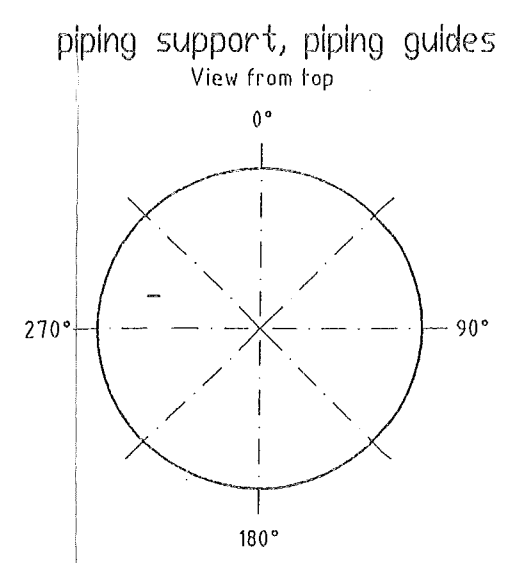

Rohr DN (MM) 100
 CL Länge (MM) 1717

Essener Hochdruck-
 Rohrleitungsbau
 Original
 10. Okt. 2005
 ist in rot gestempelt

ESSENER HOCHDRUCK-
 ROHRLEITUNGSBAU
 AS BUILT 13.12.05

E		MATERIAL: HANAU AL		All components cleaned for oxygen	
D		Workpiece edges	SCALE	TOLERANCES:	
C		±0.5		DIN 28005	Similar:
B		outside		DIN 8570	Subst:
A				DIN 7168 mittel	Replaced:
I	Rev. No.	Date	By	DATE: 28.07.2005	
				NAME: H.Schneider	
				CECK: Frickhöfer 28/07/05	
This drawing is not to be reproduced, copied or used directly or indirectly in any way detrimental to our interests unless specifically authorized in writing by				AIR LIQUIDE	
Job CODE / REFERENCE:				SHEET: 1 OF SHEET: 1	
Title:				DRAWING No.: 79320079	
Air Liquide AGS GmbH Hanau				F Z	
DL 40007				C	