



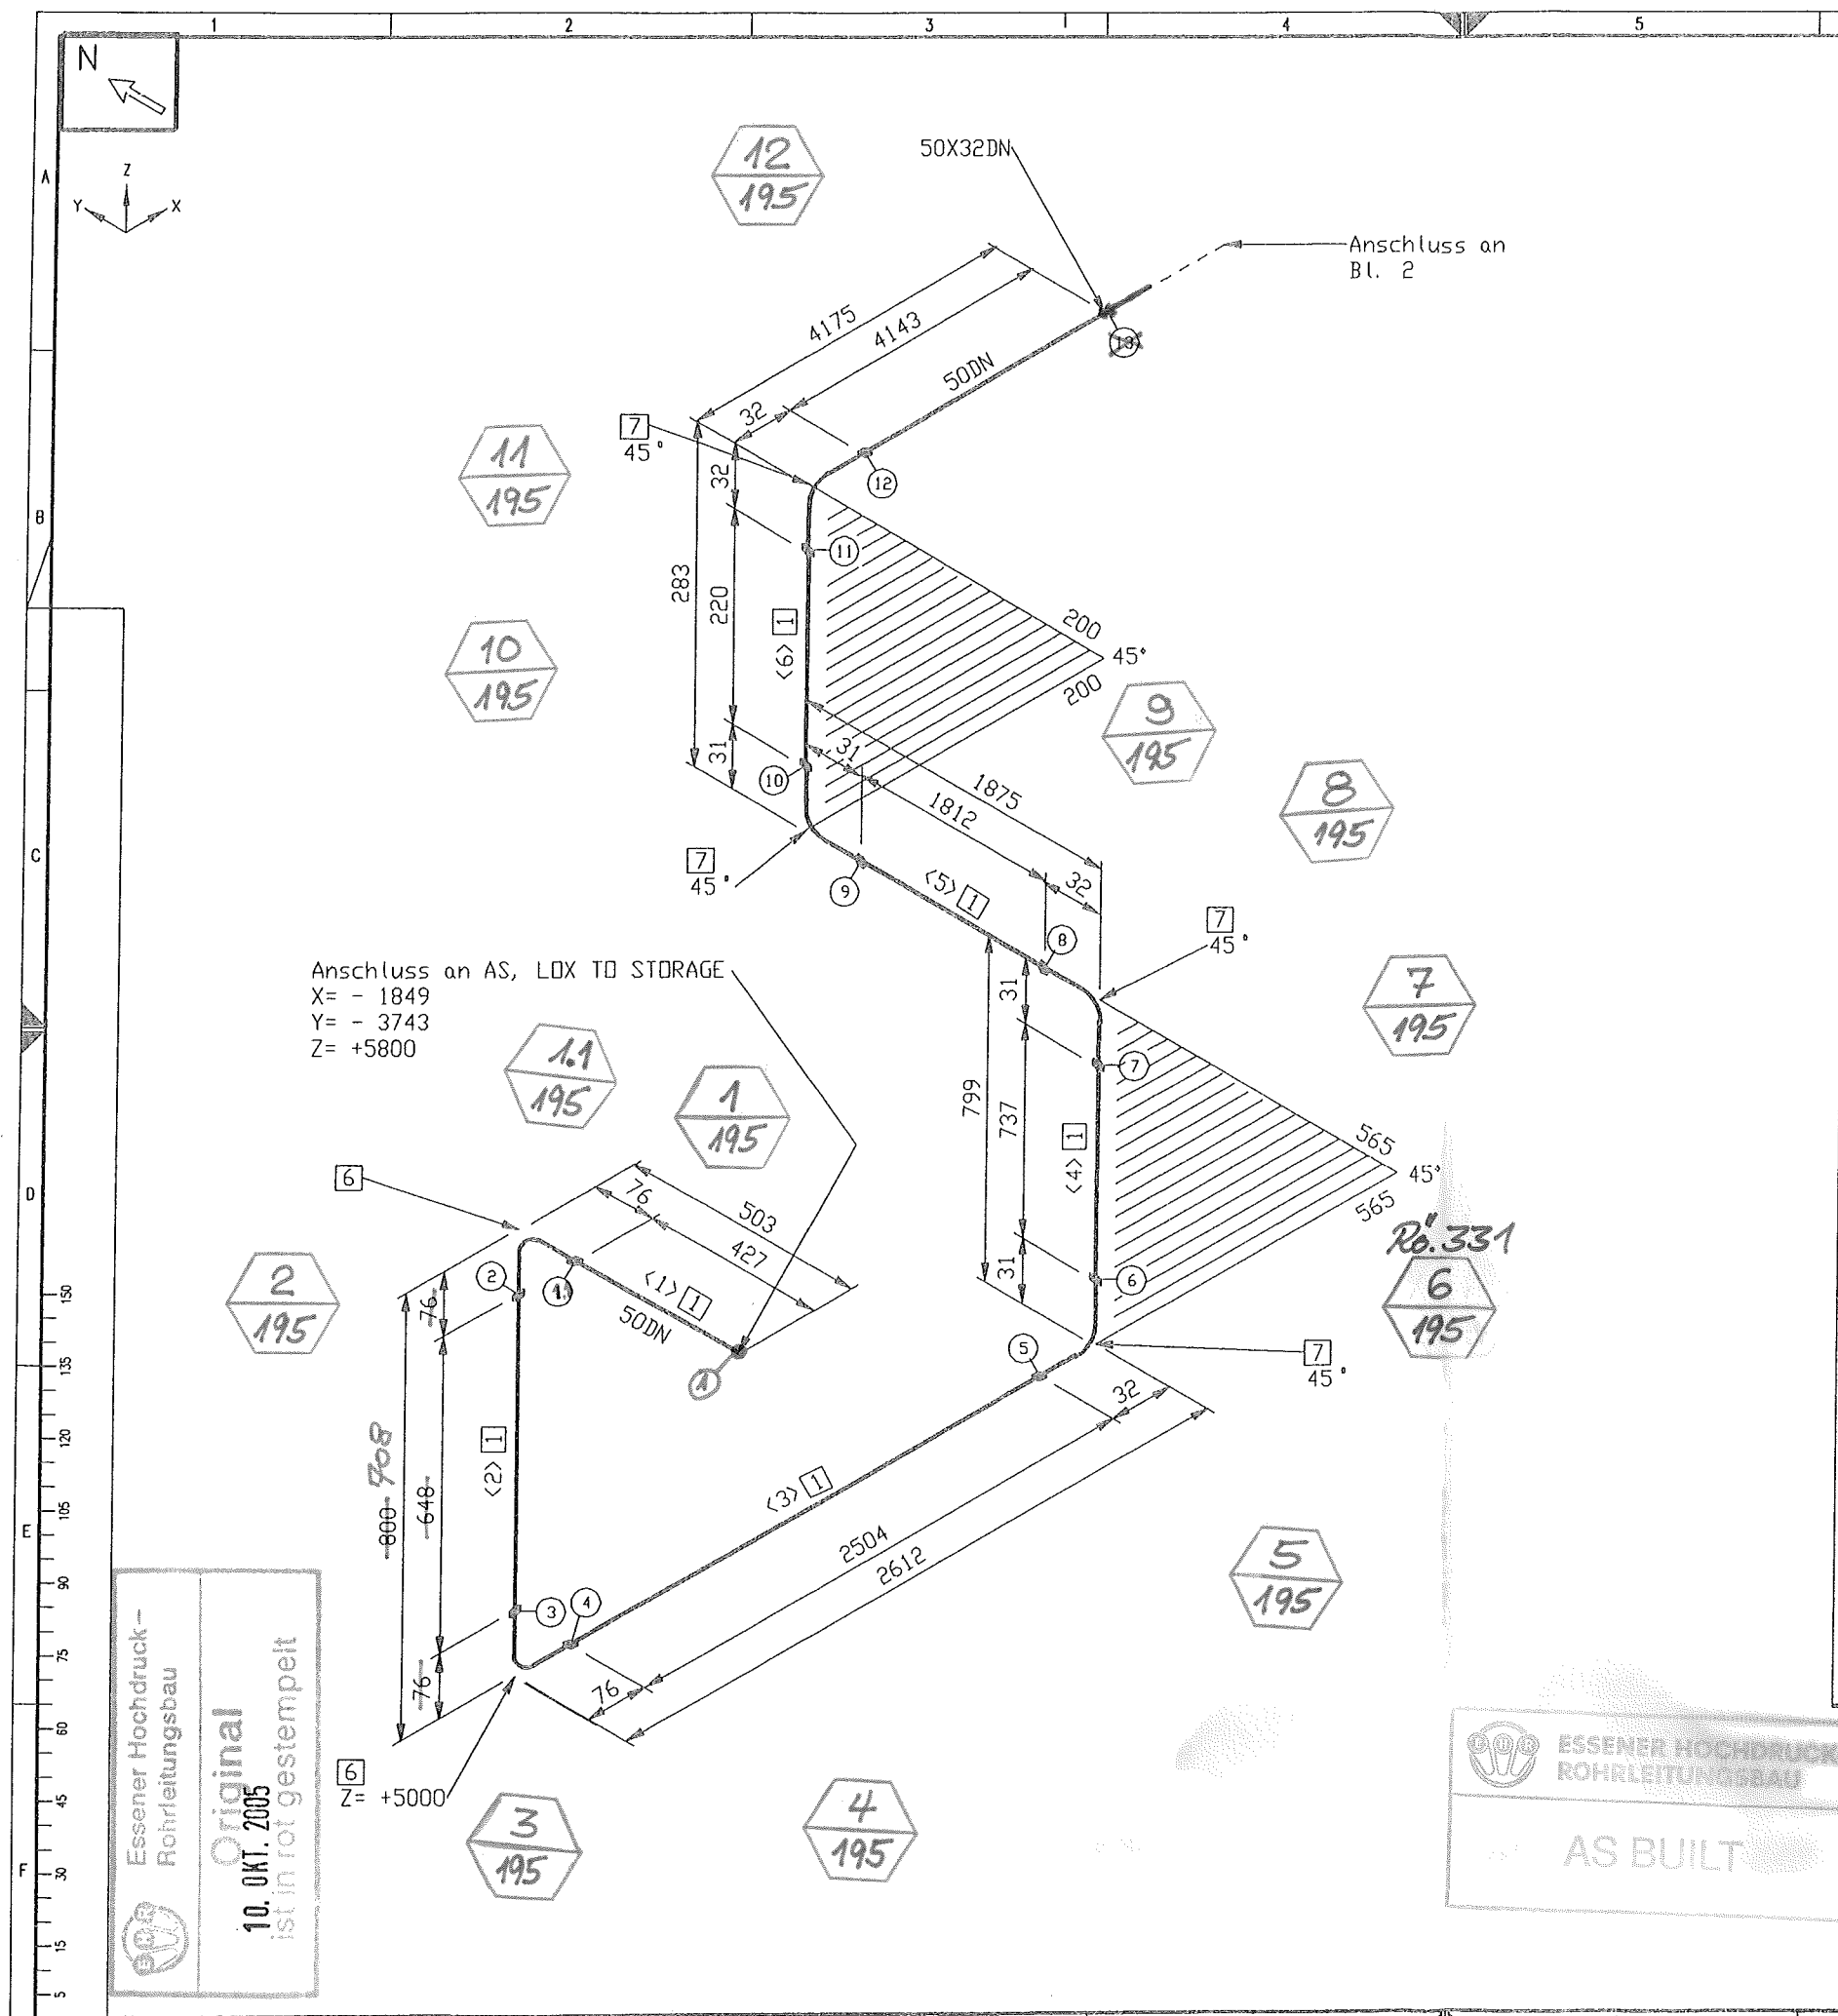

Stückliste					
Lfd Nr.	Benennung	DN (MM)	Sachnummer	Menge	Gewicht (kg)
Rohr					
1	RDHR 60,3 x 2,9 1.4541	50	0004980	11319 MM	46.5
2	RDHR 60,3 x 3,9 ALMG4, 5MN W27	50	77038146	1110 MM	2.1
3	RDHR 42,4 x 2,9 1.4541	32	77038829	4679 MM	12.4
Fitting					
4	T-Stutzen 60,3x3,9 gez. auf 79311532	50X50	79313693	2	0.2
5	RED. -STUCK-K- 60,3 x 3,9- 33,4 x 3,4 gez. auf 79313824	50X25	79313825	2	0.3
6	BOGEN R=1.5 60,3 x 2,9 1.4541	50	0375038	4	2.0
7	BOGEN R=1.5 60,3 x 2,9 1.4541	50	0375038_1	4	2.0
8	BOGEN 60,3x3,9 DIN2605-2-90-3 ALMG4, 5MN	50	77038155	1	0.2
9	TRANSITIONJOINT DN 50/PN40	50	77038167	1	1.2
10	BOGEN 60,3x3,9 DIN2605-2-90-3 ALMG4, 5MN	50	77038155_1	1	0.2
Ventil					
11	Eck-Ventil AL DN 25 / PN 40	25	77038864	1	40.0
Halterung					
12	Bordscheibe gezeichnet auf 79312379	32	79320098	1	0.3
Summe Masse					107.3

Rohrzuschnitt						
Rohr Stk.	Länge (MM)	DN (MM)	Bemerkung	Rohr Ende 1	Rohr Ende 2	Sachnummer
<1>	427	50				0004980
<2>	648	50				0004980
<3>	2504	50				0004980
<4>	737	50				0004980
<5>	1812	50				0004980
<6>	220	50				0004980
<7>	758	32				770.38829
<8>	134	32	PLD BEND(1)			770.38829
<9>	342	32				770.38829
<10>	134	32	PLD BEND(1)			770.38829
<11>	1754	32				770.38829
<12>	134	32	PLD BEND(1)			770.38829
<13>	134	32	PLD BEND(1)			770.38829
<14>	995	32				770.38829
<15>	134	32	PLD BEND(1)			770.38829
<16>	160	32				770.38829
<17>	4239	50				0004980
<18>	630	50				0004980
<19>	102	50				0004980
<20>	356	50				77038146
<21>	130	50				77038146
<22>	624	50				77038146

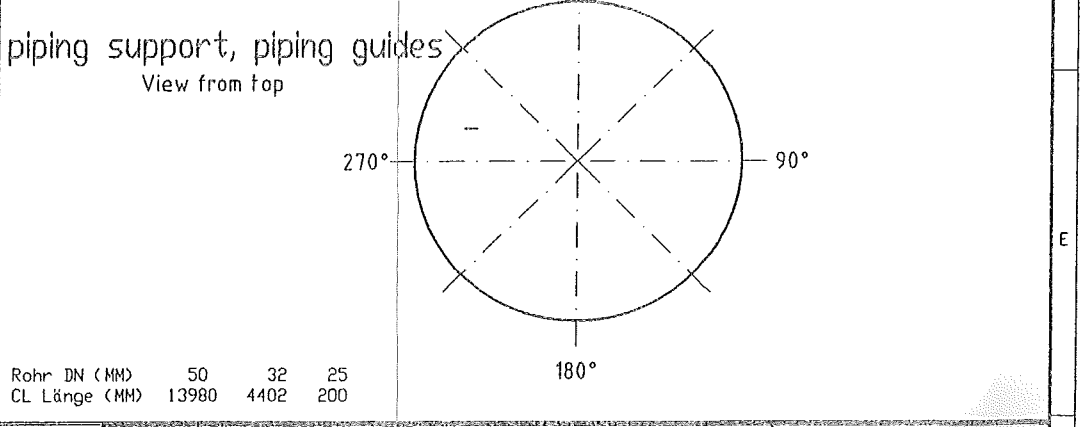

ESSENER HOCHDRUCK-ROHRLEITUNGSBAU AS BUILT		HANAU VA MATERIAL: HANAU VA SCALE: 1:100 DATE: 12.08.2005 NAME: H.Schneider CHECK: Frickhöfer 12/08/05		All components cleaned for oxygen Sinker: _____ Subst.: _____ Replaced: _____	
This drawing is not to be reproduced, copied or used directly or indirectly in any way detrimental to our interests unless specifically authorized in writing by Air Liquide AGS GmbH Hanau		JOB CODE / REFERENCE: K70101, ASU No.9 Kosice Title: DL 61102		AIR LIQUIDE SHEET: 1 OF SHEET: 3 DRAWING No.: 79320097	