



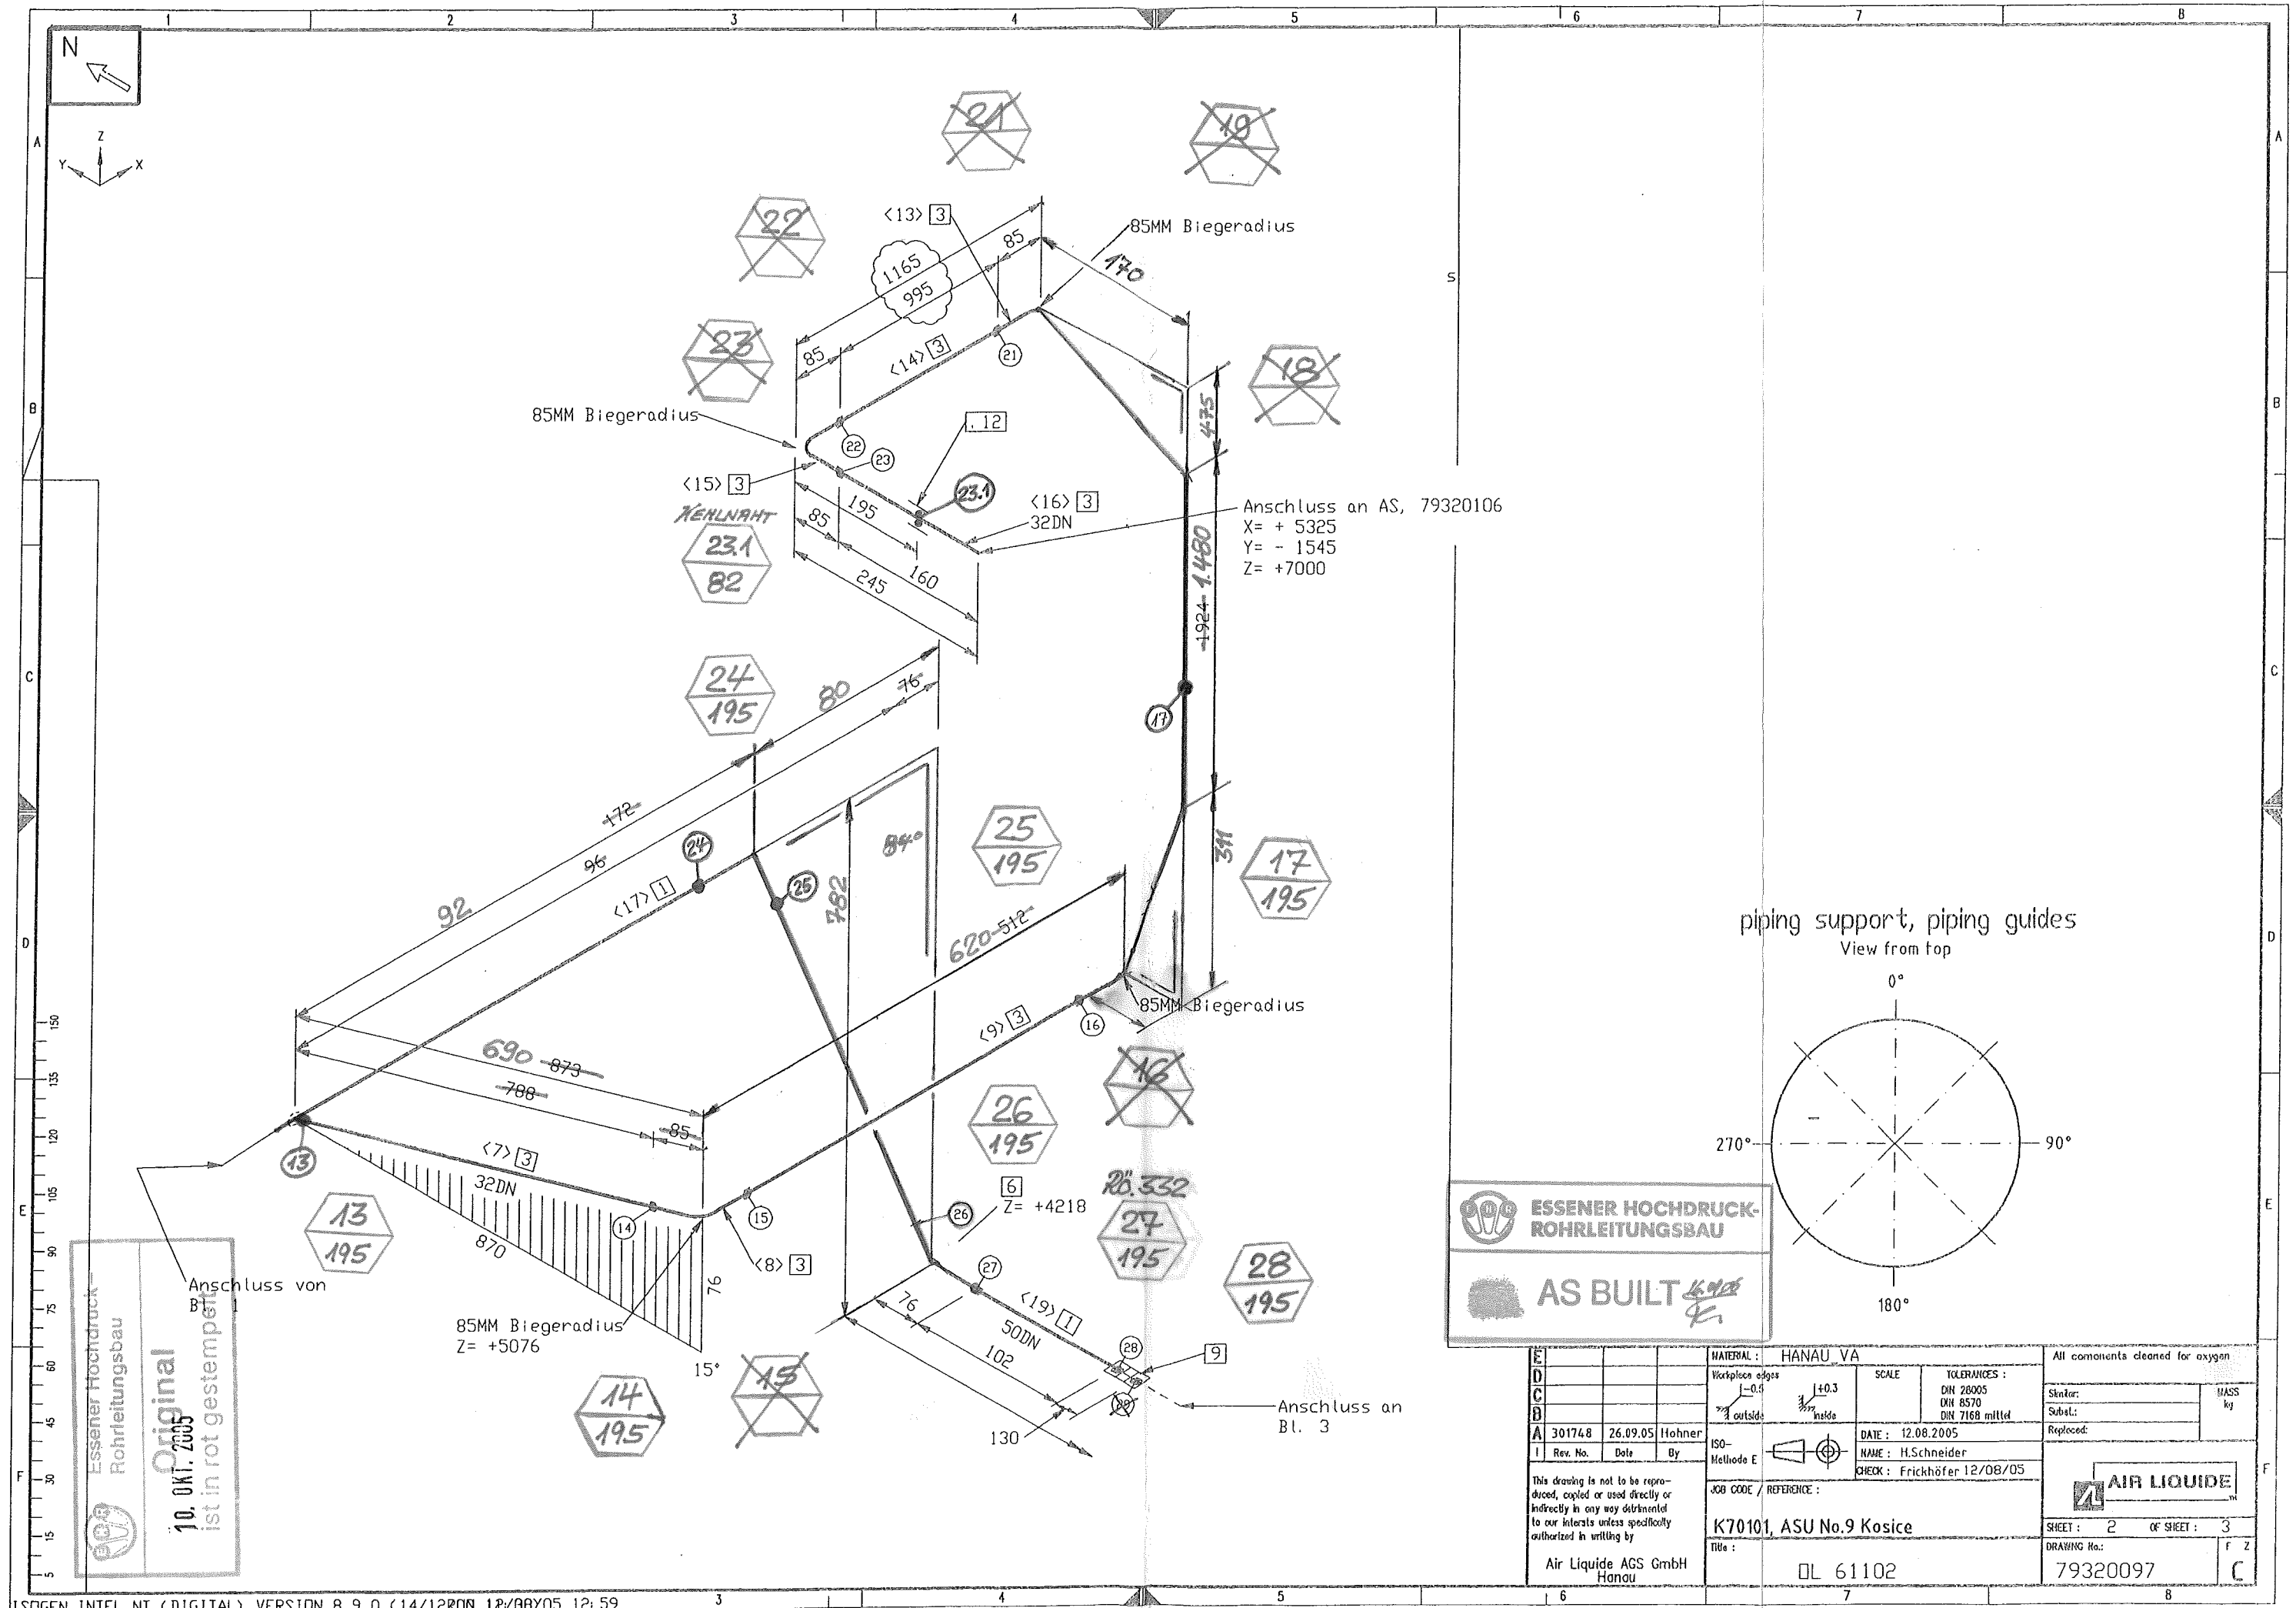

piping support, piping guides
View from top

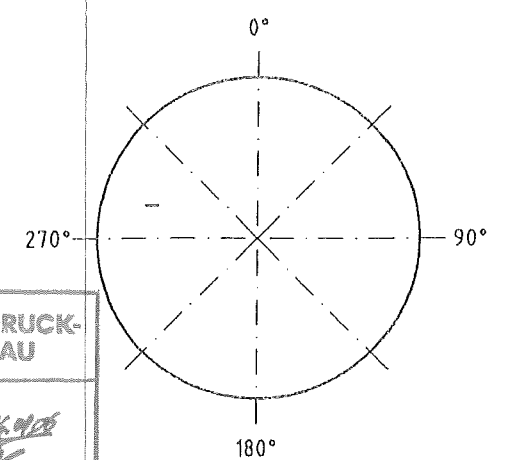

ESSENER HOCHDRUCK-ROHRLEITUNGSBAU

AS BUILT

E					MATERIAL :	HANAU VA		All components cleaned for oxygen	
D					Workpiece edges			SCALE	TOLERANCES :
C									DIN 28005
B									DIN 8570
A	301748	26.09.05	Hohner						DIN 7168 milled
I	Rev. No.	Date	By		ISO-	DATE : 12.08.2005		Skater:	DASS kg
					Methode E	NAME : H.Schneider		Subst:	
This drawing is not to be reproduced, copied or used directly or indirectly in any way detrimental to our interests unless specifically authorized in writing by Air Liquide AGS GmbH Hanau						CHECK : Frickhöfer 12/08/05		Replaced:	
					JOB CODE / REFERENCE :		 AIR LIQUIDE TM		
					K70101, ASU No.9 Kosice				
					Title :				
					DL 61102		SHEET : 2 OF SHEET : 3		
							DRAWING No.:		F 2
							79320097		C