



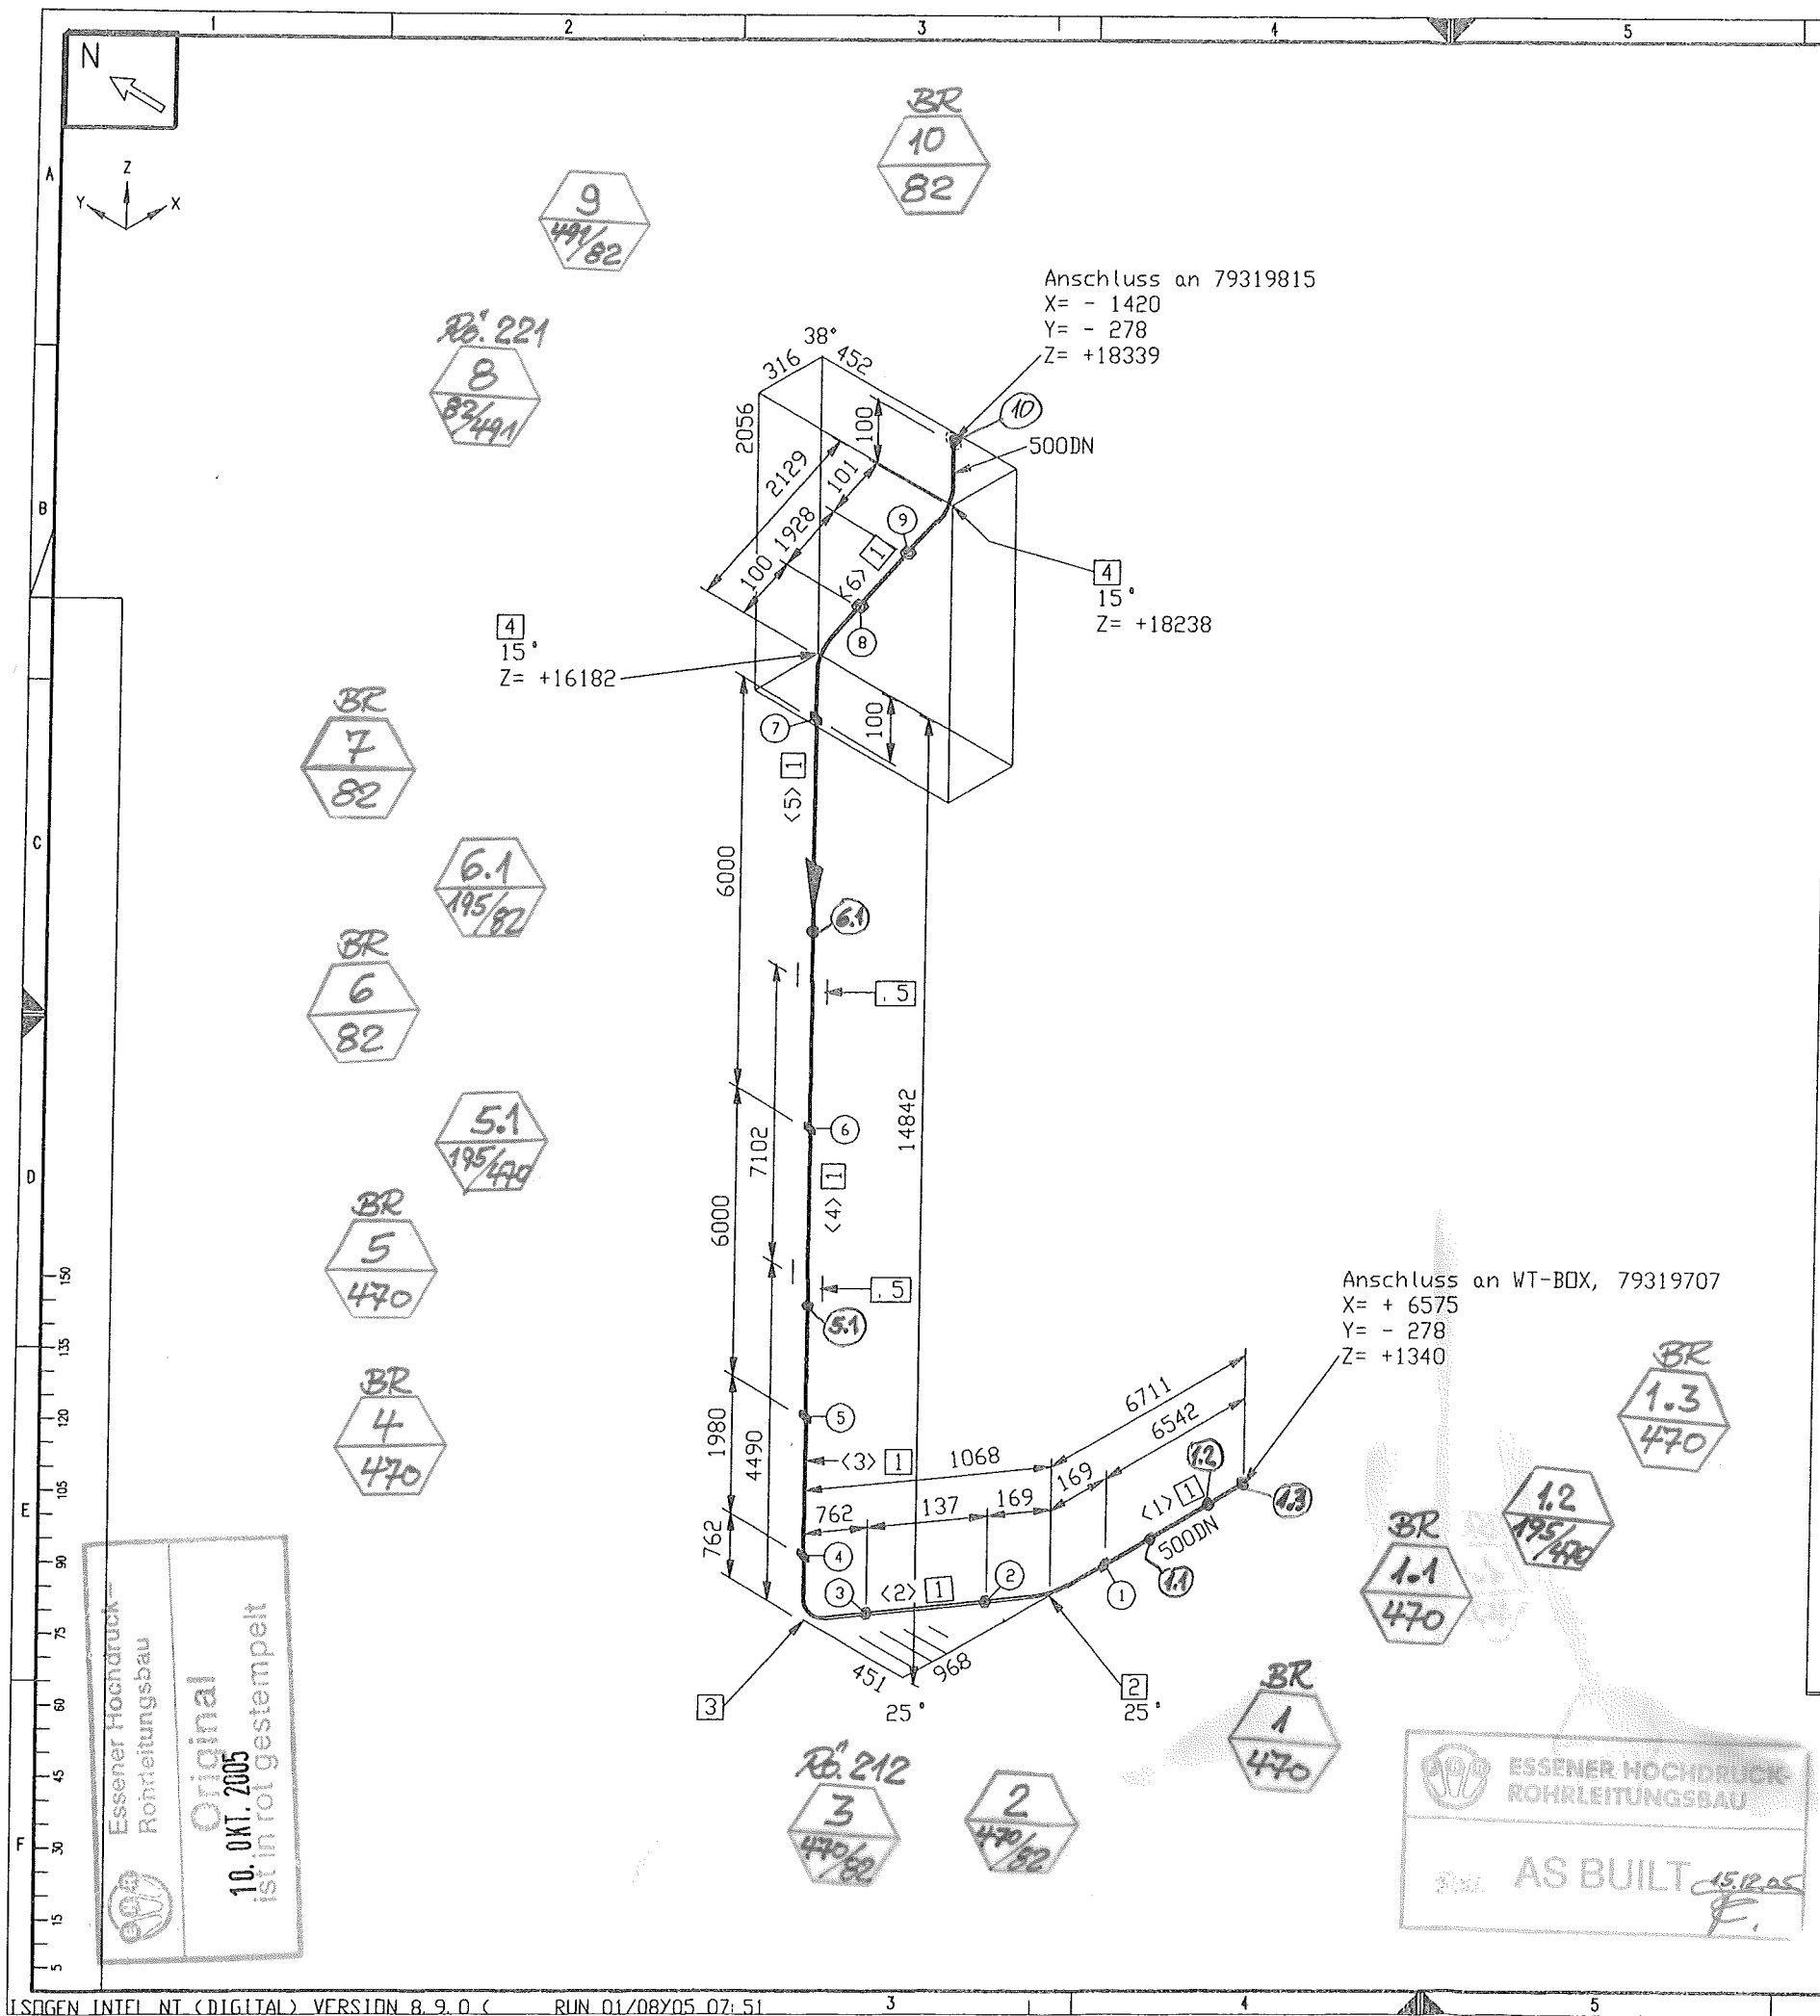

Stückliste						
Lfd. Nr.	Rohr	Benennung	DN (MM)	Sachnummer	Menge	Gewicht (kg)
1	ROHR 508 X 6	ALMG4, 5MN W27	500	77038223	22587 MM	577.1
Fitting						
2	BOGEN 508 x6	DIN2605-2-90-3 ALMG4, 5MN	500	77038238	1	30.6
3	BOGEN 508 x6	DIN2605-2-90-3 ALMG4, 5MN	500	77038238_1	1	30.6
4	BOGEN 508 x6	DIN2605-2-90-3 ALMG4, 5MN	500	77038238_2	2	61.2
Halterung						
5	Führung B gezeichnet auf 79318176,		500	79320087	2	71.6
Summe Masse						771.0

Rohrzuschnitt						
Rohr Stk.	Länge (MM)	DN (MM)	Bemerkung	Rohr Ende 1	Rohr Ende 2	Sachnummer
<1>	6542	500				77038223
<2>	137	500				77038223
<3>	1980	500				77038223
<4>	6000	500				77038223
<5>	6000	500				77038223
<6>	1928	500				77038223

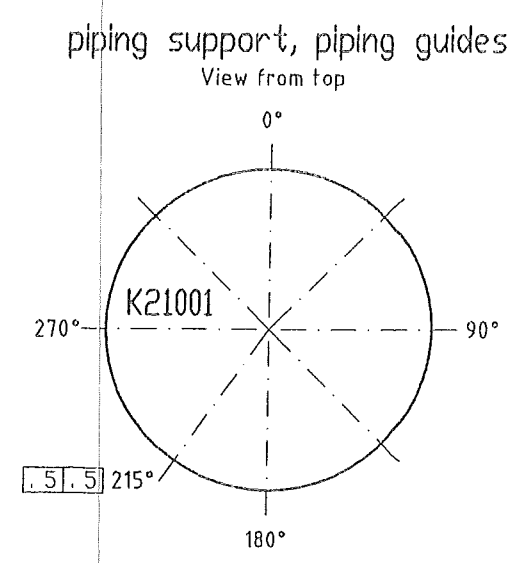

Rohr DN (MM) 500
CL Länge (MM) 24850

E		D		C		B		A		I		Rev. No.		Date		By		ISO-Methode E		This drawing is not to be reproduced, copied or used directly or indirectly in any way detrimental to our interests unless specifically authorized in writing by		Air Liquide AGS GmbH Hanau	
MATERIAL: HANAU AL		Workpiece edges		J-0.5		J+0.3		SCALE		TOLERANCES:		DN 28005		DN 8570		DN 7168 mittel		DATE: 01.08.2005		NAME: H.Schneider		CECK: Frickhöfer 01/08/05	
All components cleaned for oxygen		Similar:		Subst:		Replaced:		MASS kg		AIR LIQUIDE		SHEET: 1		OF SHEET: 1		DRAWING No.:		79319889		F Z		C	
K7010		ASU No.9 Kosice		Tide:		N 22007																	

Essener Hochdruck-
Rohrleitungsbau
Original
10. OKT. 2005
ist in rot gestempelt

ESSENER HOCHDRUCK-
ROHRLEITUNGSBAU
AS BUILT