


**Zoznam izolovaných potrubných trás a aparátov pre stavbu US STEEL Košice**  
**List of insulated pipe lines and aparates for ASU 9 and Tank Farm US STEEL Kosice****Tank Farm - izolácia Foamglass, povrchová úprava pz plech****Tank Farm - insulation Foamglass, covering by hot deep galvanised plate**

| Vetva / pipe line | Typ izolácie / type of insulation | Hr. mm / thickness | Plech / plate | Hr. mm / thickness mm | Poznámka / REMARK |
|-------------------|-----------------------------------|--------------------|---------------|-----------------------|-------------------|
| 100 NL-72002      | foamglass                         | 140                | pz/ HDG       | 0,8                   |                   |
| 100 NL-72003      | foamglass                         | 140                | pz/ HDG       | 0,8                   |                   |
| 150 NL-72002      | foamglass                         | 150                | pz/ HDG       | 0,8                   |                   |
| 50 NL-73001       | foamglass                         | 70                 | pz/ HDG       | 0,8                   |                   |
| 50 OL-61102       | foamglass                         | 110                | pz/ HDG       | 0,8                   |                   |
| 50 OL-61106       | foamglass                         | 110                | pz/ HDG       | 0,8                   |                   |
| 50 OL-63003       | foamglass                         | 110                | pz/ HDG       | 0,8                   |                   |
| 50 OL-63004       | foamglass                         | 110                | pz/ HDG       | 0,8                   |                   |
| 0 OL-64004        | foamglass                         | 120                | pz/ HDG       | 0,8                   |                   |
| 80 NL-73001       | foamglass                         | 70                 | pz/ HDG       | 0,8                   |                   |
| 80 NL-73101       | foamglass                         | 70                 | pz/ HDG       | 0,8                   |                   |
| 80 NL-73102       | foamglass                         | 70                 | pz/ HDG       | 0,8                   |                   |
| 80 NL-73201       | foamglass                         | 70                 | pz/ HDG       | 0,8                   |                   |
| 80 NL-73202       | foamglass                         | 70                 | pz/ HDG       | 0,8                   |                   |
| 40 NL-73005       | foamglass                         | 120                | pz/ HDG       | 0,8                   |                   |
| 25 NL-73005       | foamglass                         | 120                | pz/ HDG       | 0,8                   |                   |
| 50 NL-23005       | foamglass                         | 120                | pz/ HDG       | 0,8                   |                   |
| 50 NL 72003       | foamglass                         | 120                | pz/ HDG       | 0,8                   |                   |
|                   |                                   |                    |               |                       |                   |
|                   |                                   |                    |               |                       |                   |
|                   |                                   |                    |               |                       |                   |
|                   |                                   |                    |               |                       |                   |

ASBUILT

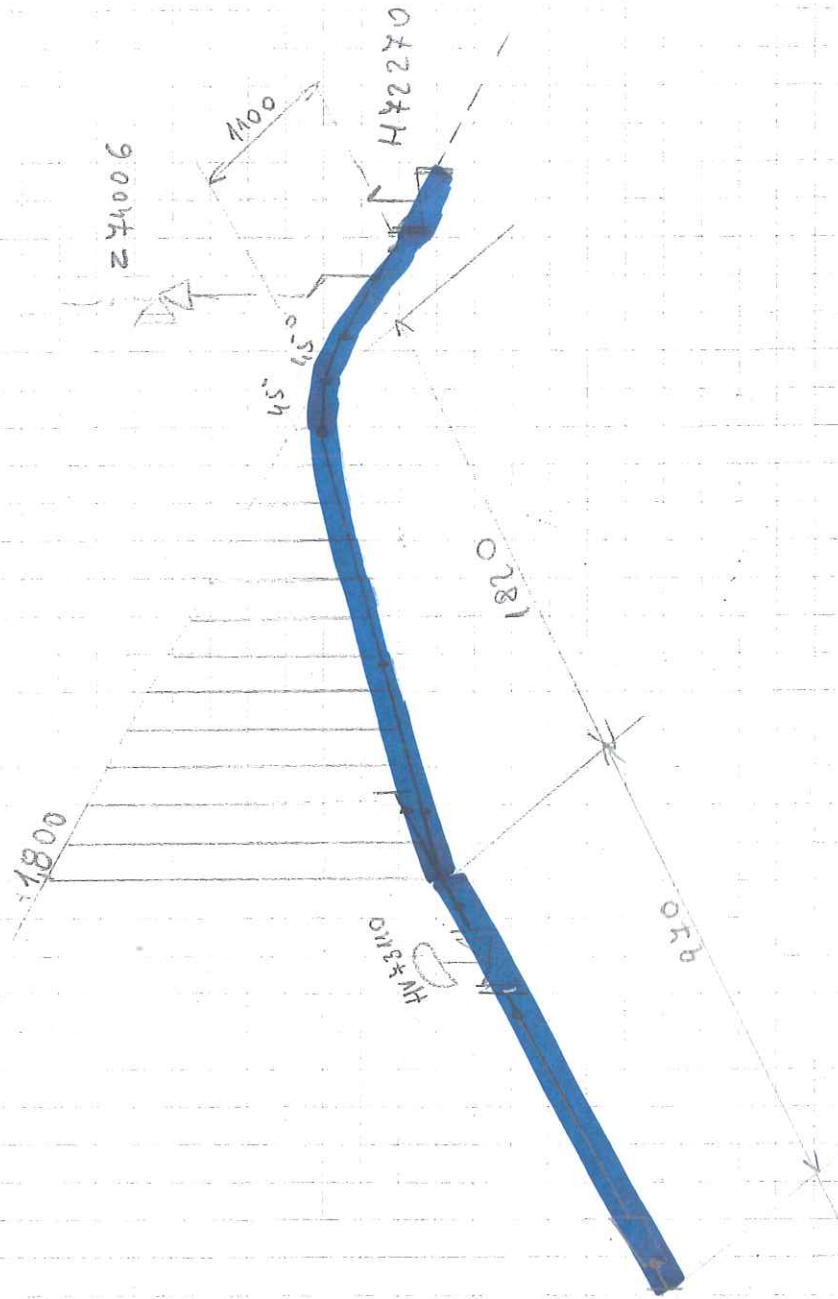

100 NL 42002

Footnotes

# THE BASICS



| Welding No. | DN    | Diameter | Welder No. | Protocol No. |
|-------------|-------|----------|------------|--------------|
| 01          | 100   | 114.3    | _____      | _____        |
| 02          | 100   | 114.3    | _____      | _____        |
| 03          | 65    | 76.1     | _____      | _____        |
| 04          | _____ | 33       | _____      | _____        |

Remarks:

Responsibility of the assembling company:

- Situation of mounting seams
- Situation of pass-lengths
- Check of measure details and pipe courses on the construction site
- Situation of the spindle at valve

Accompanying drawings:


- 100 NL-72002 ZB10C1C

Accompanying lists:

- Parts list:  
100 NL-72003-ZB10C1C

Pipe standard:

- AL Standard No.:  
50030 (ZB10C1)

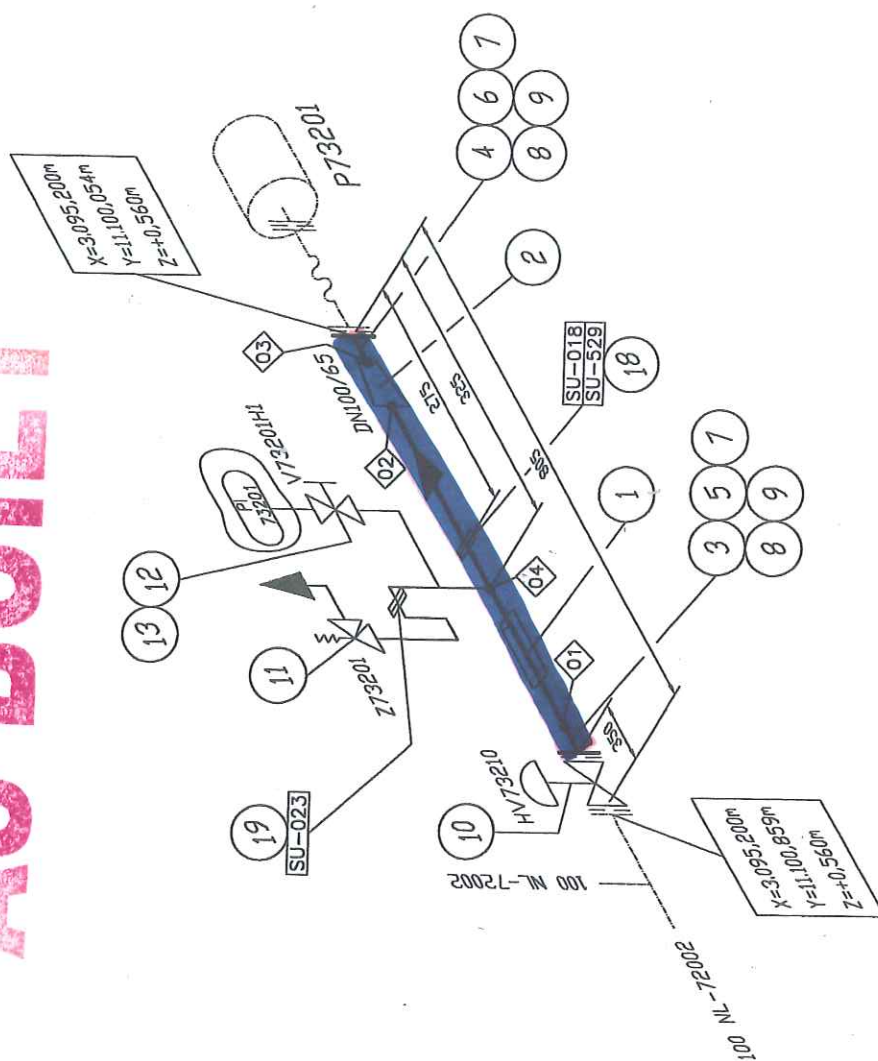



|                                                                                                                      |  |                                                                      |  |                                                           |  |                                                               |  |
|----------------------------------------------------------------------------------------------------------------------|--|----------------------------------------------------------------------|--|-----------------------------------------------------------|--|---------------------------------------------------------------|--|
| <div>  <b>AIR LIQUIDE</b> </div> |  | <div> <div>Date : 25.10.2004</div> <div>Name : Reid./ES</div> </div> |  | <div> <div>Checked:</div> <div>Hr. Gans</div> </div>      |  | <div> <div>History file:</div> <div>79287106.doc</div> </div> |  |
| <div> <div>Air Liquide AGS GmbH</div> <div>Job code: K70101</div> <div>Reference: ASU Kosice</div> </div>            |  | <div> <div>Scale</div> <div>---:---</div> </div>                     |  | <div> <div>Original format</div> <div>DIN A3</div> </div> |  | <div> <div>Sheet: 001</div> <div>of 001 Sheets</div> </div>   |  |
| <div> <div>Replaces: 79_</div> <div>Replaced by: 79_</div> </div>                                                    |  | <div> <div>Title:</div> <div>100 NL-72003</div> </div>               |  | <div> <div>Drawing No.:</div> <div>792.87106</div> </div> |  | <div> <div>Rev.</div> <div>B</div> </div>                     |  |

Dusík 100 NL- 72003

izolácia ■ Foamglass - Hr. 140 mm

pozinkovaný plech - Hr. 0,8 mm

# AS BUILT

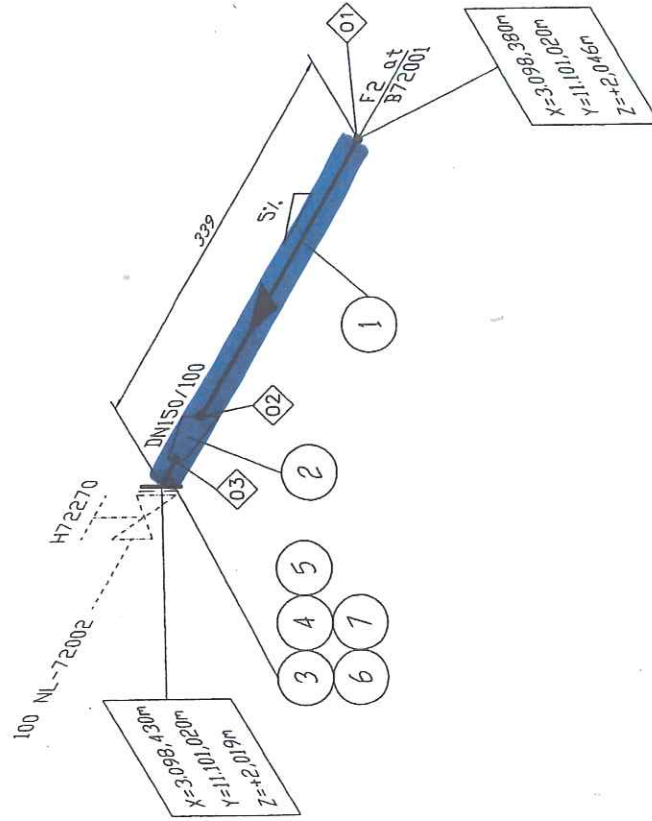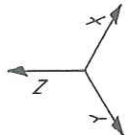

| Welding No. | DN  | Diameter | Welder No. | Protocol No. |
|-------------|-----|----------|------------|--------------|
| 01          | 150 | 168,3    |            |              |
| 02          | 150 | 168,3    |            |              |
| 03          | 100 | 114,3    |            |              |

*Rec. 0001 12/04*

### Remarks:

- Responsibility of the assembling company:
- Situation of mounting seams
  - Situation of pass-lengths
  - Check of measure details and pipe courses on the construction site
  - Situation of the spindle at valve

### Accompanying drawings:

- 100 NL-72002 ZB10C1C

### Accompanying lists:

- Parts list:  
150 NL-72002-ZB10C1C

### Pipe standard:

- AL Standard No.:  
50030 (ZB10C1)

|                      |                  |
|----------------------|------------------|
| <b>AIR LIQUIDE</b>   |                  |
| Air Liquide AGS GmbH |                  |
| Replaces: 79_        | Replaced by: 79_ |


|            |              |
|------------|--------------|
| Date:      | 25.10.2004   |
| Job code:  | K70101       |
| Reference: | ASU Kosice   |
| Title:     | 150 NL-72002 |

|          |           |         |                        |
|----------|-----------|---------|------------------------|
| Checked: | Hr. Gans  | Scale   | Original format        |
| Rev.     | Revisions | Date    | Sheet: 001 of 001      |
| 00.00.00 | 18.01.05  | Revised | Drawing No.: 792.87106 |
| 01       |           |         | Rev. A                 |

DUSÍK 150 NL - 72002

IZOLÁCIA ■ Foamglass Hr. izol. 150 mm  
pozink. plech - Hr. 0,8 mm

ASBUILT

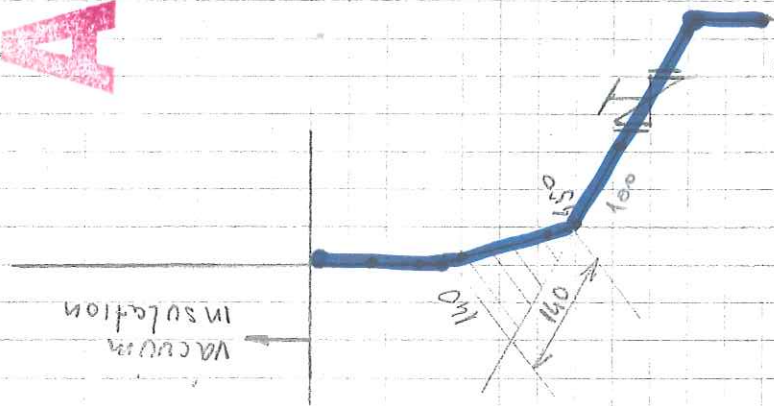

80 NL 73001

Sheet 04

Dasik 50 NL 73001

izolácia  Foamglass - (1. vrstva)  
hr. 70mm




pozink. plech - hr. 0,8mm

Druhá vrstva izolácie nebolo možné namontovať  
v požadovanej hĺbke projektu.

Trasa nespadá pod garanciu.

This drawing is protected by copyright.  
It may not be copied or used without our written  
authorization and it is strictly prohibited  
to disclose it to any third parties.

# AS BUILT

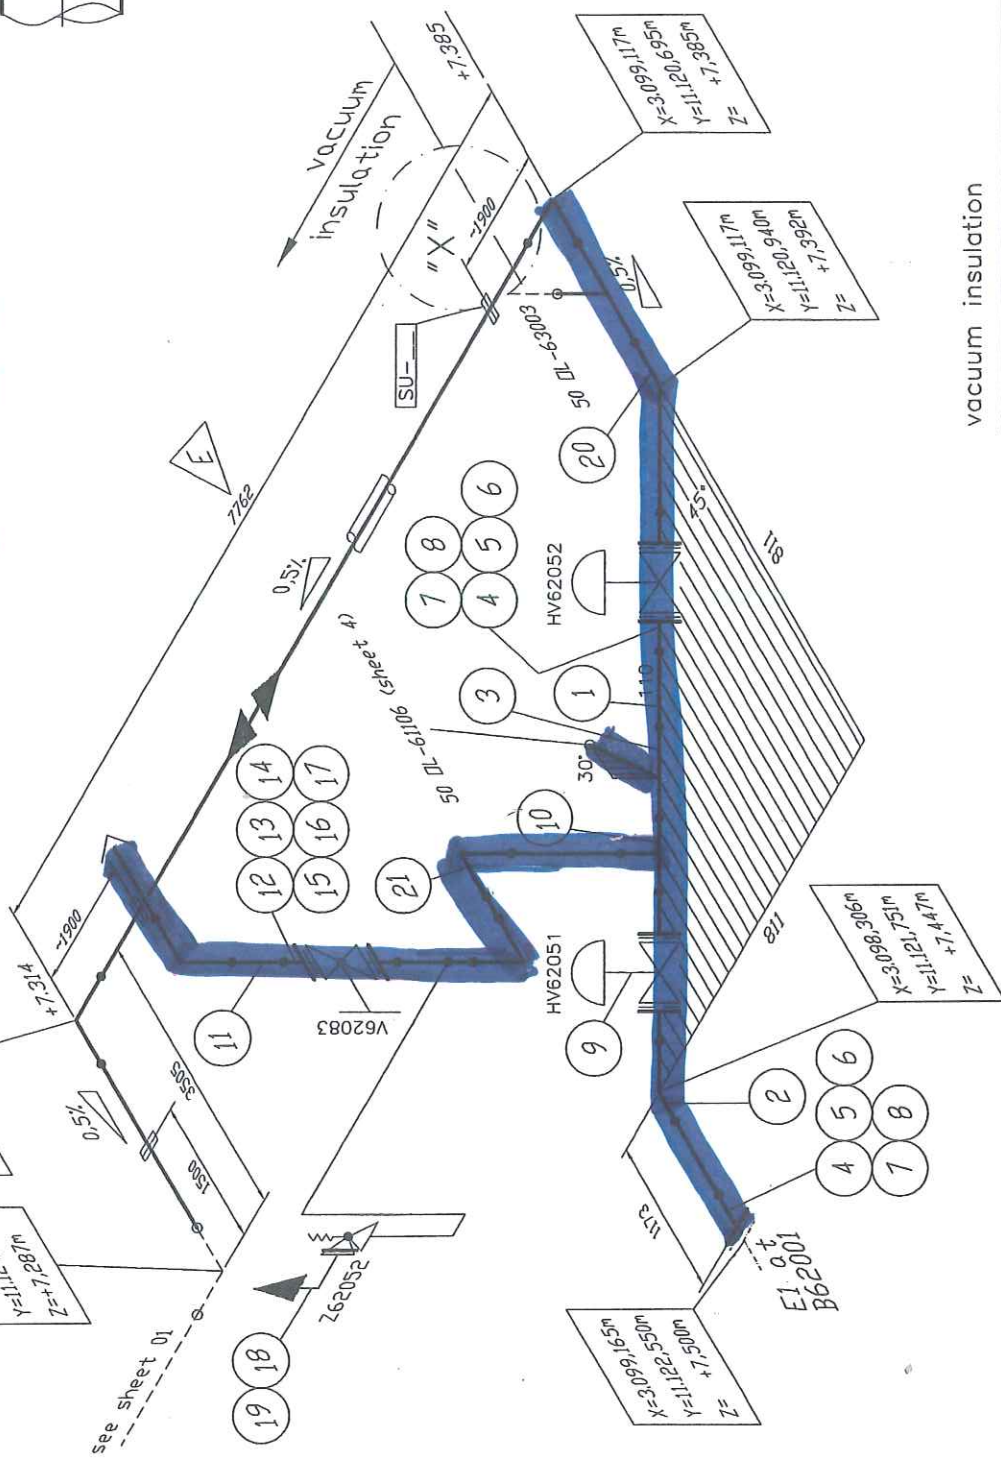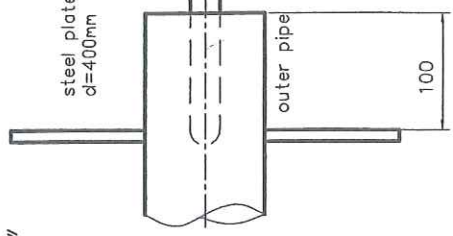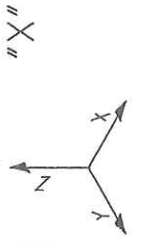

**Remarks:**  
Responsibility of the assembling company:  
- Situation of mounting seams  
- Situation of pass-lengths  
- Check of measure details and pipe courses on the construction site  
- Situation of the spindle at valve

**Accompanying drawings:**  
- 50 OL-61102 Sheet 01  
- 50 OL-63003  
- 50 OL-61106

**Accompanying lists:**  
- 50 OL-61102 ZB10C1

Pipe Length: 12m

|                      |  |                       |                  |                         |                            |
|----------------------|--|-----------------------|------------------|-------------------------|----------------------------|
| vacuum insulation    |  | Date : 16.02.2005     | Name : Reid./IES | Checked: Hr. Gans       | History file: 792------doc |
| <b>AIR LIQUIDE</b>   |  | Job code: K70101      | Scale: ---:---   | Original format: DIN A3 |                            |
| Air Liquide AGS GmbH |  | Reference: ASU Kosice | Sheet: 002       | of 002                  | Sheets                     |
| Replaces: 79-----    |  | Title:                | Drawing No.:     |                         | Rev.                       |
| Replaced by: 79----- |  |                       |                  |                         |                            |
| 50 OL-61102          |  |                       |                  |                         | 792.87106                  |
|                      |  |                       |                  |                         | E                          |



Ky slík

50 OL-61102

IZOLÁCIA ■ Foamglass - Hr. 110mm  
pozinkovaný plech Hr. - 0,8mm

AS BUILT

This drawing is protected by copyright.  
It may not be copied or used without our written  
authorization and it is strictly prohibited  
to disclose it to any third parties.

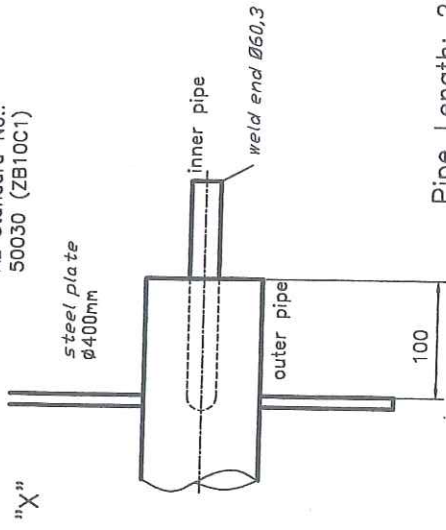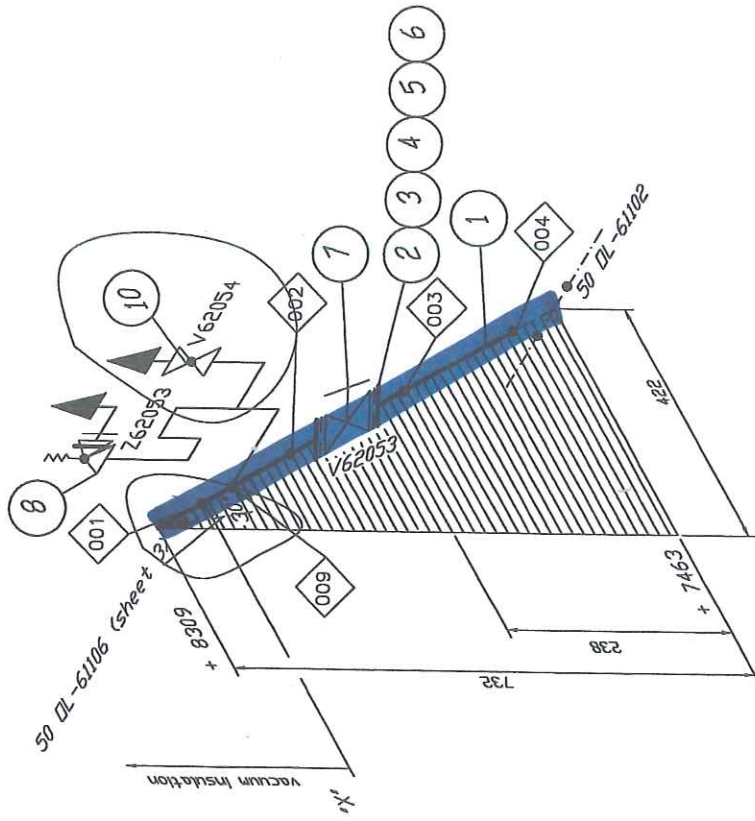

Pipe Length: 2m

vacuum insulation

|                      |  |                       |                              |                            |  |
|----------------------|--|-----------------------|------------------------------|----------------------------|--|
| <b>AIR LIQUIDE</b>   |  | Date : 01.04.05       | Name : WIP/Rad.              | History file: 79287106.doc |  |
| Air Liquide ACS GmbH |  | Job code: K70101      | Scale Original format DIN A3 |                            |  |
| Replaces: 79_        |  | Reference: ASU Kosice | Sheet: 004 of 004 Sheets     |                            |  |
| Replaced by: 79_     |  | Title: 50 OL-61106    | Drawing No.: 792.87106 B     |                            |  |

| Welding No. | DN | φ    | Welder No. | Protoc No. |
|-------------|----|------|------------|------------|
| 001         | 50 | 60,3 |            |            |
| 002         | 50 | 60,3 |            |            |
| 003         |    | 22   |            |            |
| 004         | 50 | 60,3 |            |            |
| 005         | 50 | 60,3 |            |            |

Remarks:

- Responsibility of the assembling company:
- Situation of mounting seams
- Situation of pass-lengths
- Check of measure details and pipe courses on the construction site
- Situation of the spindle at valve

Accompanying drawings:

- 50 OL-61106 Sheet 03

Accompanying lists:

- Parts list: 50 OL-61106 ZB10C1

Pipe standard:

- AL Standard No.: 50030 (ZB10C1)


Foam glass

Kyslík

50 OL-61 106

IZOLÁCIA  Foamglass - hr. 110 mm  
pozinkovaný plech - hr. 0,8 mm

AS BUILT

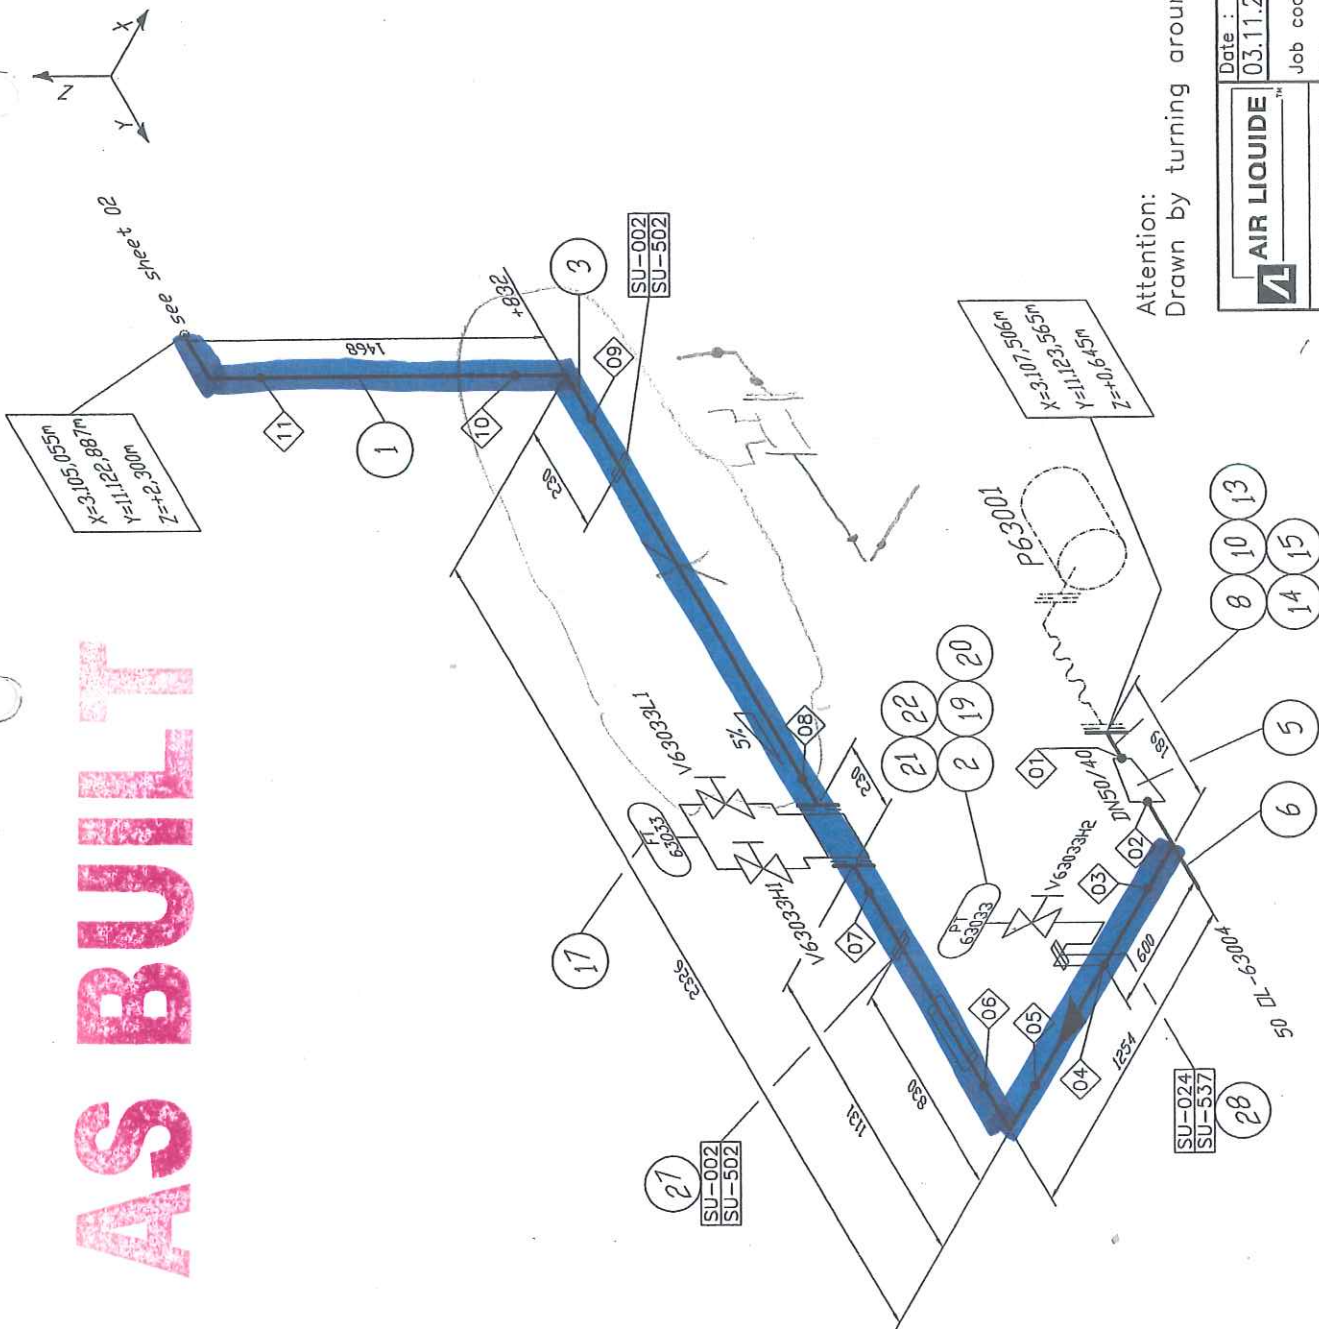

| Welding No. | DN | Diameter | Welder No. | Protocol No. |
|-------------|----|----------|------------|--------------|
| 01          | 40 | 48,3     |            |              |
| 02          | 50 | 60,3     |            |              |
| 03          | 50 | 60,3     |            |              |
| 04          | 50 | 60,3     |            |              |
| 05          | 50 | 60,3     |            |              |
| 06          | 50 | 60,3     |            |              |
| 07          | 50 | 60,3     |            |              |
| 08          | 50 | 60,3     |            |              |
| 09          | 50 | 60,3     |            |              |
| 10          | 50 | 60,3     |            |              |
| 11          | 50 | 60,3     |            |              |

Remarks:

- Responsibility of the assembling company:
- Situation of mounting seams
  - Situation of pass-lengths
  - Check of measure details and pipe courses on the construction site
  - Situation of the spindle at valve

Accompanying drawings:

- 50 OL-63003 ZB10C1C Blatt 02
- 50 OL-63004 ZB40C1C

Accompanying lists:

- 50 OL-63003 ZB10C1C


Pipe standard:

- AL Standard No.: 50030 (ZB10C1)

Attention:  
Drawn by turning around 45°

25.7

|                       |  |                        |                  |                         |                            |
|-----------------------|--|------------------------|------------------|-------------------------|----------------------------|
| AIR LIQUIDE           |  | Date : 03.11.2004      | Name : Reid./IES | Checked: Hr. Gons       | History file: 79287106.doc |
| Air Liquide AGS GmbH  |  | Job code: K70101       | Scale: ---       | Original format: DIN A3 |                            |
| Reference: ASU Kosice |  | Sheet: 001             | of 002           | Sheets                  | Rev.                       |
| Title: 50 OL-63003    |  | Drawing No.: 792.87106 |                  | C                       |                            |

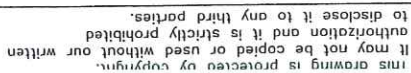

Remarks:

- Responsibility of the assembling company:
- Situation of mounting seams
- Situation of pass-lengths
- Check of measure details and pipe courses on the construction site
- Situation of the spindle at valve

Accompanying lists:  
- 50 OL-63003 ZB10C1C

Pipe standard:  
- AL Standard No.:  
50030 (ZB10C1)



**AIR LIQUIDE**<sup>TM</sup>

Job code: K70101

Reference: ASU Kosice

Title:

50 OL-63003

792.87106

Ky slika


50 OL - 63 003

IZOLÁCIA  Foamglass Hr. 110 mm  
pozinkovaný plech - Hr. 0,8 mm

# ASBUILT

$X=3101,954m$   
 $Y=11112,717m$   
 $Z=+4,750m$

$X=3101,684m$   
 $Y=11112,717m$   
 $Z=+4,750m$

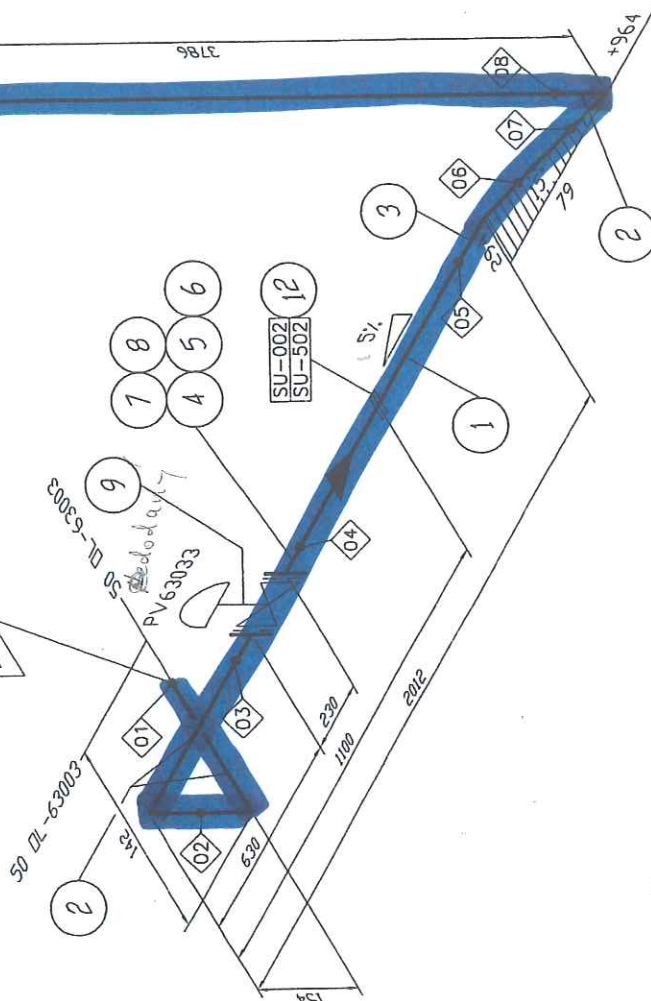

| Welding No. | DN | Diameter | Welder No. | Protocol No. |
|-------------|----|----------|------------|--------------|
| 01          | 50 | 60,3     | ---        | ---          |
| 02          | 50 | 60,3     | ---        | ---          |
| 03          | 50 | 60,3     | ---        | ---          |
| 04          | 50 | 60,3     | ---        | ---          |
| 05          | 50 | 60,3     | ---        | ---          |
| 06          | 50 | 60,3     | ---        | ---          |
| 07          | 50 | 60,3     | ---        | ---          |
| 08          | 50 | 60,3     | ---        | ---          |
| 09          | 50 | 60,3     | ---        | ---          |
| 10          | 50 | 60,3     | ---        | ---          |

Re. 09001/172

**Remarks:**  
 Responsibility of the assembling company:  
 - Situation of mounting seams  
 - Situation of pass-lengths  
 - Check of measure details and pipe courses on the construction site  
 - Situation of the spindle at valve

**Accompanying drawings:**  
 - 50 OL-63003 ZB10C1C

**Accompanying lists:**  
 - 50 OL-63004 ZB10C1C

**Pipe standard:**  
 - AL Standard No.: 50030 (ZB10C1)

**Attention:**  
 Drawn by turning around 45°

| Rev. | Revisions | Date     | Name  | provid |
|------|-----------|----------|-------|--------|
| ---  | ---       | ---      | ---   | ---    |
| -A   | ---       | 19.01.05 | Ry/ES | Gans   |


|                      |                  |                          |                       |                   |                            |
|----------------------|------------------|--------------------------|-----------------------|-------------------|----------------------------|
| <b>AIR LIQUIDE</b>   |                  | Date : 02.10.2004        | Name : Reid./IES      | Checked: Hr. Gans | History file: 79287106.doc |
| Air Liquide AGS GmbH |                  | Job code: K70101         | Reference: ASU Kosice | Scale: ---:---    | Original format: DIN A3    |
| Replaces: 79_        | Replaced by: 79_ | Sheet: 001 of 001 Sheets |                       |                   |                            |
| Title: 50 OL-63004   |                  | Drawing No.: 792.87106_A |                       |                   |                            |

Kyselík

50 OL - 63004

izolácia  Foamglass Hr. 110 mm  
pozinkovaný plech - hr. 98 mm

# ASBUILT

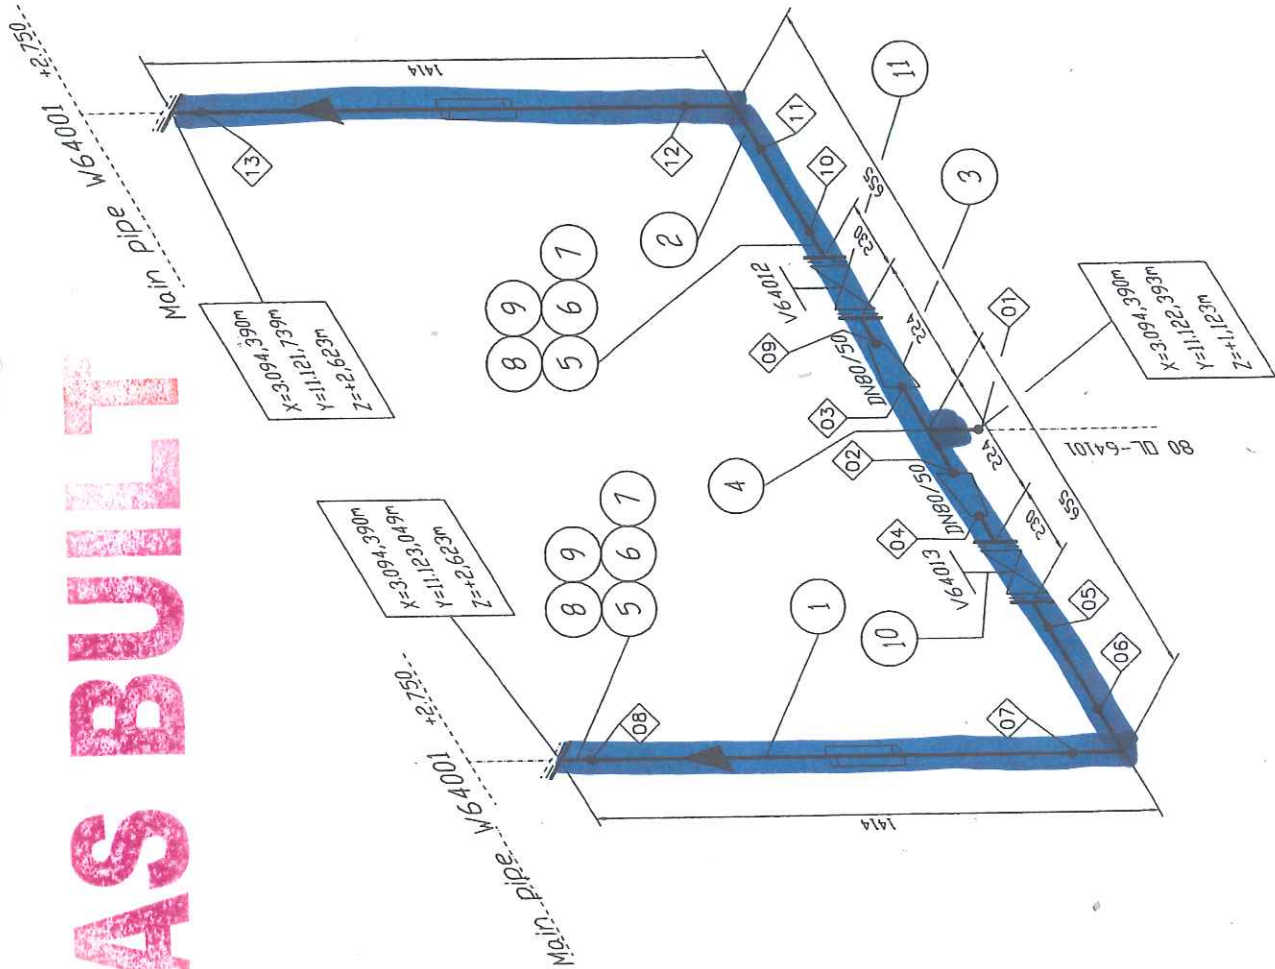

| Welding No. | DN | Diameter | Welder No. | Protocol No. |
|-------------|----|----------|------------|--------------|
| 01          | 80 | 88,9     |            |              |
| 02          | 80 | 88,9     |            |              |
| 03          | 80 | 88,9     |            |              |
| 04          | 50 | 60,3     |            |              |
| 05          | 50 | 60,3     |            |              |
| 06          | 50 | 60,3     |            |              |
| 07          | 50 | 60,3     |            |              |
| 08          | 50 | 60,3     |            |              |
| 09          | 50 | 60,3     |            |              |
| 10          | 50 | 60,3     |            |              |
| 11          | 50 | 60,3     |            |              |
| 12          | 50 | 60,3     |            |              |
| 13          | 50 | 60,3     |            |              |

*Re. operas 17-4*

## Remarks:

- Responsibility of the assembling company:
- Situation of mounting seams
  - Situation of pass-lengths
  - Check of measure details and pipe courses on the construction site
  - Situation of the spindle at valve

## Accompanying drawings:

- 80 OL-64101 ZB40C1

## Accompanying lists:

- 50 OL-64004 ZB40C1

## Pipe standard:

- AL Standard No.: 50006 (ZB40C1)


|                      |    |             |                 |               |              |
|----------------------|----|-------------|-----------------|---------------|--------------|
| <b>AIR LIQUIDE</b>   |    | Date :      | 08.11.2004      | Name :        | Reid./IES    |
| Air Liquide AGS GmbH |    | Job code:   | K70101          | Checked:      | Hr. Gans     |
| Reference:           |    | ASU Kosice  |                 | History file: | 79287106.doc |
| Replaces:            | 79 | Scale       | Original format | Rev./         | Revisions    |
| Replaced by:         | 79 | Sheet: 001  | DIN A3          | Date          | Name         |
| Title:               |    | 50 OL-64004 |                 | provid        | Gans         |
| Drawing No.:         |    | 792.87106   |                 |               |              |
| Rev.:                |    | A           |                 |               |              |

Kyslik


50 OL - 64004

IZOLÁCIA  Foamglass Hr. 120 mm  
pozinkovaný plech hr. 0,8 mm



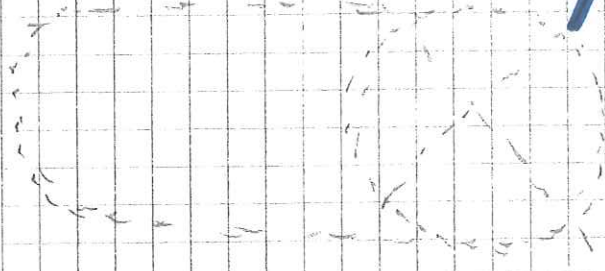

B73001

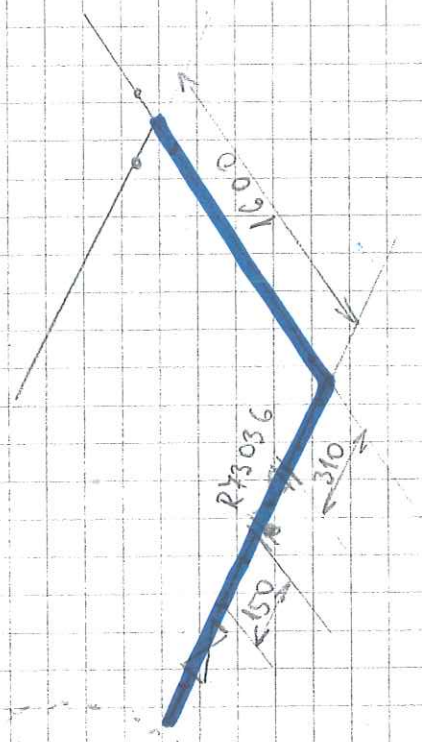


80 NL 73001

Sheet 2

Foamglas

sheet

1005708

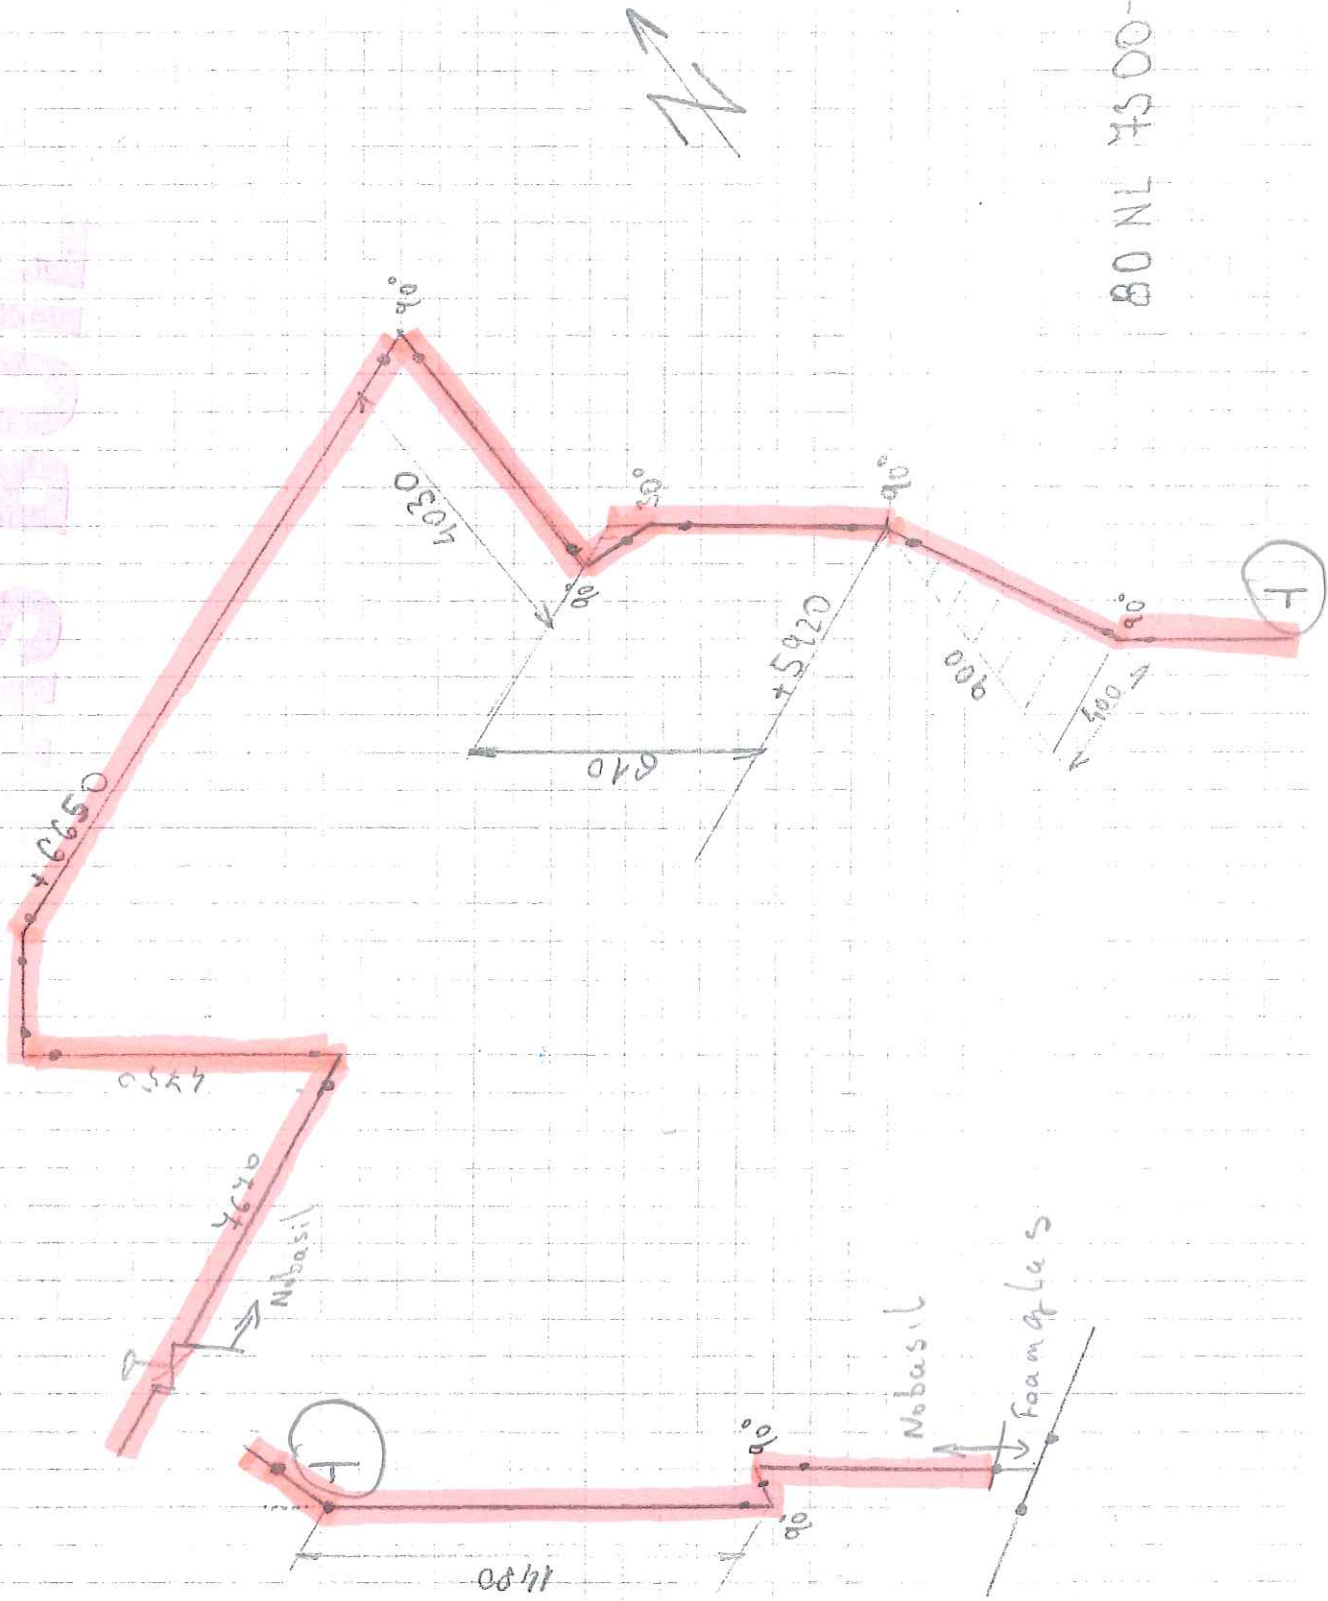

DUSÍK-80 NL 73 001

(1. vrstva)

izolácia  Foamglas - hr. 70 mm

pozink. plech - hr. 0,8 mm

Druhá vrstvu izolácie nebolo možné namontovať  
v požadovanej hrúbke projektu.

Trasa nespadá pod garanciu.


Sheet-2

Dusík - 80 NL 73 001

izolácia  Rockwool WM 105 ZINC HR - 80 mm

pozink. plech Hr. 0,8 mm

Sheet-1

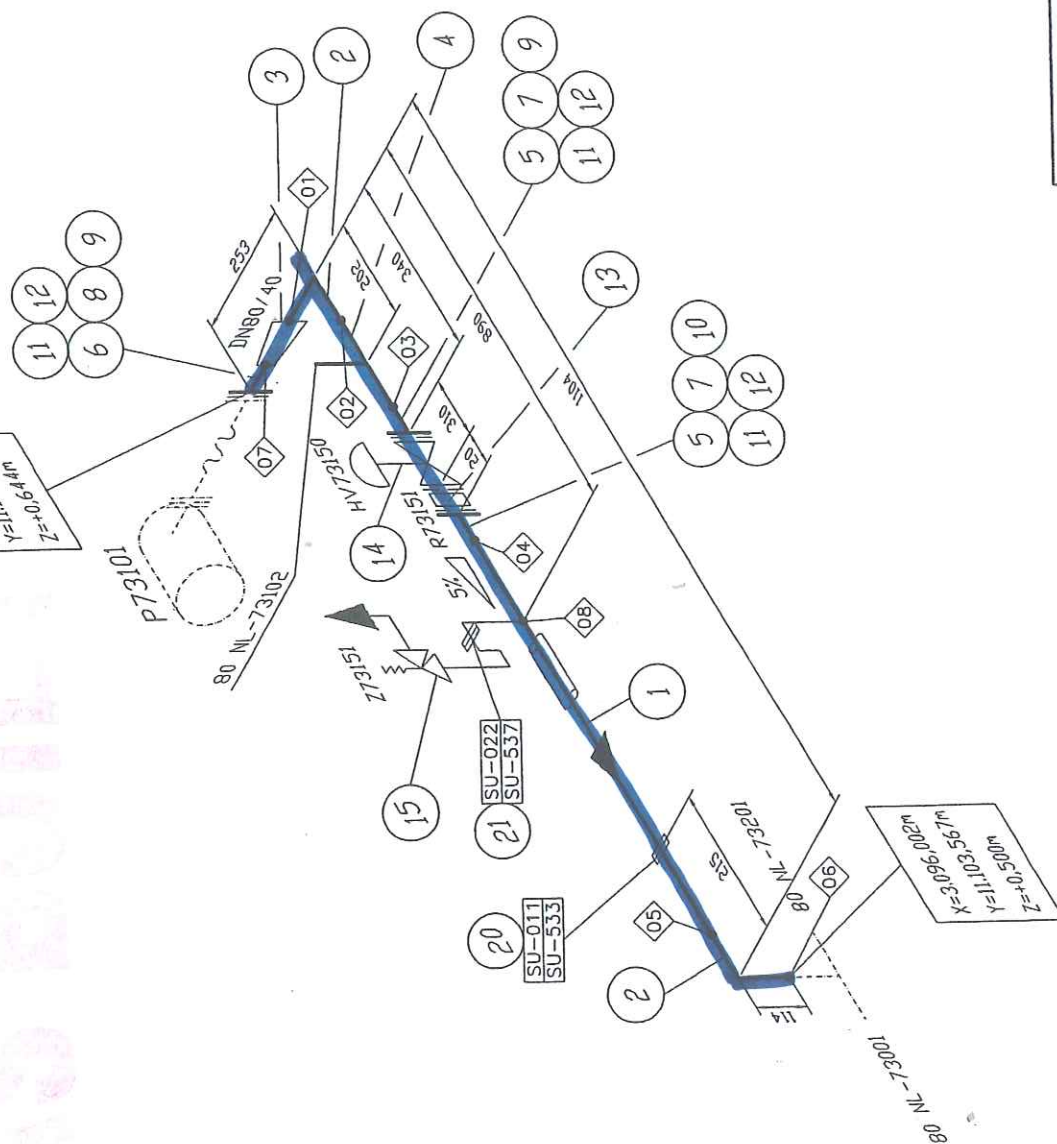

Re. 2000-7-1

Responsibility of the assembling company:

- Situation of mounting seams
- Situation of pass-lengths
- Check of measure details and pipe courses on the construction site
- Situation of the spindle at valve

80 NL-73201 ZB25C1C  
80 NL-73001 ZB25C1C  
80 NL-73102 ZB25C1C

Parts list:  
80 NL-73101 ZB25C1C

— AL Standard No.:  
50026 (ZB25C1)

History file:

Original format  
DIN A3

|      |      |
|------|------|
| No.: | Rev. |
|------|------|

10/1/01

|               |                 |
|---------------|-----------------|
| <b>Scale</b>  | Original format |
| <b>DIN A3</b> |                 |

|                      |              |      |
|----------------------|--------------|------|
| Reference:           | Since: 00    | Rev. |
| Air Liquide AGS GmbH | Drawing No.: |      |

Replaced by: 80 NL- / 3101 192.0 / 100 D


Dnsík 80 NL - 73 101

izol.  Foamglass hr. (1. vrstva)  
70 mm

pozink. plech - Hr. 0,8 mm

Drátní vrstvu izolácie nebolo možné namontovať  
v požadovanej hrúbke projektu.

Trasa nespadá pod garanciu.

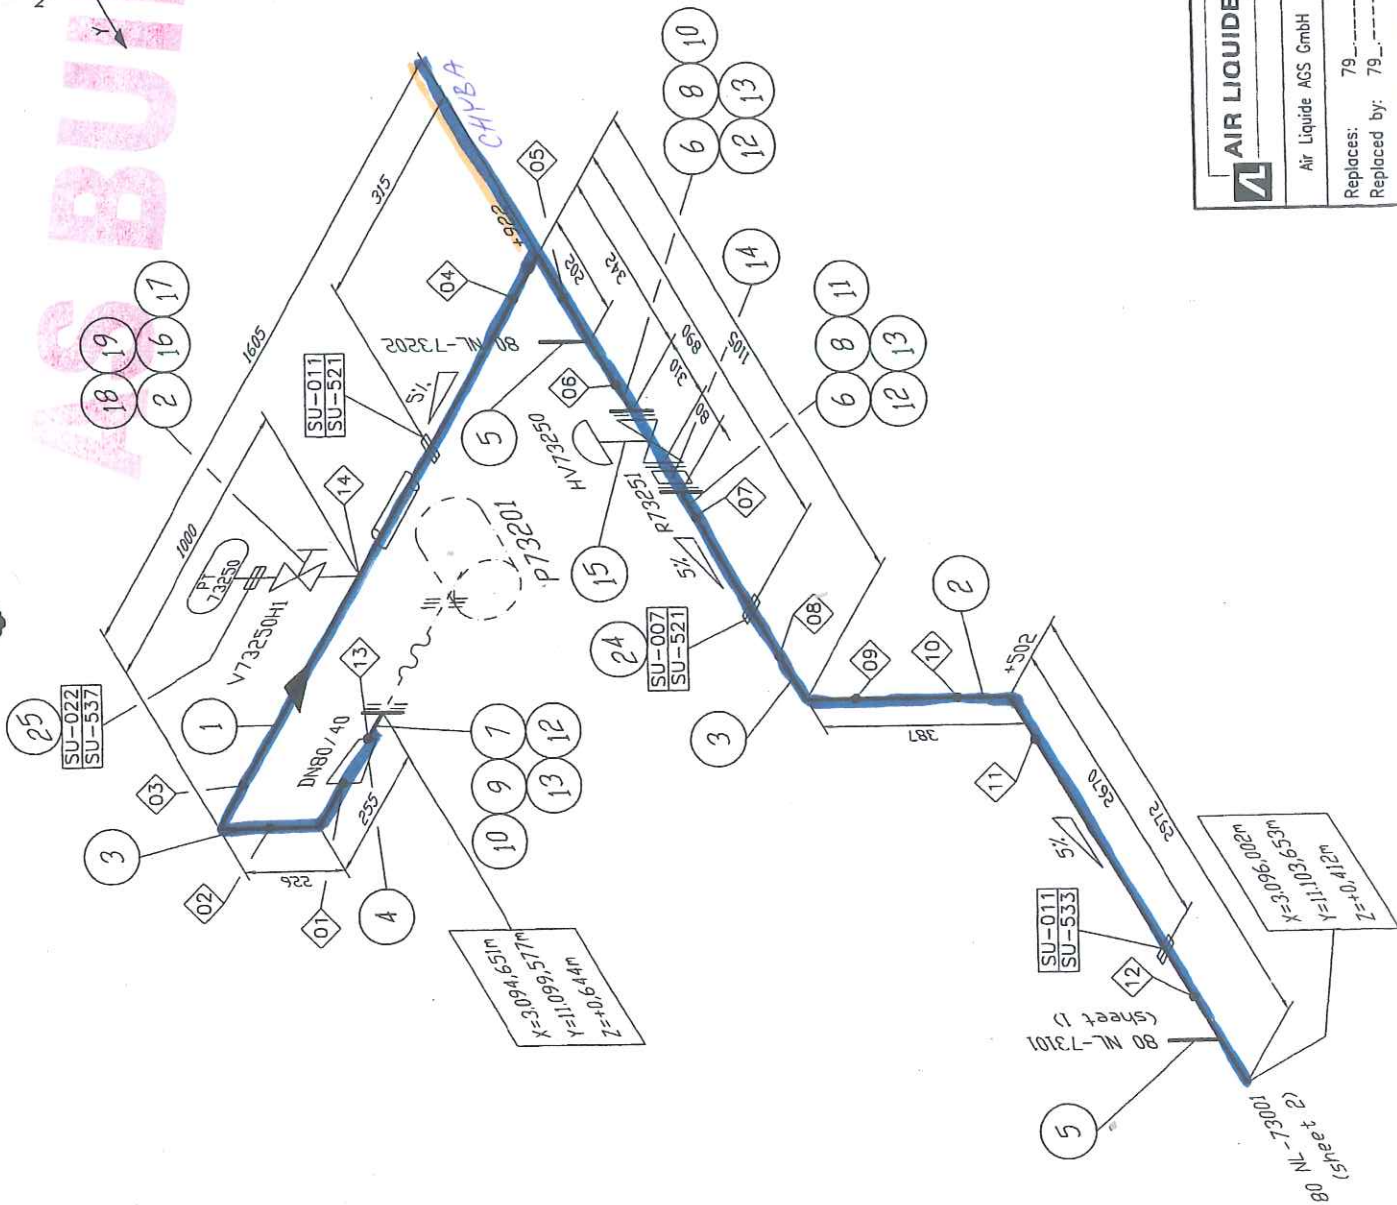

| Welding No. | DN | Diameter | Welder No. | Protocol No. |
|-------------|----|----------|------------|--------------|
| 01          | 80 | 88.9     |            |              |
| 02          | 80 | 88.9     |            |              |
| 03          | 80 | 88.9     |            |              |
| 04          | 80 | 88.9     |            |              |
| 05          | 80 | 88.9     |            |              |
| 06          | 80 | 88.9     |            |              |
| 07          | 80 | 88.9     |            |              |
| 08          | 80 | 88.9     |            |              |
| 09          | 80 | 88.9     |            |              |
| 10          | 80 | 88.9     |            |              |
| 11          | 80 | 88.9     |            |              |
| 12          | 80 | 88.9     |            |              |
| 13          | 40 | 48.3     |            |              |
| 14          |    | 21.3     |            |              |

*Rec. 09.05.2004*

#### Remarks:

Responsibility of the assembling company:

- Situation of mounting seams
- Situation of pass-lengths
- Check of measure details and pipe courses on the construction site
- Situation of the spindle at valve

#### Accompanying drawings:

- 80 NL-73202 ZB25C1C
- 80 NL-73101 ZB25C1C
- 80 NL-73001 ZB25C1C

#### Accompanying lists:

- Parts list:
- 80 NL-73201 ZB25C1C

|                       |  |                        |  |                         |  |                            |  |
|-----------------------|--|------------------------|--|-------------------------|--|----------------------------|--|
| Date: 25.10.2004      |  | Name: Reid./IES        |  | Checked: Hr. Gans       |  | History file: 79287106.doc |  |
| Job code: K70101      |  | Scale: ---:---         |  | Original format: DIN A3 |  | Sheet: 001 of 001          |  |
| Reference: ASU Kosice |  | Drawing No.: 792.87106 |  | Rev. B                  |  |                            |  |
| Replaces: 79_         |  | Replaced by: 79_       |  | Title: 80 NL-73201      |  |                            |  |
| Air Liquide ACS GmbH  |  | Job code: K70101       |  | Reference: ASU Kosice   |  | Drawing No.: 792.87106     |  |
| Replaces: 79_         |  | Replaced by: 79_       |  | Title: 80 NL-73201      |  |                            |  |

Dusík 80 NL-73 201

izolácia — Foamglass

(1. vrstva)



hr. 70 mm

pozinkovaný plech — hr. 0,8 mm

Druhá vrstvu nebolo možné namontovať  
v požadovanej hrúbke

Trasa nespadá pod garanciu

# AS BUILT

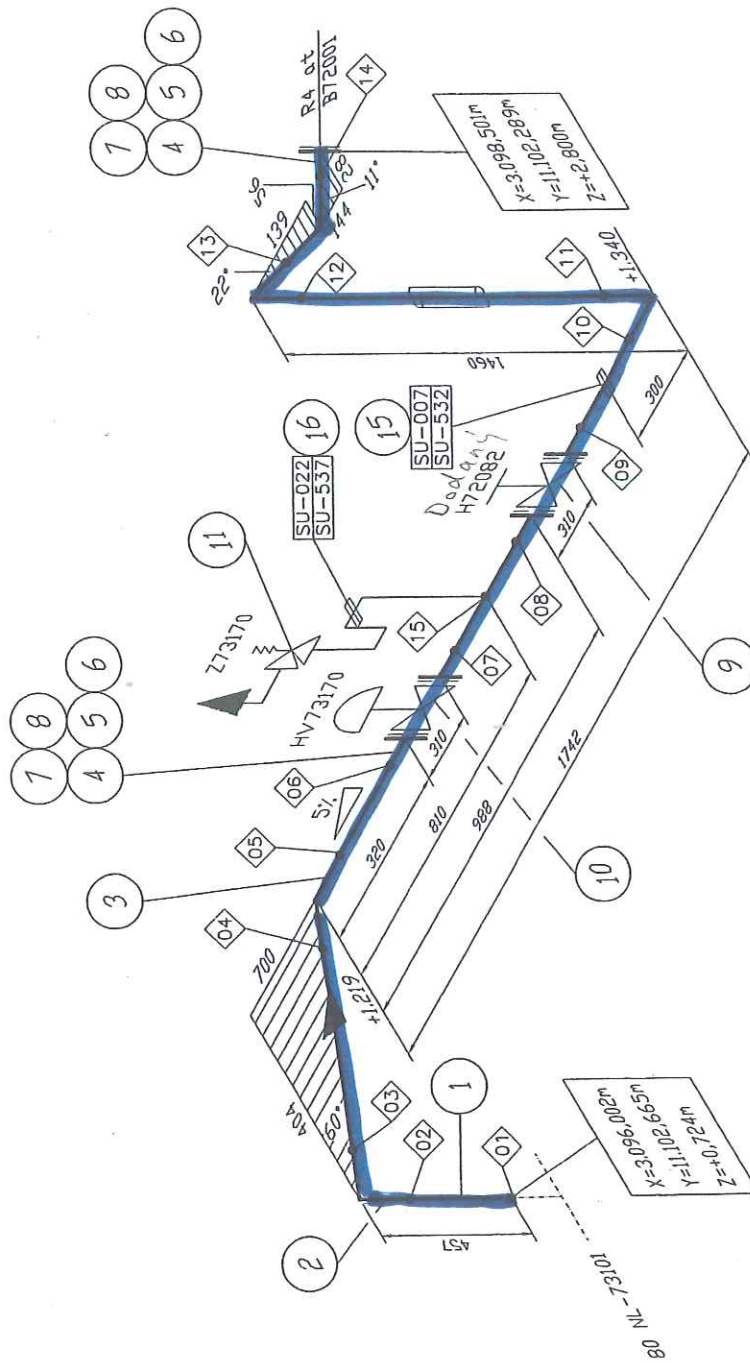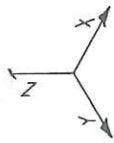

| Welding No. | DN | Diameter | Welder No. | Protocol No. |
|-------------|----|----------|------------|--------------|
| 01          | 80 | 88,9     | ---        | ---          |
| 02          | 80 | 88,9     | ---        | ---          |
## Remarks:

Responsibility of the assembling company:

- Situation of mounting seams
- Situation of pass-lengths
- Check of measure details and pipe courses on the construction site
- Situation of the spindle at valve

## Accompanying drawings:

- 80 NL-73101 ZB25C1C

## Accompanying lists:

- Parts list:
- 80 NL-73102 ZB25C1C

## Pipe standard:

- AL Standard No.: 50026 (ZB25C1)

|                       |  |                    |  |                         |  |                            |  |
|-----------------------|--|--------------------|--|-------------------------|--|----------------------------|--|
| Date: 27.10.2004      |  | Name: Reid./IES    |  | Checked: Hr. Gans       |  | History file: 79287106.doc |  |
| Job code: K70101      |  | Scale: --:--       |  | Original format: DIN A3 |  |                            |  |
| Reference: ASU Kosice |  | Sheet: 001         |  | of 001                  |  | Sheets                     |  |
| Replaces: 79          |  | Title: 80 NL-73102 |  | Drawing No.: 792.87106  |  | Rev. B                     |  |
| Replaced by: 79       |  |                    |  |                         |  |                            |  |

|      |               |          |       |        |
|------|---------------|----------|-------|--------|
| B    | diff. Changes | 15.04.05 | Rb/ES | Gans   |
| A    | diff. Changes | 18.01.05 | Rb/ES | Gans   |
| Rev. | Revisions     | Date     | Name  | proved |

Dusík - 80NL 73 102

izolácia  Foamglass

(1. vrstva)

hr. 70 mm



pozinkovaný plech - Hr. 0,8 mm

Druhá vrstvu nebolo možné namontovať  
v požadovanej hrúbke projektu.

Trasa nespadá pod garanciu

This drawing is protected by copyright. It may not be copied or used without our written authorization and it is strictly prohibited to disclose it to any third parties.

ASBUL

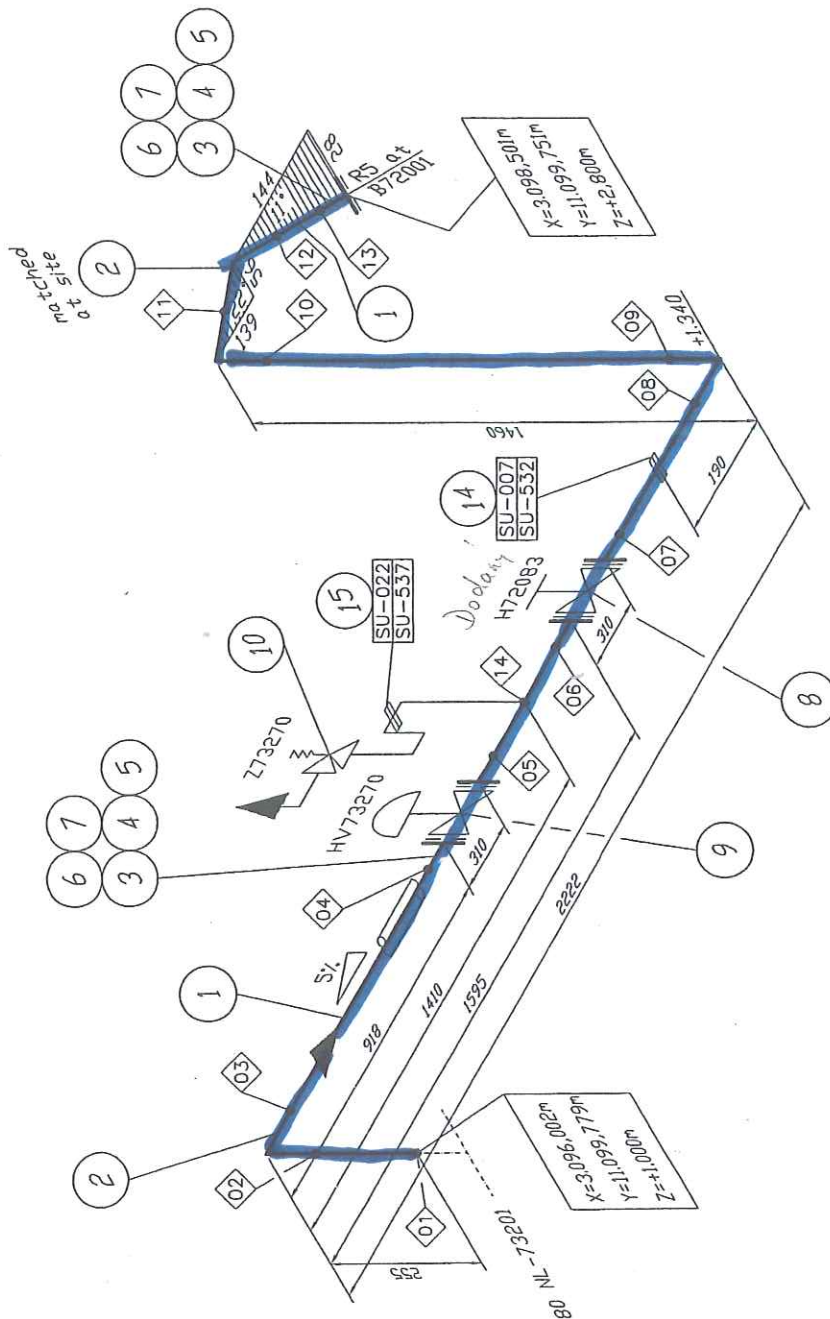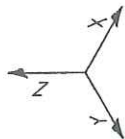

| Welding No. | DN | Diameter | Welder No. | Protocol No. |
|-------------|----|----------|------------|--------------|
| 01          | 80 | 88,9     | ---        | ---          |
| 02          | 80 | 88,9     | ---        | ---          |
| 14          | 22 | 22       | ---        | ---          |

*Rec. 090087764*

#### Remarks:

- Responsibility of the assembling company:
- Situation of mounting seams
  - Situation of pass-lengths
  - Check of measure details and pipe courses on the construction site
  - Situation of the spindle of valve

#### Accompanying drawings:

- 80 NL-73201 ZB25C1C

#### Accompanying lists:

- Parts list: 80 NL-73202 ZB25C1C

#### Pipe standard:

- AL Standard No.: 50026 (ZB25C1)

| Rev. | Revisions     | Date     | Name  | History file: |
|------|---------------|----------|-------|---------------|
| B    | diff. Changes | 16.04.05 | Rb/ES | Gans          |
| A    | diff. Changes | 18.01.05 | Rb/ES | Gans          |
|      |               |          |       | proved        |

|                      |  |                       |  |                        |  |                            |  |
|----------------------|--|-----------------------|--|------------------------|--|----------------------------|--|
| Date : 27.10.2004    |  | Name : Reid./IES      |  | Checked: Hr. Gans      |  | History file: 79287106.doc |  |
| Job code: K70101     |  | Reference: ASU Kosice |  | Scale: ---:---         |  | Original format: DIN A3    |  |
| Air Liquide AGS GmbH |  | Title: 80 NL-73202    |  | Sheet: 001 of 001      |  | Sheets: Rev.               |  |
| Replaces: 79_        |  | Replaced by: 79_      |  | Drawing No.: 792.87106 |  | B                          |  |

80 Dusík NL-73202

|      |             |
|------|-------------|
| 70mm | - 1. vrstva |
| 50mm | - 2. vrstva |


izolácia — Foamglass hrúbka 70mm

pozink. plech — HR. 0,8 mm

Druhá vrstvu nebolo možné namontovať  
v projektovej hrúbke.

Trasa nespadá pod garanciu.

AS BUILT

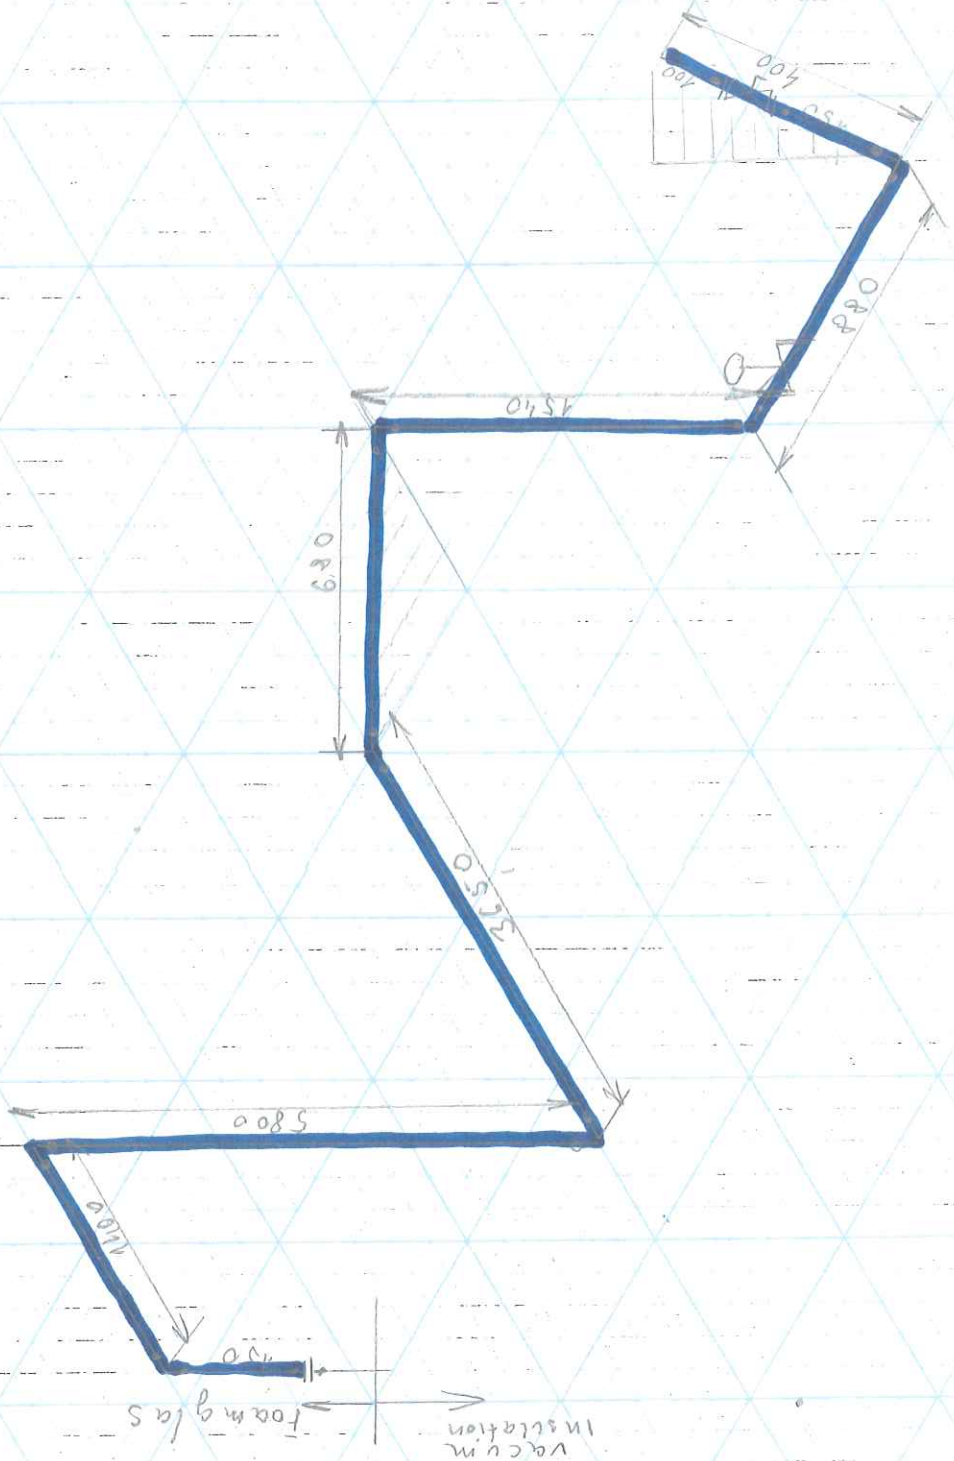


40NL 43005

Dusík - 40 NL 73005

izol. Foamglass  Hr. 120 mm (70+50)

pozink. plech - Hr. 0,8 mm

Práca naviac

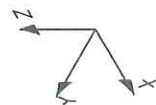

Re. opat 14 21

|      |           |          |          |        |
|------|-----------|----------|----------|--------|
| B    | -----     | 13.04.05 | WIP/Rad. | -----  |
| A    | -----     | 17.12.04 | WIP/Rad. | -----  |
| Rev. | Revisions | Date     | Name     | proved |

Checked: \_\_\_\_\_ History file: \_\_\_\_\_

- Responsibility of the assembling company:
- Situation of mounting seams
- Situation of pass-lengths
- Check of measure details and pipe courses on the construction site
- Situation of the spindle at valve

— 80 NL-73003

— Parts list:  
25 NL-730

- AL Standard No.:  
50026 / ZB25C1

|            |             |                |                           |
|------------|-------------|----------------|---------------------------|
| Date :     | Name :      | Checked:       | History file:             |
| 29.10.2004 | WIP/Rad.    | —              | 79287106.doc              |
| Job code:  | K70101      | Scale<br>—:—:— | Original format<br>DIN A3 |
| Reference: | ASU Kosice  | Sheet: 001     | of 001 Sheets             |
| Title:     | 25 NL 73005 | Drawing No.:   | Rev.                      |
|            |             | 792.87106      | B                         |


25 NL 73005

Izolácia - Foamglas hrúbka 120 mm

Plech pozinkovaný - Hr. 0.8 mm

This drawing is protected by copyright.  
It may not be copied or used without our written  
authorization and it is strictly prohibited  
to disclose it to any third parties.

**AS BUILT**

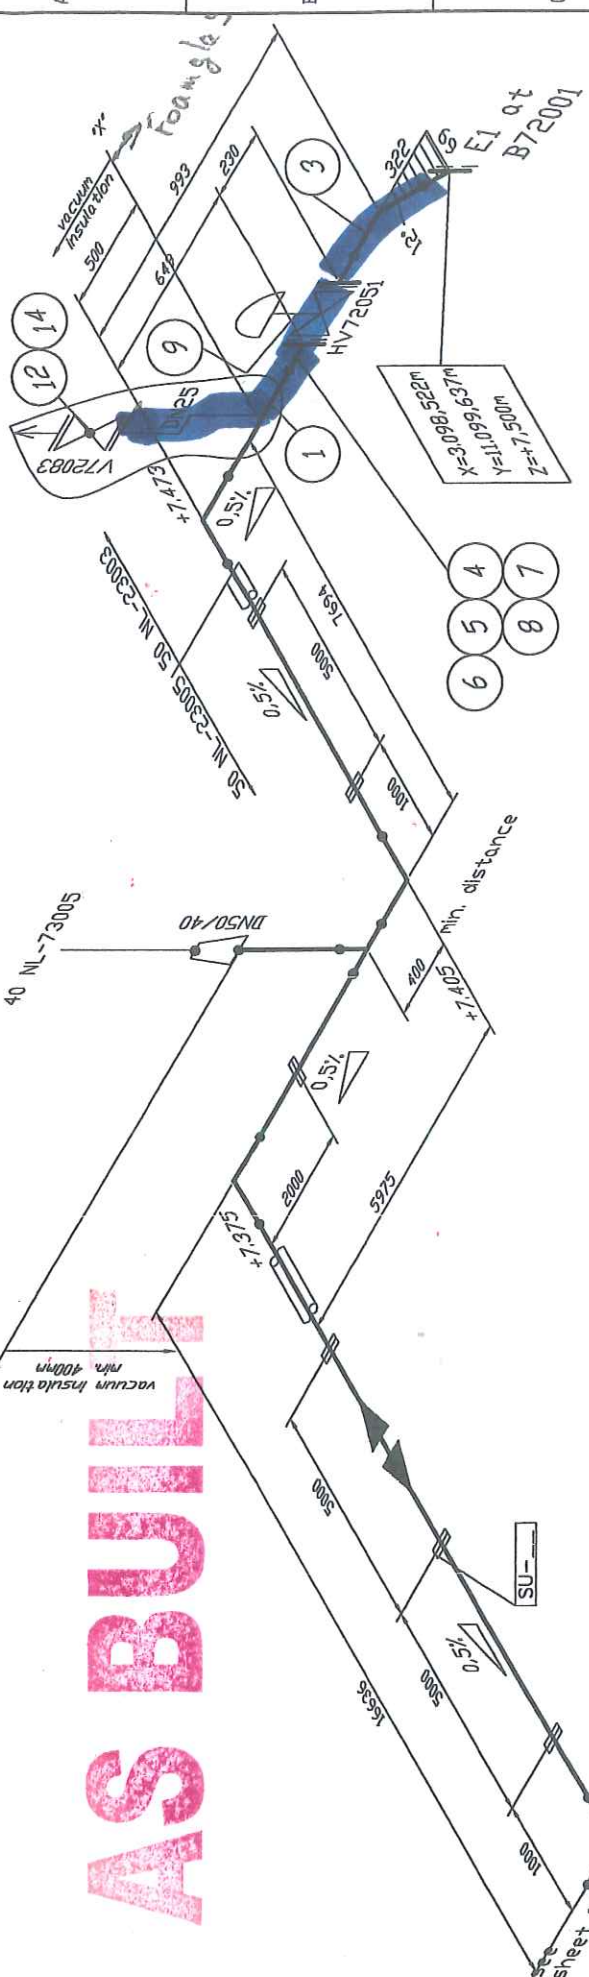

**Remarks:**


- Responsibility of the assembling company:
- Situation of mounting seams
  - Situation of pass-lengths
  - Check of measure details and pipe courses on the construction site
  - Situation of the spindle at valve

**Accompanying drawings:**

- 50 NL-23005 Sheet 01

**Accompanying lists:**

- 50 NL-23005 ZB16C1CV

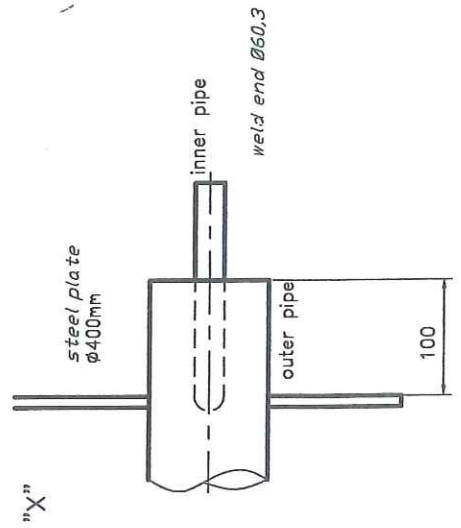

Pipe Length: 31m

vacuum insulation

|                   |  |                        |  |                   |  |                             |  |
|-------------------|--|------------------------|--|-------------------|--|-----------------------------|--|
| Date : 17.02.2005 |  | Name : Reid./IES       |  | Checked: Hr. Gans |  | History file: 792------,doc |  |
| Job code: K70101  |  | Reference: ASU Kosice  |  | Scale: ---:---    |  | Original format: DIN A3     |  |
| Replaces: 79_     |  | Title: 50 NL-23005     |  | Sheet: 002        |  | of 002 Sheets               |  |
| Replaced by: 79_  |  | Drawing No.: 792.87106 |  | Rev.:             |  | C                           |  |

50 NL 23005

Izolácia - Foamglas hrúbka 120 mm

Plech pozinkovaný - Hr. 0,8 mm.

# AS BUILT

## Remarks:

- Responsibility of the assembling company:
- Situation of mounting seams
  - Situation of pass-lengths
  - Check of measure details and pipe courses on the construction site
  - Situation of the spindle at valve



## Accompanying drawings:

- 50 NL-73001

## Accompanying lists:

- Parts list:

*Rev. 000000 1/1 6/9*

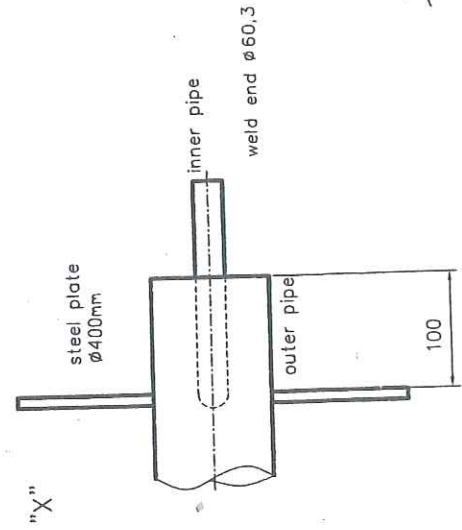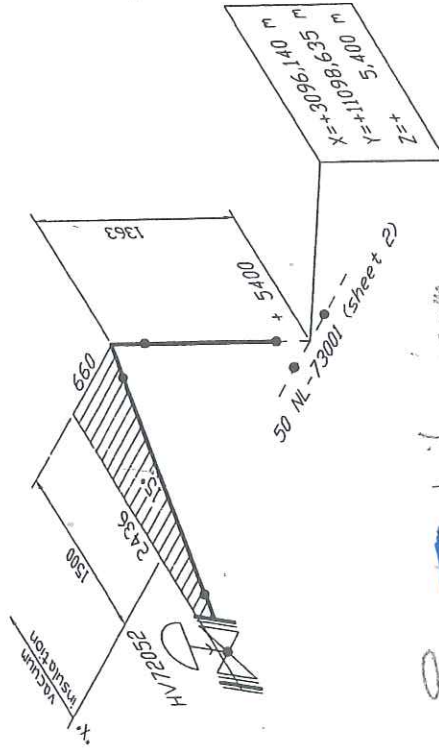

Pipe Length: 3m

vacuum insulated

|                      |  |                       |  |                        |  |                            |  |
|----------------------|--|-----------------------|--|------------------------|--|----------------------------|--|
| Date : 06.04.05      |  | Name : WIP/Rad.       |  | Checked: -             |  | History file: 79287106.doc |  |
| Job code: K70101     |  | Reference: ASU Kosice |  | Scale: --:--           |  | Original format: DIN A3    |  |
| Air Liquide ACS GmbH |  | Title: 50 NL 72003    |  | Sheet: 001 of 001      |  | Sheets: Rev. --            |  |
| Replaces: 79         |  | Replaced by: 79       |  | Drawing No.: 792.87106 |  | Rev. --                    |  |

50 NL 72003

Izolácia ■ Foamglas - hr. 120 mm

Pozinkovaný plech - hr. 0,8 mm.

Tank Farm - izolácia Rockwool rohože WM 105, pz plech

Tank Farm - insulation by Rockwool WM 105, hot deep galvanised plate

| Vetva / pipe line | Typ izolácie / type of insulation | Hr. mm / thickness | Plech / plate | Hr. mm / thickness mm | Poznámka / REMARK |
|-------------------|-----------------------------------|--------------------|---------------|-----------------------|-------------------|
| 150 OL-62001      | rockwool                          | 100                | pz/ HDG       | 0,8                   |                   |
| 100 OL-62001      | rockwool                          | 100                | pz/ HDG       | 0,8                   |                   |
| 150 OL-62002      | rockwool                          | 100                | pz/ HDG       | 0,8                   |                   |
| 100 OL-62002      | rockwool                          | 100                | pz/ HDG       | 0,8                   |                   |
| 80 OL-62002       | rockwool                          | 100                | pz/ HDG       | 0,8                   |                   |
| 80 OL-62003       | rockwool                          | 80                 | pz/ HDG       | 0,8                   |                   |
| 50 OL-62004       | rockwool                          | 80                 | pz/ HDG       | 0,8                   |                   |
| 100 OL-62005      | rockwool                          | 100                | pz/ HDG       | 0,8                   |                   |
| 25 OL-64002       | rockwool                          | 60                 | pz/ HDG       | 0,8                   |                   |
| 80 OL-64101       | rockwool                          | 100                | pz/ HDG       | 0,8                   |                   |
| 80 OL-64102       | rockwool                          | 100                | pz/ HDG       | 0,8                   |                   |
| 0 OL-64201        | rockwool                          | 100                | pz/ HDG       | 0,8                   |                   |
| 80 OL - 64202     | rockwool                          | 100                | pz/ HDG       | 0,8                   |                   |
| 150 NL-72001      | rockwool                          | 100                | pz/ HDG       | 0,8                   |                   |
| 80 NL - 72001     | rockwool                          | 100                | pz/ HDG       | 0,8                   |                   |
| 80 NL-72004       | rockwool                          | 100                | pz/ HDG       | 0,8                   |                   |
| 100 NL-72101      | rockwool                          | 100                | pz/ HDG       | 0,8                   |                   |
| 80 NL-72102       | rockwool                          | 80                 | pz/ HDG       | 0,8                   |                   |
| 50 N-72103        | rockwool                          | 80                 | pz/ HDG       | 0,8                   |                   |
| 80 NL-73001       | rockwool                          | 80                 | pz/ HDG       | 0,8                   |                   |
| 80 NL-73003       | rockwool                          | 100                | pz/ HDG       | 0,8                   |                   |
| 50 NL-73007       | rockwool                          | 80                 | pz/ HDG       | 0,8                   |                   |
| 25 NL-73008       | rockwool                          | 60                 | pz/ HDG       | 0,8                   |                   |
| 100 NL-74090      | rockwool                          | 80                 | pz/ HDG       | 0,8                   |                   |
| 50 NL-74101       | rockwool                          | 80                 | pz/ HDG       | 0,8                   |                   |
| 50 NL-74102       | rockwool                          | 80                 | pz/ HDG       | 0,8                   |                   |
| 50 NL-74201       | rockwool                          | 80                 | pz/ HDG       | 0,8                   |                   |
| 50 NL-74202       | rockwool                          | 80                 | pz/ HDG       | 0,8                   |                   |
|                   |                                   |                    |               |                       |                   |
|                   |                                   |                    |               |                       |                   |



Kyslik

150 OL - 62 001

IZOLÁCIA - Rockwool WM 105 ZINC Hr: 100mm  
pozinkovaný plech - Hr. 0,8mm

Trasa nie je v zozname - (práca naviac)

# AS BUILT

*Rec. 09.08.2004*

| Welding No. | DN  | Diameter | Welder No. | Protocol No. |
|-------------|-----|----------|------------|--------------|
| 01          | 100 | 114,3    |            |              |
| 02          | 100 | 114,3    |            |              |
| 03          | 100 | 114,3    |            |              |
| 04          | 100 | 114,3    |            |              |
| 05          | 100 | 114,3    |            |              |
| 06          | 100 | 114,3    |            |              |
| 07          | 100 | 114,3    |            |              |
| 08          | 100 | 114,3    |            |              |
| 09          | 100 | 114,3    |            |              |
| 10          | 65  | 76,1     |            |              |
| 11          |     | 24       | 48         |              |
| 12          |     | 33       | 48         |              |

## Remarks:

- Responsibility of the assembling company:
- Situation of mounting seams
  - Situation of pass-lengths
  - Check of measure details and pipe courses on the construction site
  - Situation of the spindle at valve

## Accompanying drawings:


- 150 OL-62001 ZB10C1C
- 100 OL-62005 ZB10C1C

## Accompanying lists:

- Parts list:
- 100 OL-62001-ZB10C1C

## Pipe standard:

- AL Standard No.: 50030 (ZB10C1)

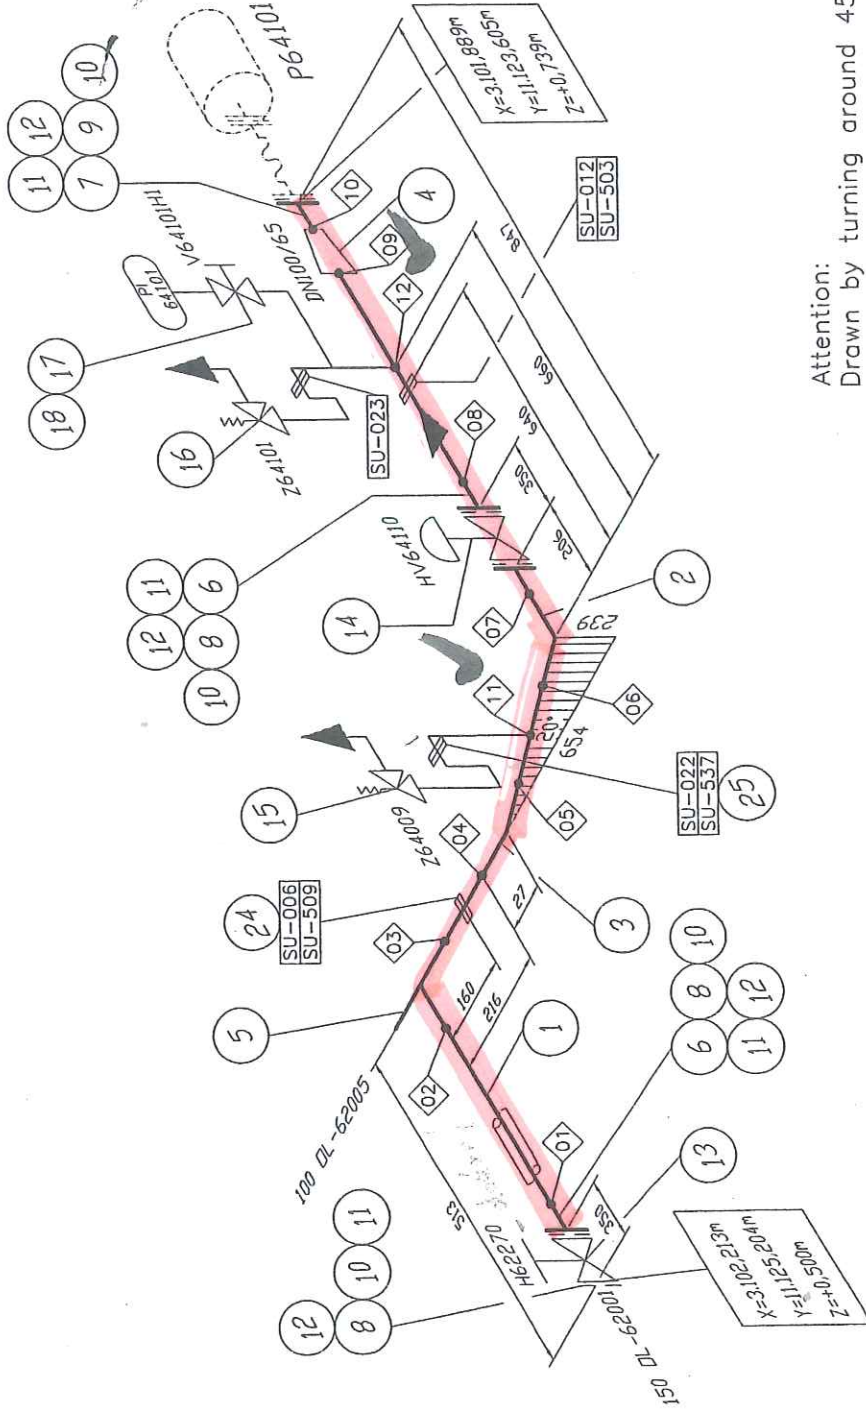


Attention:  
Drawn by turning around 45°

|                     |  |                        |  |                        |  |                            |  |
|---------------------|--|------------------------|--|------------------------|--|----------------------------|--|
| Date: 27.10.2004    |  | Name: Reid./IES        |  | Checked: Hr. Gans      |  | History file: 79287106.doc |  |
| Job code: K70101    |  | Reference: ASU Kosice  |  | Scale: Original format |  | DIN A3                     |  |
| Replaces: 79        |  | Replaced by: 79        |  | Sheet: 001             |  | of 001 Sheets              |  |
| Title: 100 OL-62001 |  | Drawing No.: 792.87106 |  | Rev. B                 |  |                            |  |

Kyslík

100 OL - 62 001

IZOLÁCIA  Rockwool WM 105 ZINC Hr. 100mm  
pozinkovaný plech - Hr. 0,8mm

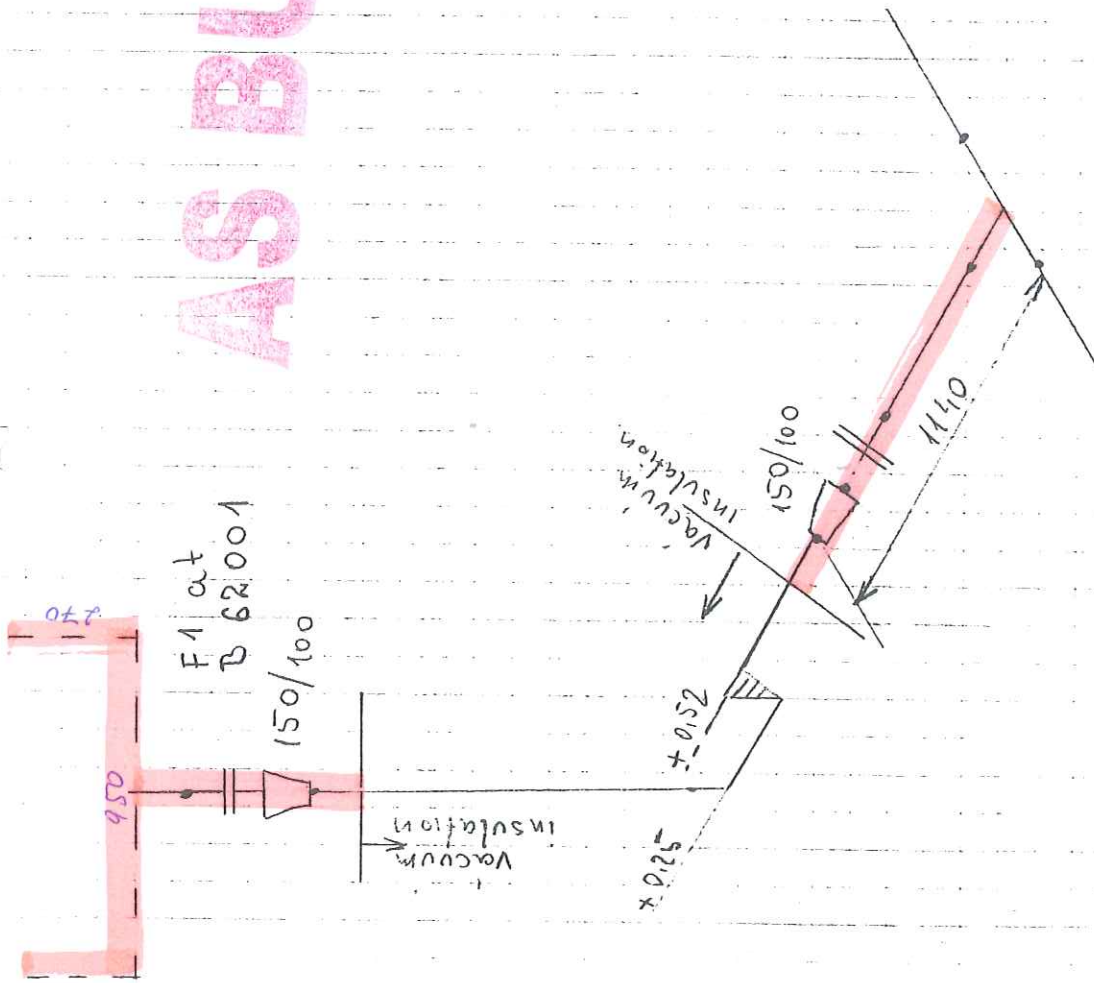

150 OL-62002

Kyslík

150 OL-62 002

IZOLÁCIA - Rockwool WM 105 ZINC hr. 100 mm  
pozinkovaný plech - Hr. 0,8 mm

Trasa nie je v zozname - (práca navyše)

**AS BUILT**

*Rec. 090001 24-4*

| Welding<br>No. | DN  | Diameter | Welder<br>No. | Protocol<br>No. |
|----------------|-----|----------|---------------|-----------------|
| 01             | 150 | 168,3    |               |                 |
| 02             | 100 | 114,3    |               |                 |
| 03             | 100 | 114,3    |               |                 |
| 04             | 100 | 114,3    |               |                 |
| 05             | 100 | 114,3    |               |                 |
| 06             | 100 | 114,3    |               |                 |
| 07             | 100 | 114,3    |               |                 |
| 08             |     | 33       | 02            |                 |

### Remarks:

Responsibility of the assembling company:

- Situation of mounting seams
- Situation of pass-lengths
- Check of measure details and pipe courses on the construction site
- Situation of the spindle at valve

### Accompanying drawings:


- 150 OL-62002 ZB10C1C
- 80 OL-62002 ZB10C1C

### Accompanying lists:

- 100 OL-62002 ZB10C1C

### Pipe standard:

- AL Standard No.: 50030 (ZB10C1)

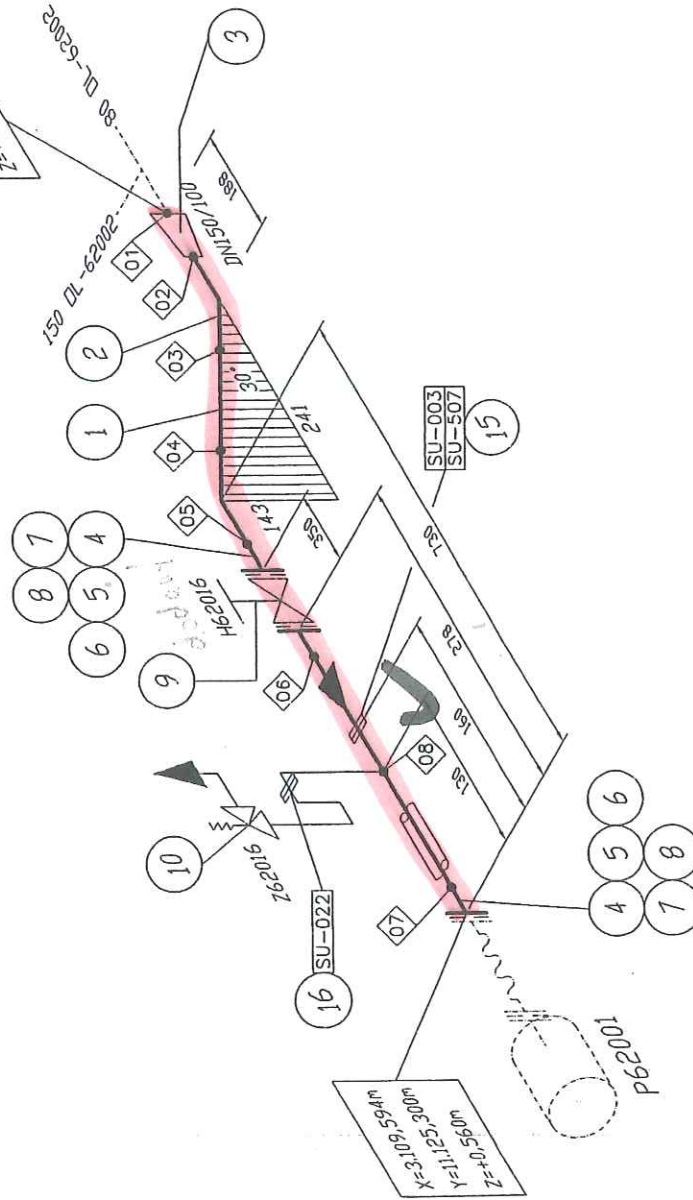

Attention:  
Drawn by turning around 45°

|                     |  |                        |  |                   |  |                            |  |
|---------------------|--|------------------------|--|-------------------|--|----------------------------|--|
| Date: 27.10.2004    |  | Name: Reid./IES        |  | Checked: Hr. Gans |  | History file: 79287106.doc |  |
| Job code: K70101    |  | Reference: ASU Kosice  |  | Scale: ---        |  | Original format: DIN A3    |  |
| Replaces: 79_       |  | Replaced by: 79_       |  | Sheet: 001 of 001 |  | Sheets: Rev.               |  |
| Title: 100 OL-62002 |  | Drawing No.: 792.87106 |  | Rev. B            |  |                            |  |


100 DL 62002

Izolačia - Rockwool WM-105 - ZINC - Hr. - 100 mm

Pozinkovaný plech - hr. 0,8 mm

This drawing is protected by copyright.  
It may not be copied or used without our written  
authorization and it is strictly prohibited  
to disclose it to any third parties.

# AS BUILT

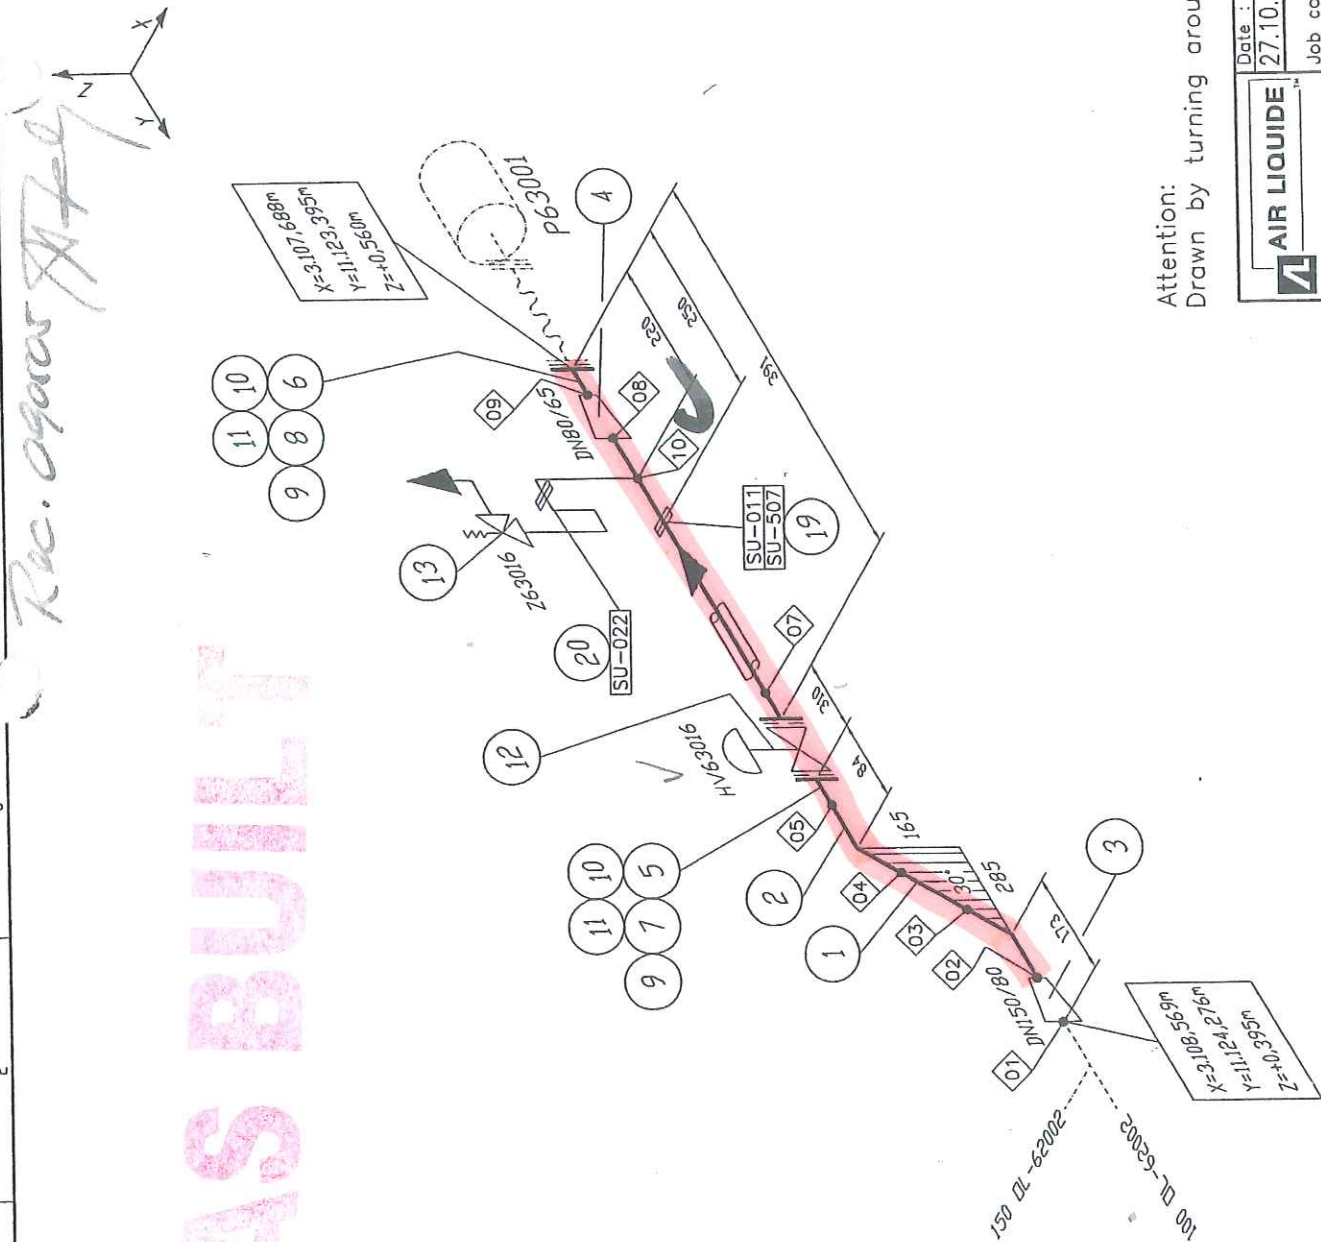

| Welding No. | DN  | Diameter | Welder No. | Protocol No. |
|-------------|-----|----------|------------|--------------|
| 01          | 100 | 114.3    | ---        | ---          |
| 02          | 80  | 88.9     | ---        | ---          |
| 03          | 80  | 88.9     | ---        | ---          |
| 04          | 80  | 88.9     | ---        | ---          |
| 05          | 80  | 88.9     | ---        | ---          |
| 06          | 80  | 88.9     | ---        | ---          |
| 07          | 80  | 88.9     | ---        | ---          |
| 08          | 80  | 88.9     | ---        | ---          |
| 09          | 65  | 76.1     | ---        | ---          |
| 10          | 33  | ---      | ---        | ---          |

Remarks:

Responsibility of the assembling company:

- Situation of mounting seams
- Situation of pass-lengths
- Check of measure details and pipe courses on the construction site
- Situation of the spindle at valve

Accompanying drawings:

- 150 OL-62002 ZB10C1C
- 100 OL-62002 ZB10C1C

Accompanying lists:

- 80 OL-62002 ZB10C1C

Pipe standard:

- AL Standard No.: 50030 (ZB10C1)

Attention: Drawn by turning around 45°


|                    |  |                        |  |                   |  |                            |  |
|--------------------|--|------------------------|--|-------------------|--|----------------------------|--|
| Date: 27.10.2004   |  | Name: Reid./IES        |  | Checked: Hr. Gans |  | History file: 79287106.doc |  |
| Job code: K70101   |  | Reference: ASU Kosice  |  | Scale: ---:---    |  | Original format: DIN A3    |  |
| Replaces: 79_      |  | Replaced by: 79_       |  | Sheet: 001 of 001 |  | Sheets: Rev.               |  |
| Title: 80 OL-62002 |  | Drawing No.: 792.87106 |  | Rev. B            |  |                            |  |

| B    | diff. Changes | 16.04.05 | Rb./IES | Gans   |
|------|---------------|----------|---------|--------|
| A    | diff. Changes | 19.01.05 | Rb./IES | Gans   |
| Rev. | Revisions     | Date     | Name    | proved |

Kyslík  
80 OL-62002

IZOLÁCIA - ROCKWOOL WM 105 ZINC Hr. 100mm  
pozinkovaný plech - hr: 0,8mm

# AS BUILT

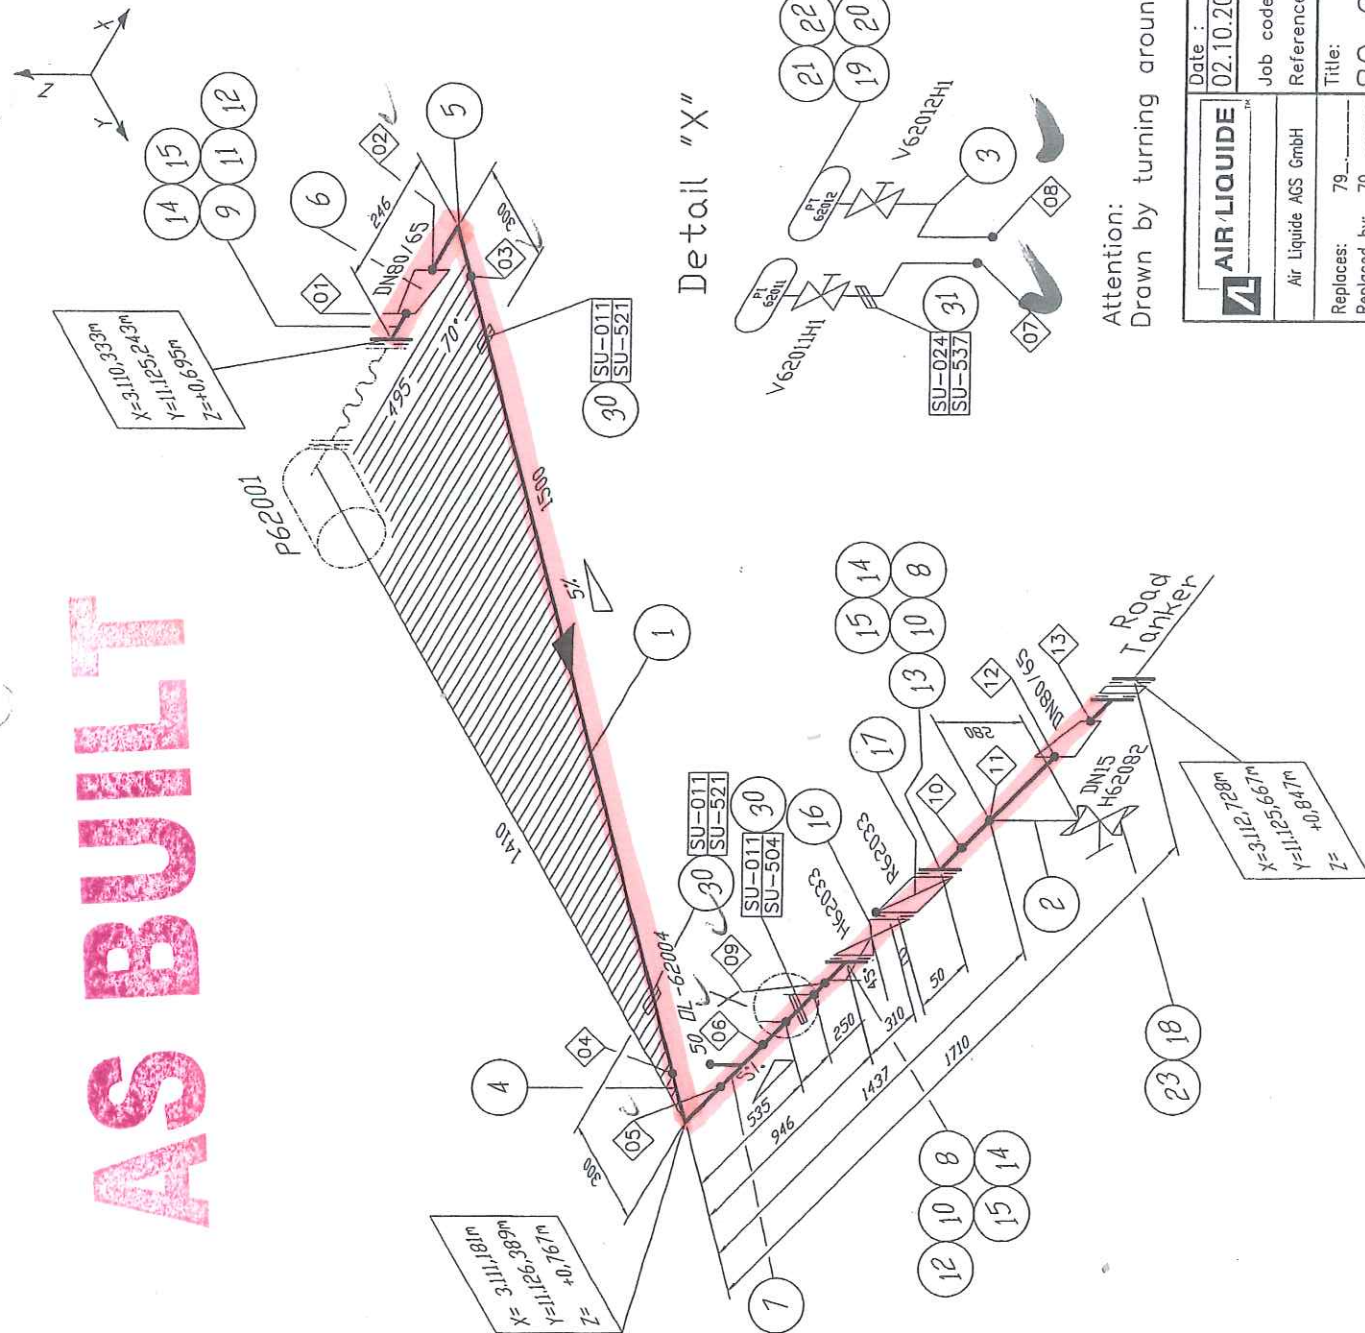

## Remarks:

- Responsibility of the assembling company:
- Situation of mounting seams
  - Situation of pass-lengths
  - Check of measure details and pipe courses on the construction site
  - Situation of the spindle at valve

## Accompanying drawings:

- 50 OL-62004 ZB40C1C

## Accompanying lists:

- 80 OL-62003 ZB10C1C

## Pipe standard:

- AL Standard No.: 50030 (ZB10C1)

Attention:  
Drawn by turning around 45°



Date: 02.10.2004  
Reid./IES

Job code: K70101  
Reference: ASU Kosice

Title: 80 OL-62003

Replaces: 79  
Replaced by: 79

Sheet: 001 of 001  
Drawing No.: 792.87106 B

Scale: ---:---  
Original format: DIN A3

History file: 79287106.doc

Checked: Hr. Gans

Rev. Revisions Date Name proved

-B diverse 24.06.05 WIP/Red. Dz/IES

-A dif. Changes 19.01.05 Rb/IES Gans

| Welding No. | DN | Diameter | Welder No. | Protocol No. |
|-------------|----|----------|------------|--------------|
| 01          | 65 | 76,1     | 96         |              |
| 02          | 80 | 88,9     | 96         |              |
| 03          | 80 | 88,9     | 96         |              |
| 04          | 80 | 88,9     | 96         |              |
| 05          | 80 | 88,9     | 96         |              |
| 06          | 80 | 88,9     | 96         |              |
| 07          | 80 | 88,9     | 96         |              |
| 08          | 80 | 88,9     | 96         |              |
| 09          | 80 | 88,9     | 96         |              |
| 10          | 80 | 88,9     | 96         |              |
| 11          | 15 | 21,3     | 96         |              |
| 12          | 80 | 88,9     | 96         |              |
| 13          | 65 | 76,1     | 96         |              |


Kyslík

80 OL - 62 003


IZOLÁCIA - Rockwool WM 105 ZINC Hr. 80 mm  
pozinkovaný plech - Hr. 0,8 mm

Trasa nie je v zozname (práca navyše)

This drawing is protected by copyright  
 It may not be copied or used without our written  
 authorization and it is strictly prohibited  
 to disclose it to any third parties.

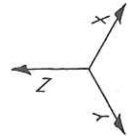

**AS BUILT**

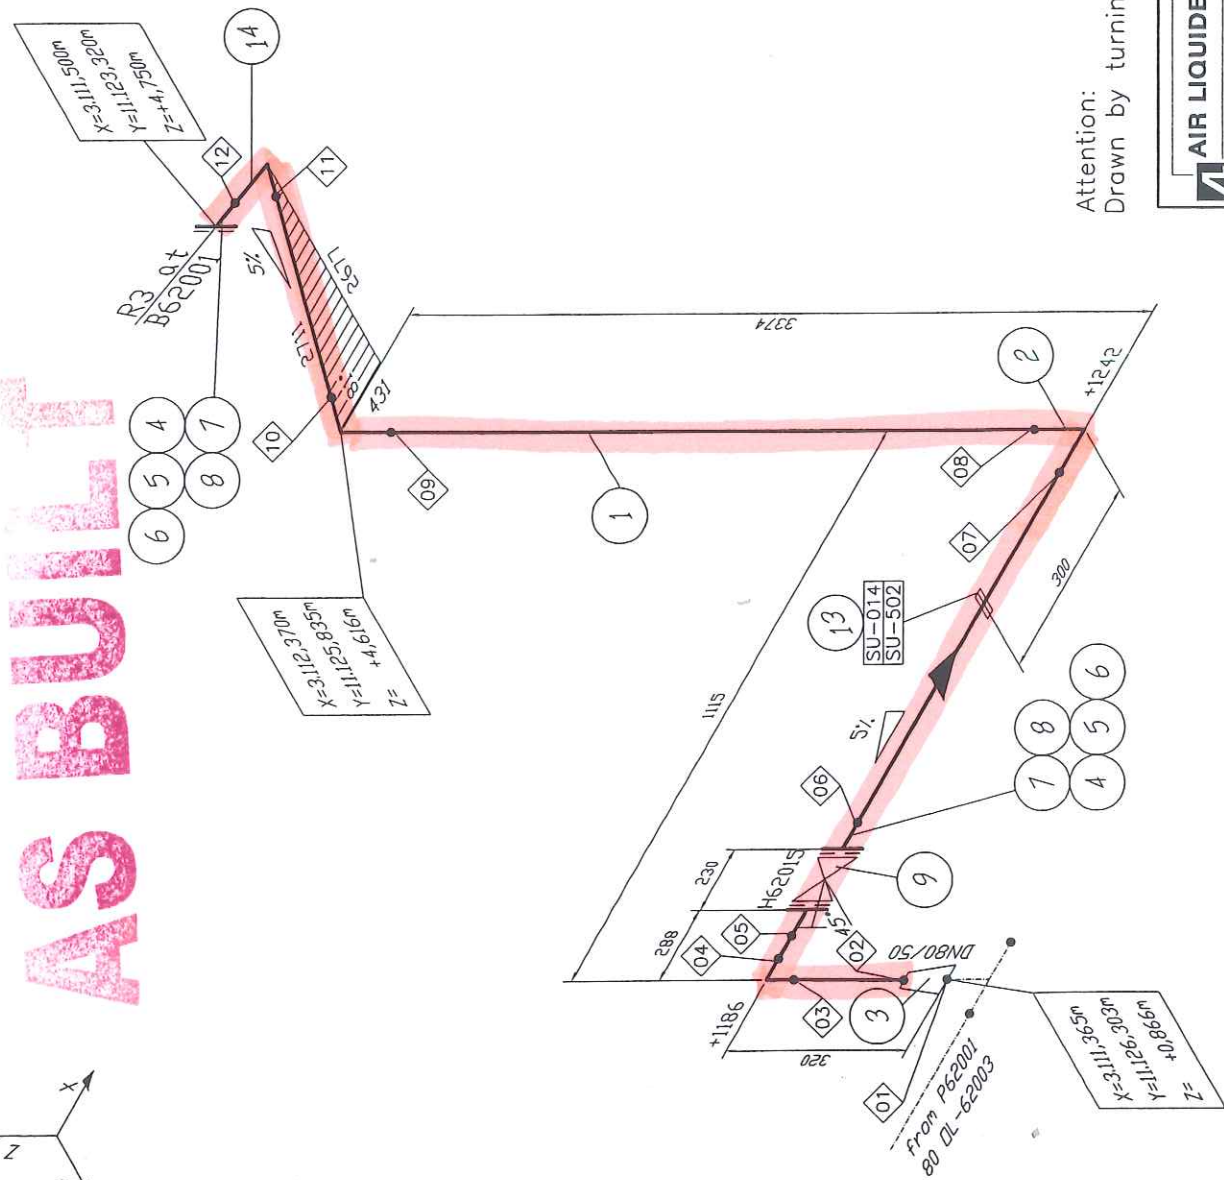

*Rec. Peter [Signature]*

**Remarks:**

- Responsibility of the assembling company:
- Situation of mounting seams
  - Situation of pass-lengths
  - Check of measure details and pipe courses on the construction site
  - Situation of the spindle at valve

**Accompanying drawings:**

- 80 OL-62003 ZB10C1C

**Accompanying lists:**

- 50 OL-62004 ZB40C1C

**Pipe standard:**

- AL Standard No.: 50030 (ZB10C1)

Attention:  
 Drawn by turning around 45°

|                    |  |                        |            |            |           |                 |          |               |              |
|--------------------|--|------------------------|------------|------------|-----------|-----------------|----------|---------------|--------------|
| <b>AIR LIQUIDE</b> |  | Date :                 | 02.10.2004 | Name :     | Reid./IES | Checked:        | Hr. Gans | History file: | 79287106.doc |
| Job code: K70101   |  | Reference: ASU Kosice  |            | Scale      |           | Original format |          | DIN A3        |              |
| Replaces: 79_      |  | Title: 50 OL-62004     |            | Sheet: 001 |           | of 001          |          | Sheets        |              |
| Replaced by: 79_   |  | Drawing No.: 792.87106 |            | Rev.       |           | B               |          |               |              |



| Welding No. | DN | Diameter | Welder No. | Protocol No. |
|-------------|----|----------|------------|--------------|
| 01          | 80 | 88,9     |            |              |
| 02          | 50 | 60,3     |            |              |
| 03          | 50 | 60,3     |            |              |
| 04          | 50 | 60,3     |            |              |
| 05          | 50 | 60,3     |            |              |
| 06          | 50 | 60,3     |            |              |
| 07          | 50 | 60,3     |            |              |
| 08          | 50 | 60,3     |            |              |
| 09          | 50 | 60,3     |            |              |
| 10          | 50 | 60,3     |            |              |
| 11          | 50 | 60,3     |            |              |
| 12          | 50 | 60,3     |            |              |

Ky slika - OL 62004

izol. Rockwool - VM 105 ZINC HR - 80 mm

pozink. plech - HR - 0,8 mm

**AS BUILT**

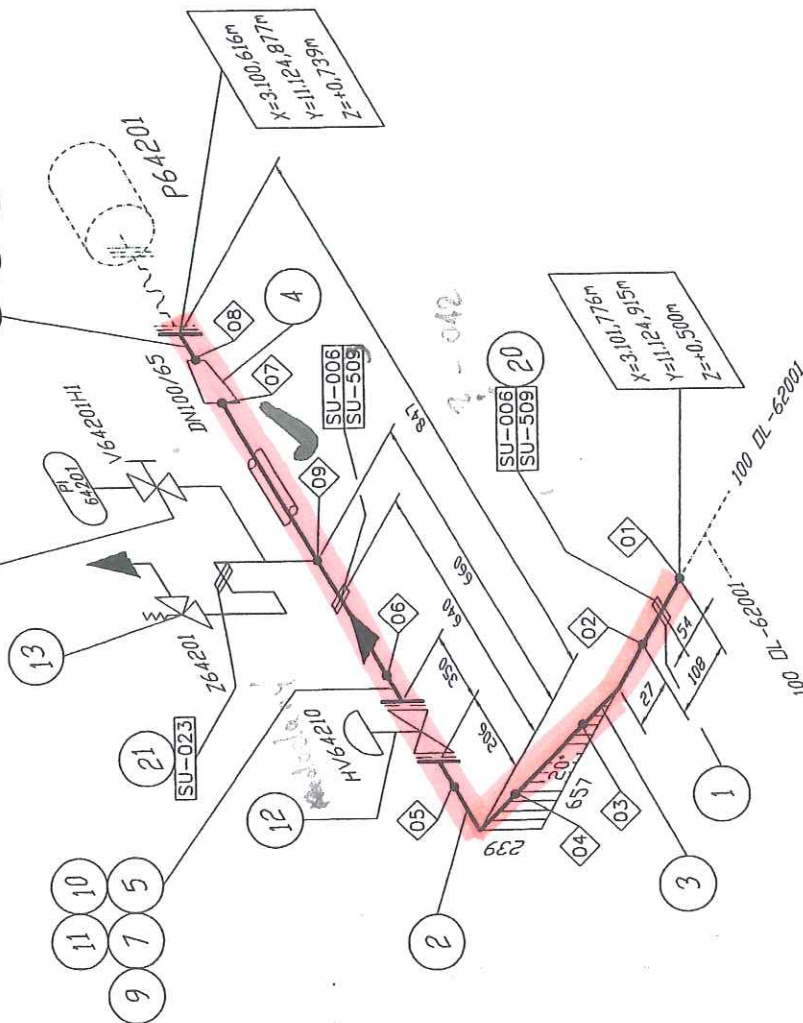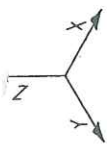

| Welding No. | DN  | Diameter | Welder No. | Protocol No. |
|-------------|-----|----------|------------|--------------|
| 01          | 100 | 114,3    | ---        | ---          |
| 02          | 100 | 114,3    | ---        | ---          |
| 03          | 100 | 114,3    | ---        | ---          |
| 04          | 100 | 114,3    | ---        | ---          |
| 05          | 100 | 114,3    | ---        | ---          |
| 06          | 100 | 114,3    | ---        | ---          |
| 07          | 100 | 114,3    | ---        | ---          |
| 08          | 65  | 76,1     | ---        | ---          |
| 09          | 33  | ---      | ---        | ---          |

*Re. 040005*

### Remarks:

Responsibility of the assembling company:

- Situation of mounting seams
- Situation of pass-lengths
- Check of measure details and pipe courses on the construction site
- Situation of the spindle at valve

### Accompanying drawings:

- 100 OL-62001 ZB10C1C

### Accompanying lists:

- Parts list:
- 100 OL-62005-ZB10C1C

### Pipe standard:

- AL Standard No.: 50030 (ZB10C1)

Attention:  
Drawn by turning around 45°


|                       |  |                        |  |                         |  |                            |  |
|-----------------------|--|------------------------|--|-------------------------|--|----------------------------|--|
| Date: 27.10.2004      |  | Name: Reid./IES        |  | Checked: Hr. Gans       |  | History file: 79287106.doc |  |
| Job code: K70101      |  | Scale: ---:---         |  | Original format: DIN A3 |  |                            |  |
| Reference: ASU Kosice |  | Sheet: 001             |  | of 001                  |  | Sheets                     |  |
| Title: 100 OL-62005   |  | Drawing No.: 792.87106 |  | Rev. B                  |  |                            |  |
| Replaces: 79          |  | Replaced by: 79        |  |                         |  |                            |  |

Kyslík

OL - 100 62 005

IZOLÁCIA - Rockwool WM 105 ZINC Hr. 100mm  
pozinkovaný plech - Hr. 0,8mm

5 15 30 45 60 75 90 105 120 135 150

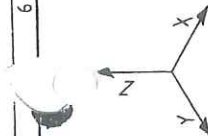

Rec. 1000 177

Responsibility of the assembling company:

- Situation of mounting seams
- Situation of pass-lengths
- Check of measure details and pipe courses on the construction site
- Situation of the spindle at valve

- 80 OL-64101 ZB40C1

- 25 OL-64002 ZB40C1

- AL Standard No.:

50006 (ZB40C1)

|                                                                                                                                  |                             |                              |                                 |                                  |                             |               |                                      |                       |
|----------------------------------------------------------------------------------------------------------------------------------|-----------------------------|------------------------------|---------------------------------|----------------------------------|-----------------------------|---------------|--------------------------------------|-----------------------|
|  <b>AIR LIQUIDE</b><br><small>SAFETY</small> | <b>Date :</b><br>08.11.2004 |                              | <b>Name :</b><br>Reid./IES      |                                  | <b>Checked:</b><br>Hr. Gans |               | <b>History file:</b><br>79287106.doc |                       |
|                                                                                                                                  | <b>Job code:</b><br>K70101  |                              | <b>Reference:</b><br>ASU Kosice |                                  | <b>Scale</b><br>---:---     |               | <b>Original format</b><br>DIN A3     |                       |
| <b>Air Liquide ACS GmbH</b>                                                                                                      |                             | <b>Title:</b><br>25 OL-64002 |                                 | <b>Sheet:</b> 001                |                             | <b>of</b> 001 |                                      | <b>Sheets</b><br>Rev. |
| <b>Replaces:</b><br>79_                                                                                                          |                             | <b>Replaced by:</b><br>79_   |                                 | <b>Drawing No.:</b><br>792.87106 |                             | <b>_A</b>     |                                      |                       |

Kyslík


25 OL-64002

IZOLÁCIA - Rockwool WM 105 ZINC Hr. 60mm  
pozinkovaný plech Hr. 0,8mm

Nie je uznané (práca na viac)

# AS BUILT

This drawing is protected by copyright. It may not be copied or used without our written authorization and it is strictly prohibited to disclose it to any third parties.

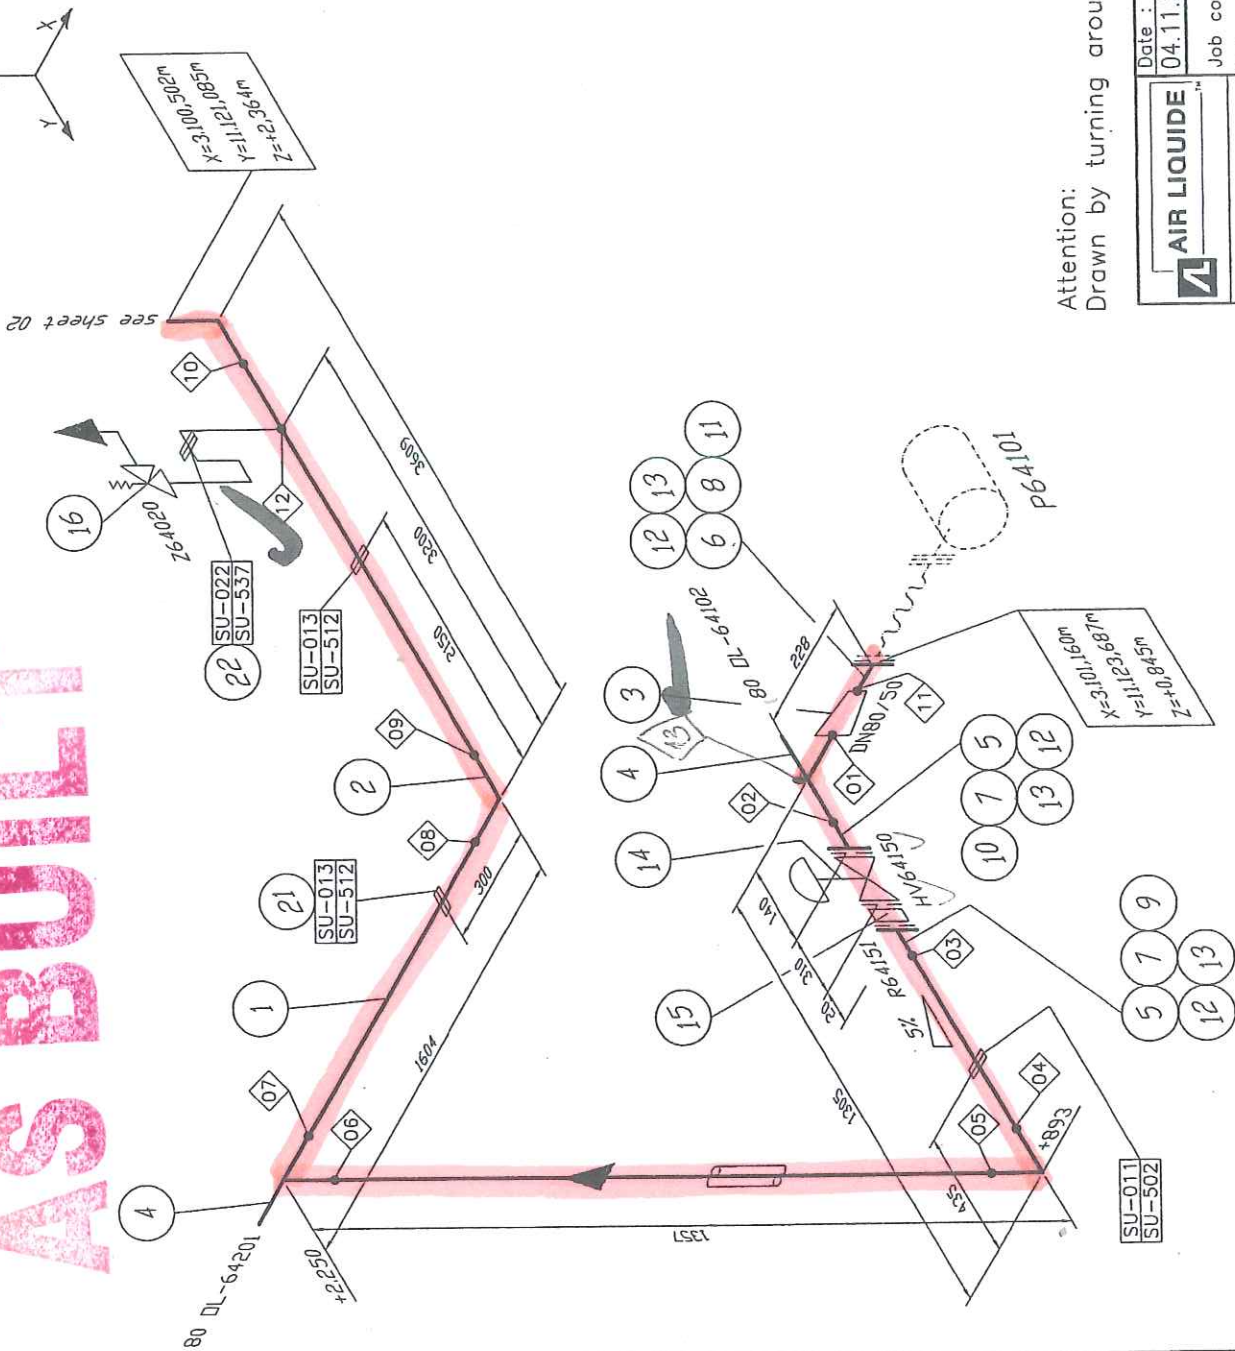

| Welding No. | DN | Diameter | Welder No. | Protocol No. |
|-------------|----|----------|------------|--------------|
| 01          | 80 | 88.9     |            |              |
| 02          | 80 | 88.9     |            |              |
| 03          | 80 | 88.9     |            |              |
| 04          | 80 | 88.9     |            |              |
| 05          | 80 | 88.9     |            |              |
| 06          | 80 | 88.9     |            |              |
| 07          | 80 | 88.9     |            |              |
| 08          | 80 | 88.9     |            |              |
| 09          | 80 | 88.9     |            |              |
| 10          | 80 | 88.9     |            |              |
| 11          | 50 | 60.3     |            |              |
| 12          | 22 | 22       |            |              |

13  
Rev. 19.01.05  
97

## Remarks:

Responsibility of the assembling company:

- Situation of mounting seams
- Situation of pass-lengths
- Check of measure details and pipe courses on the construction site
- Situation of the spindle at valve

## Accompanying drawings:

- 80 OL-64101 ZB40C1C Blatt 02
- 80 OL-64102 ZB40C1C
- 80 OL-64201 ZB40C1C

## Accompanying lists:

- 80 OL-64101 ZB40C1C

## Pipe standard:

- AL Standard No.: 50006 (ZB40C1)

Attention:  
Drawn by turning around 45°

| B    | diff. Changes | 16.04.05 | Rb/IES | Gons   |
|------|---------------|----------|--------|--------|
| A    | diff. Changes | 19.01.05 | Rb/IES | Gons   |
| Rev. | Revisions     | Date     | Name   | proved |

|            |             |              |           |                  |          |               |              |
|------------|-------------|--------------|-----------|------------------|----------|---------------|--------------|
| Date:      | 04.11.2004  | Name:        | Reid./IES | Checked:         | Hr. Gons | History file: | 79287106.doc |
| Job code:  | K70101      | Scale:       | ---       | Original format: | DIN A3   |               |              |
| Reference: | ASU Kosice  | Sheet:       | 001       | of 003           | Sheets   |               |              |
| Title:     | 80 OL-64101 | Drawing No.: | 792.87106 | Rev.:            | B        |               |              |



Air Liquide AGS GmbH

Replaces: 79

Replaced by: 79

AS BUILT

This drawing is protected by copyright.  
It may not be copied or used without our written  
authorization and it is strictly prohibited  
to disclose it to any third parties.

150 135 120 105 90 75 60 45 30 15 5

| Welding<br>No. | DN | Diameter | Welder<br>No. | Protocol<br>No. |
|----------------|----|----------|---------------|-----------------|
| 21             | 80 | 88,9     | ---           | ---             |
| 22             | 80 | 88,9     | ---           | ---             |
| 23             | 80 | 88,9     | ---           | ---             |
| 24             | 22 | 22       | ---           | ---             |

Rec. 09000 K 12

#### Remarks:

Responsibility of the assembling company:

- Situation of mounting seams
- Situation of pass-lengths
- Check of measure details and pipe courses on the construction site
- Situation of the spindle at valve

#### Accompanying drawings:


- 80 OL-64101 ZB40C1C Blatt 02
- 50 OL-64004 ZB40C1
- 25 OL-64002 ZB40C1

#### Accompanying lists:

- 80 OL-64101 ZB40C1C

#### Pipe standard:

- AL Standard No.: 50006 (ZB40C1)

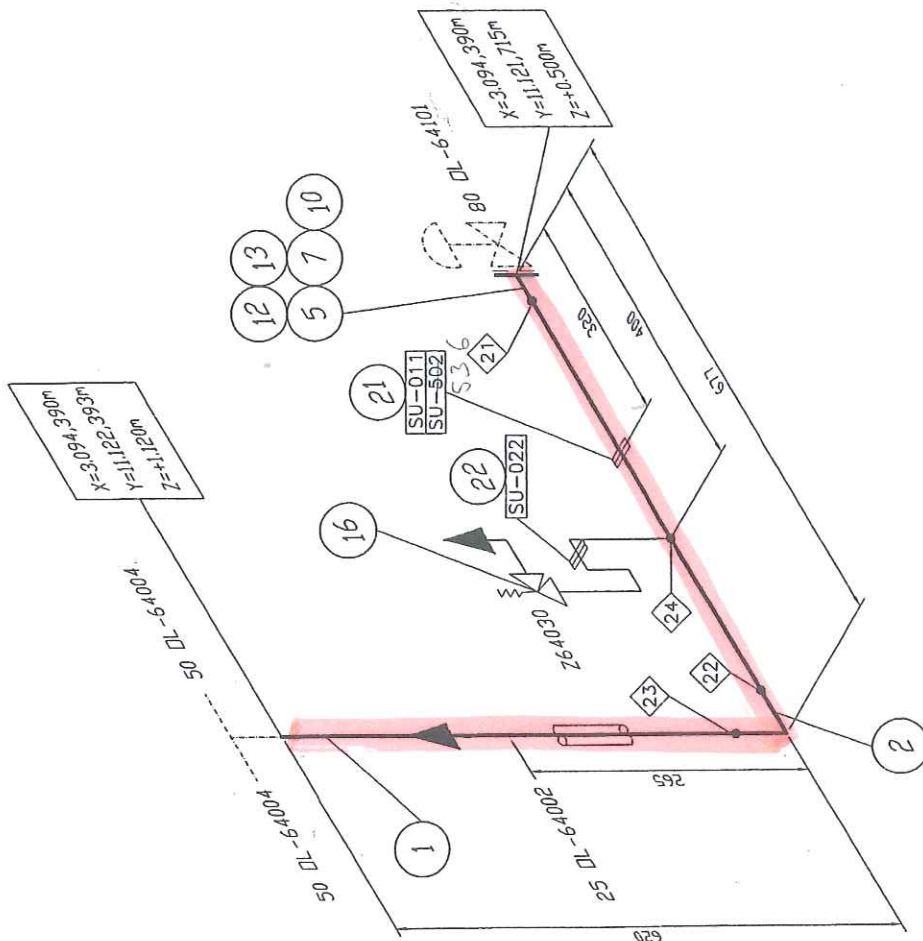

|   |               |          |       |      |
|---|---------------|----------|-------|------|
| B | diff. Changes | 16.04.05 | Rb/ES | Gans |
| A | diff. Changes | 19.01.05 | Rb/ES | Gans |

|      |           |      |      |        |
|------|-----------|------|------|--------|
| Rev. | Revisions | Date | Name | proved |
|------|-----------|------|------|--------|

History file:

|            |           |          |               |
|------------|-----------|----------|---------------|
| Date :     | Name :    | Checked: | History file: |
| 04.11.2004 | Reid./IES | Hr. Gans | 79287106.doc  |

|           |       |                 |
|-----------|-------|-----------------|
| Job code: | Scale | Original format |
| K70101    | --:-- | DIN A3          |

|            |        |     |        |
|------------|--------|-----|--------|
| Reference: | Sheet: | of  | Sheets |
| ASU Kosice | 003    | 003 | Rev.   |

|             |              |      |
|-------------|--------------|------|
| Title:      | Drawing No.: | Rev. |
| 80 OL-64101 | 792,87106    | B    |

1

2

3

4


5

6

7

8

1-04-19 70 08

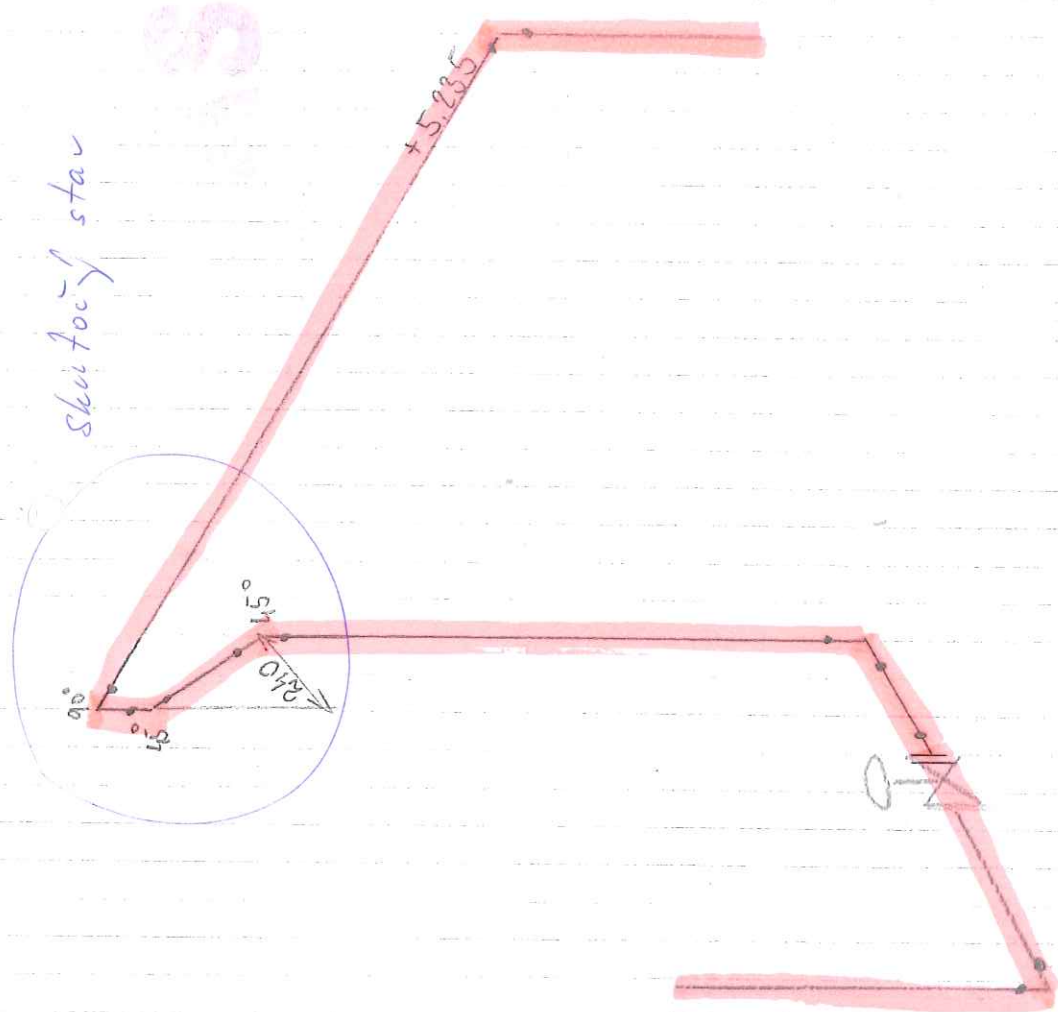


Kyslik 80 OL-64 101

IZOLĀCIJA ~~—~~ ROCKWOOL WM 105 ZINC Hr. 100 mm  
pozinkovāj' plech Hr. 0,8 mm

# ASBUL

It may not be copied or used without our written authorization and it is strictly prohibited to disclose it to any third parties.

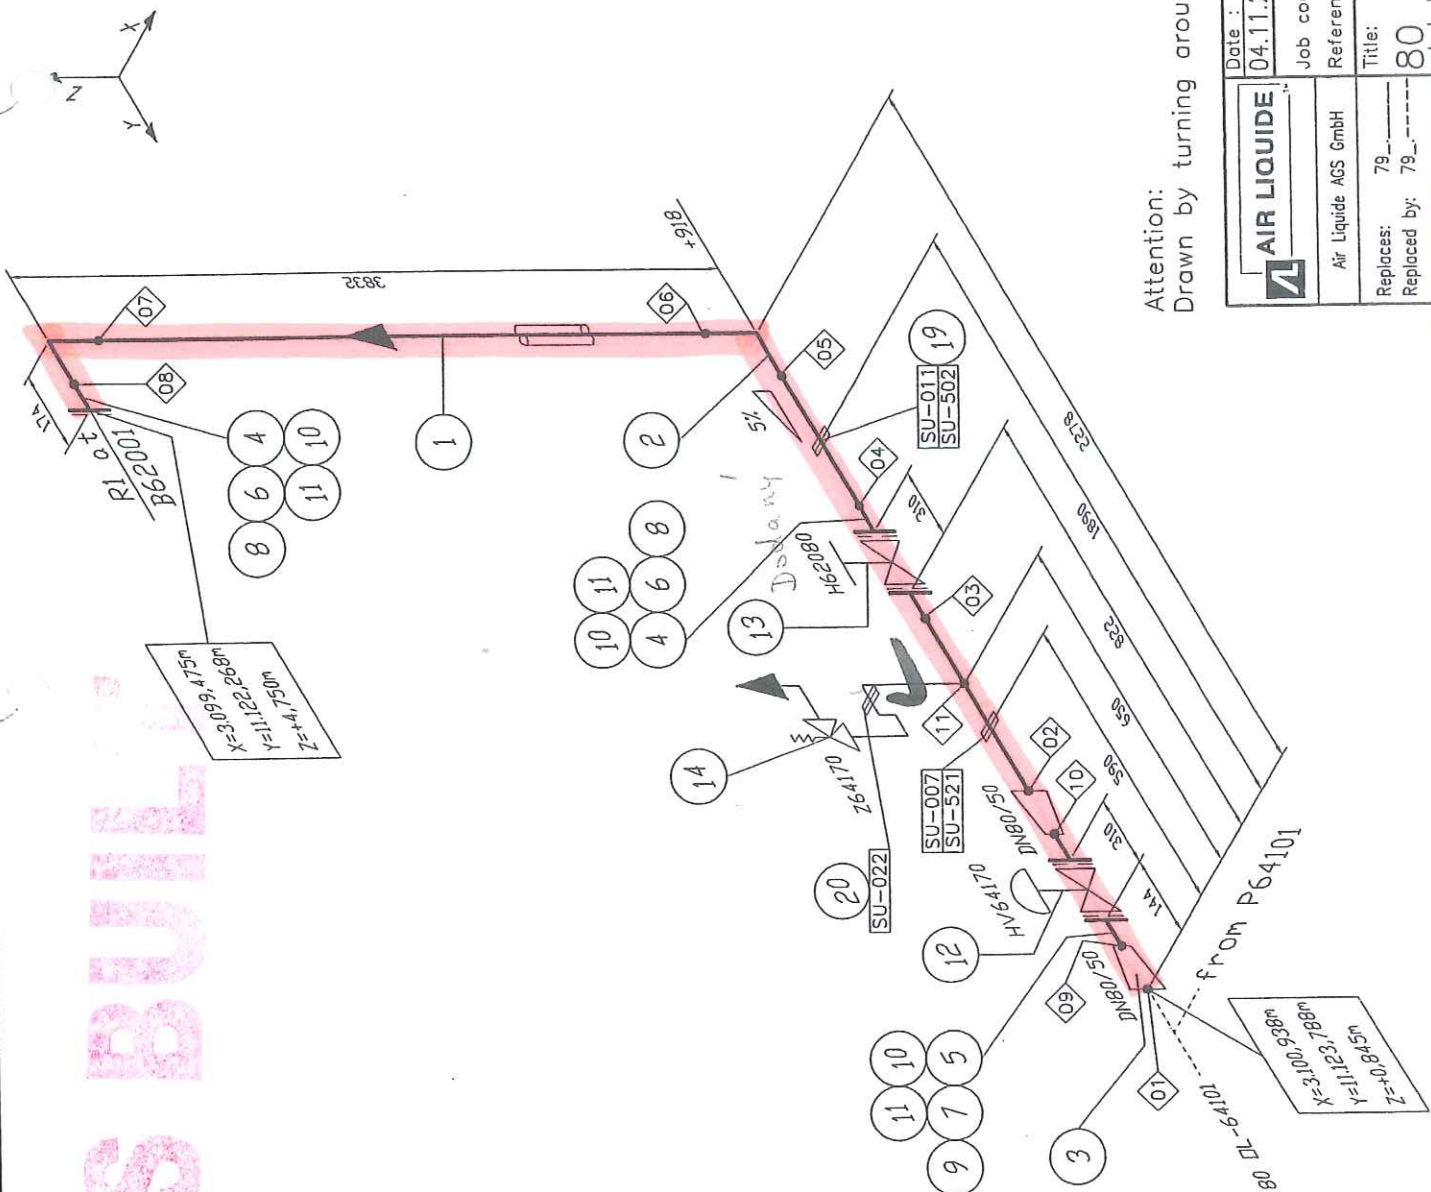

| Welding No. | DN | Diameter | Welder No. | Protocol No. |
|-------------|----|----------|------------|--------------|
| 01          | 80 | 88.9     |            |              |
| 02          | 80 | 88.9     |            |              |
| 03          | 80 | 88.9     |            |              |
| 04          | 80 | 88.9     |            |              |
| 05          | 80 | 88.9     |            |              |
| 06          | 80 | 88.9     |            |              |
| 07          | 80 | 88.9     |            |              |
| 08          | 80 | 88.9     |            |              |
| 09          | 50 | 60.3     |            |              |
| 10          | 50 | 60.3     |            |              |
| 11          | 22 |          |            |              |

*Re. 09007721*

**Remarks:**  
 Responsibility of the assembling company:  
 - Situation of mounting seams  
 - Situation of pass-lengths  
 - Check of measure details and pipe courses on the construction site  
 - Situation of the spindle at valve

**Accompanying drawings:**  
 - 80 OL-64101 ZB40C1C

**Accompanying lists:**  
 - 80 OL-64102 ZB40C1C

**Pipe standard:**  
 - AL Standard No.: 50006 (ZB40C1)

Attention:  
 Drawn by turning around 45°

|                      |        |            |             |              |           |                 |              |
|----------------------|--------|------------|-------------|--------------|-----------|-----------------|--------------|
| <b>AIR LIQUIDE</b>   |        | Date :     | 04.11.2004  | Name :       | Reid./IES | Hr. Gans        | 79287106.doc |
| Air Liquide AGS GmbH |        | Job code:  | K70101      | Scale        | ---       | Original format | DIN A3       |
| Replaces:            | 79---- | Reference: | ASU Kosice  | Sheet:       | 001       | of 001          | Sheets       |
| Replaced by:         | 79---- | Title:     | 80 OL-64102 | Drawing No.: | 792.87106 | Rev.            | B            |

| Rev. | Revisions     | Date     | Name    | proved |
|------|---------------|----------|---------|--------|
| B    | diff. Changes | 16.04.05 | Rb./IES | Gans   |
| A    | diff. Changes | 18.01.05 | Rb./IES | Gans   |


| Checked: | History file: |
|----------|---------------|
|          | 79287106.doc  |

Ry s lik


80 OL - 64 102

IZOLÁCIA - ROCKWOOL WM 105 ZINC Hr. 100 mm  
pozinkovaný plech Hr. 0,8 mm

This drawing is protected by copyright.  
It may not be copied or used without our written  
authorization and it is strictly prohibited  
to disclose it to any third parties.

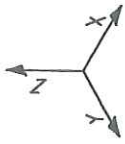

# AS BUILT

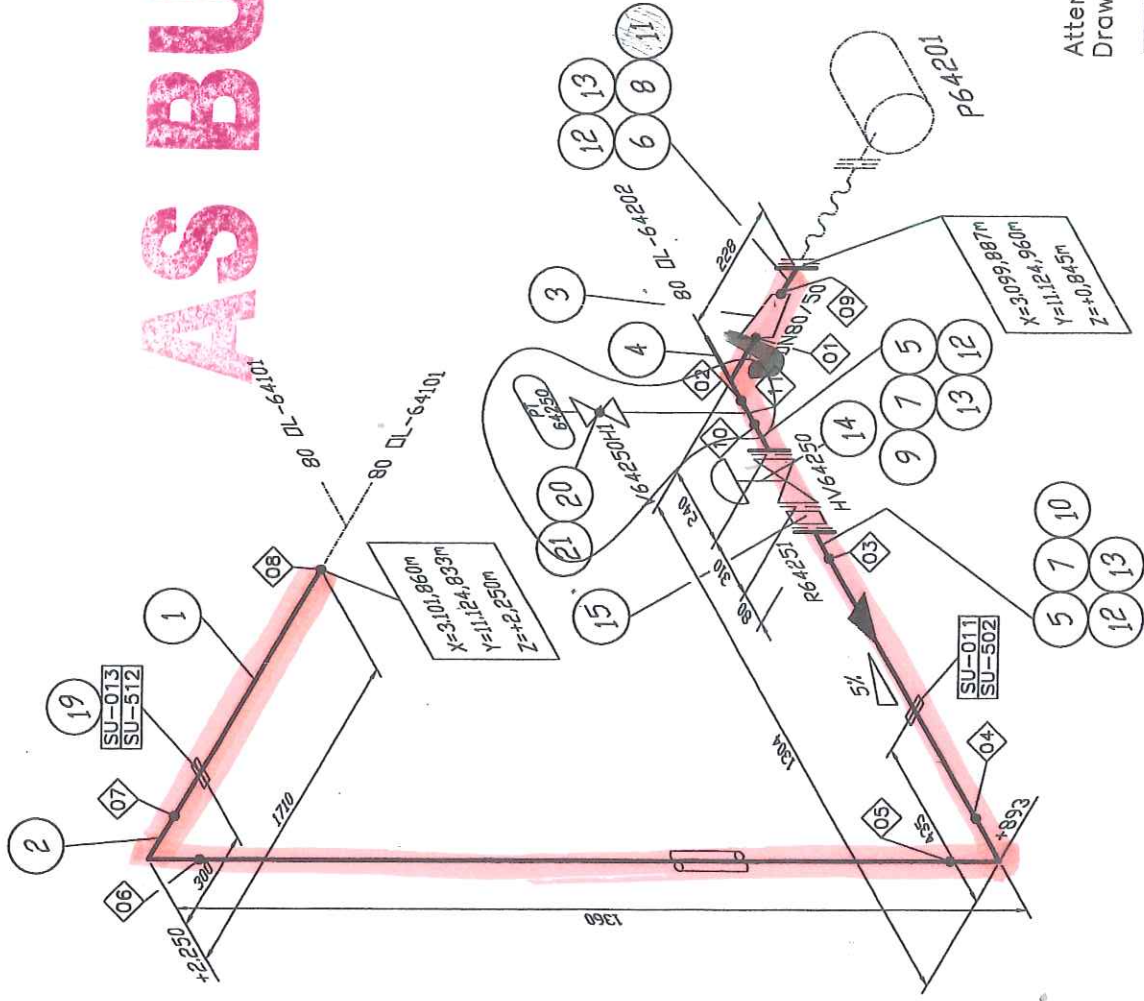

| Welding No. | DN | Diameter | Welder No. | Protocol No. |
|-------------|----|----------|------------|--------------|
| 01          | 80 | 88.9     |            |              |
| 02          | 80 | 88.9     |            |              |
| 03          | 80 | 88.9     |            |              |
| 04          | 80 | 88.9     |            |              |
| 05          | 80 | 88.9     |            |              |
| 06          | 80 | 88.9     |            |              |
| 07          | 80 | 88.9     |            |              |
| 08          | 80 | 88.9     |            |              |
| 09          | 50 | 60.3     |            |              |
| 10          | 80 | 88.9     |            |              |
| 11          | 25 | 33.7     | QZ         |              |

### Remarks:

- Responsibility of the assembling company:
- Situation of mounting seams
  - Situation of pass-lengths
  - Check of measure details and pipe courses on the construction site
  - Situation of the spindle at valve

### Accompanying drawings:

- 80 OL-64101 ZB40C1C
- 80 OL-64202 ZB40C1C

### Accompanying lists:

- 80 OL-64201 ZB40C1C

### Pipe standard:

- AL Standard No.: 50006 (ZB40C1)

Attention:  
Drawn by turning around 45°


|                      |  |              |             |               |                           |
|----------------------|--|--------------|-------------|---------------|---------------------------|
| <b>AIR LIQUIDE</b>   |  | Date :       | 03.11.2004  | Name :        | Reid./IES                 |
| Air Liquide AGS GmbH |  | Job code:    | K70101      | Checked:      | Hr. Gons                  |
| Replaces: 79         |  | Reference:   | ASU Kosice  | History file: | 79287106.doc              |
| Replaced by: 79      |  | Title:       | 80 OL-64201 | Scale         | Original format<br>DIN A3 |
|                      |  | Sheet:       | 001         | of 001        | Sheets                    |
|                      |  | Drawing No.: | 792.87106   | Rev.          | B                         |

| Rev. | Revisions     | Date     | Name     | proved |
|------|---------------|----------|----------|--------|
| A    | diff. Changes | 18.01.05 | Rb/IES   | Gons   |
| B    | diverse       | 06.06.05 | WIP/Red. |        |

Kyslik 80 OL-64201

IZOLÁCIA  Rockwool WM 105 ZINC Hr. 100 mm  
pozinkovaný plech hr. 0,8 mm

AS BULL

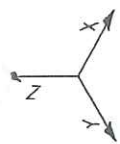

| Welding No. | DN | Diameter | Welder No. | Protocol No. |
|-------------|----|----------|------------|--------------|
| 01          | 80 | 88.9     | ---        | ---          |
| 02          | 80 | 88.9     | ---        | ---          |
| 03          | 80 | 88.9     | ---        | ---          |
| 04          | 80 | 88.9     | ---        | ---          |
| 05          | 80 | 88.9     | ---        | ---          |
| 06          | 80 | 88.9     | ---        | ---          |
| 07          | 80 | 88.9     | ---        | ---          |
| 08          | 80 | 88.9     | ---        | ---          |
| 09          | 80 | 88.9     | ---        | ---          |
| 10          | 80 | 88.9     | ---        | ---          |
| 11          | 50 | 60.3     | ---        | ---          |
| 12          | 50 | 60.3     | ---        | ---          |
| 13          | 22 | ---      | ---        | ---          |

*Rec. 88001/1*

#### Remarks:

Responsibility of the assembling company:

- Situation of mounting seams
- Situation of pass-lengths
- Check of measure details and pipe courses on the construction site
- Situation of the spindle at valve

#### Accompanying drawings:

- 80 OL-64201 ZB40C1C


#### Accompanying lists:

- 80 OL-64202 ZB40C1C

#### Pipe standard:

- AL Standard No.: 50006 (ZB40C1)

Attention:  
Drawn by turning around 45°

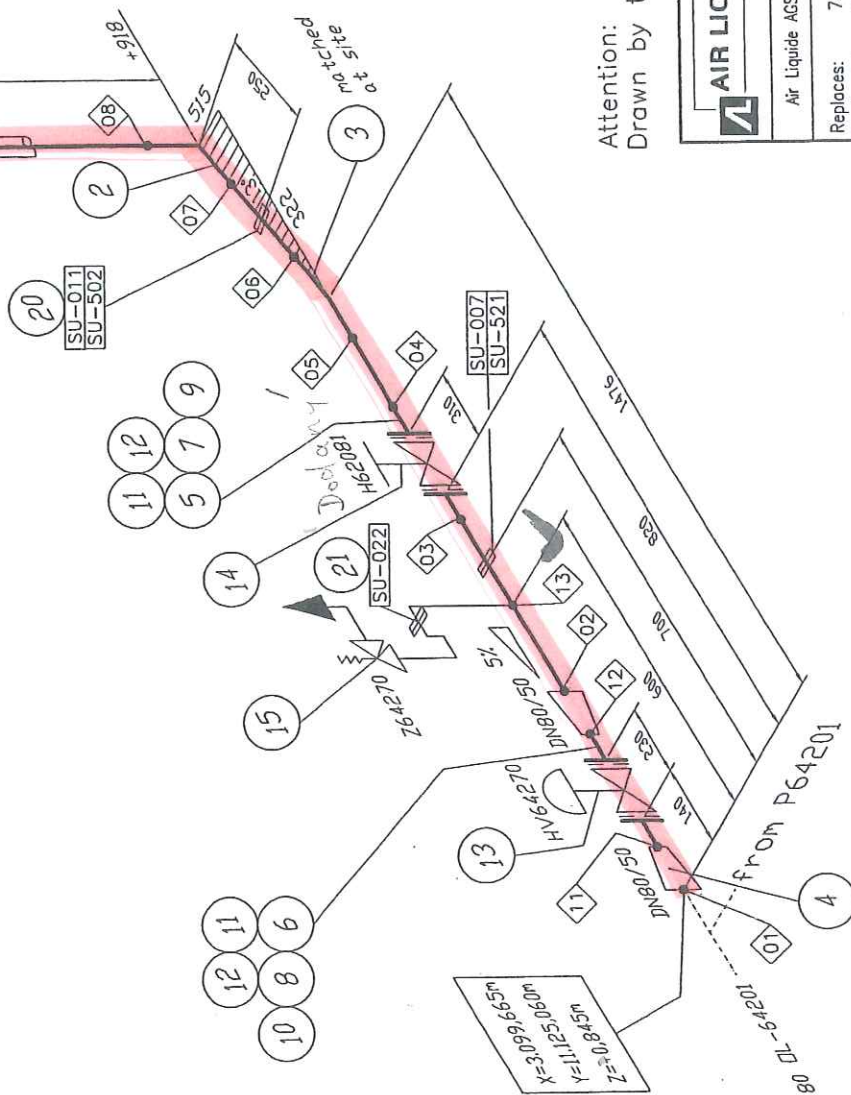


| Rev | Revisions     | Date     | Name   | proved |
|-----|---------------|----------|--------|--------|
| B   | diff. Changes | 16.04.05 | Rb/IES | Gans   |
| A   | diff. Changes | 18.01.05 | Rb/IES | Gans   |

|                      |            |                        |                          |               |                 |
|----------------------|------------|------------------------|--------------------------|---------------|-----------------|
| Date :               | 04.11.2004 | Name :                 | Reid./IES                | History file: | 79287106.doc    |
| AIR LIQUIDE          |            | Job code: K70101       |                          | Scale         | Original format |
| Air Liquide AGS GmbH |            | Reference: ASU Kosice  |                          | ---           | DIN A3          |
| Replaces:            | 79_        | Title:                 | Sheet: 001 of 001 Sheets |               |                 |
| Replaced by:         | 79_        | Drawing No.: 792.87106 |                          | Rev. B        |                 |

Kyslík 80 OL - 64 202

IZOLÁCIA  Rockwool WM 105 ZINC Hr: 100mm  
pozinkovaný plech Hr. 0,8 mm

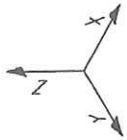

"HOLD"

Dec. 20. 1860. H. H.

Responsibility of the assembling company:

- Accompanying drawings:

- Accompanying lists:

- Pipe standard:

- AL Standard No.:  
50030 (ZB10C1)


|                                                                                                                                 |                                           |                        |            |                   |                            |             |
|---------------------------------------------------------------------------------------------------------------------------------|-------------------------------------------|------------------------|------------|-------------------|----------------------------|-------------|
|  <b>AIR LIQUIDE</b><br>Air Liquide AGS GmbH | Date : 25.10.2004<br>Name :               |                        | Checked:   |                   | History file: 79287106.doc |             |
|                                                                                                                                 | Job code: K70101<br>Reference: ASU Kosice |                        | Revid./IES |                   | Hr. Gans                   |             |
| Title: 150 NL-72001                                                                                                             |                                           | Drawing No.: 792.87106 |            | Sheet: 001 of 001 |                            | Sheets Rev. |
| Replaces: 79_____<br>Replaced by: 79_____<br>7                                                                                  |                                           | 6                      |            | 7                 |                            | 8           |

Dusík 150 NL 72001

izolácia — Rockwool WM 105 ZINC Hr. 100mm  
pozink. plech Hr. 0,8mm

This drawing is protected by copyright. It may not be copied or used without our written authorization and it is strictly prohibited to disclose it to any third parties.

150  
135  
120  
105  
90  
75  
60  
45  
30  
15  
5

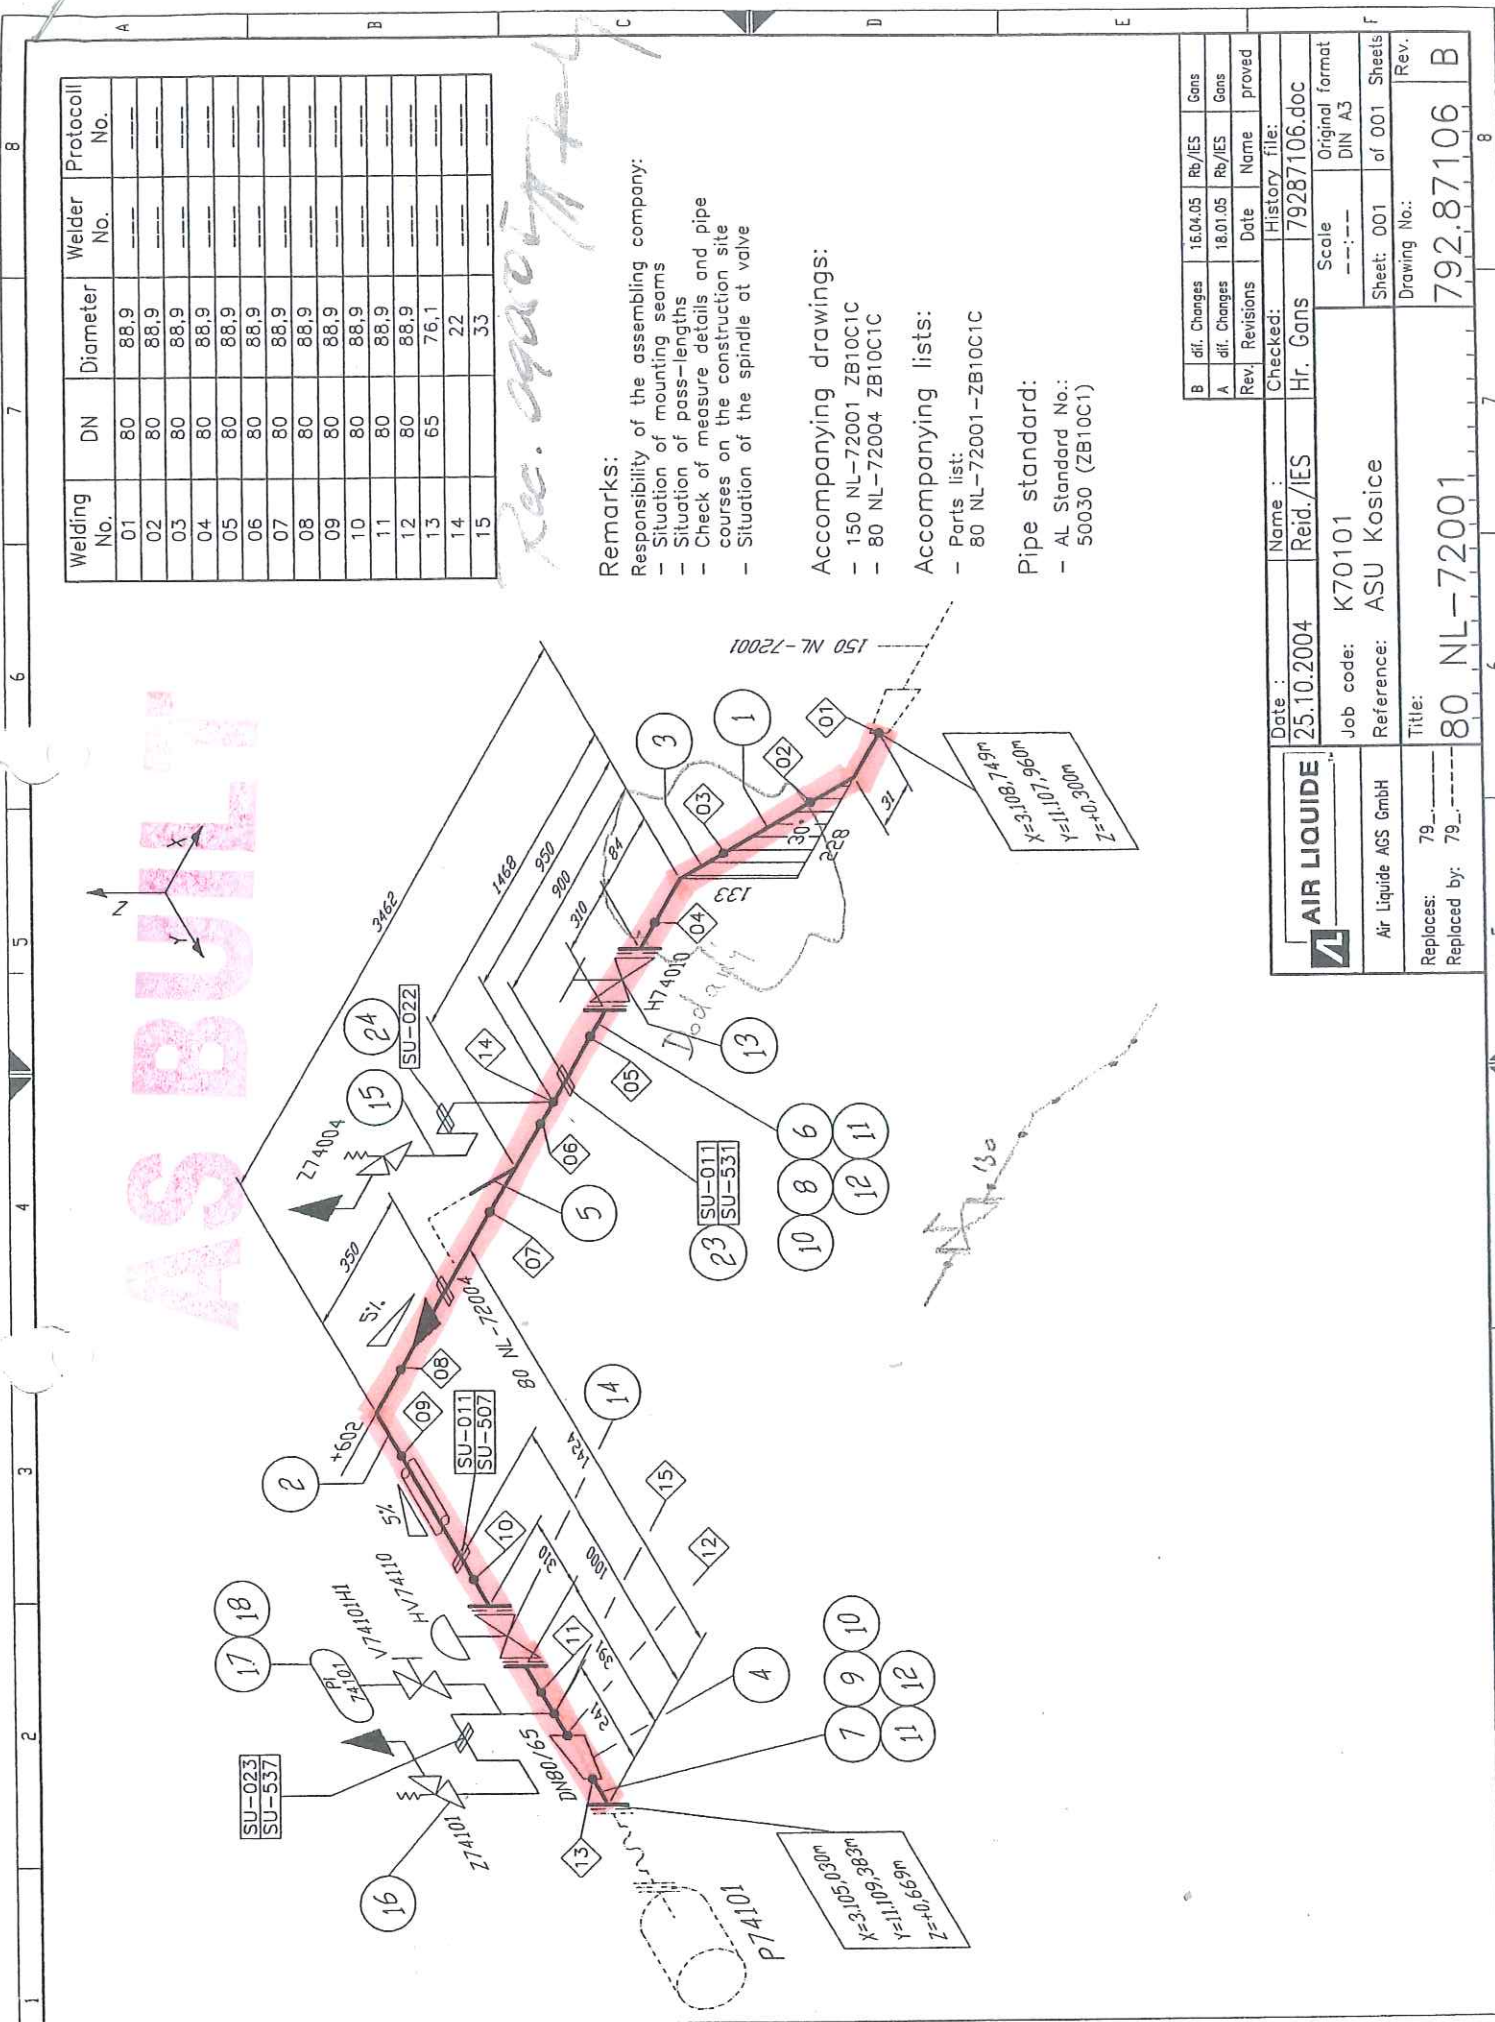



|                   |  |                       |  |                               |  |                            |  |
|-------------------|--|-----------------------|--|-------------------------------|--|----------------------------|--|
| Date : 25.10.2004 |  | Name : Reid./IES      |  | Checked: Hr. Gans             |  | History file: 79287106.doc |  |
| Job code: K70101  |  | Reference: ASU Kosice |  | Scale: Original format DIN A3 |  | Sheet: 001 of 001 Sheets   |  |
| Replaces: 79      |  | Replaced by: 79       |  | Drawing No.: 792.87106        |  | Rev. B                     |  |

| B    | diff. Changes | 16.04.05 | Rb/IES | Gans   |
|------|---------------|----------|--------|--------|
| A    | diff. Changes | 18.01.05 | Rb/IES | Gans   |
| Rev. | Revisions     | Date     | Name   | proved |

Dusík 80 NL - 72 001

izolácia — Rockwool WM 105 ZINC Hr. 100mm  
pozink. plech hr. 0,8mm

AS BUILT

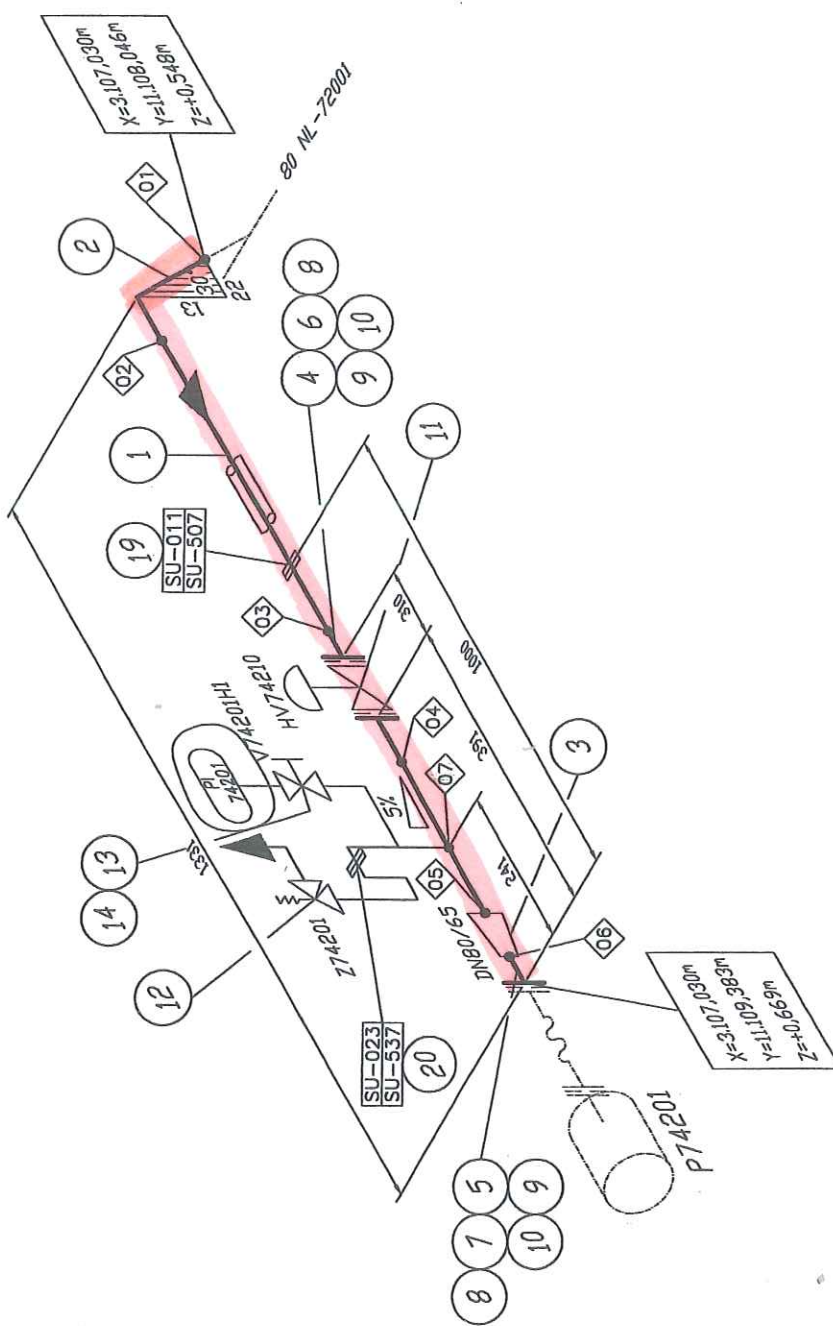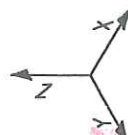

| Welding No. | DN | Diameter | Welder No. | Protocol No. |
|-------------|----|----------|------------|--------------|
| 01          | 80 | 88.9     |            |              |
| 02          | 80 | 88.9     |            |              |
| 03          | 80 | 88.9     |            |              |
| 04          | 80 | 88.9     |            |              |
| 05          | 80 | 88.9     |            |              |
| 06          | 65 | 76.1     |            |              |
| 07          | 33 |          |            |              |

Remarks:

- Responsibility of the assembling company:
- Situation of mounting seams
- Situation of pass-lengths
- Check of measure details and pipe courses on the construction site
- Situation of the spindle at valve

Accompanying drawings:

- 80 NL-72001 ZB10C1C

Accompanying lists:

- Parts list:
- 80 NL-72004-ZB10C1C

Pipe standard:

- AL Standard No.: 50030 (ZB10C1)

|      |               |          |          |        |
|------|---------------|----------|----------|--------|
| C    | diverge       | 07.06.05 | WIP/Red. |        |
| B    | diff. Changes | 16.04.05 | Rb/IES   | Gans   |
| Rev. | Revisions     | Date     | Name     | proved |

|                       |           |                        |
|-----------------------|-----------|------------------------|
| Date :                | Name :    | History file:          |
| 25.10.2004            | Reid./IES | 79287106.doc           |
| Job code: K70101      |           | Scale: Original format |
| Reference: ASU Kosice |           | DIN A3                 |
| Title:                |           | Sheet: 001 of 001      |
| Replaces: 79-...      |           | Drawing No.: 792.87106 |
| Replaced by: 79-...   |           | Rev. C                 |

This drawing is protected by copyright. It may not be copied or used without our written authorization and it is strictly prohibited to disclose it to any third parties.

Dusík 80 NL - 72004

120L ěia - Rockwool WM 105 ZINC Hr. 100mm  
pozink. plech Hr. 0,8mm



AS BUILT



100-24 7N 001-42-101

Dusík 100 NL 72 101

izol. - Rockwool WIM 105 ZINC Hr. 100 mm  
pozink. plech - Hr. 0,8 mm

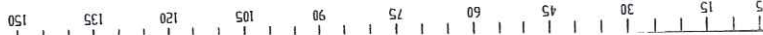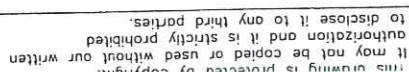

Rec. 2200-76

Responsibility of the assembling company:

- Situation of mounting seams
- Situation of pass-lengths
- Check of measure details and pipe courses on the construction site
- Situation of the spindle at valve

- 50 N-72103 ZB10C1C

- Parts list:

- 80 NL-72102-ZB10C1C

- AL Standard No.:

- AL Standard No.:  
50030 (ZB10C1)


|          |               |
|----------|---------------|
| Checked: | History file: |
|----------|---------------|

Replaces: 79\_-----  
Title: \_\_\_\_\_

Dusík 80 NL - 72 102

izol.  Rockwool WM 105 ZINC Hr. 80 mm  
pozink. plech - Hr. 0,8 mm

Nie je v zozname (práca navyše)

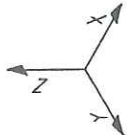

acc. 09080-114

Remarks:

- Responsibility of the assembling company:
- Situation of mounting seams
- Situation of pass-lengths
- Check of measure details and pipe courses on the construction site
- Situation of the spindle at valve

Accompanying drawings:

Accompanying lists:

Pipe standard:

|                                                                                                         |  |            |  |            |  |              |  |                 |  |
|---------------------------------------------------------------------------------------------------------|--|------------|--|------------|--|--------------|--|-----------------|--|
|  <b>AIR LIQUIDE</b> |  | Date :     |  | Name :     |  | Checked:     |  | History file:   |  |
|                                                                                                         |  | 27.10.2004 |  | Reid./IES  |  | Hr. Gans     |  | 79287106.doc    |  |
| Air Liquide ASG GmbH                                                                                    |  | Job code:  |  | K70101     |  | Scale        |  | Original format |  |
|                                                                                                         |  | Reference: |  | ASU Kosice |  | ---:---      |  | DIN A3          |  |
| Replaces: 79_____                                                                                       |  | Title:     |  | 50 N-72103 |  | Sheet: 001   |  | of 001 Sheets   |  |
| Replaced by: 79_____                                                                                    |  |            |  |            |  | Drawing No.: |  | Rev.            |  |
|                                                                                                         |  |            |  |            |  | 792.87106    |  | _A              |  |

It may not be copied or used without our written authorization and it is strictly prohibited to disclose it to any third parties.


Dusík 50 N - 72 103

izolácia — Rockwool WM 105 ZINC Hr. 80 mm  
pozink. plech - Hr. 0,8 mm

This drawing is provided by copyright  
 It may not be copied or used without our written  
 authorization and it is strictly prohibited  
 to disclose it to any third parties.

**AS BUILT**

Re. 09001/177

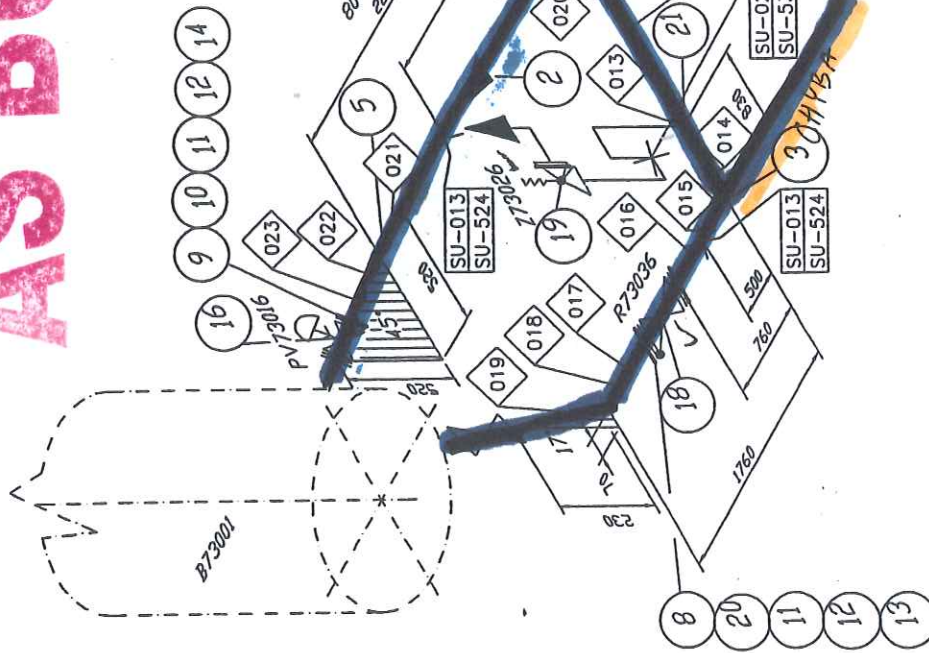

### Remarks:

- Responsibility of the assembling company:
- Situation of mounting seams
- Situation of pass-lengths
- Check of measure details and pipe courses on the construction site
- Situation of the spindle at valve

### Accompanying drawings:

- 80 NL-73001
- 50 NL-73001
- 50 NL-73007
- 80 NL-73101
- 80 NL-73201

### Accompanying lists:


- Parts list:
- 80 NL 73001

| Welding No. | DN | φ    | Welder No. | Protocol No. |
|-------------|----|------|------------|--------------|
| 001         | 80 | 88.9 |            |              |
| 002         | 80 | 88.9 |            |              |
| 003         | 80 | 88.9 |            |              |
| 020         | 50 | 60.3 |            |              |
| 021         | 50 | 60.3 |            |              |
| 022         | 50 | 60.3 |            |              |
| 023         | 50 | 60.3 |            |              |

|                                            |  |                                                                    |  |
|--------------------------------------------|--|--------------------------------------------------------------------|--|
| <b>AIR LIQUIDE</b><br>Air Liquide AGS GmbH |  | Date : 28.10.2004<br>Name : WIP/Rad.                               |  |
| Job code: K70101<br>Reference: ASU Kosice  |  | Checked: 79287106.doc<br>Scale: ---:---<br>Original format: DIN A3 |  |
| Replaces: 79...<br>Replaced by: 79...      |  | Sheet: 002 of 002 Sheets<br>Drawing No.: 792.87106 D               |  |

AS BUILT

B43001

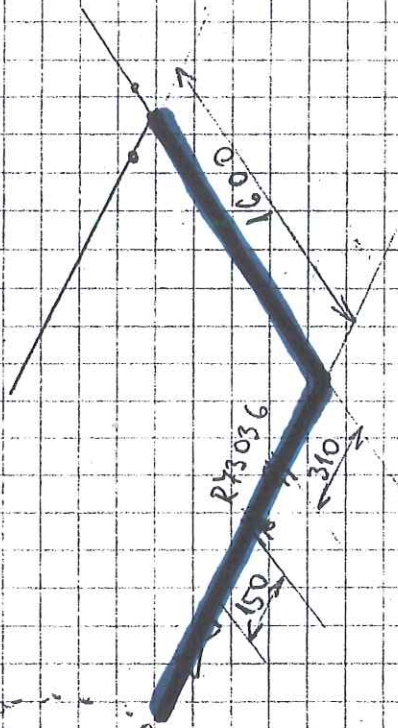


80 NL 43001

Sheet 2

Foamglas

80 NL 7500-1

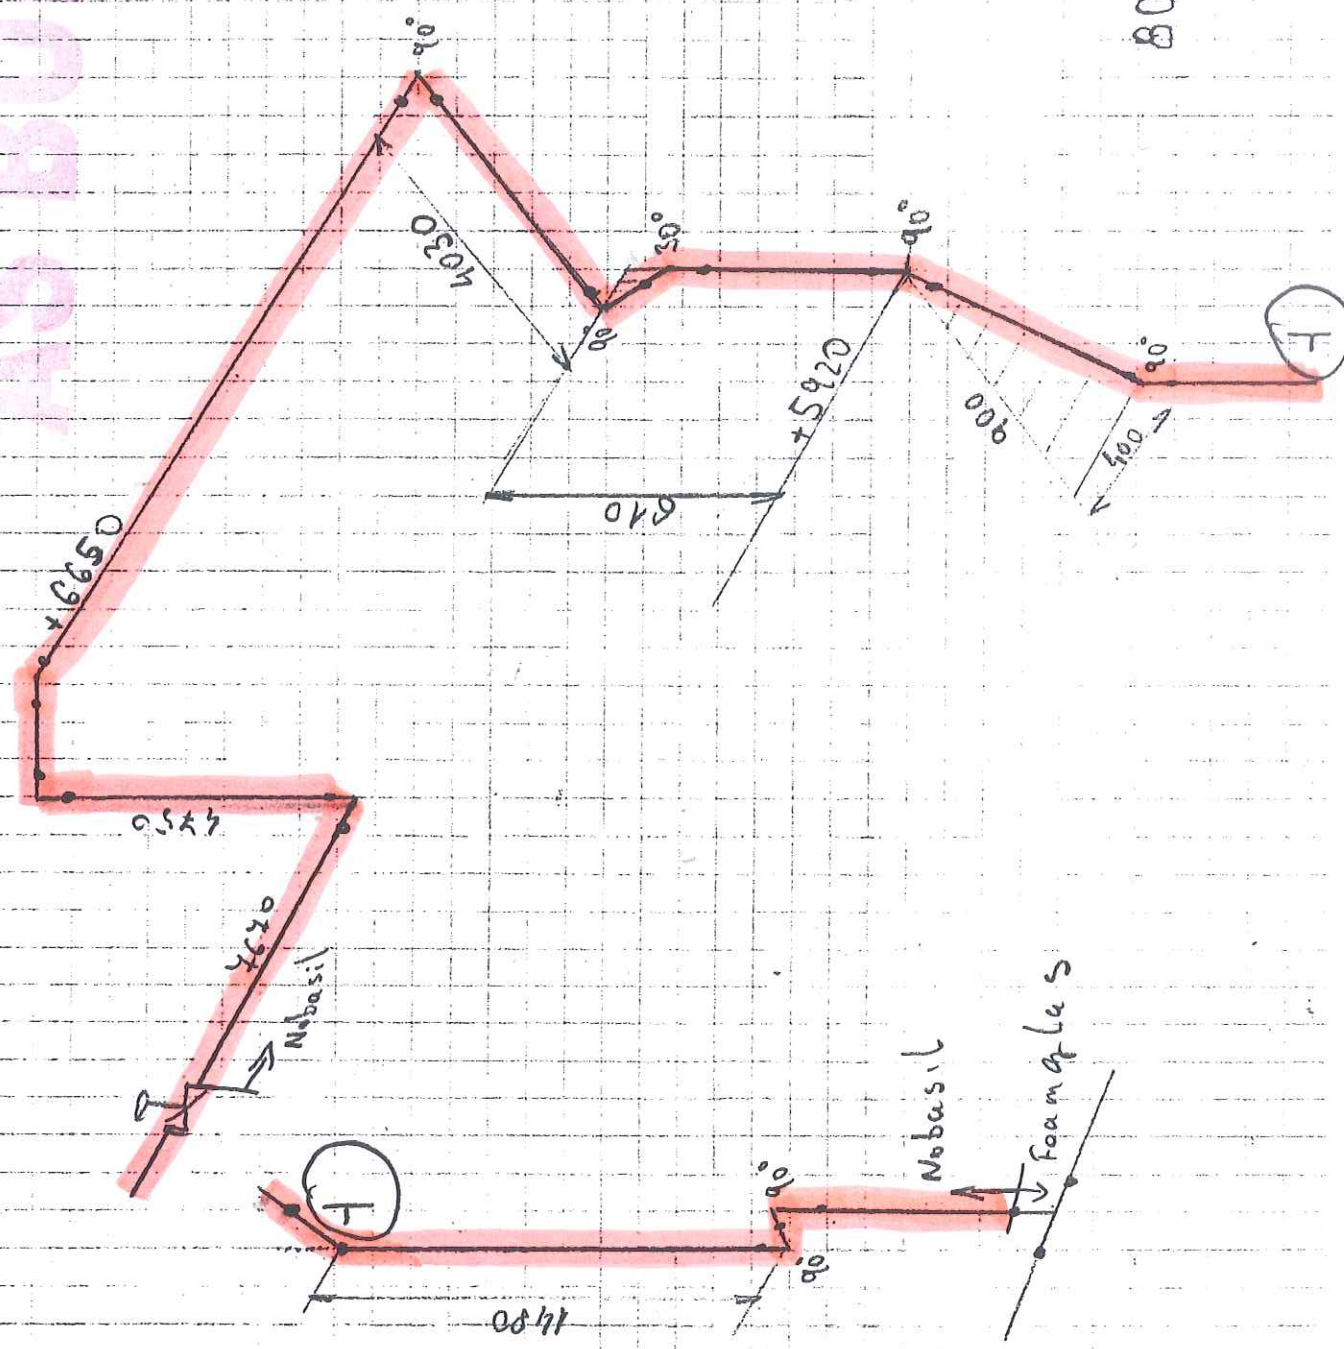

DUSÍK-80 NL 73001

(1. vrstva)

izolácia  Foamglas - hr. 70 mm

pozink. plech - hr. 0,8 mm

Druhá vrstvu izolácie nebolo možné namontovať v požadovanej hrúbke projektu.

Trasa nespadá pod garanciu.

Sheet-2

Dusík - 80 NL 73001


izolácia  Rockwool WM 105 ZINC HR - 80 mm

pozink. plech Hr. 0,8 mm

Sheet-1

See attached file

AS BUILT

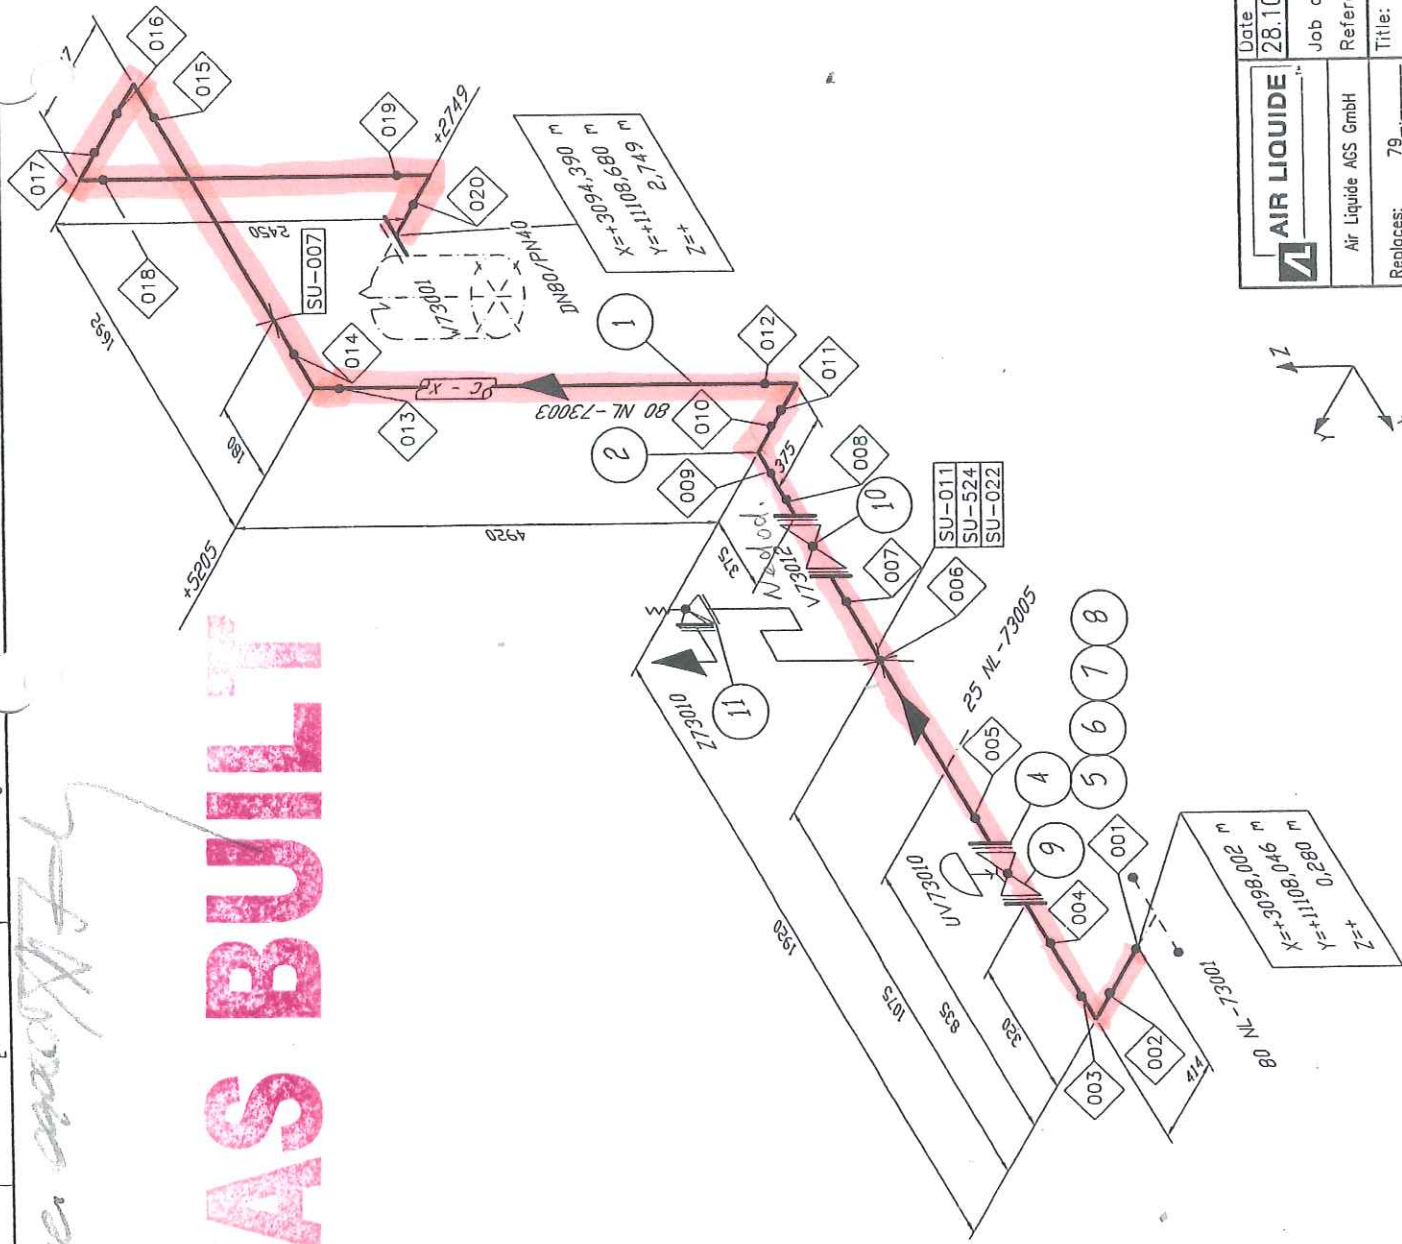

### Remarks:

- Responsibility of the assembling company:
- Situation of mounting seams
  - Situation of pass-lengths
  - Check of measure details and pipe courses on the construction site
  - Situation of the spindle at valve

### Accompanying drawings:

- 80 NL-73001
- 25 NL-73005

### Accompanying lists:

- Parts list:  
80 NL-73003

### Pipe Standard:

- AL Standard No.:  
50026 / ZB25C1

| Welding No. | DN | Ø    | Weider No. | Protocol No. |
|-------------|----|------|------------|--------------|
| 001         | 80 | 88.9 |            |              |
| 002         | 80 | 88.9 |            |              |
| 003         | 80 | 88.9 |            |              |
|                       |                         |
|-----------------------|-------------------------|
| <b>AIR LIQUIDE</b>    |                         |
| Date : 28.10.2004     | Name : WIP/Rad.         |
| Job code: K70101      | Scale: ---              |
| Reference: ASU Kosice | Original format: DIN A3 |
| Title: 80 NL 73003    | Sheet: 001 of 001       |
| Replaces: 79.---      | Rev.:                   |
| Replaced by: 79.---   | Drawing No.: 792.87106  |

| B    | diff. Changes | 16.04.05 | Rb/IES | Gans   |
|------|---------------|----------|--------|--------|
| A    | Revisions     | Date     | Name   | proved |
| Rev. | Revisions     | Date     | Name   | proved |


History file: 79287106.doc

Nobasil

Dusik 80NL 73003

izol. - Rockwool WM 105 ZINC Hr. 100 mm  
pozink. plech - Hr. 0,8 mm


A hand-drawn diagram of a Z-shaped path, shaded in pink. The path consists of three main segments: a bottom horizontal segment, a middle vertical segment, and a top horizontal segment. The bottom horizontal segment is labeled '5010' and has a dimension of '2300' indicated below it. The middle vertical segment is labeled '5420' and has a dimension of '1500' indicated to its right. The top horizontal segment is labeled '5420' and has a dimension of '1500' indicated above it. The path is labeled 'SU' at both the bottom and top ends. A dashed line with arrows at both ends is drawn parallel to the middle vertical segment, with a dimension of '1500' indicated between the path and the dashed line. A small '50' is written near the top right corner of the path.

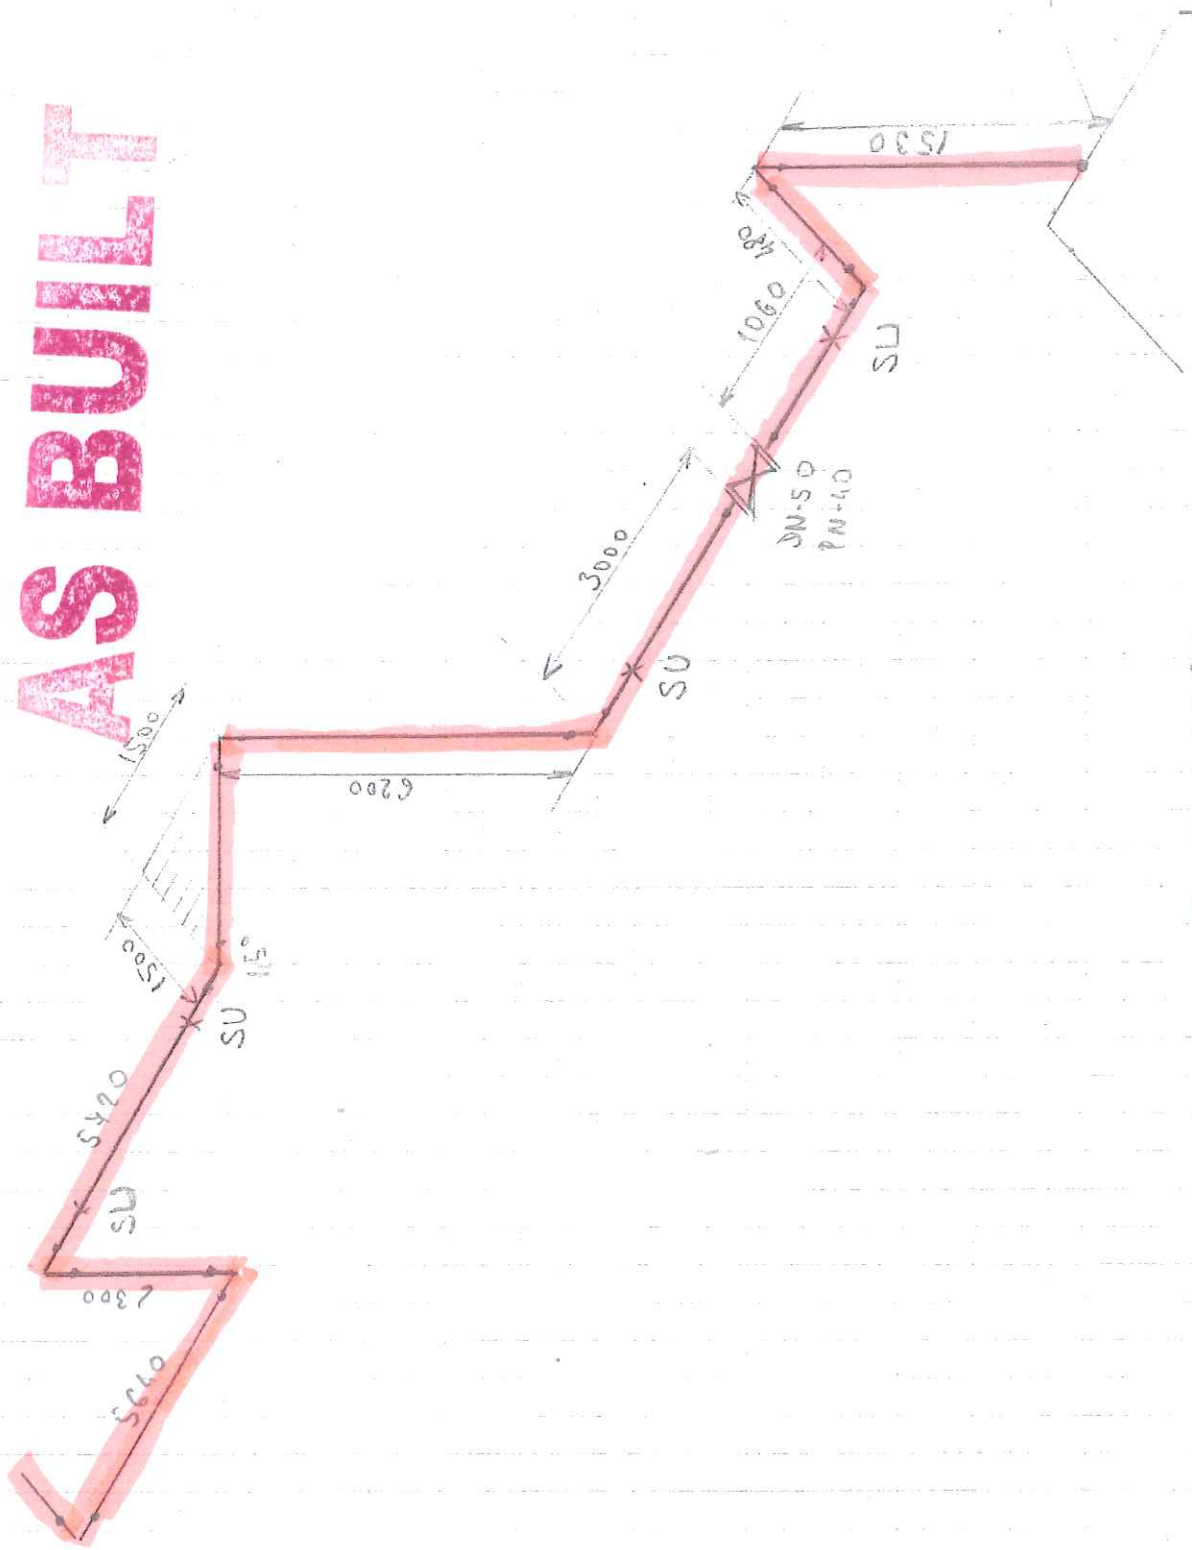

50 NL 73004

24

AS BUILT

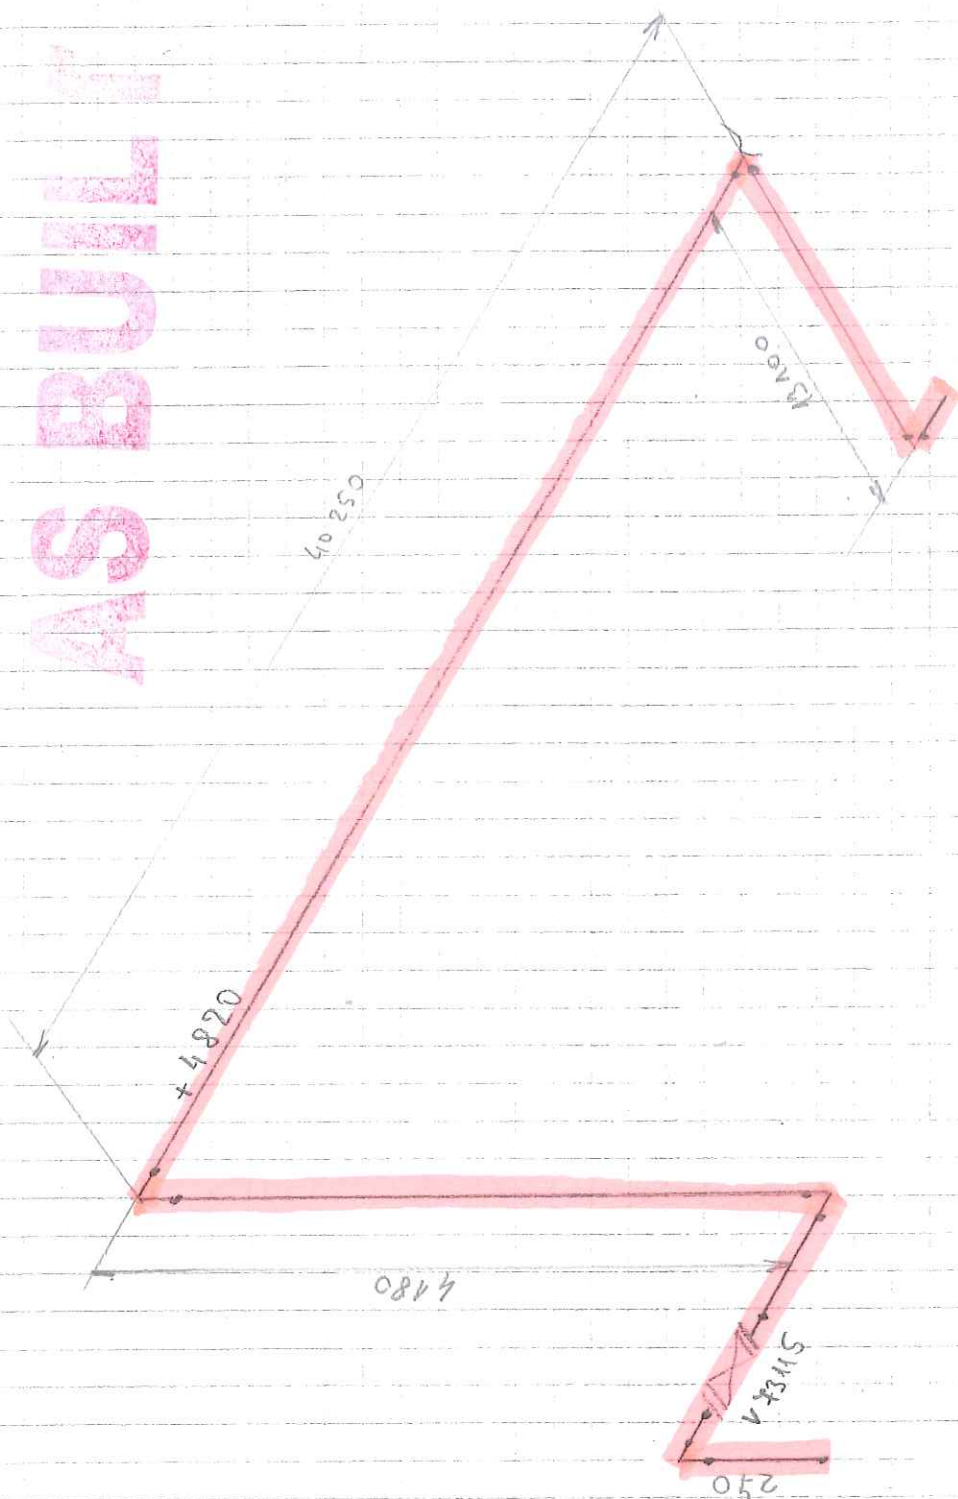

50 NL 73 00 Y  
Sheet 1

Dusík - 50 NL 73 007

izol. — Rock wool WM 105 ZINC HR: 80 mm

pozink. plech - HR: 0,8 mm

práca naviac

B-4300-1

BU 2




25 NL 43008

25 NL 73008

Izolácia - Rockwool WM-105 ZINC - Hr. - 60mm

Pozinkovaný plech - Hr. 0,8mm

This drawing is protected by copyright.  
It may not be copied or used without our written  
authorization and it is strictly prohibited  
to disclose it to any third parties.

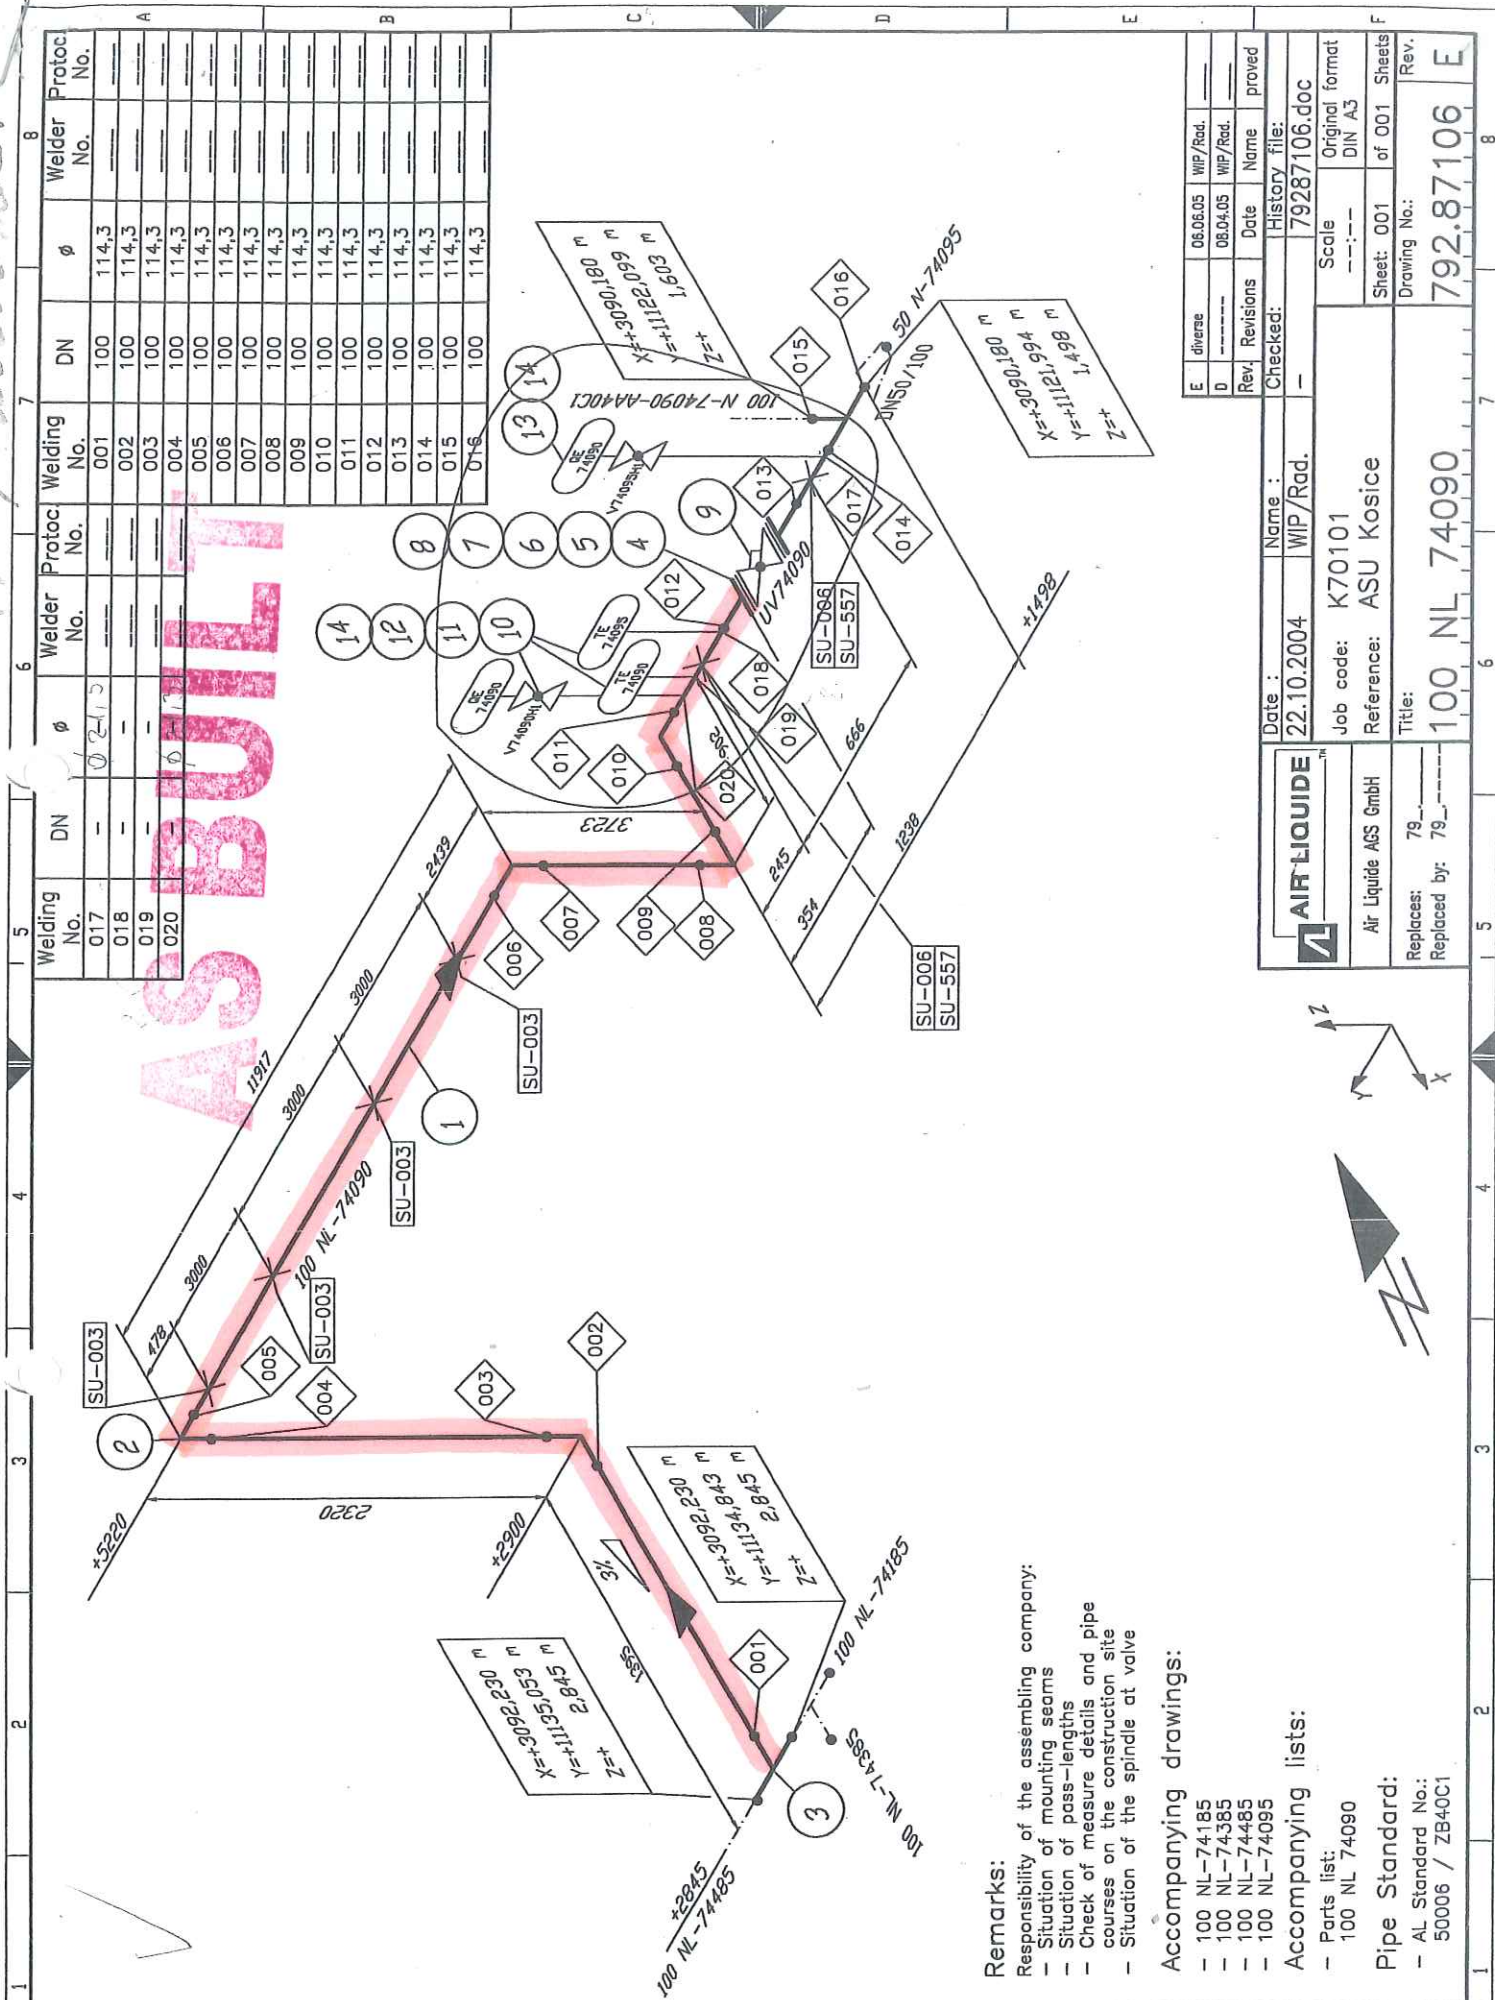

#### Remarks:

- Responsibility of the assembling company:
- Situation of mounting seams
- Situation of pass-lengths
- Check of measure details and pipe courses on the construction site
- Situation of the spindle at valve

#### Accompanying drawings:

- 100 NL-74185
- 100 NL-74385
- 100 NL-74485
- 100 NL-74095

#### Accompanying lists:

- Parts list:
- 100 NL 74090

#### Pipe Standard:

- AL Standard No.:
- 50006 / ZB40C1

|                       |  |                         |                 |                            |
|-----------------------|--|-------------------------|-----------------|----------------------------|
| <b>AIR LIQUIDE</b>    |  | Date : 22.10.2004       | Name : WIP/Rad. | History file: 79287106.doc |
| Job code: K70101      |  | Scale: ---:---          |                 |                            |
| Reference: ASU Kosice |  | Original format: DIN A3 |                 |                            |
| Title: 100 NL 74090   |  | Sheet: 001 of 001       |                 |                            |
| Replaces: 79          |  | Drawing No.: 792.87106  |                 |                            |
| Replaced by: 79       |  | Rev. E                  |                 |                            |

| E    | diversee  | 06.06.05 | WIP/Rad. |        |
|------|-----------|----------|----------|--------|
| D    |           | 08.04.05 | WIP/Rad. |        |
| Rev. | Revisions | Date     | Name     | proved |

Dusík 100 NL 74090


izol. Rockwool - WM 105 ZINC HR: 80mm

pozink. plech - HR 0,8mm

Nie je v zozname

This drawing is protected by copyright.  
It may not be copied or used without our written  
authorization and it is strictly prohibited  
to disclose it to any third parties.

ASBUL

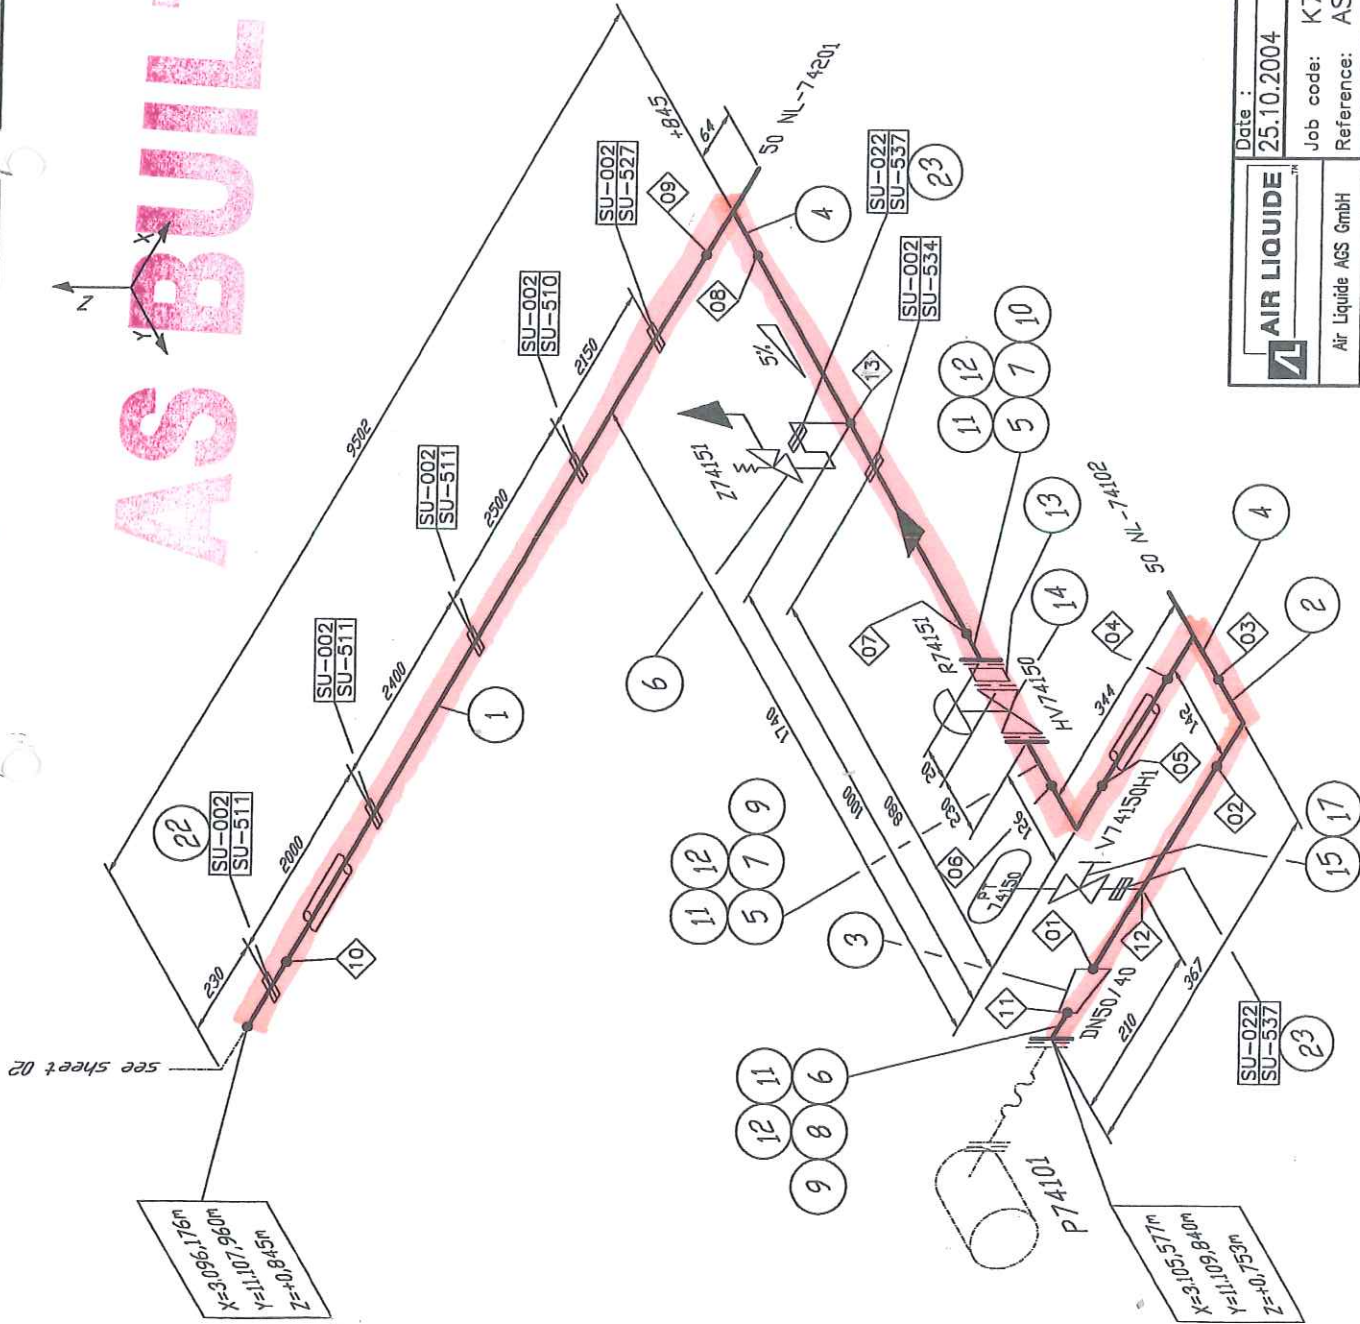

### Remarks:

Responsibility of the assembling company:

- Situation of mounting seams
- Situation of pass-lengths
- Check of measure details and pipe courses on the construction site
- Situation of the spindle at valve

### Accompanying drawings:

- 50 NL-74101 ZB40C1C Blatt 02
- 50 NL-74102 ZB40C1C
- 50 NL-74201 ZB40C1C

### Accompanying lists:

- Parts list:
- 50 NL-74101 ZB40C1C

### Pipe standard:



- AL Standard No.: 50006 (ZB40C1)

| Welding No. | DN | Diameter | Welder No. | Protocol No. |
|-------------|----|----------|------------|--------------|
| 01          | 50 | 60,3     |            |              |
| 02          | 50 | 60,3     |            |              |
| 03          | 50 | 60,3     |            |              |
| 04          | 50 | 60,3     |            |              |
| 05          | 50 | 60,3     |            |              |
| 06          | 50 | 60,3     |            |              |
| 07          | 50 | 60,3     |            |              |
| 08          | 50 | 60,3     |            |              |
| 09          | 50 | 60,3     |            |              |
| 10          | 50 | 60,3     |            |              |
| 11          | 40 | 48,3     |            |              |
| 12          |    | 21,3     |            |              |
| 13          |    | 22       |            |              |

|                       |  |                               |  |                            |  |
|-----------------------|--|-------------------------------|--|----------------------------|--|
| Date : 25.10.2004     |  | Name : Reid./IES              |  | History file: 79287106.doc |  |
| Job code: K70101      |  | Scale: Original format DIN A3 |  | Sheet: 001 of 003 Sheets   |  |
| Reference: ASU Kosice |  | Title: 50 NL-74101            |  | Drawing No.: 792.87106 C   |  |
| Replaces: 79          |  | Replaced by: 79               |  | Rev.:                      |  |

| Rev. | Revisions     | Date     | Name   | proved |
|------|---------------|----------|--------|--------|
| C    | 07.06.05      | WIP/Red. |        |        |
| B    | diff. Changes | 16.04.05 | Rb/IES | Gans   |

This drawing is protected by copyright.  
It may not be copied or used without our written  
authorization and it is strictly prohibited  
to disclose it to any third parties.

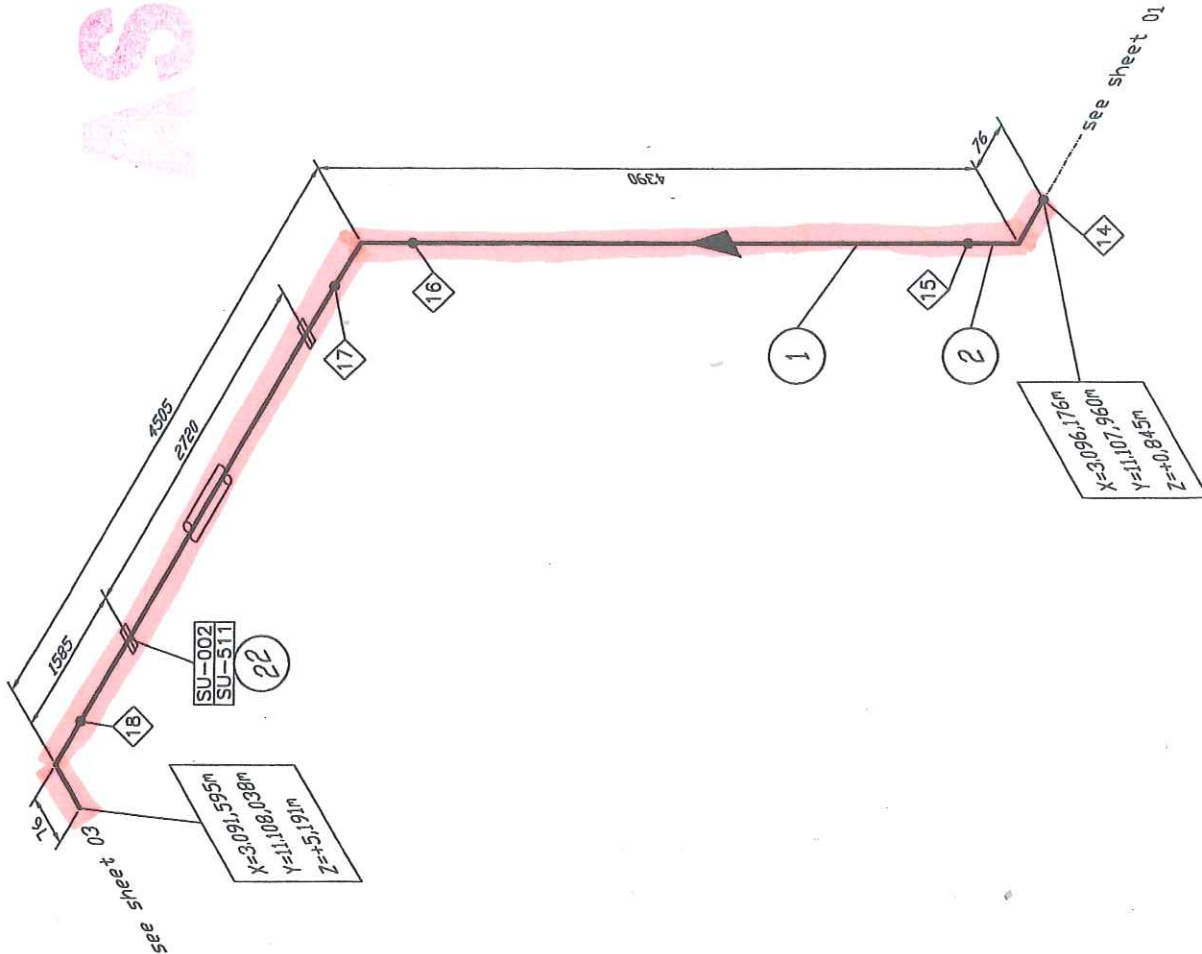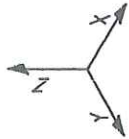

| Welding No. | DN | Diameter | Welder No. | Protocol No. |
|-------------|----|----------|------------|--------------|
| 14          | 50 | 60,3     |            |              |
| 15          | 50 | 60,3     |            |              |
| 16          | 50 | 60,3     |            |              |
| 17          | 50 | 60,3     |            |              |
| 18          | 50 | 60,3     |            |              |

#### Remarks:

Responsibility of the assembling company:

- Situation of mounting seams
- Situation of pass-lengths
- Check of measure details and pipe courses on the construction site
- Situation of the spindle at valve

#### Accompanying drawings:

- 50 NL-74101 ZB40C1C Blatt 01
- 50 NL-74101 ZB40C1C Blatt 03

#### Accompanying lists:

- Parts list:  
50 NL-74101 ZB40C1C

#### Pipe standard:

- AL Standard No.:  
50006 (ZB40C1)



AIR LIQUIDE

Air Liquide AGS GmbH

Replaces: 79\_

Replaced by: 79\_

Date : 25.10.2004

Name : Reid./IES

Job code: K70101

Reference: ASU Kosice

Title: 50 NL-74101

Checked: Hr. Gans

Scale: Original format

Sheet: 002 of 003

Drawing No.: 792.87106

History file: 79287106.doc

Revisions

Date

Name

proved

07.06.05

WIP/Rad.

16.04.05

Rb/IES

Gans


792.87106

C

This drawing is protected by copyright.  
It may not be copied or used without our written  
authorization and it is strictly prohibited  
to disclose it to any third parties.

150  
135  
120  
105  
90  
75  
60  
45  
30  
15  
5

| Welding<br>No. | DN | ø    | Weider<br>No. | Protoc<br>No. |
|----------------|----|------|---------------|---------------|
| 001            | 50 | 60,3 |               |               |
| 002            | 50 | 60,3 |               |               |
| 003            | 50 | 60,3 |               |               |
| 004            | 50 | 60,3 |               |               |
| 005            | 50 | 60,3 |               |               |
| 006            | 50 | 60,3 |               |               |
| 007            | 50 | 60,3 |               |               |
| 008            | 50 | 60,3 |               |               |
| 009            | 50 | 60,3 |               |               |

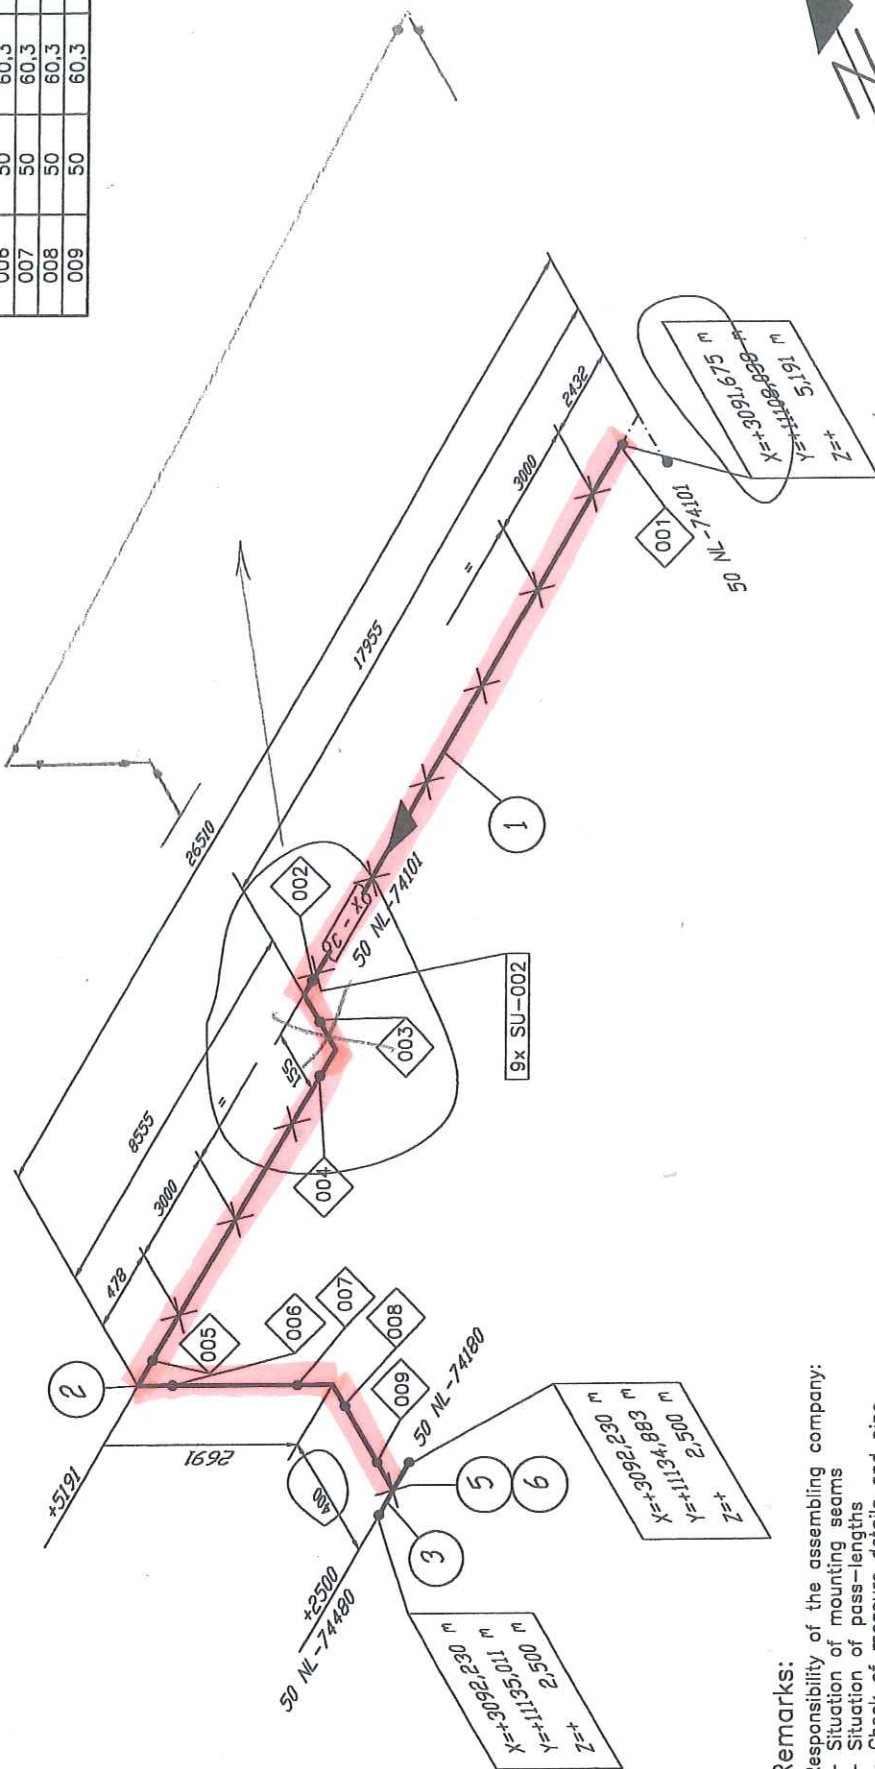

**Remarks:**  
Responsibility of the assembling company:  
- Situation of mounting seams  
- Situation of pass-lengths  
- Check of measure details and pipe  
courses on the construction site  
- Situation of the spindle at valve

**Accompanying drawings:**

- 50 NL-74180
- 50 NL-74480
- 50 NL-74101

**Accompanying lists:**


- Parts list:  
50 NL 74101

**Pipe Standard:**

- AL Standard No.:  
50006 / ZB40C1

|                      |  |              |             |            |                           |
|----------------------|--|--------------|-------------|------------|---------------------------|
| <b>AIR LIQUIDE</b>   |  | Date:        | 18.10.2004  | Name:      | WIP/Rad.                  |
| Air Liquide AGS GmbH |  | Job code:    | K70101      | Checked:   | 79287106.doc              |
| Replaces: 79         |  | Reference:   | ASU Kosice  | Scale      | Original format<br>DIN A3 |
| Replaced by: 79      |  | Title:       | 50 NL 74101 | Sheet: 003 | of 003 Sheets             |
|                      |  | Drawing No.: | 792.87106   | Rev.       | C                         |

| Rev. | Revisions | Date     | Name     | proved |
|------|-----------|----------|----------|--------|
| C    | diverse   | 07.06.05 | WIP/Rad. |        |
| A    |           | 17.12.04 | WIP/Rad. |        |

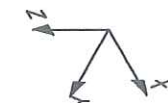

Dusik - 50 NL 74 101

izol. Rockwool - WM 105 ZINC HR: 80 mm  
pozink plech - HR 0,8 mm

01 AT  
B 42001

123456789

1050

650

360

650

91

91

50 NL 74-102


Dnsik 50 NL 74 102

izol.  Rockwool WM 105 ZINC HR: 80 mm

pozink. plech - Hr. 0,8 mm

This drawing is protected by copyright.  
It may not be copied or used without our written  
authorization and it is strictly prohibited  
to disclose it to any third parties.

AS BUILT

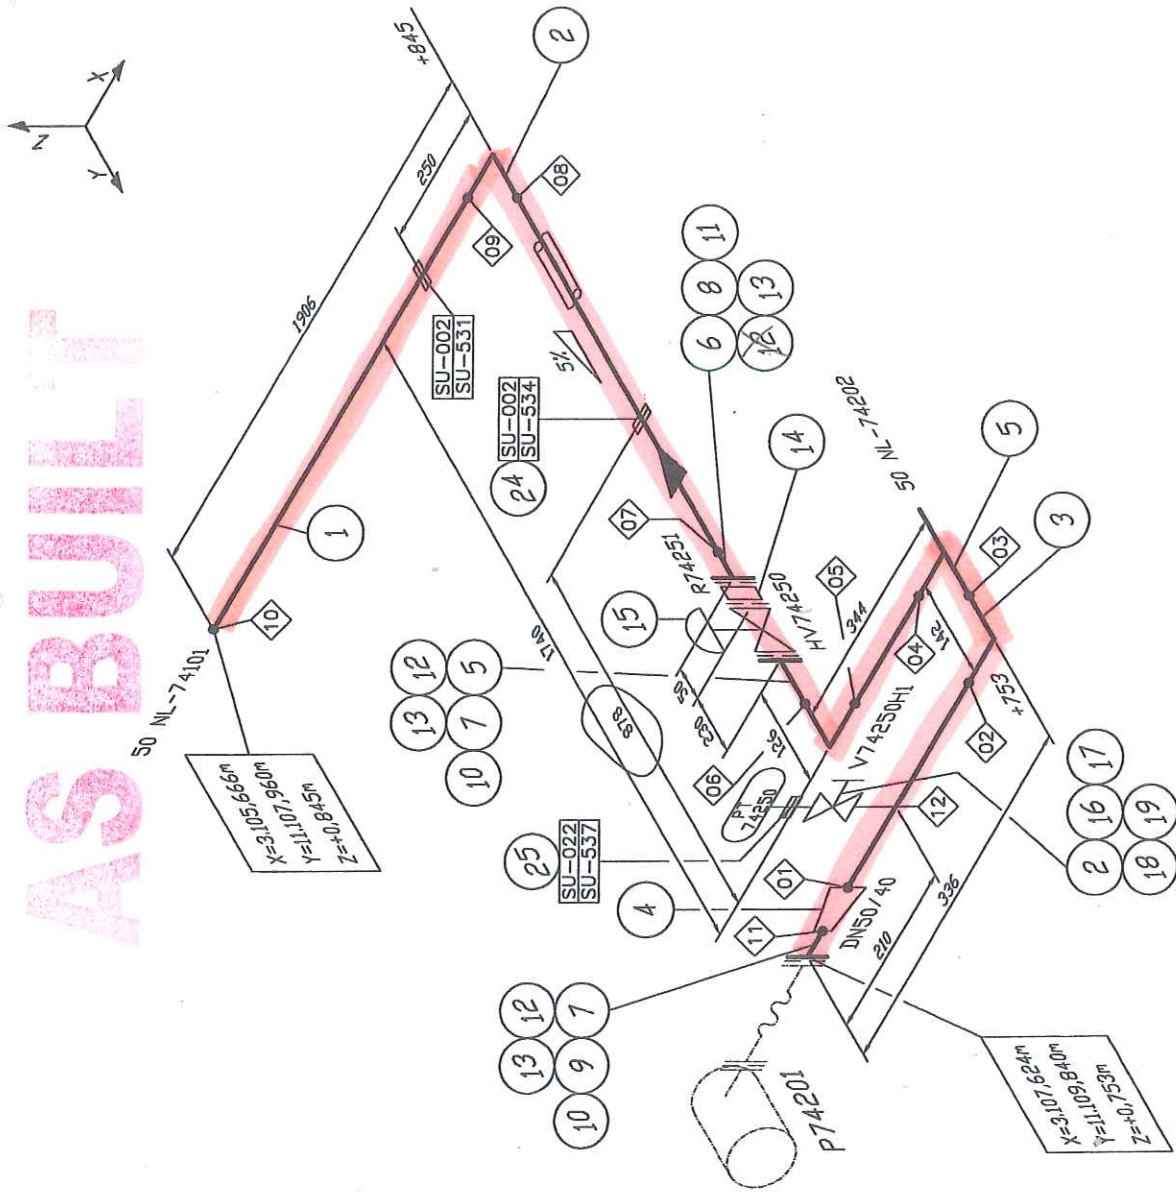

| Welding No. | DN   | Diameter | Welder No. | Protocol No. |
|-------------|------|----------|------------|--------------|
| 01          | 50   | 60,3     |            |              |
| 02          | 50   | 60,3     |            |              |
| 03          | 50   | 60,3     |            |              |
| 04          | 50   | 60,3     |            |              |
| 05          | 50   | 60,3     |            |              |
| 06          | 50   | 60,3     |            |              |
| 07          | 50   | 60,3     |            |              |
| 08          | 50   | 60,3     |            |              |
| 09          | 50   | 60,3     |            |              |
| 10          | 50   | 60,3     |            |              |
| 11          | 40   | 48,3     |            |              |
| 12          | 21,3 |          |            |              |

#### Remarks:

- Responsibility of the assembling company:
- Situation of mounting seams
  - Situation of pass-lengths
  - Check of measure details and pipe courses on the construction site
  - Situation of the spindle at valve

#### Accompanying drawings:

- 50 NL-74101 ZB40C1C
- 50 NL-74202 ZB40C1C

#### Accompanying lists:

- Parts list:
- 50 NL-74201 ZB40C1C

#### Pipe standard:

- AL Standard No.: 50006 (ZB40C1)

|                                   |                       |
|-----------------------------------|-----------------------|
| <b>AIR LIQUIDE</b>                |                       |
| Job code: K70101                  | Reference: ASU Kosice |
| Replaces: 79-<br>Replaced by: 79- |                       |

|                          |                            |
|--------------------------|----------------------------|
| Date: 25.10.2004         | Name: Reid./IES            |
| Checked: Hr. Gans        | History file: 79287106.doc |
| Scale: ---:---           | Original format: DIN A3    |
| Sheet: 001               | of 001 Sheets              |
| Drawing No.: 50 NL-74201 | Rev. 792.87106 B           |

| B    | diverse       | 07.06.05 | W/P /Rad. |        |
|------|---------------|----------|-----------|--------|
| A    | diff. Changes | 18.01.05 | Rb/IES    | Gans   |
| Rev. | Revisions     | Date     | Name      | proved |

Dusík - NL 74 201

izol. Rockwool - WM 105 ZINC HR: 80 mm  
pozink. plech - HR - 0,8 mm

[illegible]

50749203

Dusík - 50 NL 74202

- 50 NL 79203 - Nie je v zozname

izol. Rockwool - WM 105 ZINC HR- 80 mm  
pozink. plech - HR 0,8 mm