
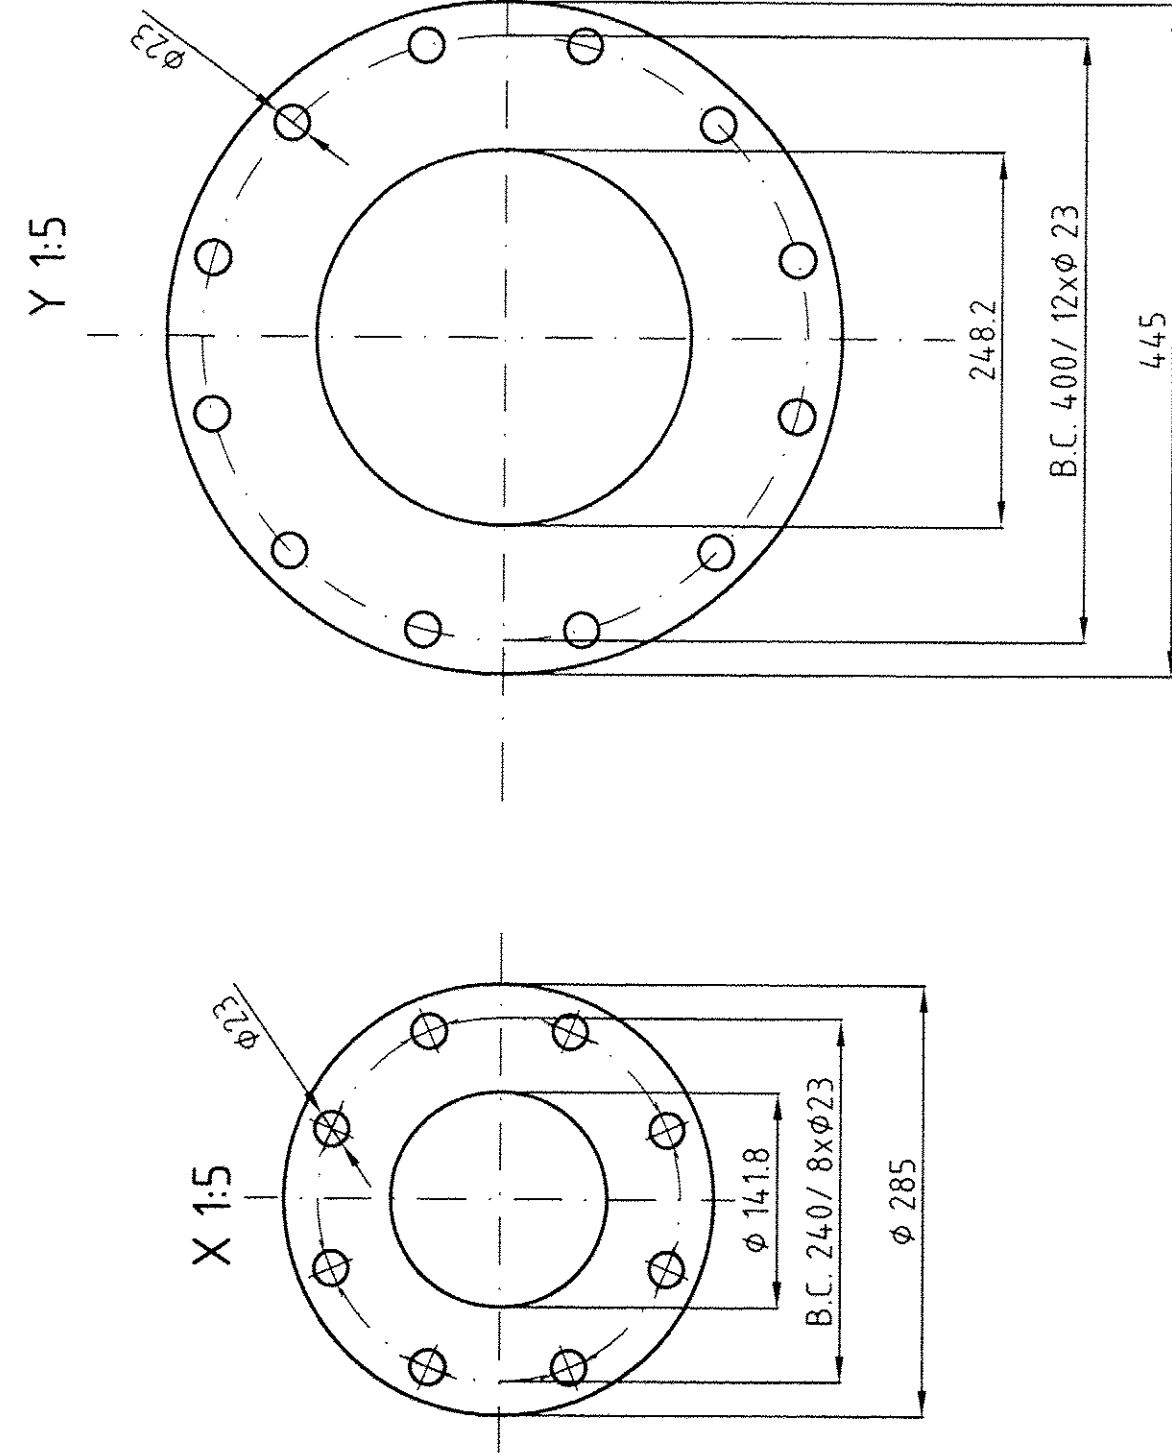
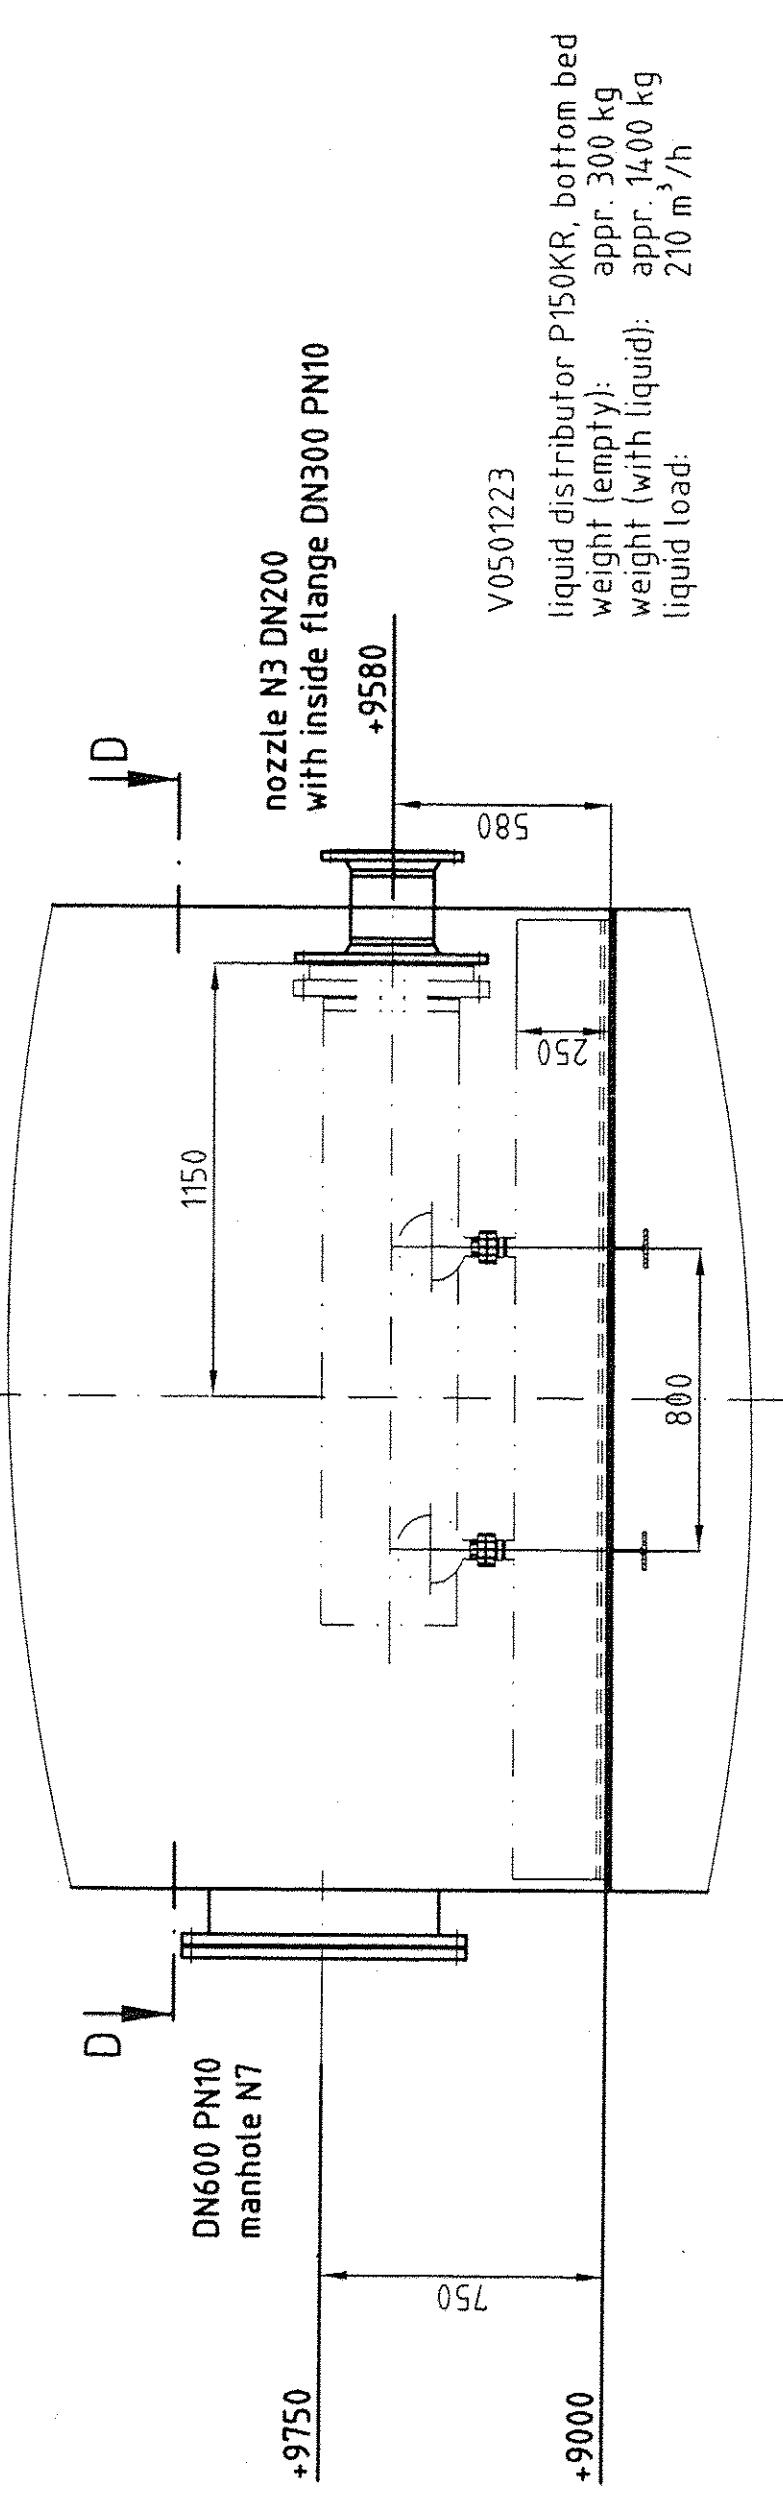
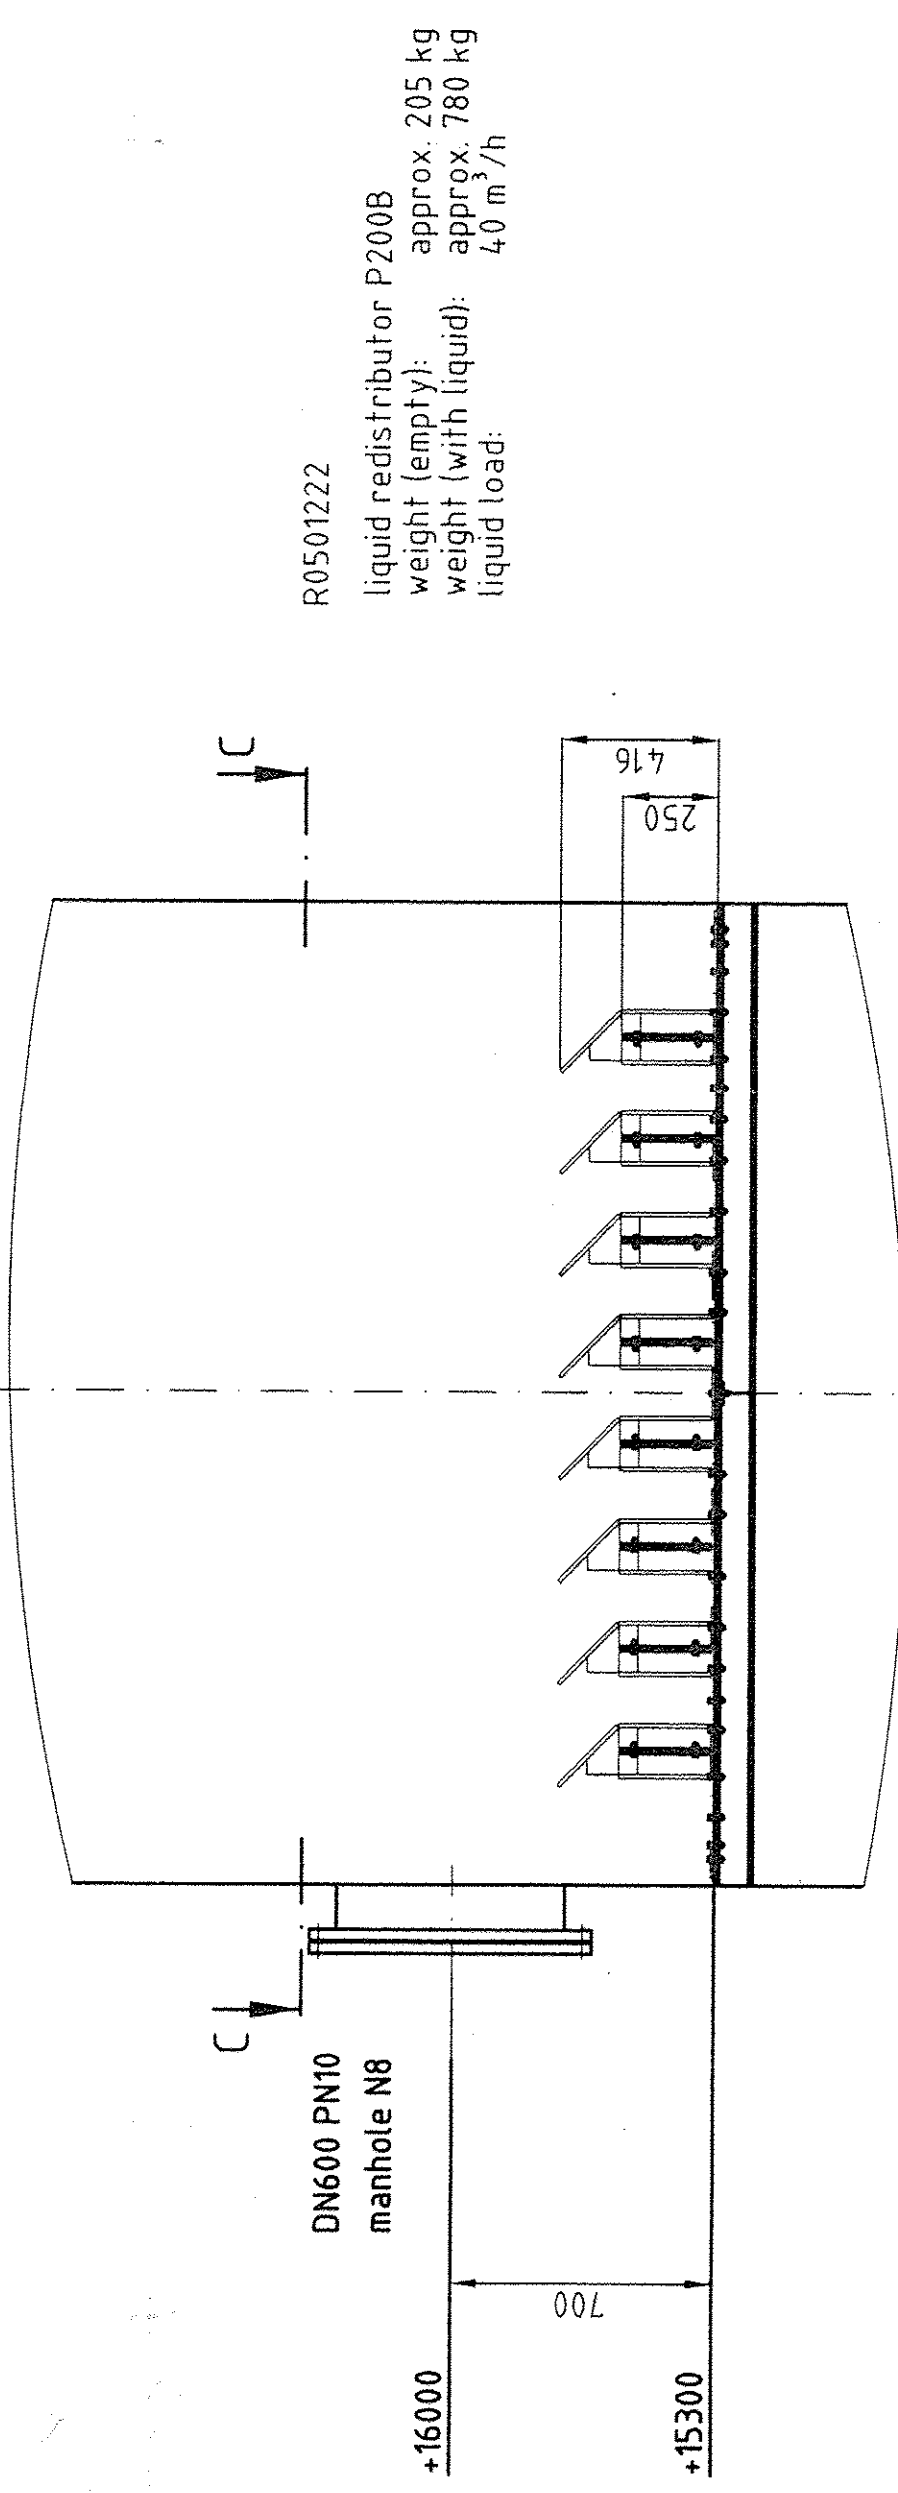
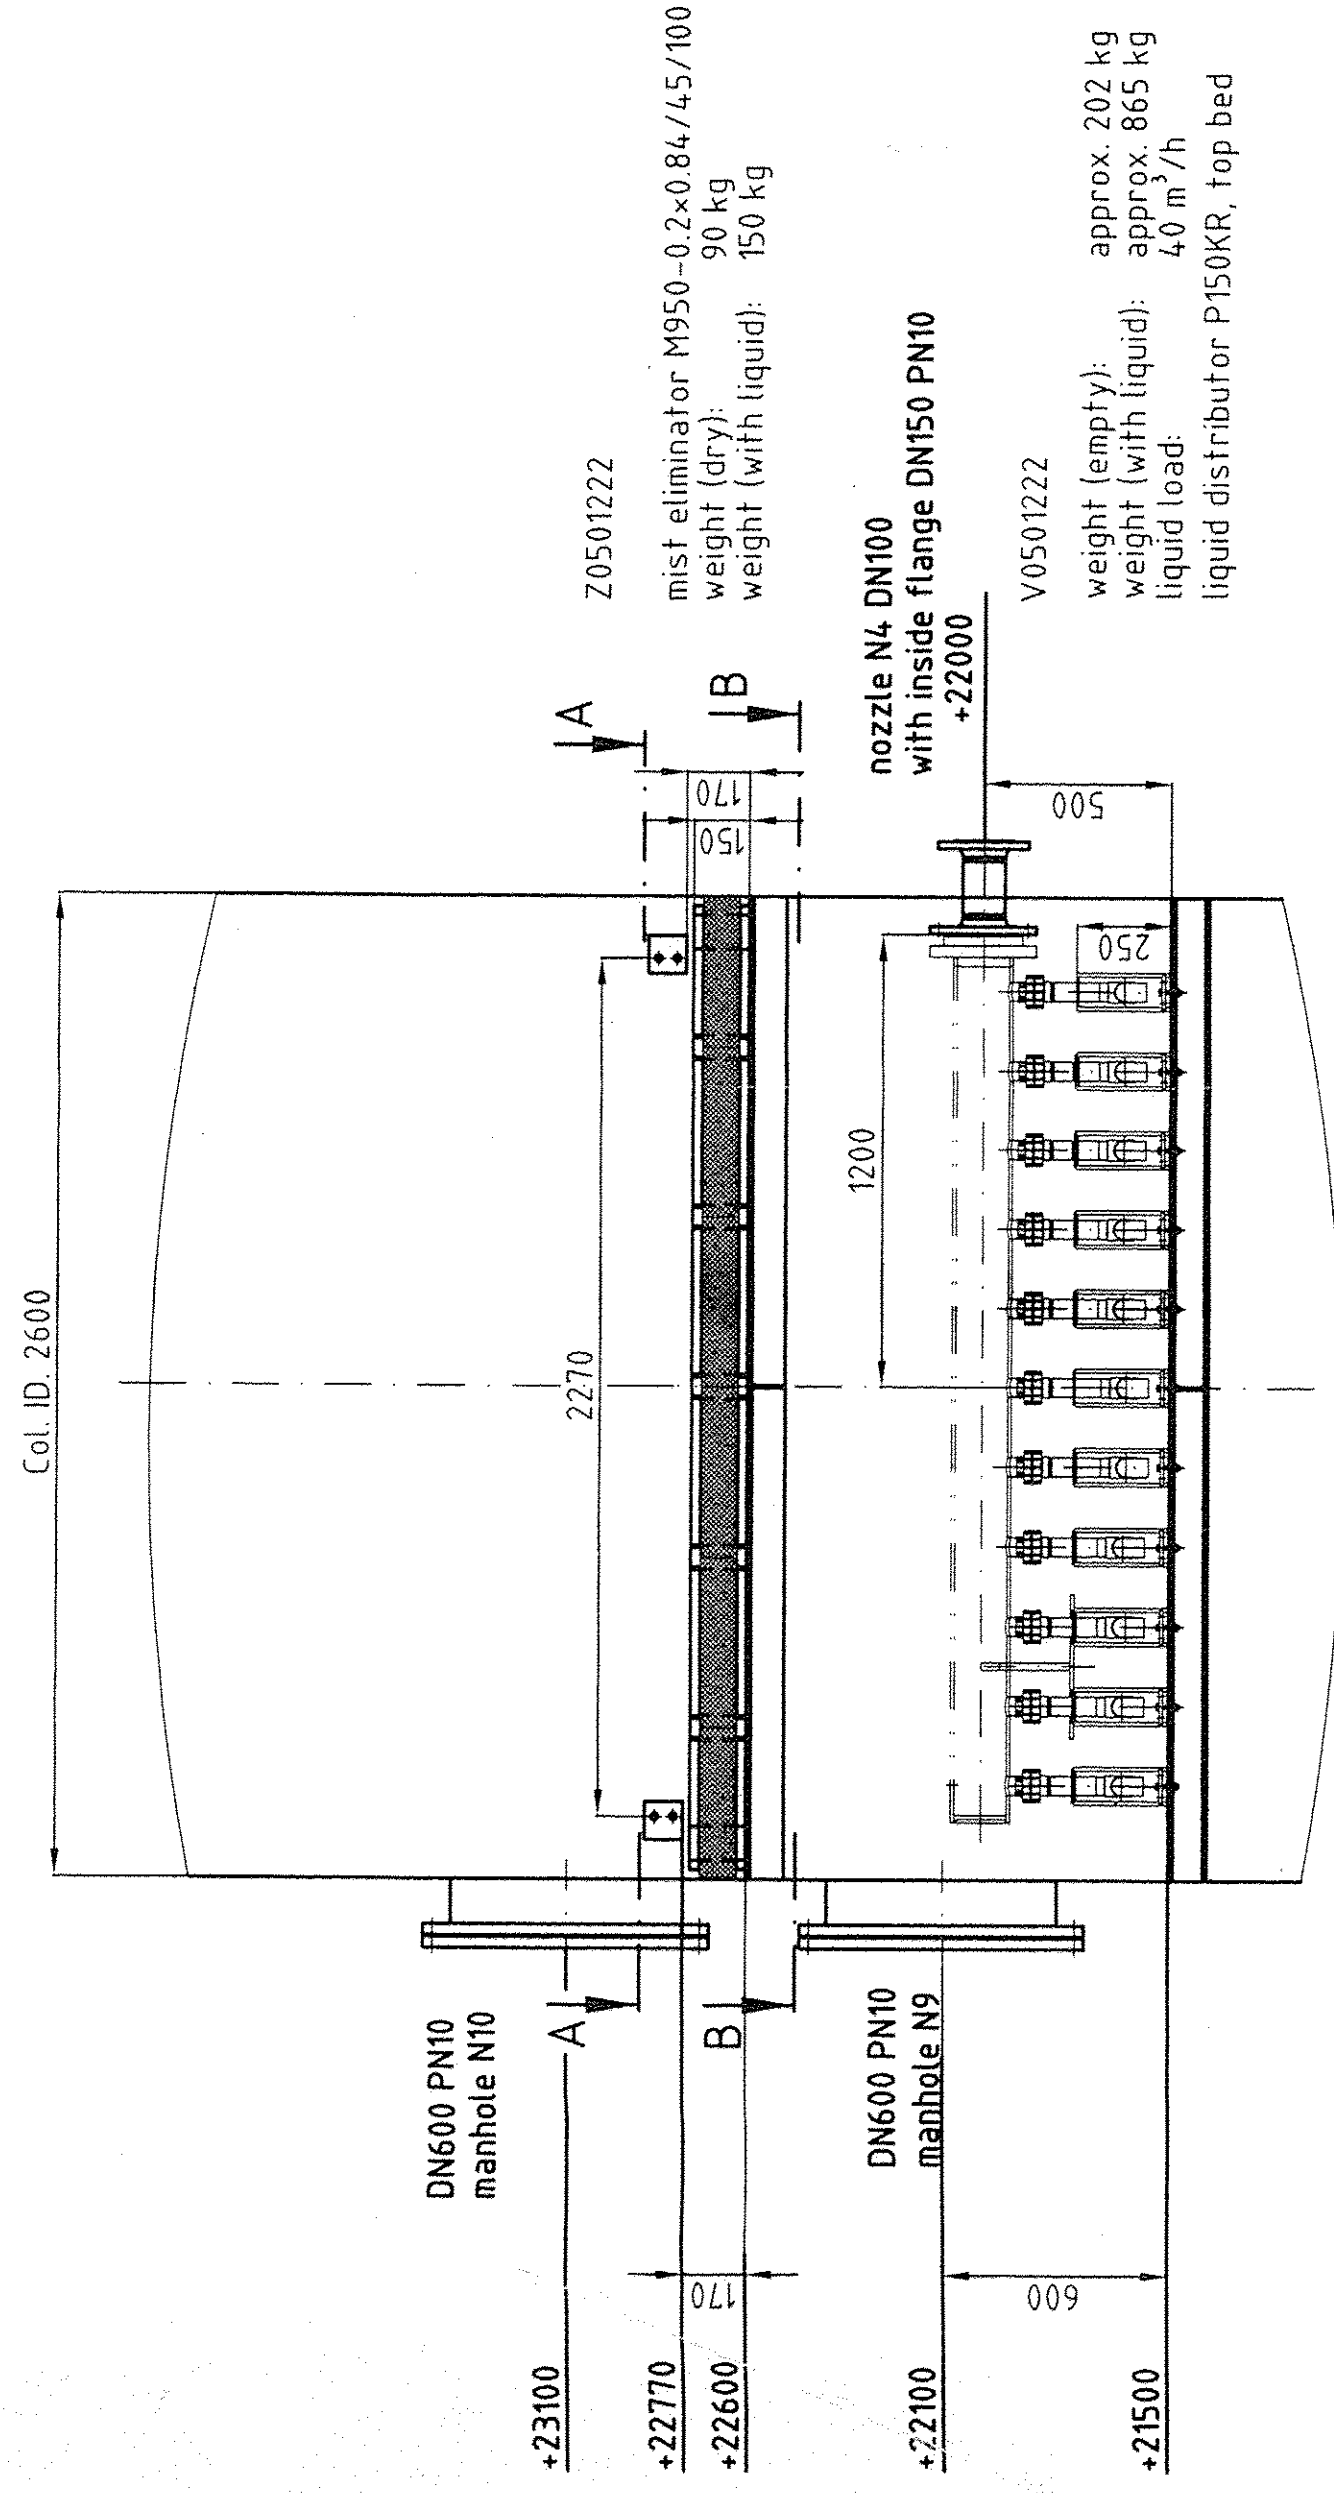
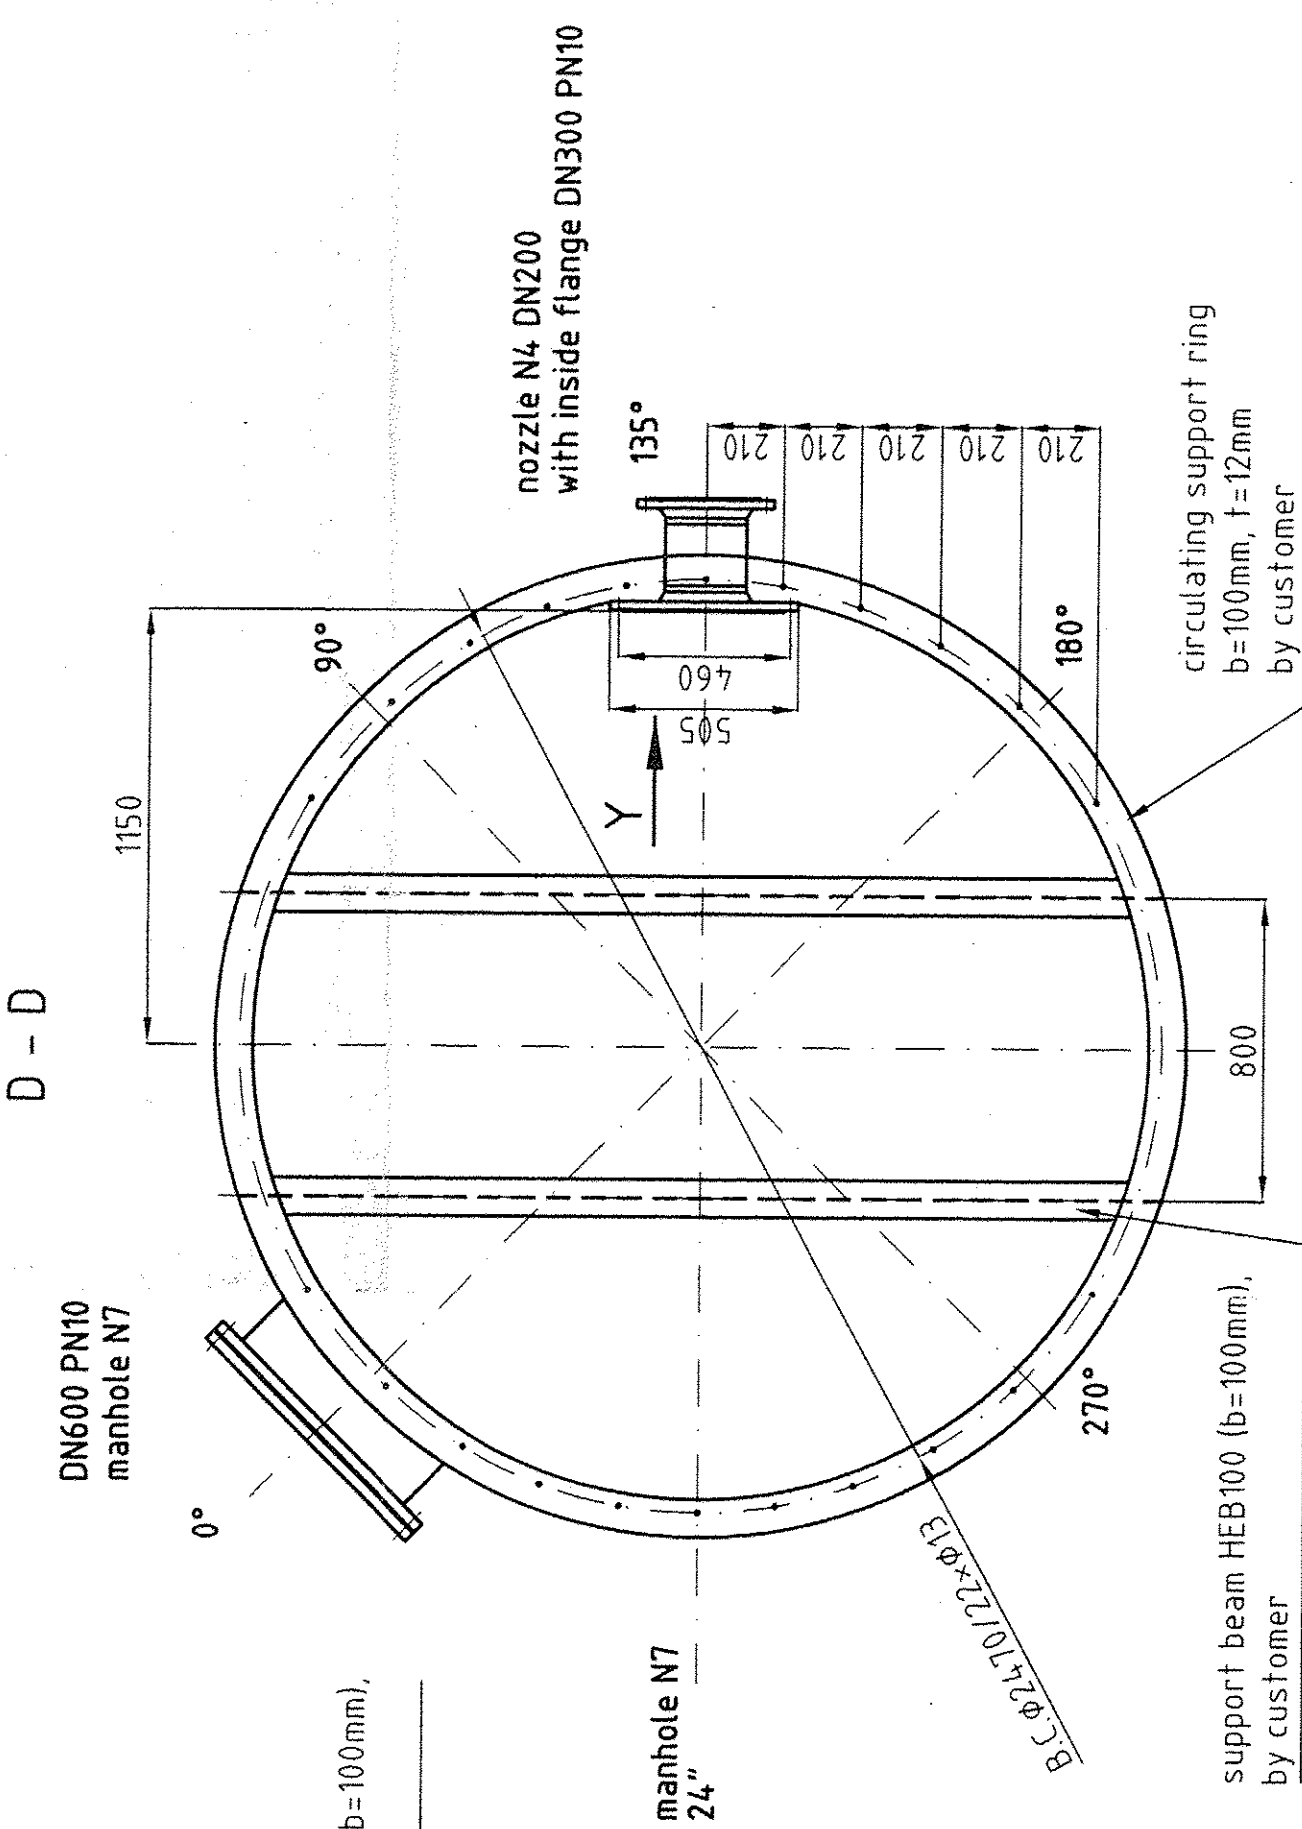
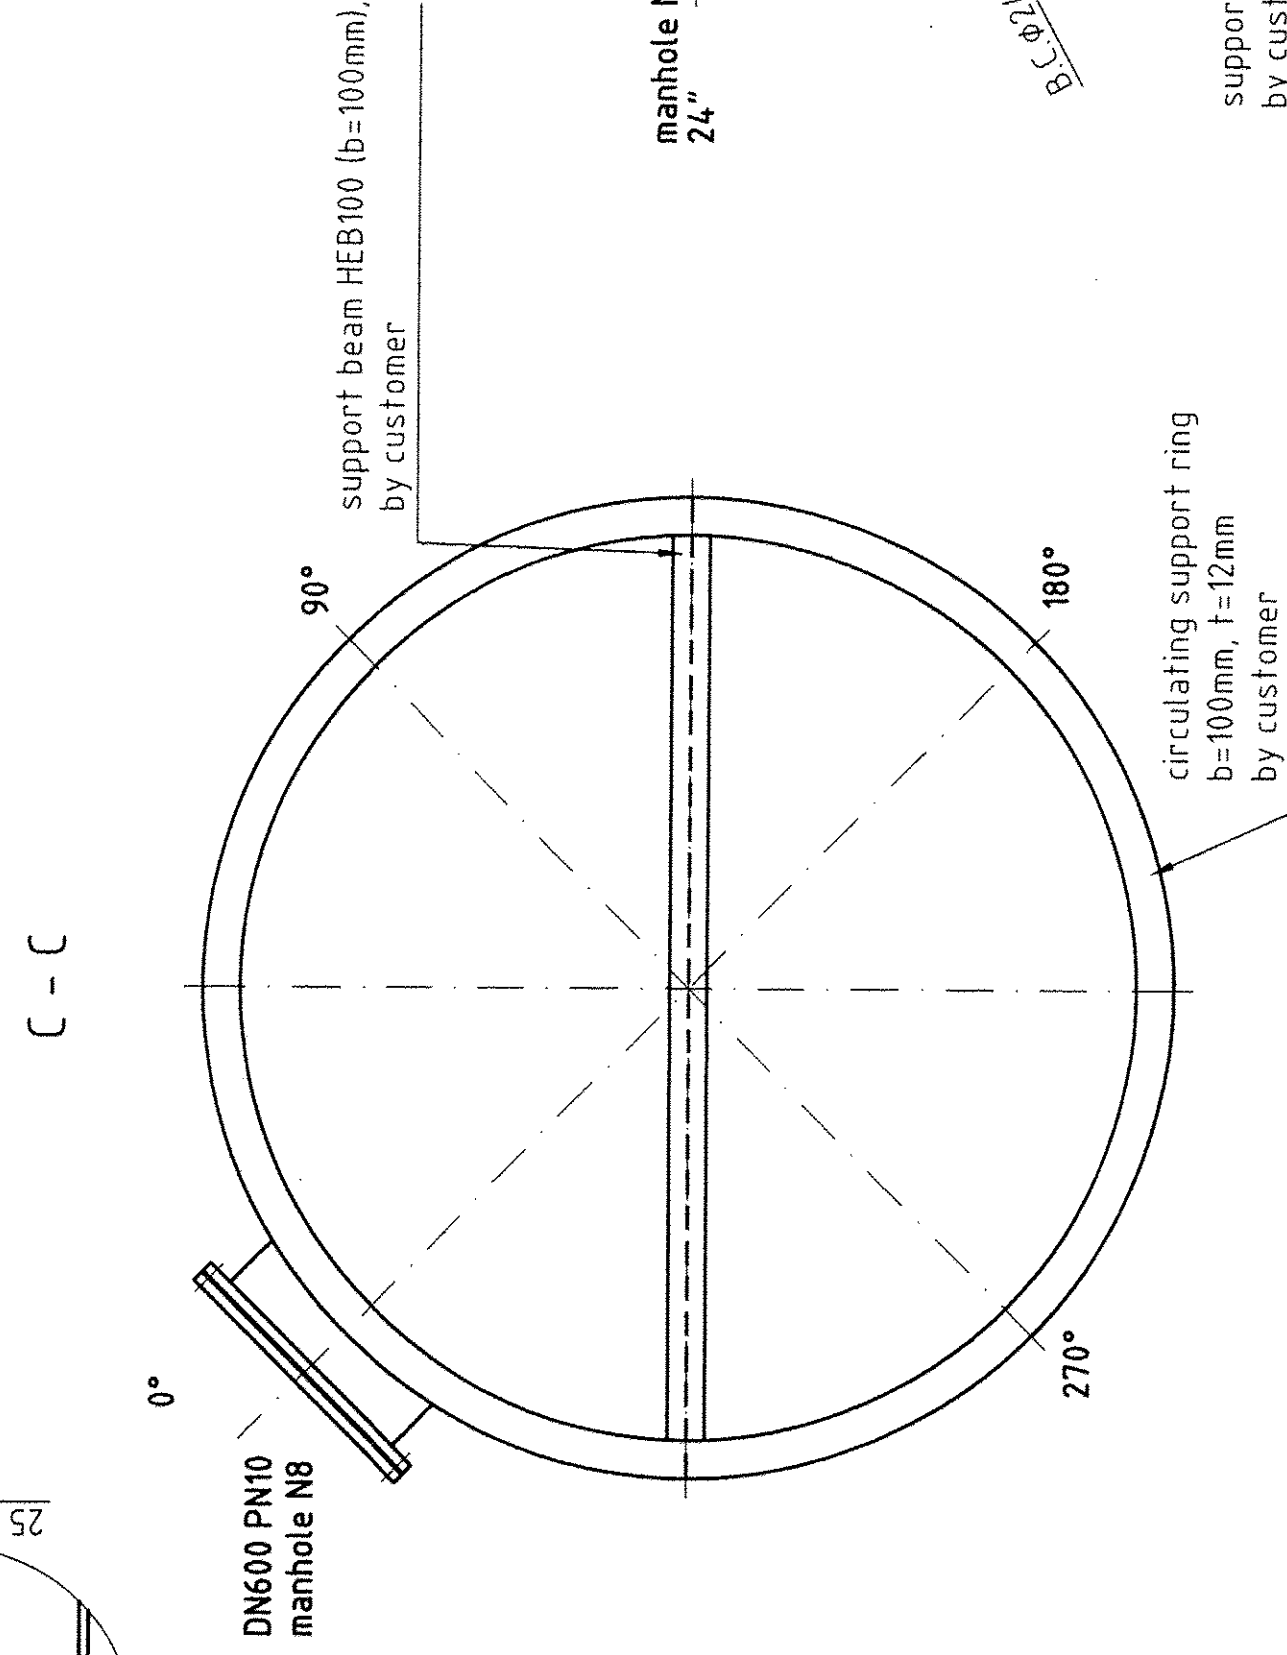
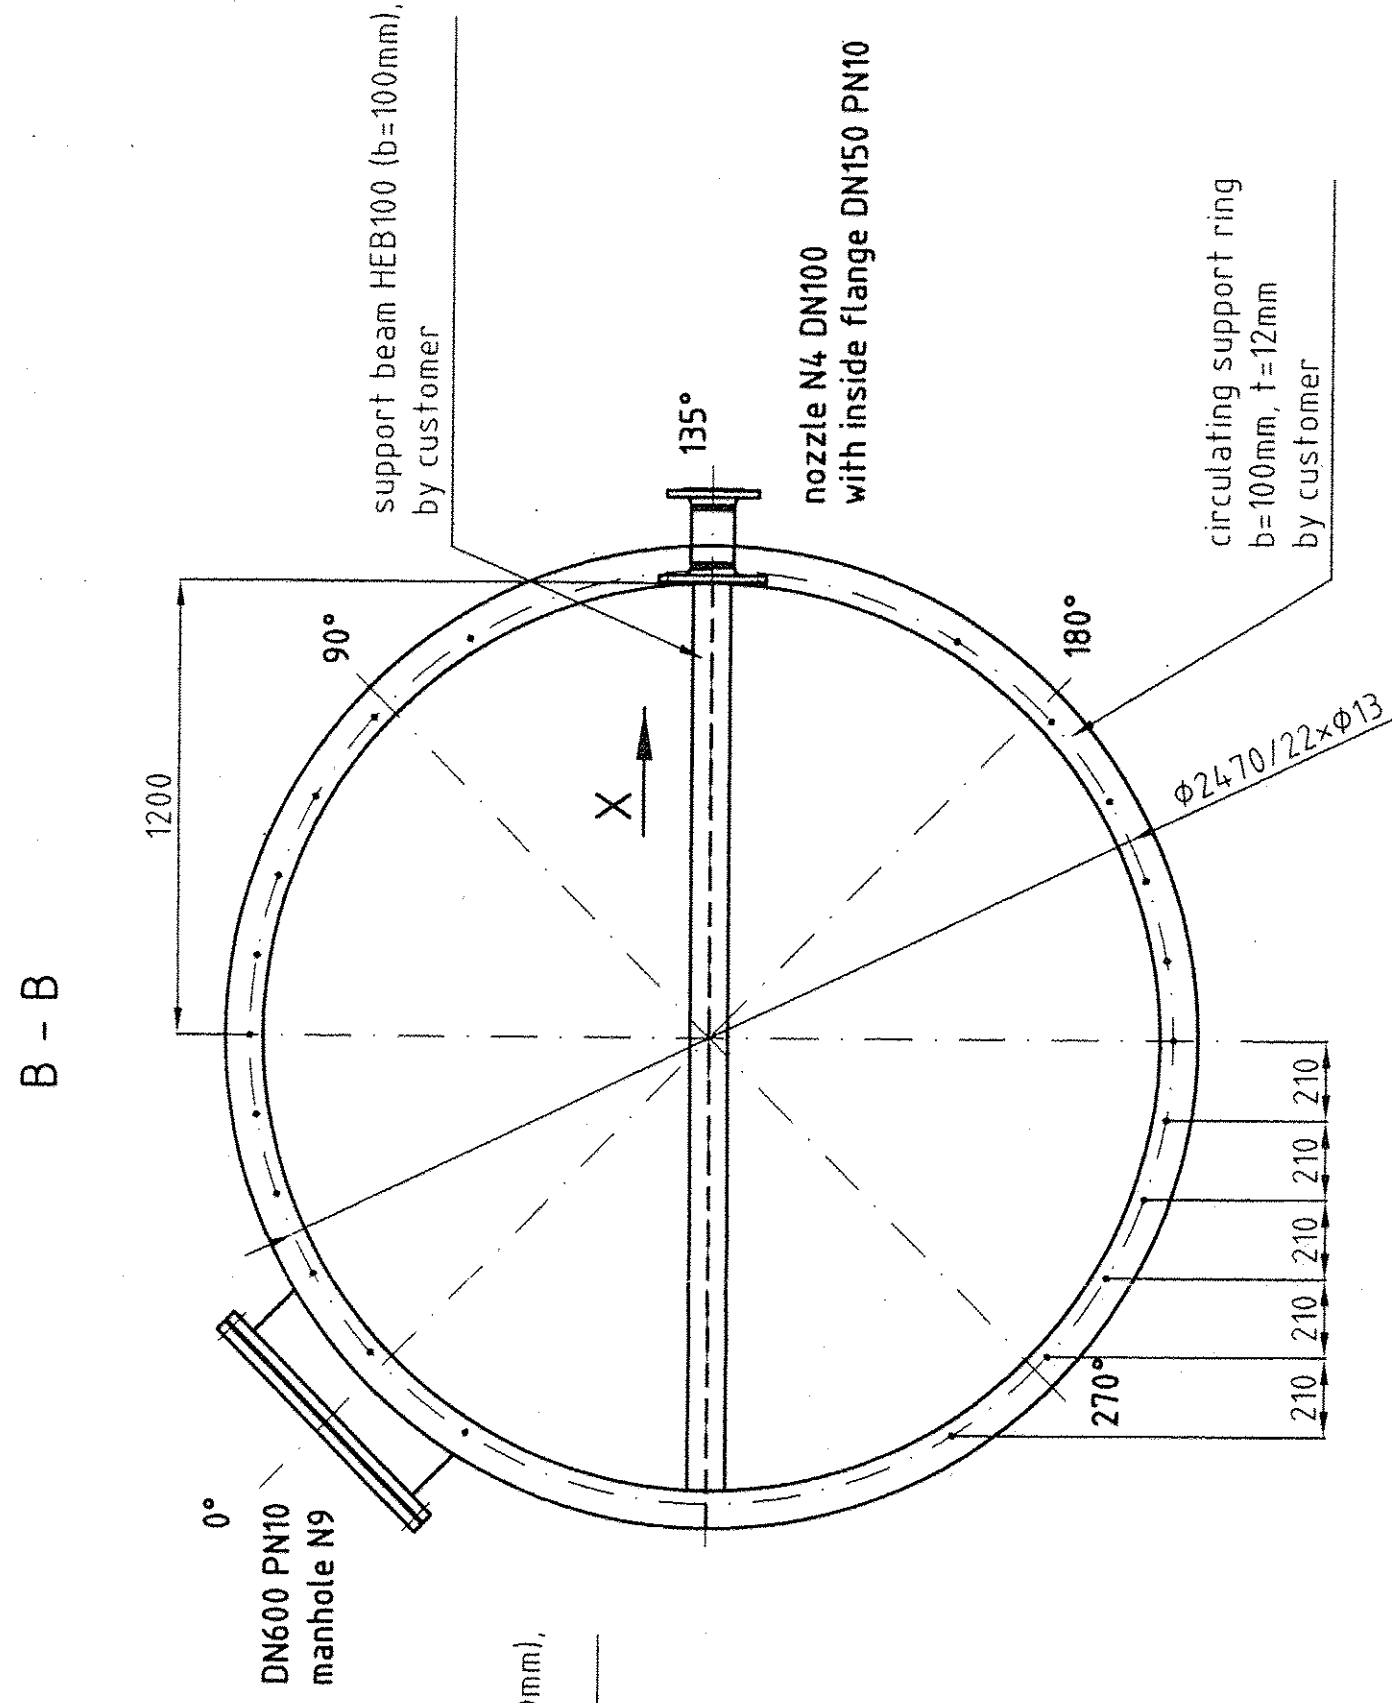


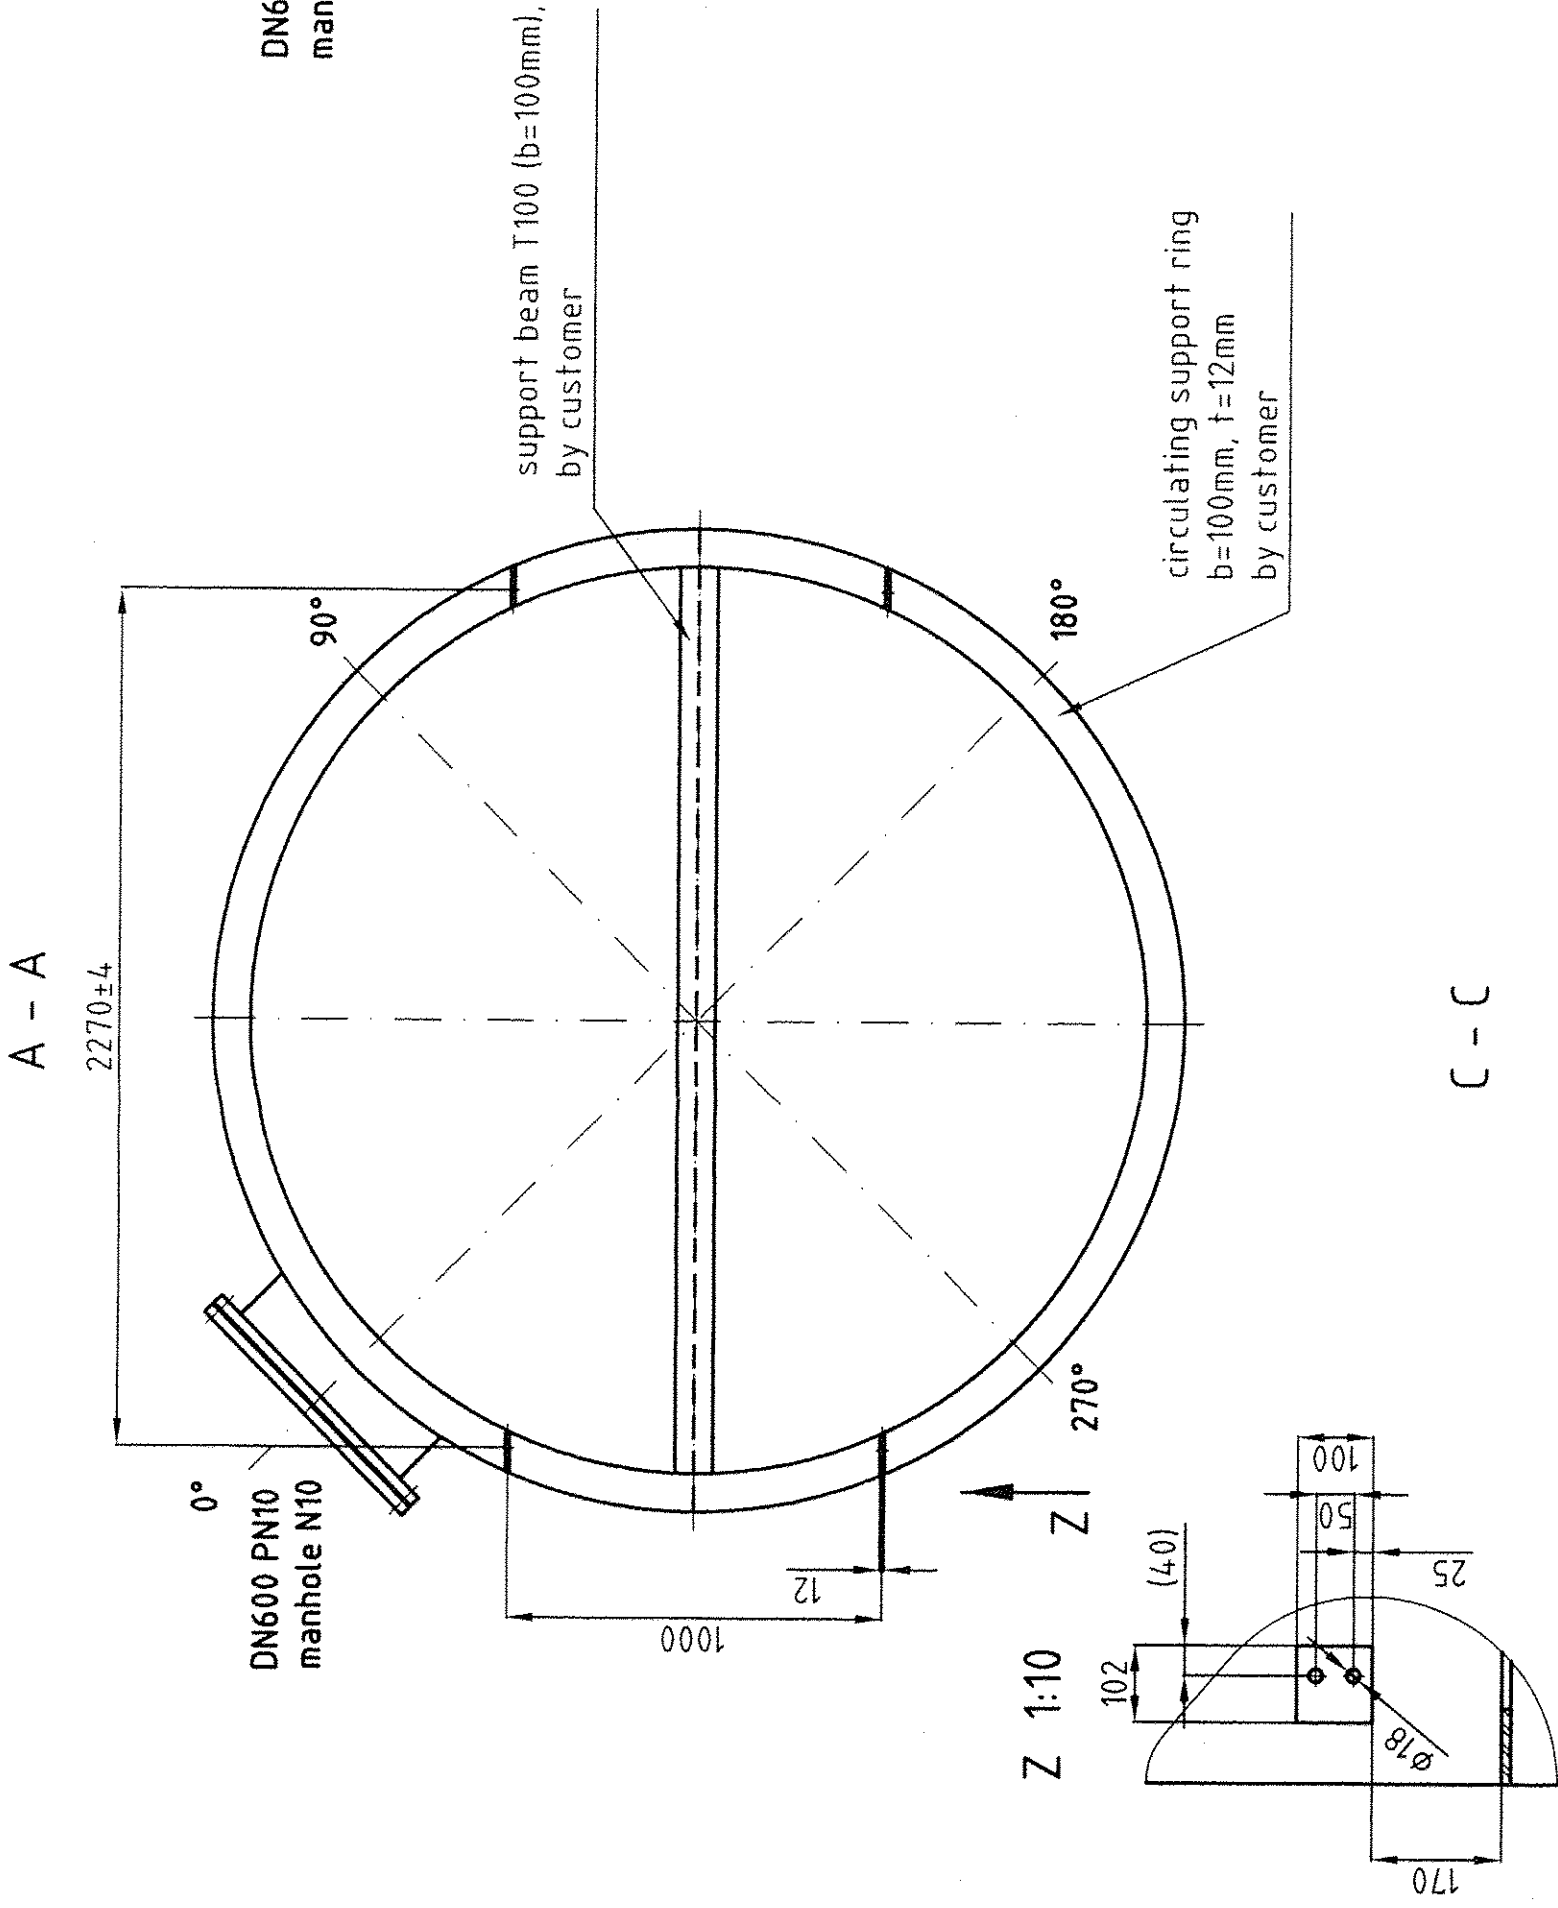

customer: Air Liquide project: ASU Kosice
order no: 4500024509 position: DCAC
RVT-order no.: 30872

rev.	date	name	description	approved	date
02	19.07.2005	F. Prell	as built - no changes		
01	08.02.2005	U. Napierala	Flangeanschluss N4, N4		
00	22.01.2005	U. Napierala	first issue		

material	weight	piece	unit
sheet	A1	scale	1:20
drawing issue			
as built			

Rauscher
Paul-Rauscher-Str. 6 · 96349 Steinwiesen
Technisches Büro im Gies II · 96344 Marktleuthaus
Telefon +49 9267 6663-10 · Fax +49 9267 6663-19

Internals General Arrangement dia2600

tolerances acc.	copyright	drawing no.	Rev
DIN ISO 2768-c	DIN34	K0050222-02	02