
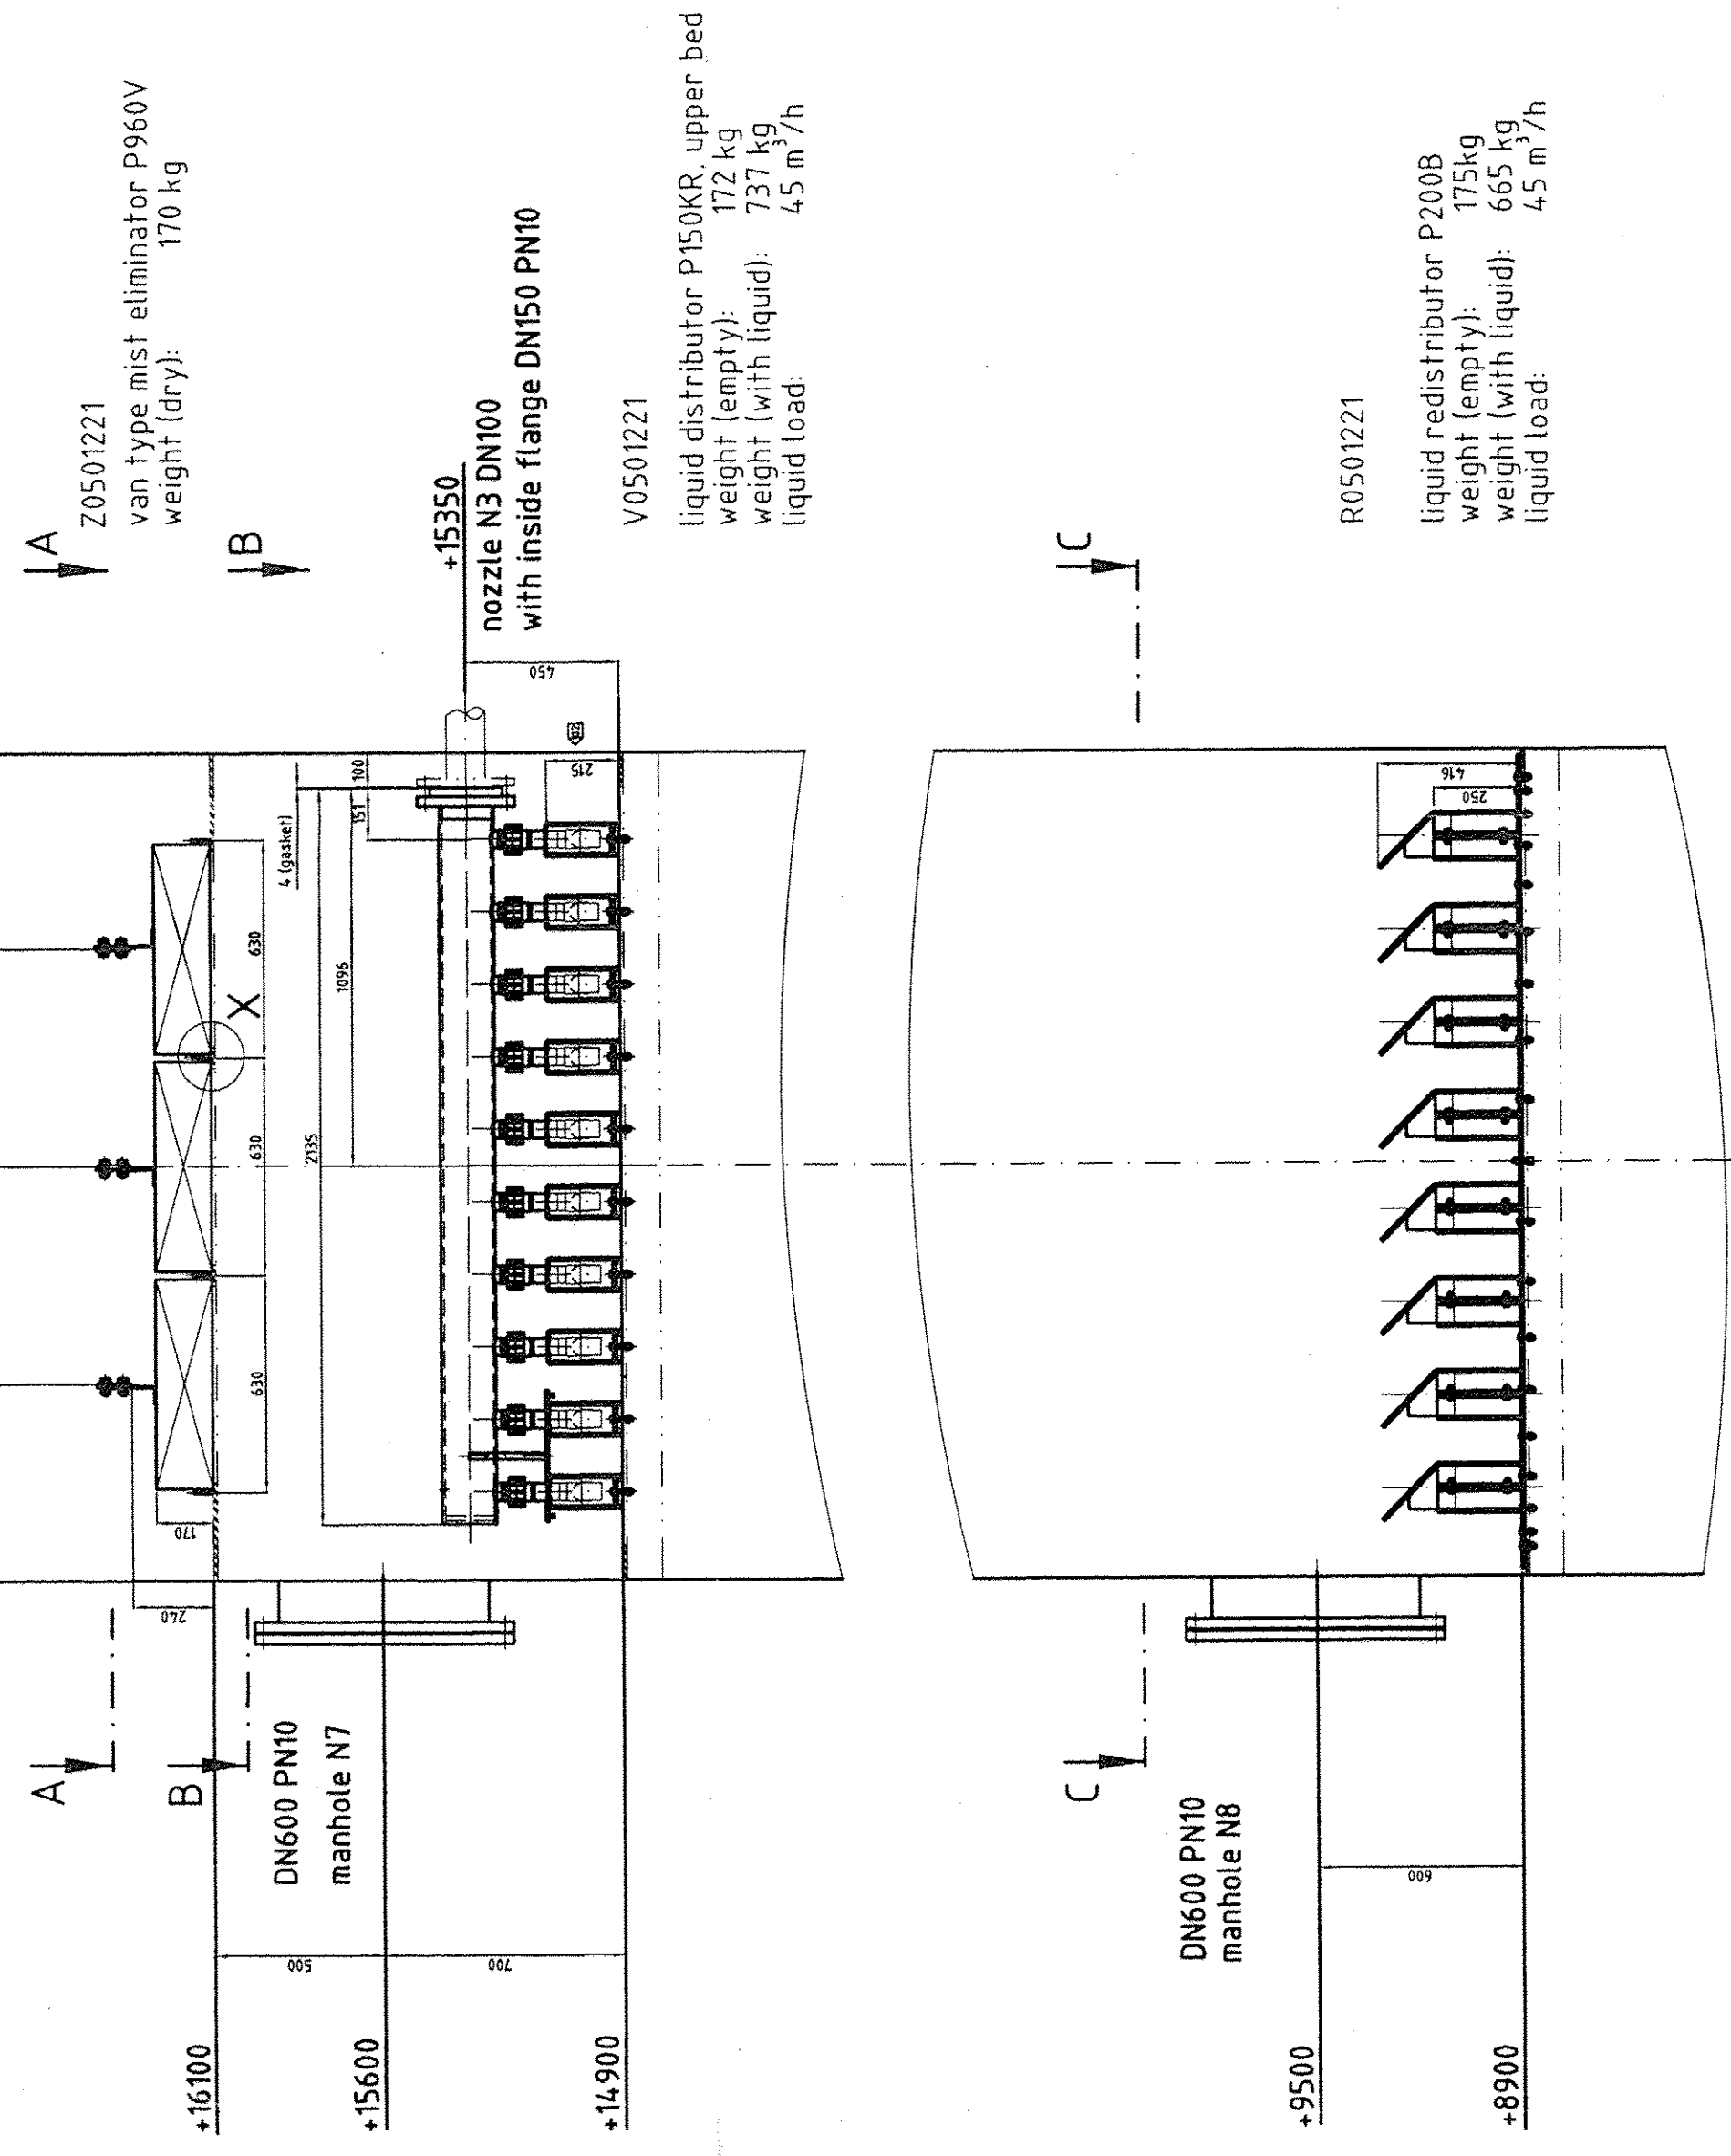
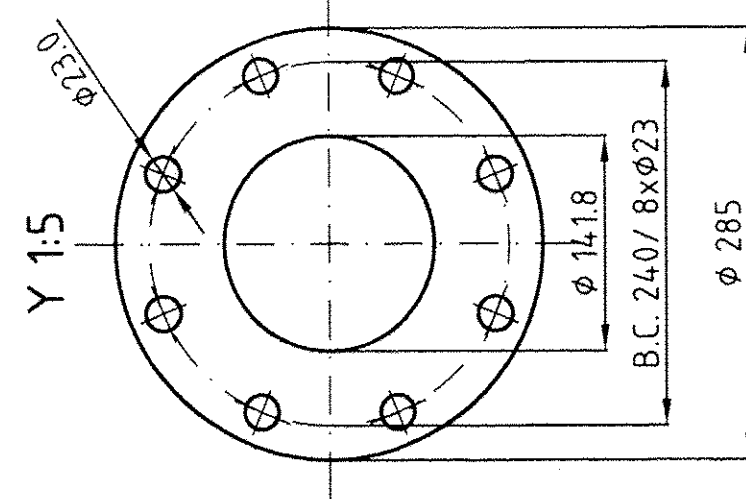
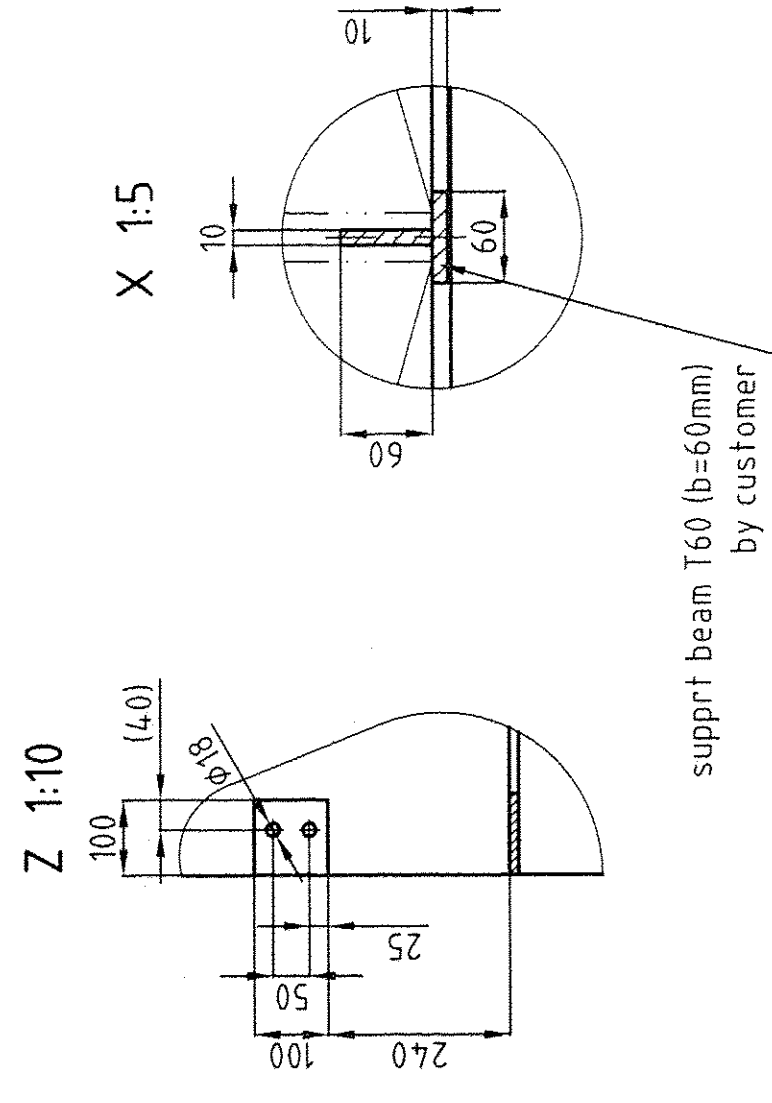
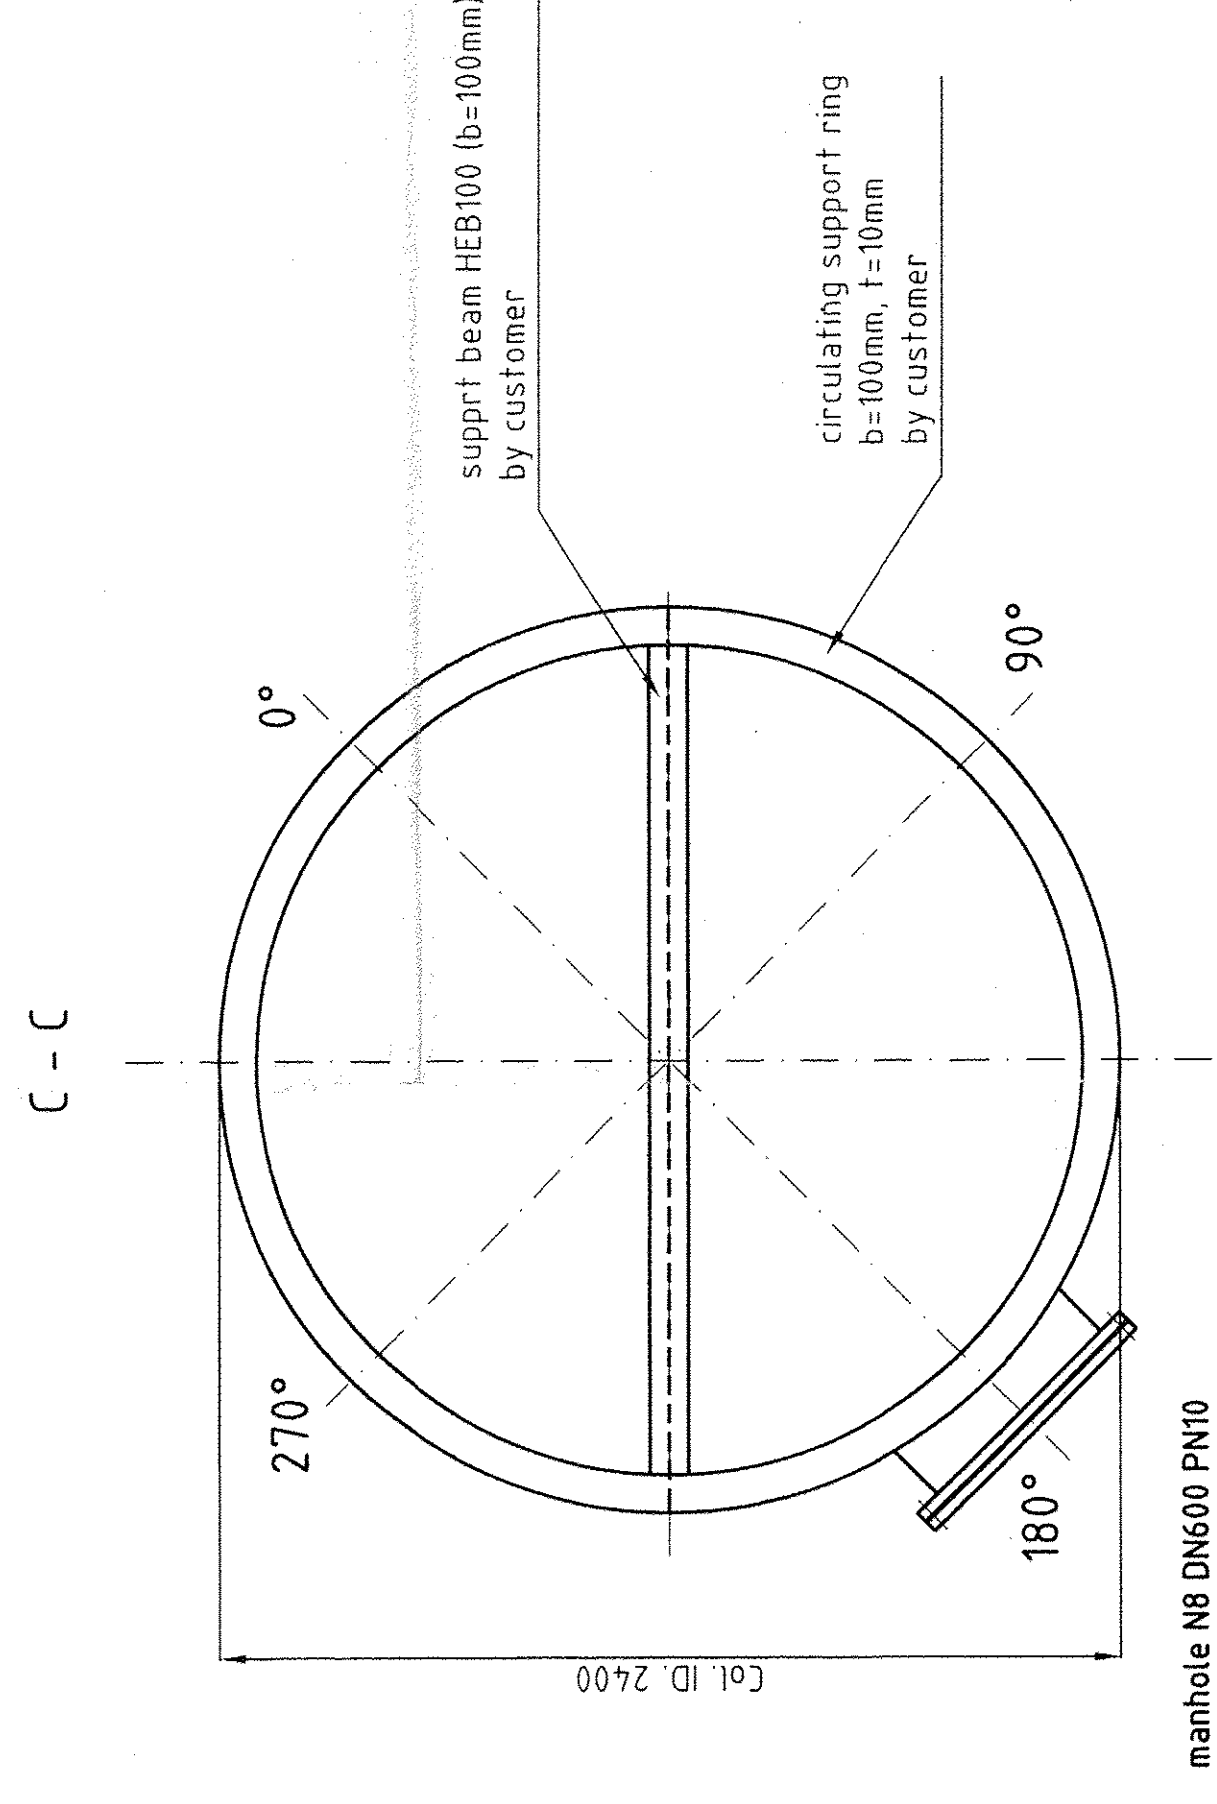


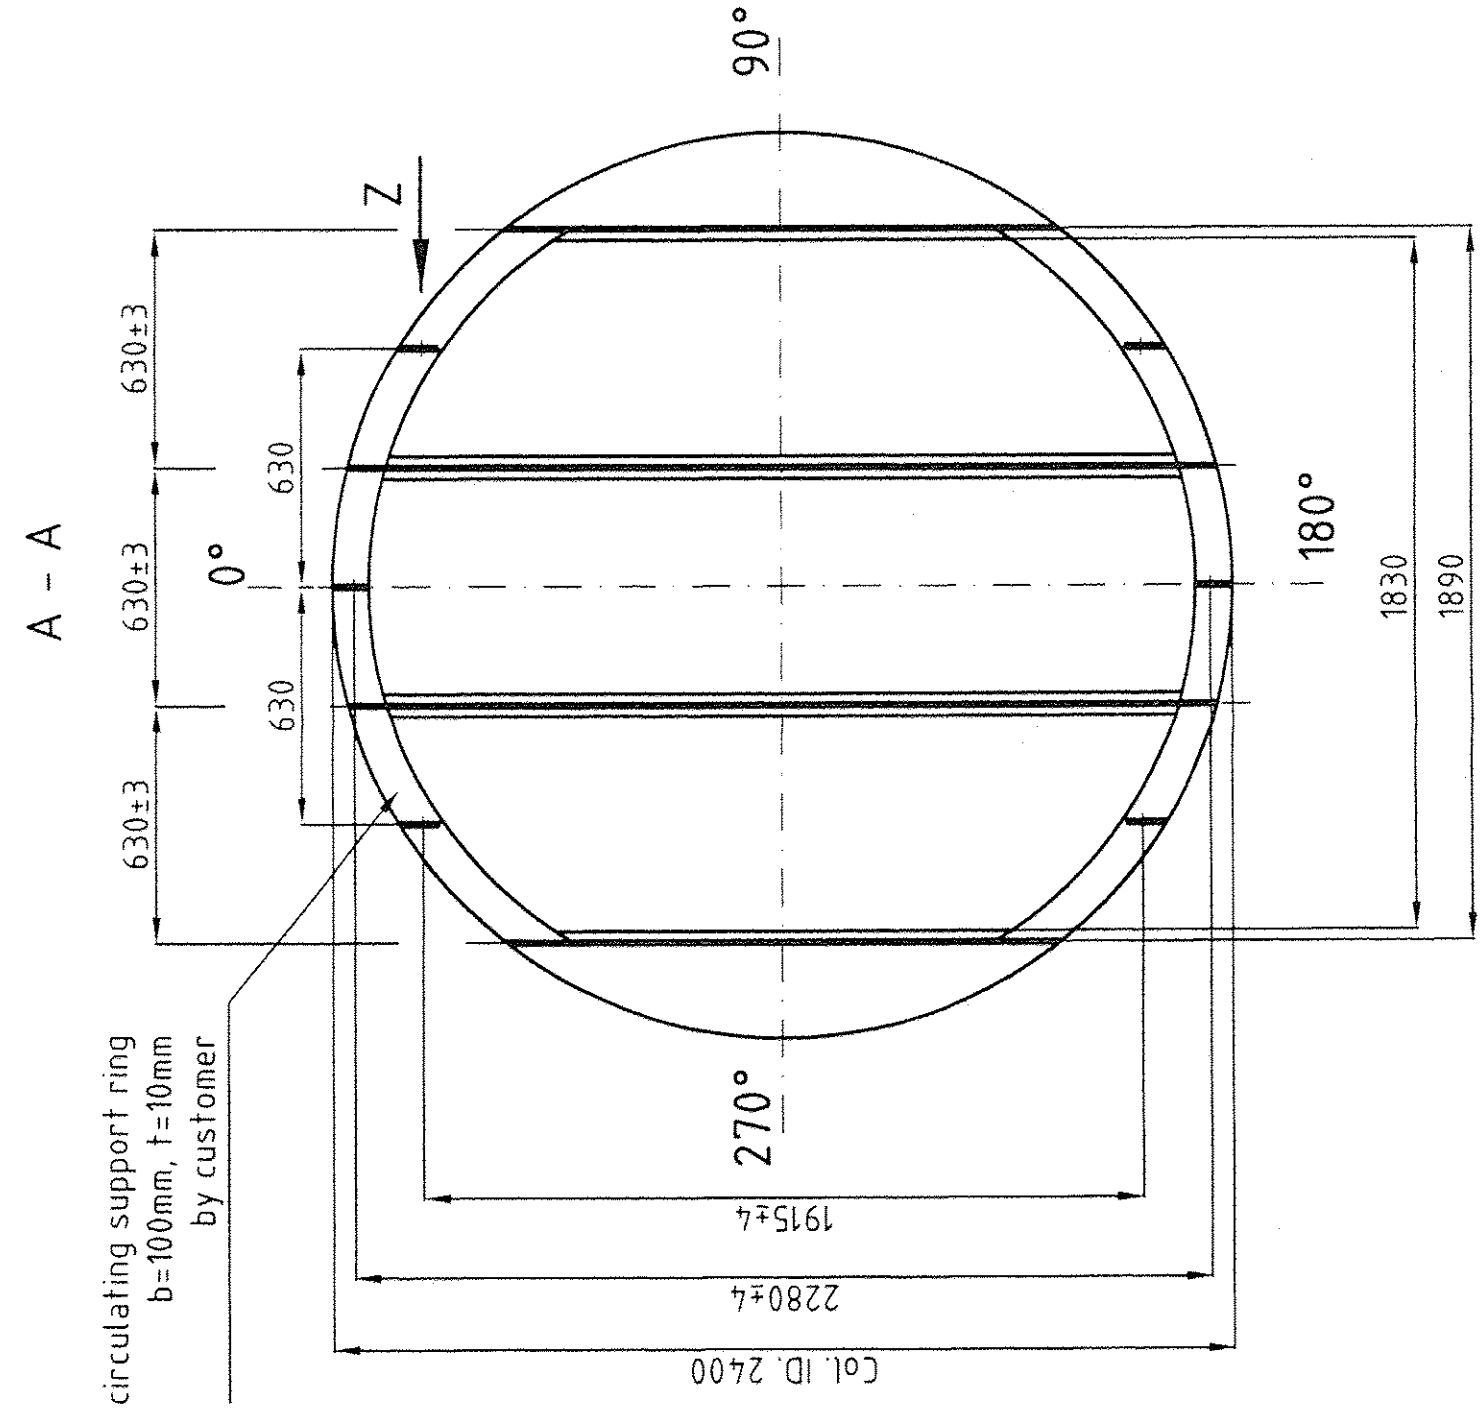

customer:	Air Liquide	project:	ASU Kosice
order no.:	4500024509	position:	Chill Tower
RVT-order no.:		30872 	

02	18.07.2005	F. Prell	as built - no changes			
01	08.02.2005	U. Napralta	Flanschanschluss N3			
00	22.01.2005	U. Napralta	first issue			
rev	date	name	description	approved	date	

Rauschert
KLEBERSTÄBCHEN

Paul-Rauschert-Str. 6, 96349 Steinwiesen
Technisches Büro: Im Gries 11, 96364 Marktrodach
Telefon +49 9261/6663-10, Fax +49 9261/6663-19
description:

Internals General Arrangement dia2400

tolerances acc. DIN ISO 2768-c	copyright DIN34	drawing no.: K00501221-02	Rev. 02
--------------------------------	-----------------	---------------------------	---------