

US STEEL KOSICE/SLOVAKIA
50.3023.01
SUBSTATION T80

MOTOR FEEDER

CIRCUIT DIAGRAM

A = L04

/ A01

D009781.02, 604-3, AHA

50.3023.01.A3.741.226
COVER SHEET
PANEL
04

DATE :	13.07.2005
prep.:	Brünert
Check:	Adam
Norm :	


22.12.2006 HJ0115MD
D00978102
=L04
A01
ADAM

03 AS BUILT	05.12.2006	AD
02 Fact.-Rev.	09.11.2005	AD
01 Approval	20.09.2005	AD
Nr. Alteration	Date	Name

INSTR. AND CONTROL					REMARKS
FUNCTION	LOCAL	LOCAL CONTROL	REMOTE CONTROL		
CONTROL	-08 -001, -002		-001, -002		
STATUS SIGNAL	-001, -002, -08		-001, -002, -08		
MEASUREMENT	1 (L1-L3)		1 (L2), U(L1-L2) P (P2), Q(Q2)		
PROTECTION	NIGCOM P130C				
ANSI	27, 32, 46, 48, 49, 50P, 50N, 50BF, 51, 51N, 59, 59N, 66, 67, 67N, 79, 810				81U, 86
METERING					

[illegible]

TECHNICAL TRANSFORMER DATA						
DESIGN	MANUFACT	TYP	RATIO	WDE	REMARKS	
-T1L1	AEG	CT12	1000/1/1/1A	C1: cl. 0.2FS5 15VA		
-T1L2	AEG	CT12	1000/1/1/1A	C2: cl. 1FS5 15VA		
-T1L3	AEG	CT12	1000/1/1/1A	C3: cl. 10P10 15VA		
-T91	AEG	RKT 250/160 Gr. 3	60/1A	C1: cl. 3FS5 1.2VA		
-T92	AEG	RKT 250/160 Gr. 3	60/1A	C1: cl. 3FS5 1.2VA		
-T93	AEG	RKT 250/160 Gr. 3	60/1A	C1: cl. 3FS5 1.2VA		
-T94	AEG	RKT 250/160 Gr. 3	60/1A	C1: cl. 3FS5 1.2VA		
-F1L1	AREVA	HE09				
-F1L2	AREVA	HE09				
-F1L3	AREVA	HE09				OVERVOLTAGE ARRESTOR
-G1L1	AREVA	IV1S				
-G1L2	AREVA	IV1S				CAP. TAPPING
-G1L3	AREVA	IV1S				

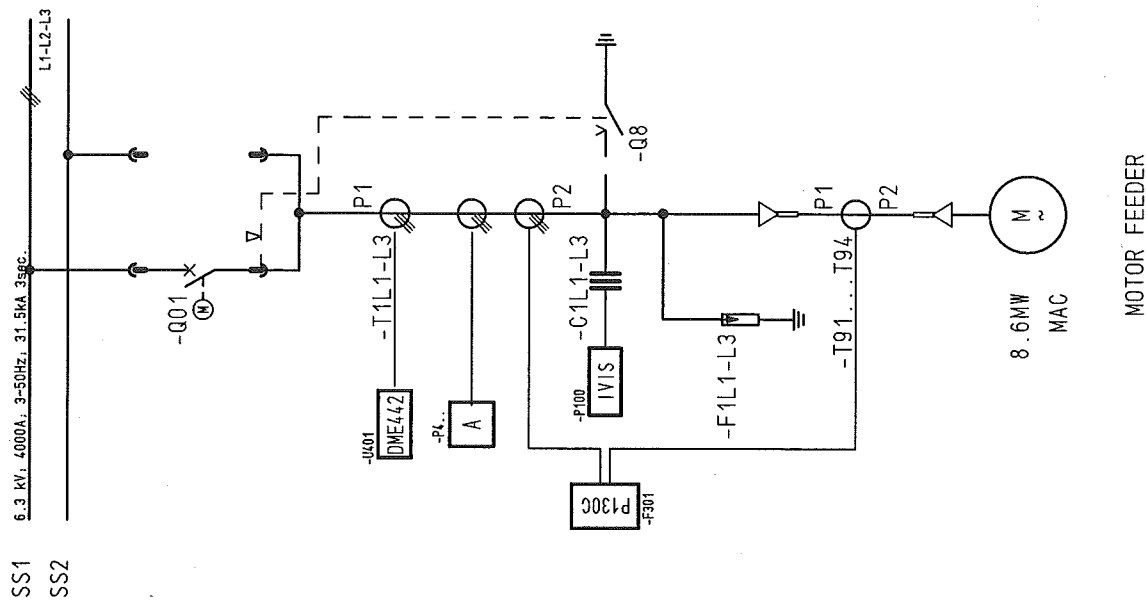

1		2		3		4		5		6		7		8					
CLIENT DOCUMENT NUMBER		RELEASE BY DOCUMENT NUMBER		VERSION STATUS		DOCUMENT IDENTIFICATION		SHEET		DESIGN									
						SORT MATCHING		ITEM NO.											
A	50.3023.01.A3.741		D009781.02.604-3.AHA	01	02	03	A =L04	A01	1	COVER SHEET	04								
	50.3023.01.A3.741	.226	D009781.02.604-3.AHA	01	02	03	A =L04	A02	2	CIRCUIT DIAGRAM	04								
	50.3023.01.A3.741	.226	D009781.02.604-3.AHA	01	02	03	A =L04	B01	3	Inhaltsverzeichnis	04								
	50.3023.01.A3.741	.226	D009781.02.604-3.AHA	01	02	03	A =L04	B02	4	Inhaltsverzeichnis	04								
	50.3023.01.A3.741	.226	D009781.02.604-3.AHA	01	02	03	A =L04	B03	5	Inhaltsverzeichnis	04								
B	50.3023.01.A3.741	.226	D009781.02.604-3.AHA	01	02	03	A =L04	B04	6	Inhaltsverzeichnis	04								
	50.3023.01.A3.741	.226	D009781.02.604-3.AHA	01	02	03	S =L04	D01	7	CIRCUIT DIAGRAM	AC-DISTRIBUTION	04							
	50.3023.01.A3.741	.226	D009781.02.604-3.AHA	01	02	03	S =L04	B00	8	CIRCUIT DIAGRAM	CBF	04							
	50.3023.01.A3.741	.226	D009781.02.604-3.AHA	01	02	03	S =L04	B01	9	CIRCUIT DIAGRAM	DC DISTR.	04							
	50.3023.01.A3.741	.226	D009781.02.604-3.AHA	01	02	03	S =L04	B02	10	CIRCUIT DIAGRAM	RING CIRCUIT	04							
C	50.3023.01.A3.741	.226	D009781.02.604-3.AHA	01	02	03	S =L04	L01	11	CIRCUIT DIAGRAM	CIRCUIT-BREAKER	MOTOR DRIVE	04						
	50.3023.01.A3.741	.226	D009781.02.604-3.AHA	01	02	03	S =L04	M01	12	CIRCUIT DIAGRAM	CONTROL	04							
	50.3023.01.A3.741	.226	D009781.02.604-3.AHA	01	02	03	S =L04	M02	13	CIRCUIT DIAGRAM	CONTROL	04							
	50.3023.01.A3.741	.226	D009781.02.604-3.AHA	01	02	03	S =L04	M03	14	CIRCUIT DIAGRAM	CONTROL	04							
	50.3023.01.A3.741	.226	D009781.02.604-3.AHA	01	02	03	S =L04	M04	15	CIRCUIT DIAGRAM	CONTROL	04							
D	50.3023.01.A3.741	.226	D009781.02.604-3.AHA	01	02	03	S =L04	M05	16	CIRCUIT DIAGRAM	CONTROL	04							
	50.3023.01.A3.741	.226	D009781.02.604-3.AHA	01	02	03	S =L04	N01	17	CIRCUIT DIAGRAM	ARC DETECTOR	04							
	50.3023.01.A3.741	.226	D009781.02.604-3.AHA	01	02	03	S =L04	N02	18	CIRCUIT DIAGRAM	ARC DETECTOR	04							
	50.3023.01.A3.741	.226	D009781.02.604-3.AHA	01	02	03	S =L04	P01	19	CIRCUIT DIAGRAM	INTERLOCK	04							
	50.3023.01.A3.741	.226	D009781.02.604-3.AHA	01	02	03	S =L04	P02	20	CIRCUIT DIAGRAM	INTERLOCK	04							
	50.3023.01.A3.741	.226	D009781.02.604-3.AHA	01	02	03	S =L04	R01	29	CIRCUIT DIAGRAM	SIGNALING	04							
	50.3023.01.A3.741	.226	D009781.02.604-3.AHA	01	02	03	S =L04	S01	30	CIRCUIT DIAGRAM	CURR. TRANSF.	04							
	50.3023.01.A3.741	.226	D009781.02.604-3.AHA	01	02	03	S =L04	S02	31	CIRCUIT DIAGRAM	CURR. TRANSF.	04							
Copyright as per DIN 34 to be observed!										D00978102									
FIELD 04																			
22.12.2006																			
AS BUILT										US STEEL KOSICE/SLOVAKIA									
05.12.2005										50.3023.01									
09.11.2005										50.3023.01									
09.11.2005										50.3023.01									
09.11.2005</																			

Copyright as per DIN 34 to be observed!

D00978102

FELD 04

22.12.2006

03	AS BUILT	05.12.2005 AD	Date	13.07.2005	US STEEL KOSTICE/SLOVAKIA	
02	Fact.-Rev.	09.11.2005 AD	Drawn	Bräunert	50.3023.01	
01	Approval	20.09.2005 AD	Check	Adom	SUBSTATION T60	
Alteration		Date	Name	Std.	Iss. for	
					Orig.	

1	2	3	4	5	6	7	8
CLIENT DOCUMENT NUMBER	RELEASE BY DOCUMENT NUMBER	VERSION STATUS	DOCUMENT IDENTIFICATION SORT MATCHING	ITEM NO.	SHEET	DESIGN	
50.3023.01.A3.741.226	D009781.02.604-3.AHA	01 02 03	S =L04	T01	32	CIRCUIT DIAGRAM PANEL	VOLTAGE TRANSF. 04
50.3023.01.A3.741.226	D009781.02.604-3.AHA	01 02 03	S =L04	T02	33	CIRCUIT DIAGRAM PANEL	IVIS 04
50.3023.01.A3.741.226	D009781.02.604-3.AHA	01 02 03	S =L04	V01	34	CIRCUIT DIAGRAM PANEL	SPARE CONTACTS 04
50.3023.01.A3.741.226	D009781.02.604-3.AHA	01 02 03	S =L04	V02	35	CIRCUIT DIAGRAM PANEL	SPARE CONTACTS 04
50.3023.01.A3.741.226	D009781.02.604-3.AHA	01 02 03	S =L04	X01	36	CIRCUIT DIAGRAM PANEL	AX PE-BUS 04
50.3023.01.A3.741.226	D009781.02.604-3.AHA	01 02 03	S =L04	Z1A1	37	LIST OF EQUIPMENT PANEL	04
50.3023.01.A3.741.226	D009781.02.604-3.AHA	01 02 03	S =L04	Z1A10	38	LIST OF EQUIPMENT PANEL	04
50.3023.01.A3.741.226	D009781.02.604-3.AHA	01 02 03	S =L04	Z1A11	39	LIST OF EQUIPMENT PANEL	04
50.3023.01.A3.741.226	D009781.02.604-3.AHA	01 02 03	S =L04	Z1F1	40	LIST OF EQUIPMENT PANEL	04
50.3023.01.A3.741.226	D009781.02.604-3.AHA	01 02 03	S =L04	Z1F10	41	LIST OF EQUIPMENT PANEL	04
50.3023.01.A3.741.226	D009781.02.604-3.AHA	01 02 03	S =L04	Z1F11	42	LIST OF EQUIPMENT PANEL	04
50.3023.01.A3.741.226	D009781.02.604-3.AHA	01 02 03	S =L04	Z1F2	43	LIST OF EQUIPMENT PANEL	04
50.3023.01.A3.741.226	D009781.02.604-3.AHA	01 02 03	S =L04	Z1H1	44	LIST OF EQUIPMENT PANEL	04
50.3023.01.A3.741.226	D009781.02.604-3.AHA	01 02 03	S =L04	Z1K1	45	LIST OF EQUIPMENT PANEL	04
50.3023.01.A3.741.226	D009781.02.604-3.AHA	01 02 03	S =L04	Z1K2	46	LIST OF EQUIPMENT PANEL	04
50.3023.01.A3.741.226	D009781.02.604-3.AHA	01 02 03	S =L04	Z2Y1	56	LIST OF EQUIPMENT PANEL	04
50.3023.01.A3.741.226	D009781.02.604-3.AHA	01 02 03	S =L04	Z3Q1	57	LIST OF EQUIPMENT PANEL	04
50.3023.01.A3.741.226	D009781.02.604-3.AHA	01 02 03	S =L04	Z3Q2	58	LIST OF EQUIPMENT PANEL	04
50.3023.01.A3.741.226	D009781.02.604-3.AHA	01 02 03	S =L04	Z3S1	59	LIST OF EQUIPMENT PANEL	04
50.3023.01.A3.741.226	D009781.02.604-3.AHA	01 02 03	S =L04	Z3Y1	60	LIST OF EQUIPMENT PANEL	04
50.3023.01.A3.741.226	D009781.02.604-3.AHA	01 02 03	V =L04 +STA.R	K01	61	TERMINAL DIAGRAM PANEL	04
50.3023.01.A3.741.226	D009781.02.604-3.AHA	01 02 03	V =L04 +STA.R	K02	62	TERMINAL DIAGRAM PANEL	04
Inhalt sverzeichnis					50.3023.01.A3.741.226		
AREVA					A1=L04		
US STEEL KOSICE/SLOVAKIA					/ 802		
50.3023.01					Sheet 4		
SUBSTATION T80					D009781.02.604-3.AHA		
Orig.:					98Sh		
Iss. for					8		
Iss. by:					7		
Date					6		
Name/Std.					5		
Check/Adm					4		
Drawn/Bräunert					3		
Date					2		
13.07.2005					1		
05.12.2005							
AS BUILT							
Fact -Rev.							
09.11.2005							
Approval							
20.08.2005							
Alteration							


Copyright as per DIN 34 to be observed!


D00978102

FIELD 04

22.12.2006

1		2		3		4		5		6		7		8	
CLIENT DOCUMENT NUMBER		RELEASE BY DOCUMENT NUMBER		VERSION STATUS		DOCUMENT IDENTIFICATION		SHEET		DESIGN					
						SORT MATCHING		ITEM NO.							
50.3023.01.A3.741 .226		D009781.02.604-3.AHA		01 02 03		V -L04 +S1A.R		K03		TERMINAL DIAGRAM PANEL		04			
50.3023.01.A3.741 .226		D009781.02.604-3.AHA		01 02 03		V -L04 +S1A.R		K10		TERMINAL DIAGRAM PANEL		04			
50.3023.01.A3.741 .226		D009781.02.604-3.AHA		01 02 03		V -L04 +S1A.R		K11		TERMINAL DIAGRAM PANEL		04			
50.3023.01.A3.741 .226		D009781.02.604-3.AHA		01 02 03		V -L04 +S1A.R		K12		TERMINAL DIAGRAM PANEL		04			
50.3023.01.A3.741 .226		D009781.02.604-3.AHA		01 02 03		V -L04 +S1A.R		K30		TERMINAL DIAGRAM PANEL		04			
50.3023.01.A3.741 .226		D009781.02.604-3.AHA		01 02 03		V -L04 +S1A.R		K40		TERMINAL DIAGRAM PANEL		04			
50.3023.01.A3.741 .226		D009781.02.604-3.AHA		01 02 03		V -L04 +S1A.R		K50		TERMINAL DIAGRAM PANEL		04			
50.3023.01.A3.741 .226		D009781.02.604-3.AHA		01 02 03		V -L04 +S1A.R		K51		TERMINAL DIAGRAM PANEL		04			
50.3023.01.A3.741 .226		D009781.02.604-3.AHA		01 02 03		V -L04 +S1A.R		K60		TERMINAL DIAGRAM PANEL		04			
50.3023.01.A3.741 .226		D009781.02.604-3.AHA		01 02 03		V -L04 +S1A.R		K80		TERMINAL DIAGRAM PANEL		04			
50.3023.01.A3.741 .226		D009781.02.604-3.AHA		01 02 03		V -L04 +S1A.R		K81		TERMINAL DIAGRAM PANEL		04			
50.3023.01.A3.741 .226		D009781.02.604-3.AHA		01 02 03		V -L04 +S1B.R		Q10		CROSS CONNECT. LIST PANEL		RELAY BOX 04			
50.3023.01.A3.741 .226		D009781.02.604-3.AHA		01 02 03		V -L04 +S1B.R		S01		PLUG DIAGRAM PANEL		CIRCUIT-BREAKER 04			
50.3023.01.A3.741 .226		D009781.02.604-3.AHA		01 02 03		V -L04 +S2A		Q20		CROSS CONNECT. LIST PANEL		PANEL 04			
50.3023.01.A3.741 .226		D009781.02.604-3.AHA		01 02 03		V -L04 +S3A		Q30		CROSS CONNECT. LIST PANEL		SWITCHING TRUCK 04			

033	AS BUILT	05.12.2005	AD	Date	13.07.2005	US STEEL KOSICE/SLOVAKIA	 AREVA	Inhaltsverzeichnis	50.3023.01.A3.741.226	A = 04	/ B04	
	Fact. - Rev.	09.11.2005	AD	Drawn	Bräuner	50.3023.01						
001	Approval	20.09.2005	AD	Check	Adam	SUBSTATION T80						
NO.	Alteration	Date	Name	Sid.		Orig.	iss. by:	04	Type: 09	NOTION FEEDER	D009781.02.604-3.AHA	98Stl

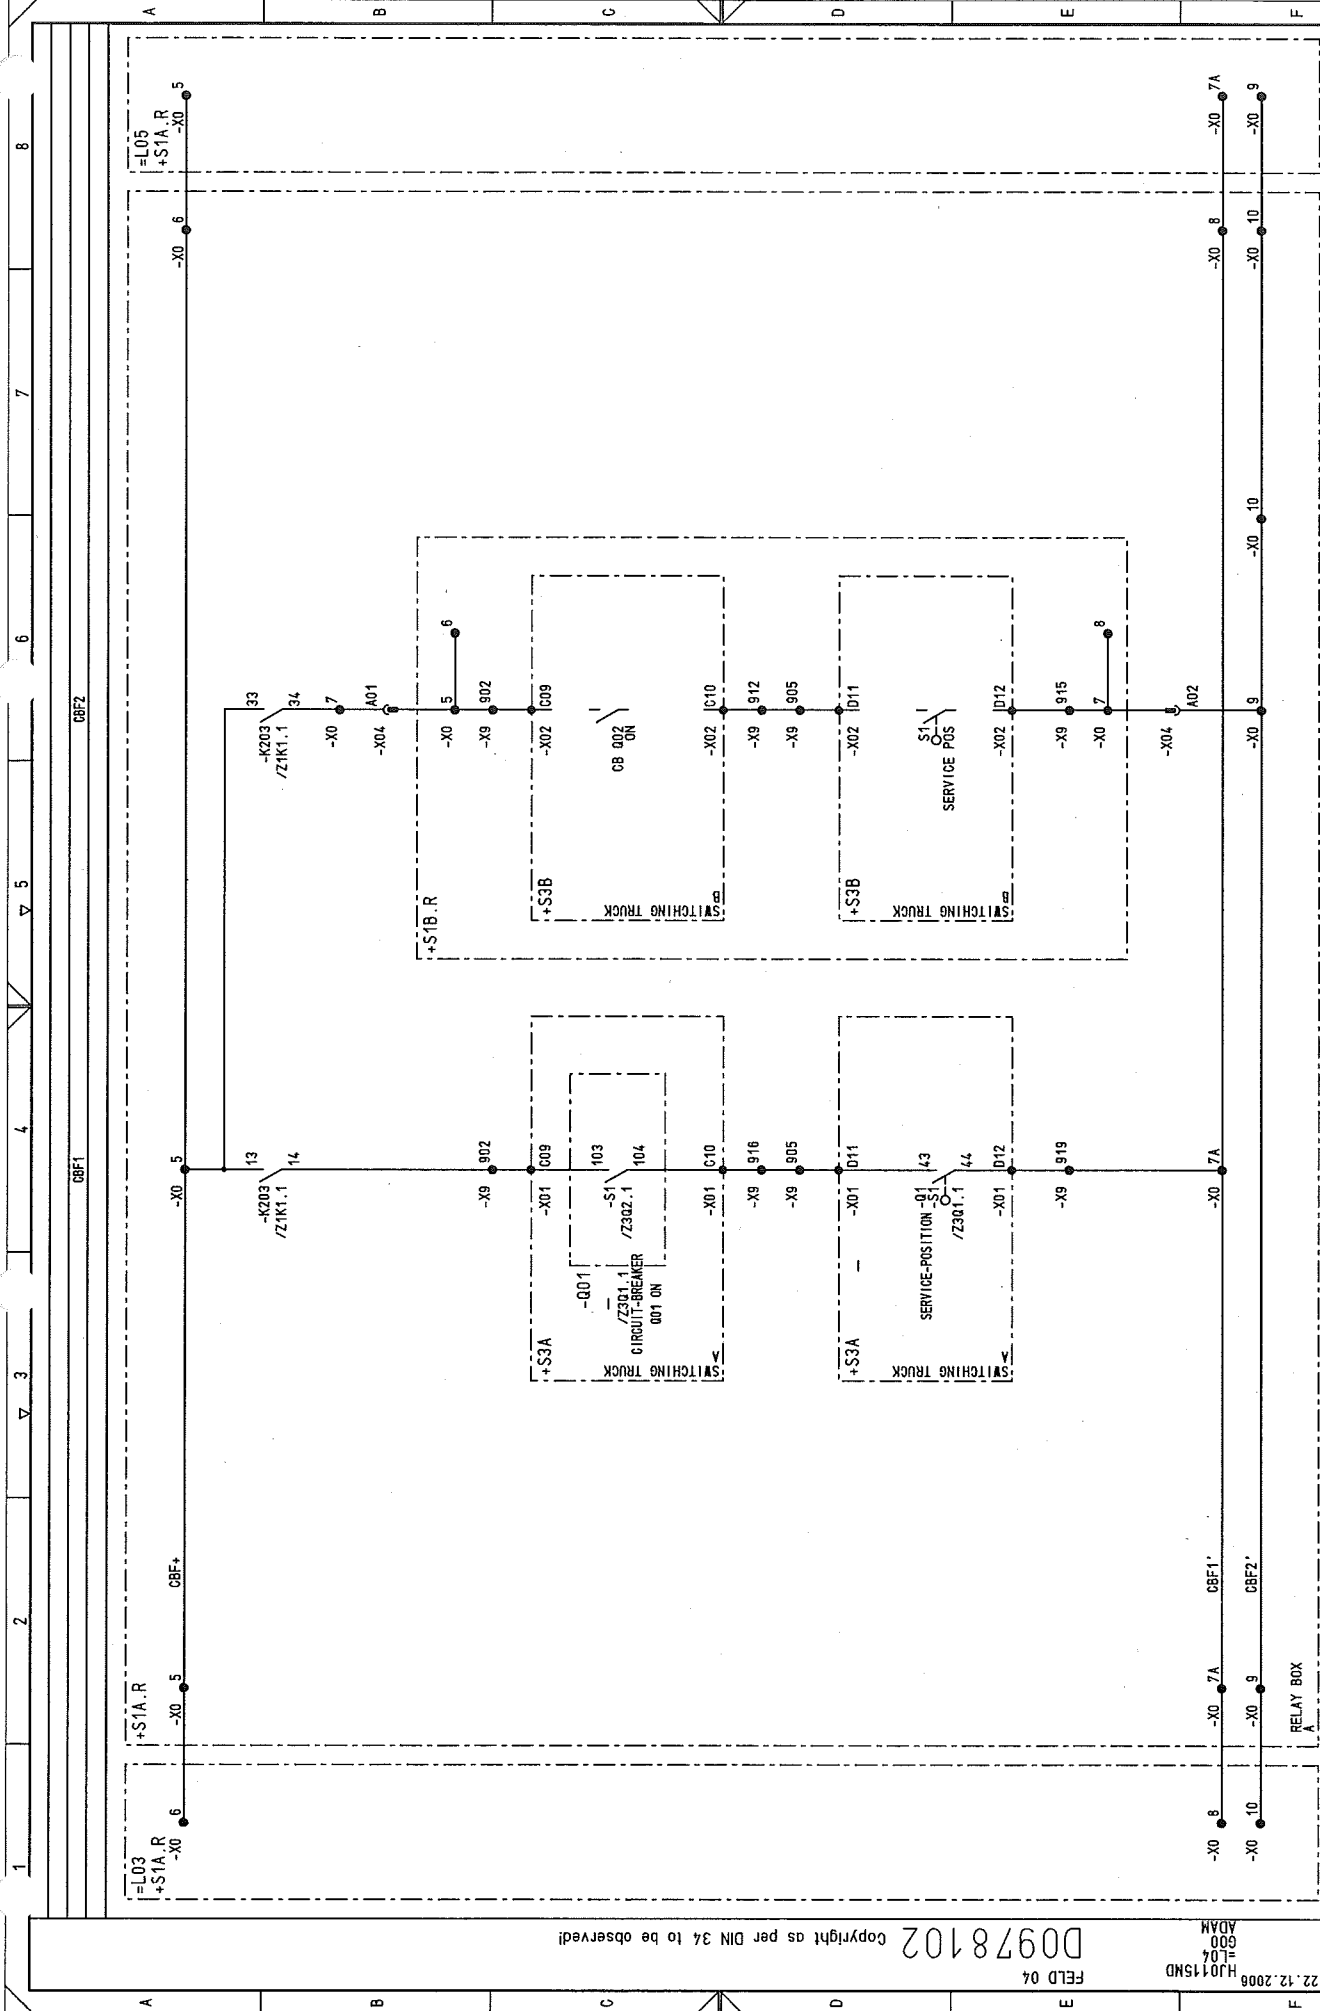

Copyright as per DIN 34 to be observed!

FIELD 04 HJ0115MD 600 ADM


22.12.2008		US STEEL KOSTICE/SLOVAKIA		CIRCUIT DIAGRAM		50.3023.01.A3.741.226		S1=L04		/ 600	
03	AS BUILT	05.12.2005	AD	Date	13.07.2005	CBF		Typ: 09		MOTOR FEEDER	
02	Fact.-Rev.	06.11.2005	AD	Drawn	Brünnert	PANEL		D009781.02.604-3.AHA		Sheet 8	
01	Approval	20.08.2005	AD	Check	Adam	04				98Sh	
NO.	Alteration	Date	Name	Std.	Iss. for	Iss. by:					



Copyright as per DIN 34 to be observed!

22.12.2006
HJ0115MD
LO1
ADM

FELD 04

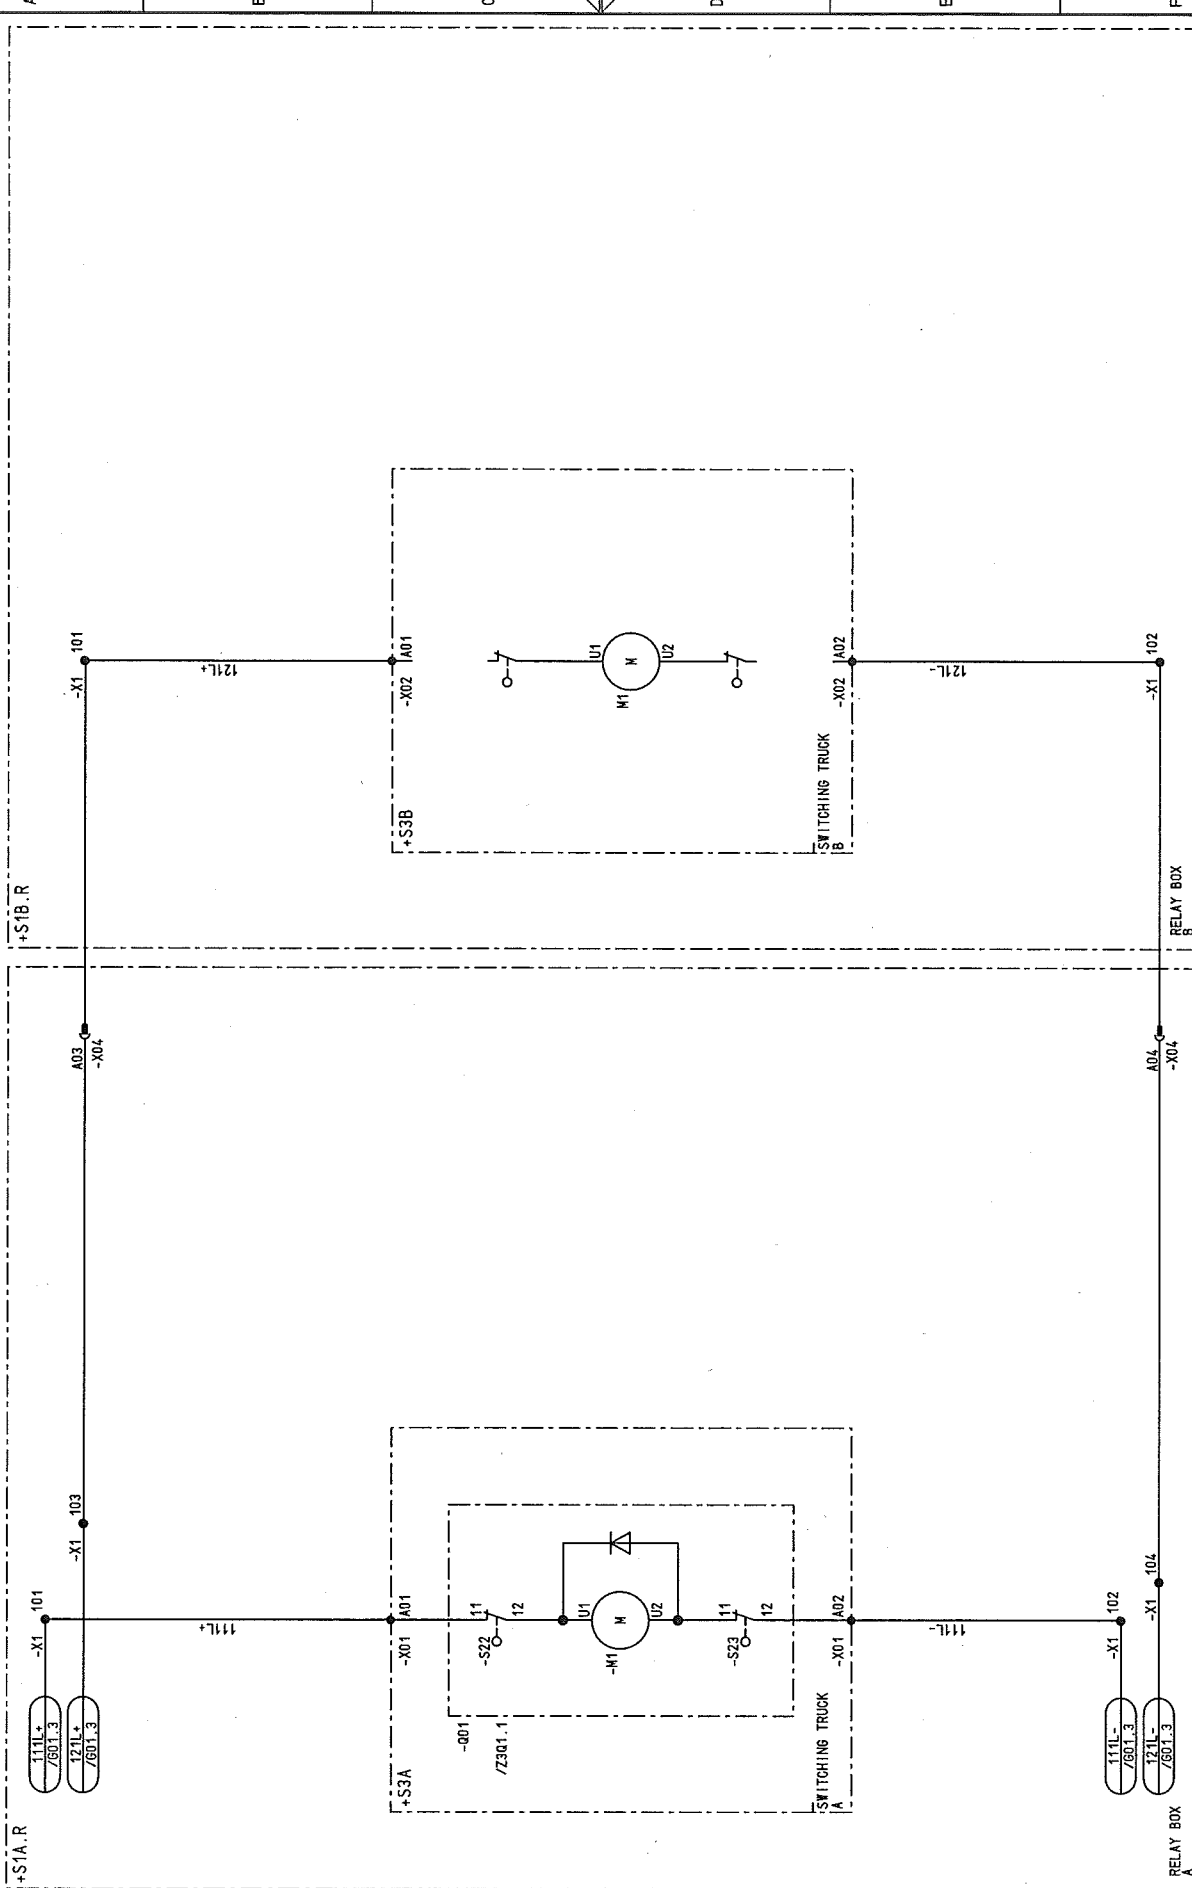

NO.	Alteration	Date	NomeStd.	Iss.by:	Iss.for	Substation T80	US STEEL KOSTICE/SLOVAKIA	50.3023.01	50.3023.01	50.3023.01.43.741.226	S1=L04	98Sh.
03	AS BUILT	05.12.2005	AD	Date	13.07.2005							
02	Fact.-Rev.	08.11.2005	AD	Drawn	Brüner							
01	Approval	20.06.2005	AD	Check	Adam							
00	Alteration											

Sheet 11

98Sh.

Typ: 09

MOTOR FEEDER

D009781.02.604-3.AHA

98Sh.

Copyright as per DIN 34 to be observed!


D0978102

FELD 04

LO4
ADAM

22.12.2006


03	AS BUILT	05.12.2005	AD	Date	13.07.2005	US STEEL KOSICE/SLOVAKIA	CIRCUIT DIAGRAM	50.3023.01.A3.741.226	S=L04	/ M01
02	Fact. -Rev.	05.11.2005	AD	Drawn	Bräunert	50.3023.01	CONTROL			
01	Approval	20.09.2005	AD	Check	Adam	SUBSTATION T80	PANEL			
NO	Alteration	Date	Name	Sld.	Iss.	for	Iss.	by:		
1										
2										
3										
4										
5										
6										
7										
8										
98Sh.										
D009781.02.604-3.AHA										
MOTOR FEEDER										
Typ: 09										
98Sh.										

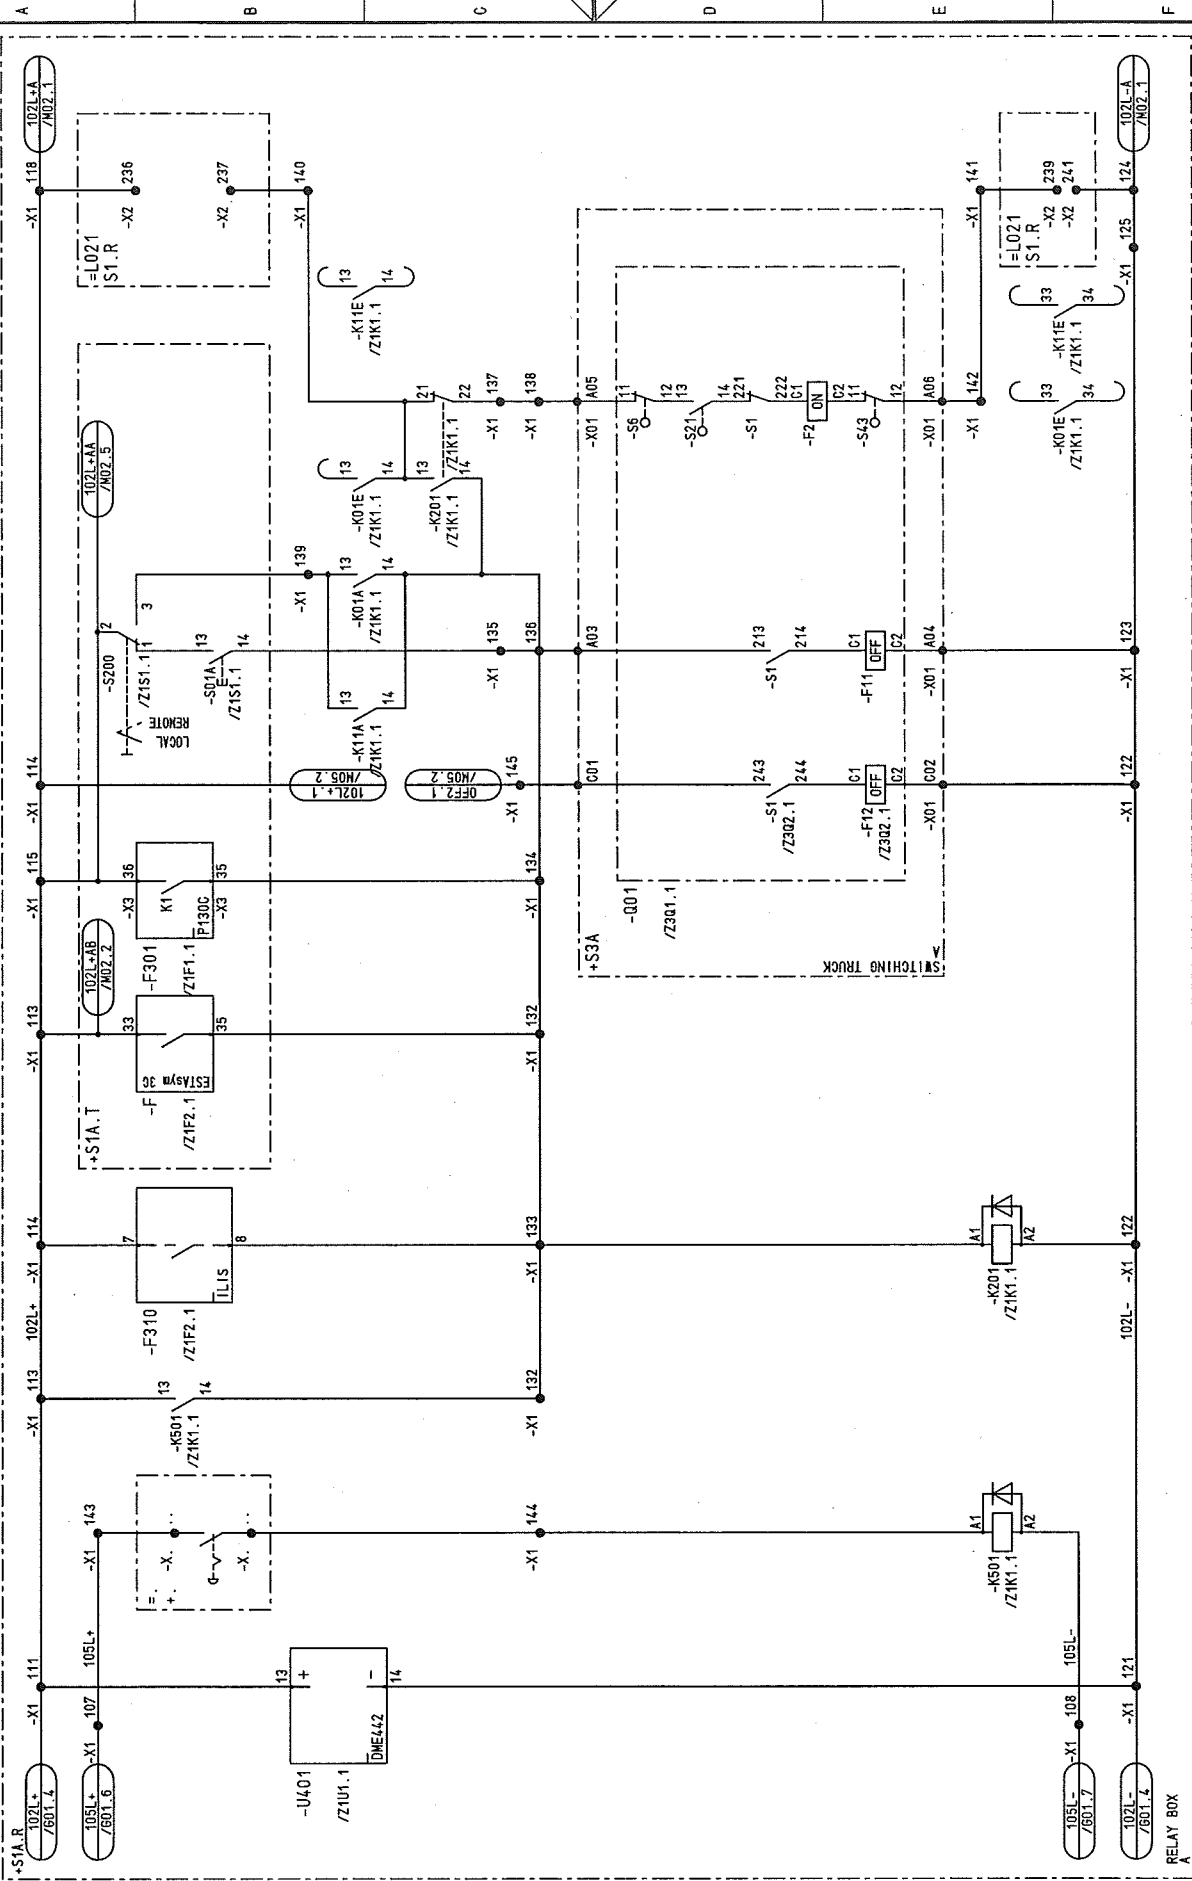


RELAY BOX

1 2 3 4 5 6 7 8

RELEASE EARTHING SWITCH
CONTROL VOLTAGE TRANSF.
PLUG PULLED
-X01

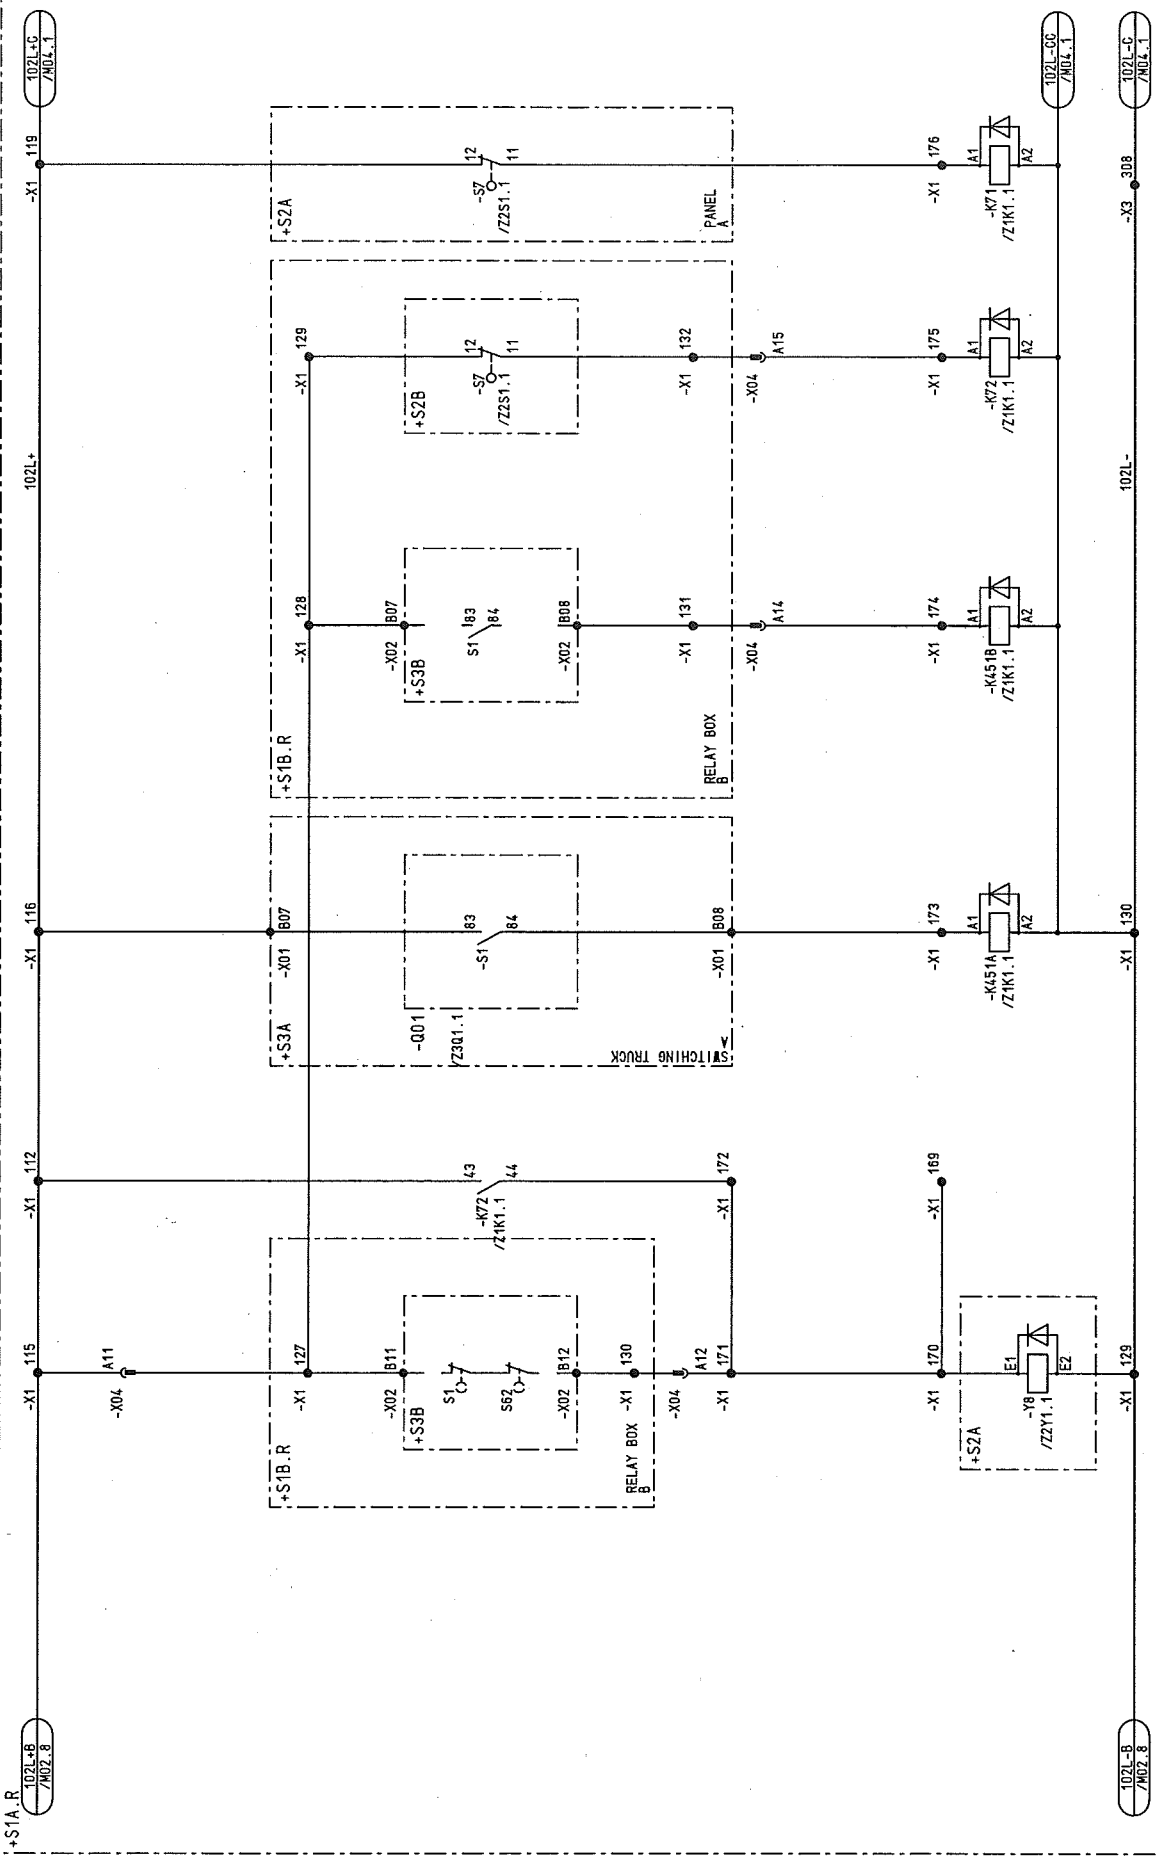

AS BUILT		06.12.2005	AD	Date	13.07.2005	US STEEL KOSTICE/SLOVAKIA		CIRCUIT DIAGRAM	
Fact.-Rev.		08.11.2005	AD	Drawn	Brünert	50.3023.01		CONTROL	
Approval		20.01.2005	AD	Check	Adam	SUBSTATION T80		PANEL	
Alteration		Date	Name	Std.		Iss. for		04	
NO.		1		2		3	4	5	6
									7
									8

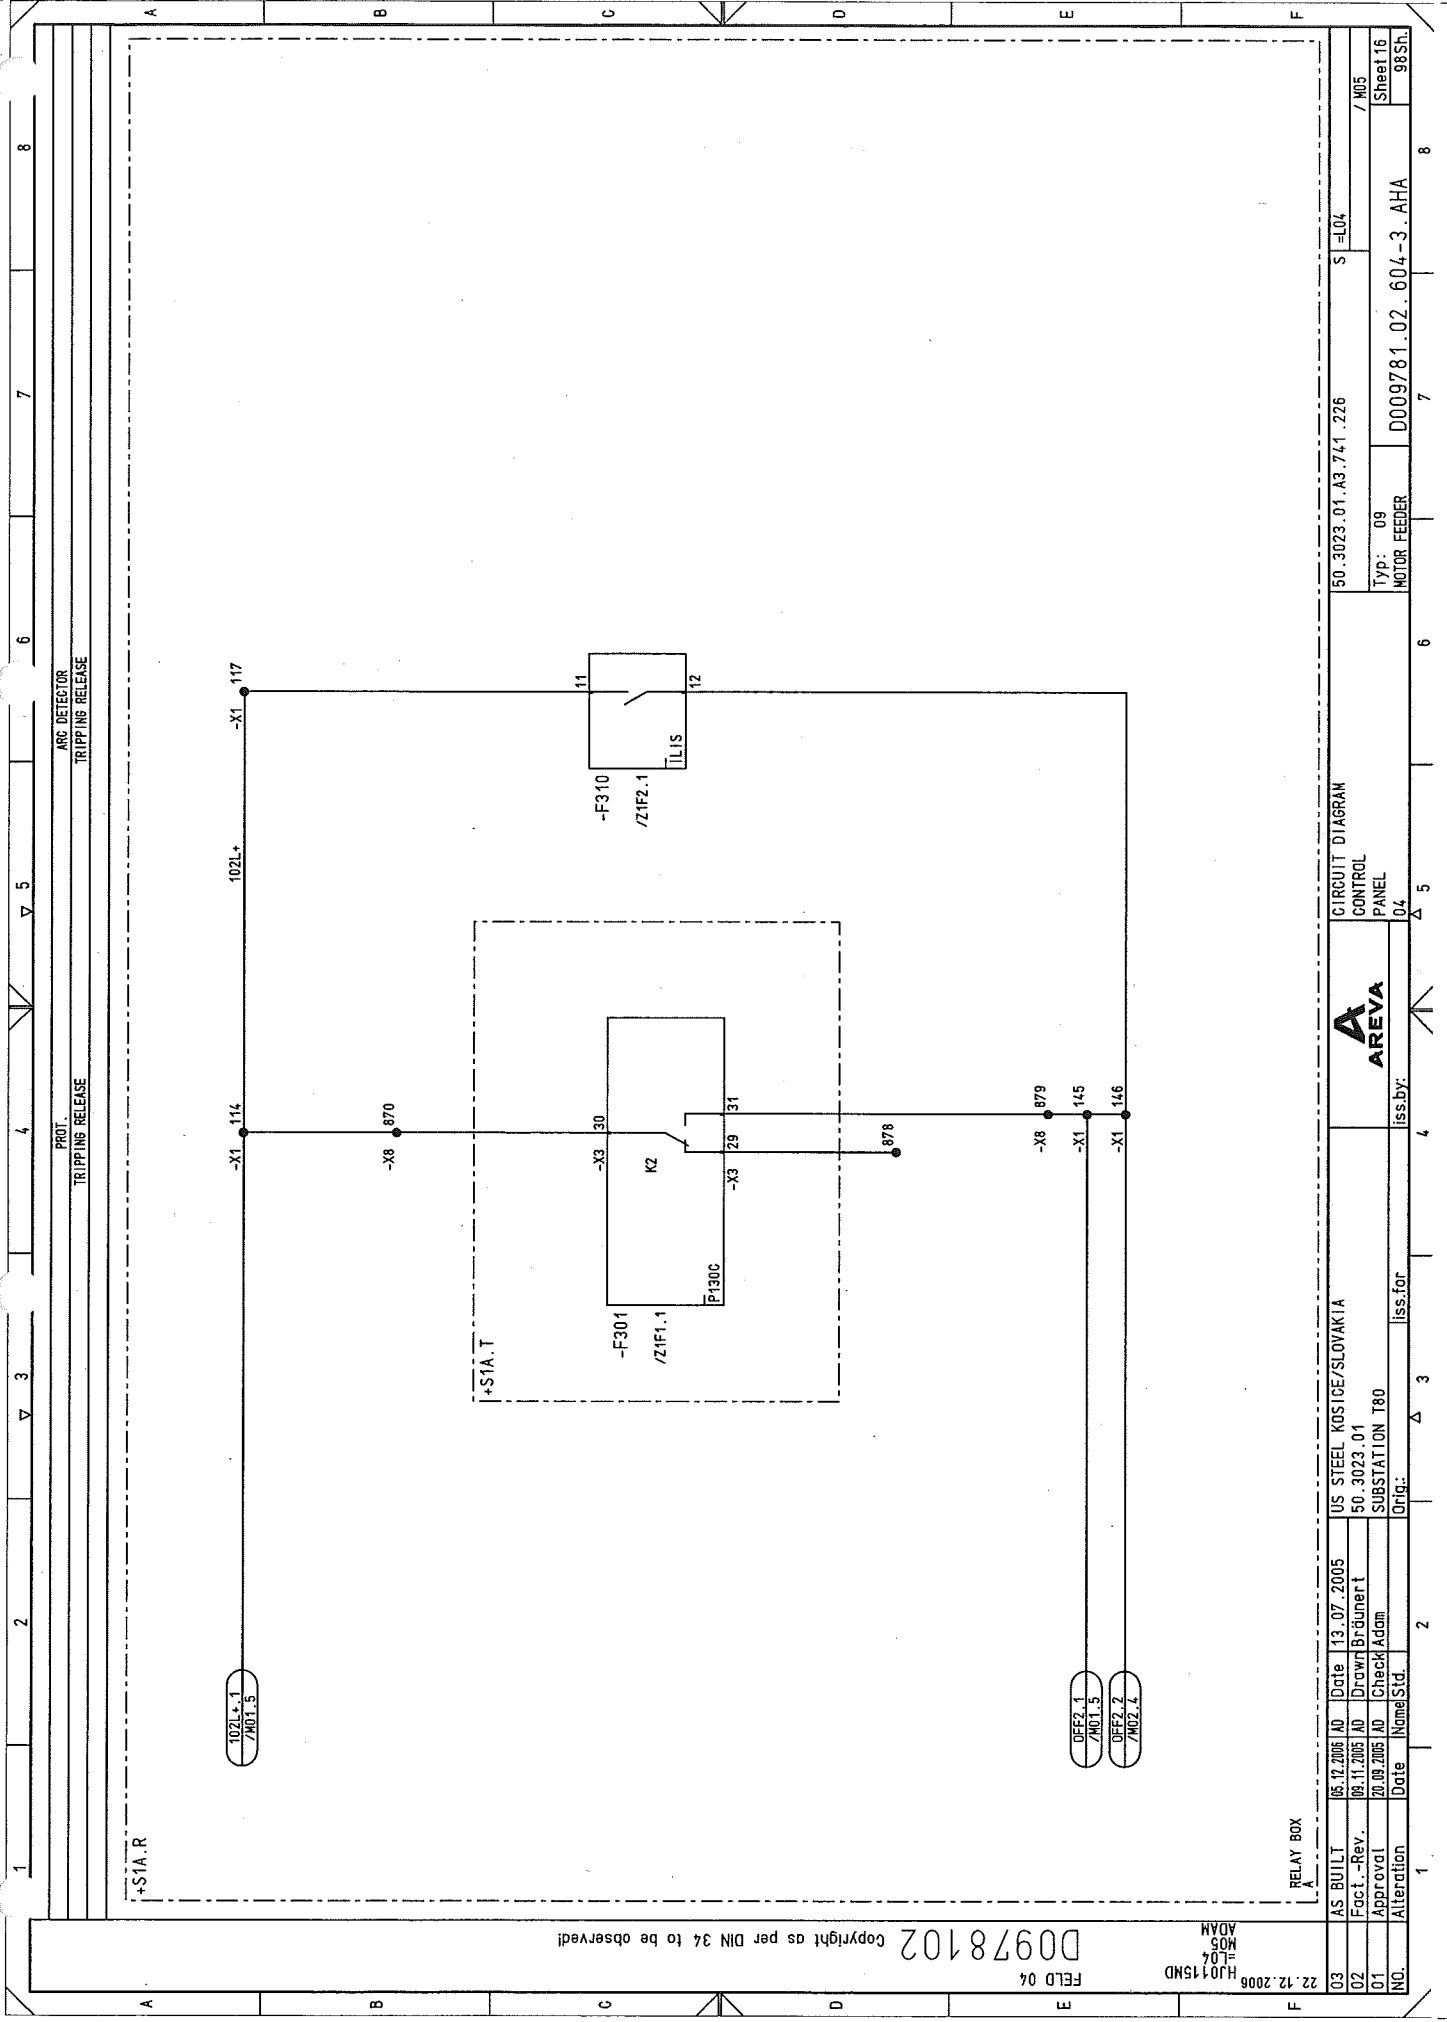

Copyright as per DIN 34 to be observed!

D0978102

HJ0115MD
=L04
M05
ADM

FELD 04

RELAY BOX

03	AS BUILT	05.12.2005	AD	Date	13.07.2005	US STEEL KOSTICE/SLOVAKIA
02	Fact.-Rev.	08.11.2005	AD	Drawn	Bräunert	50.3023.01
01	Approval	20.09.2005	AD	Check	Adam	SUBSTATION T80
NO.	Alteration	Date	Name	Std.	Iss. for	Orig.



CIRCUIT DIAGRAM

CONTROL
PANEL

50.3023.01.A3.741.226


S=L04

/M05

Typ: 09
MOTOR FEEDER

D009781.02.604-3.AHA

Sheet 16
98Sh.

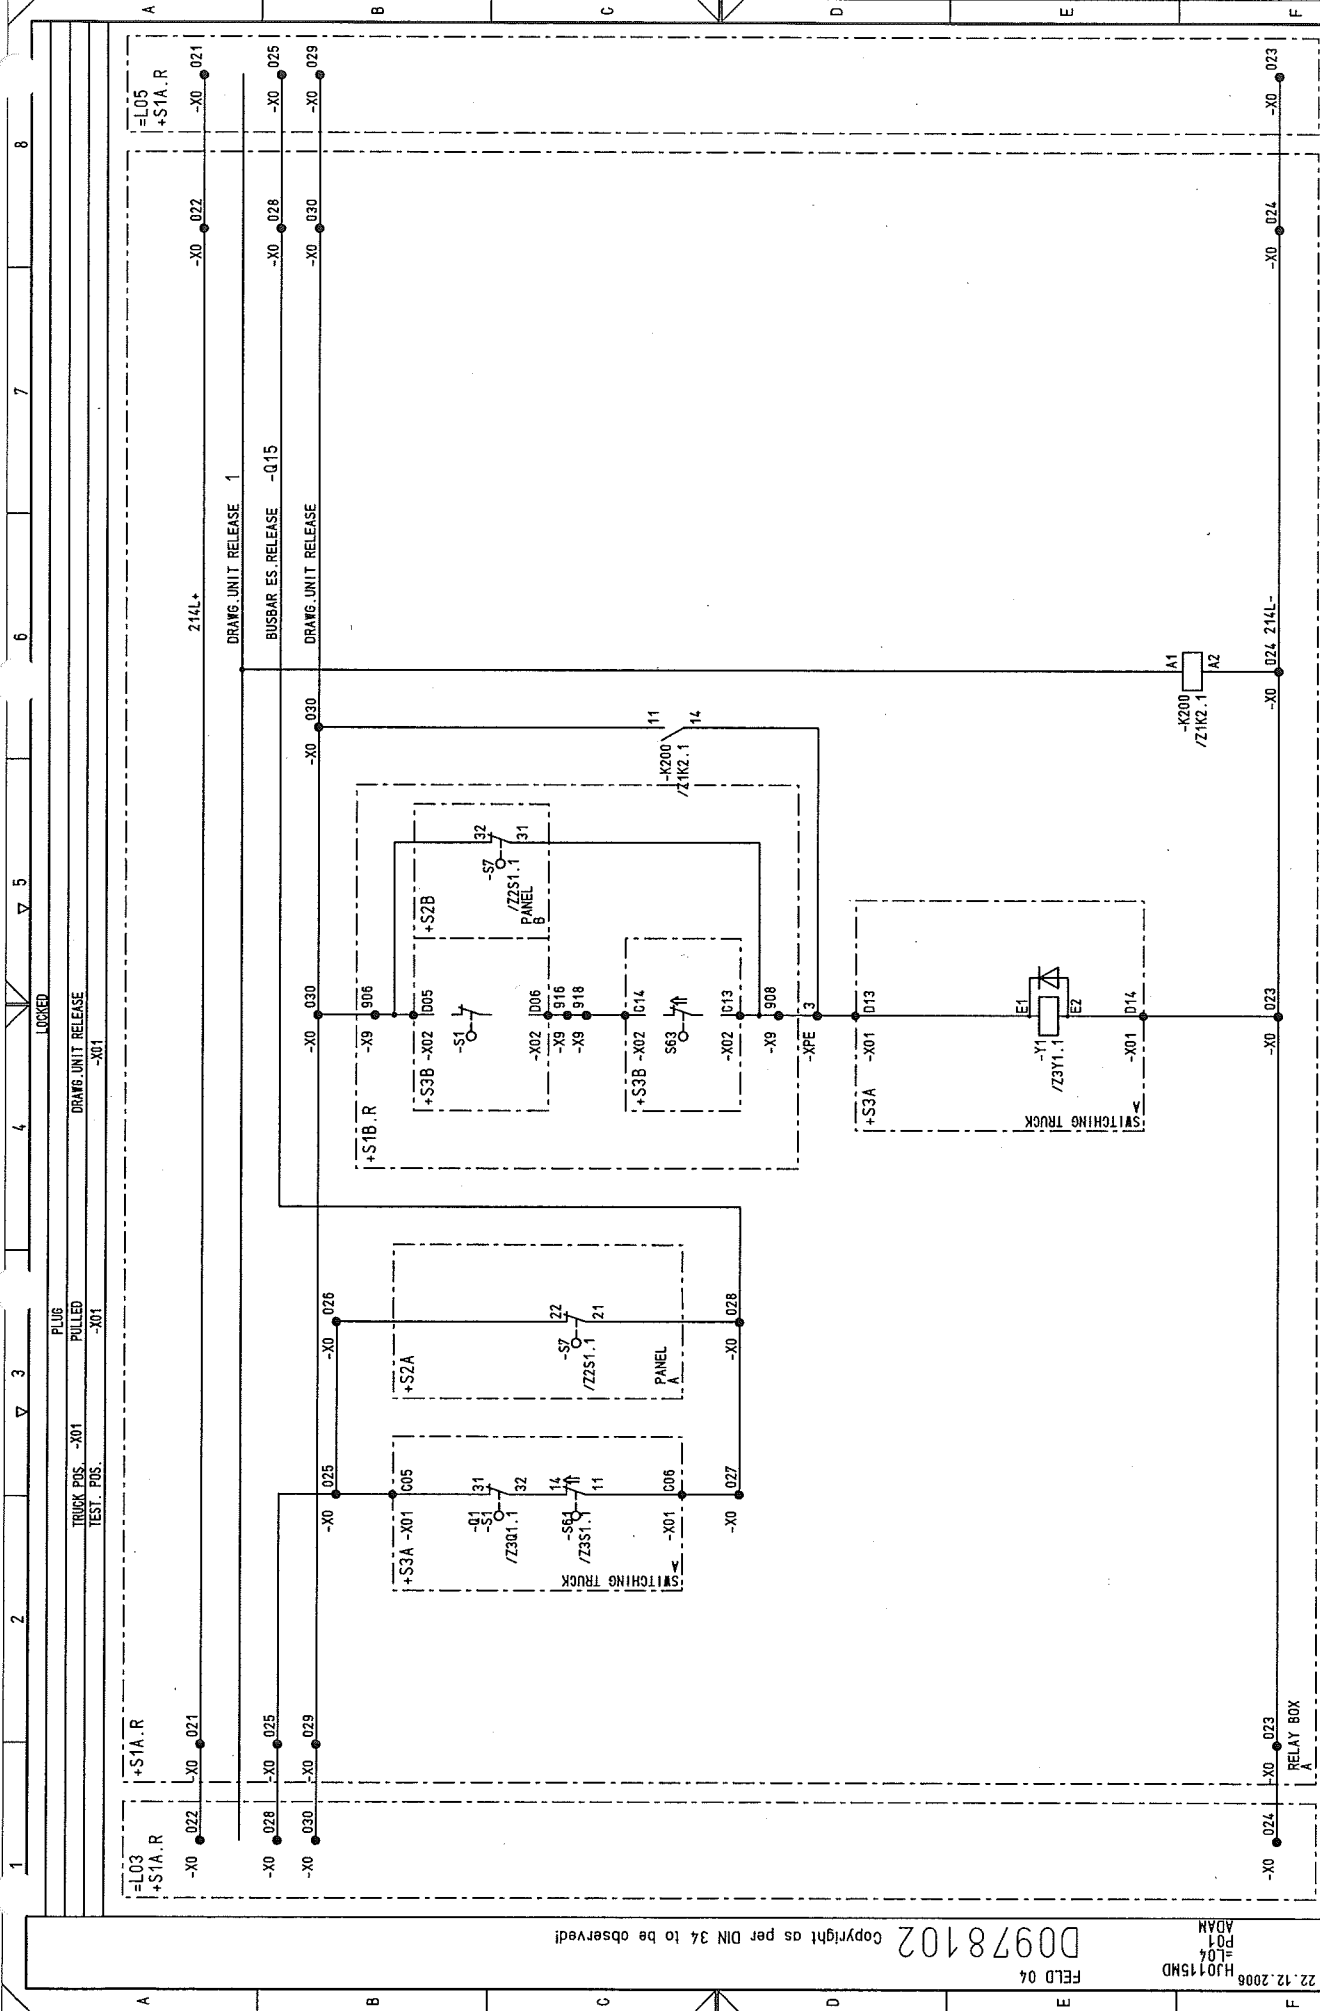


NO.		Alteration	Date	Name	Std.	Iss. for	Iss. by:	AREVA		CIRCUIT DIAGRAM		INTERLOCK		PANEL		04		50.3023.01.A3.741.226		S=L04		/ P01		Sheet 19		98Sh.	
03		AS BUILT	05.12.2005	AD	Date	13.07.2005	US STEEL KOSTICE/SLOVAKIA																				
02		Fact.-Rev.	09.11.2005	AD	Drawn	Brüner	50.3023.01																				
01		Approval	20.06.2005	AD	Check	Adam	SUBSTATION T80																				
00		Alteration			Date		Orig.																				

Copyright as per DIN 34 to be observed!

22.12.2006
H10115MD
P01
ADAM

FIELD 04

D0978102

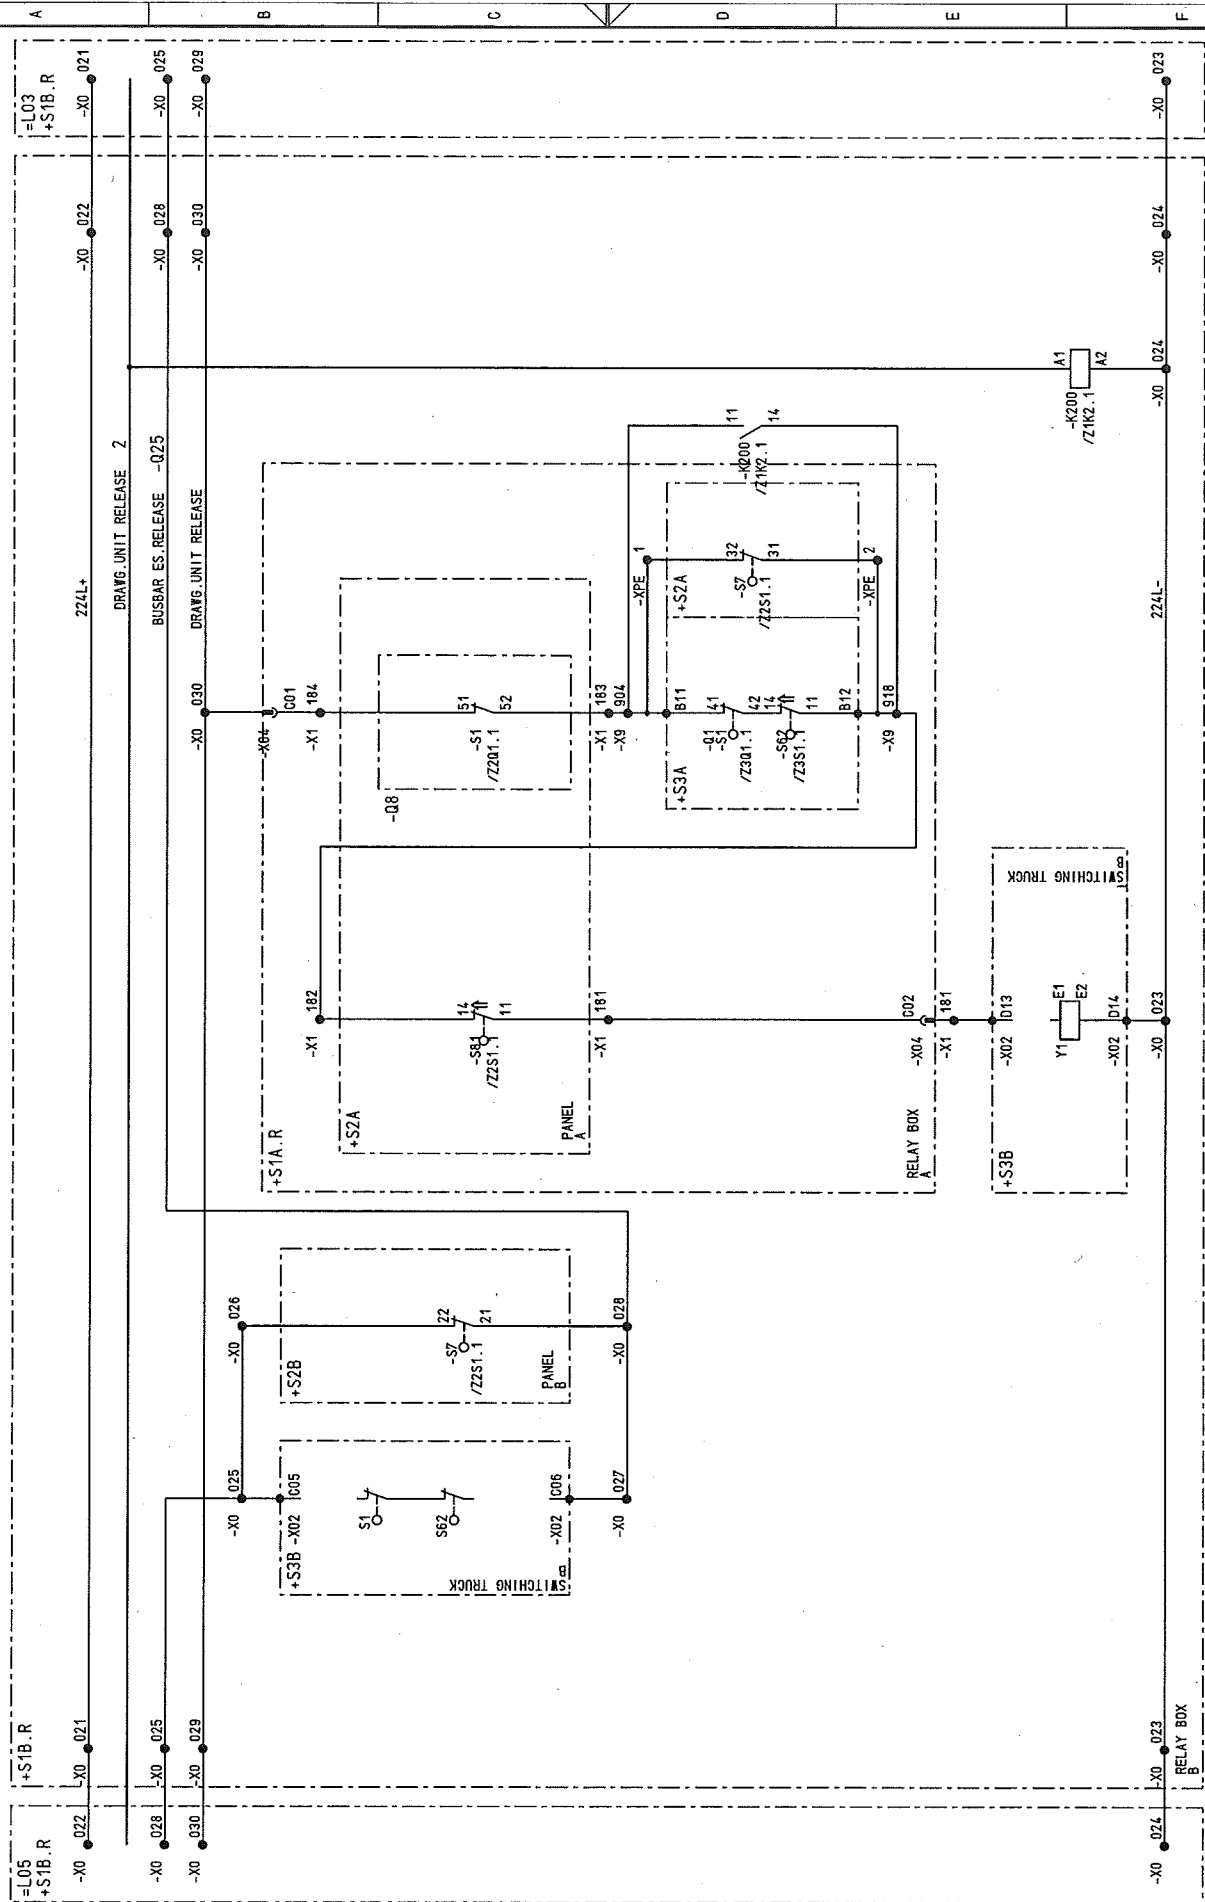




03	AS BUILT	05.12.2005	AD	Date	13.07.2005	US STEEL KOSICE/SLOVAKIA		CIRCUIT DIAGRAM POSITION INDICA. PANEL	50.3023.01.43.741.226	S=04	
02	Fact.-Rev.	09.11.2005	AD	Drawn	Brüner t	50.3023.01					
01	Approval	20.09.2005	AD	Check	Adam	SUBSTATION T80					
ING.	Alteration	Date	Name	Std.		Orig.:	iss.for	iss.by:	04	Typ: 09 MOTOR FEEDER	Sheet 21 985h
D009781.02.604-3.AHA											

Copyright as per DIN 34 to be observed!

FIELD 04
HJ0115ND
005
ADAM


03	AS BUILT	05.12.2005	AD	Date	13.07.2005	US STEEL KOSTICE/SLOVAKIA	CIRCUIT DIAGRAM	50.3023.01.A3.741.225	S=L04	/005
02	Fact.-Rev.	06.11.2005	AD	Drawn	Bräunert	50.3023.01	INTERFACE			
01	Approval	20.09.2005	AD	Check	Adam	SUBSTATION T80	PANEL			
NO.	Alteration	Date	Name	Std.	Orig.	Iss. for	Iss. by:			
1										
2										
3										
PROTECTION EARTH GPF PROTECTION ARC DETECTOR ARC DETECTOR
TRIPPING RELEASE START ALARM START FAULT TRIPPING RELEASE FAULT

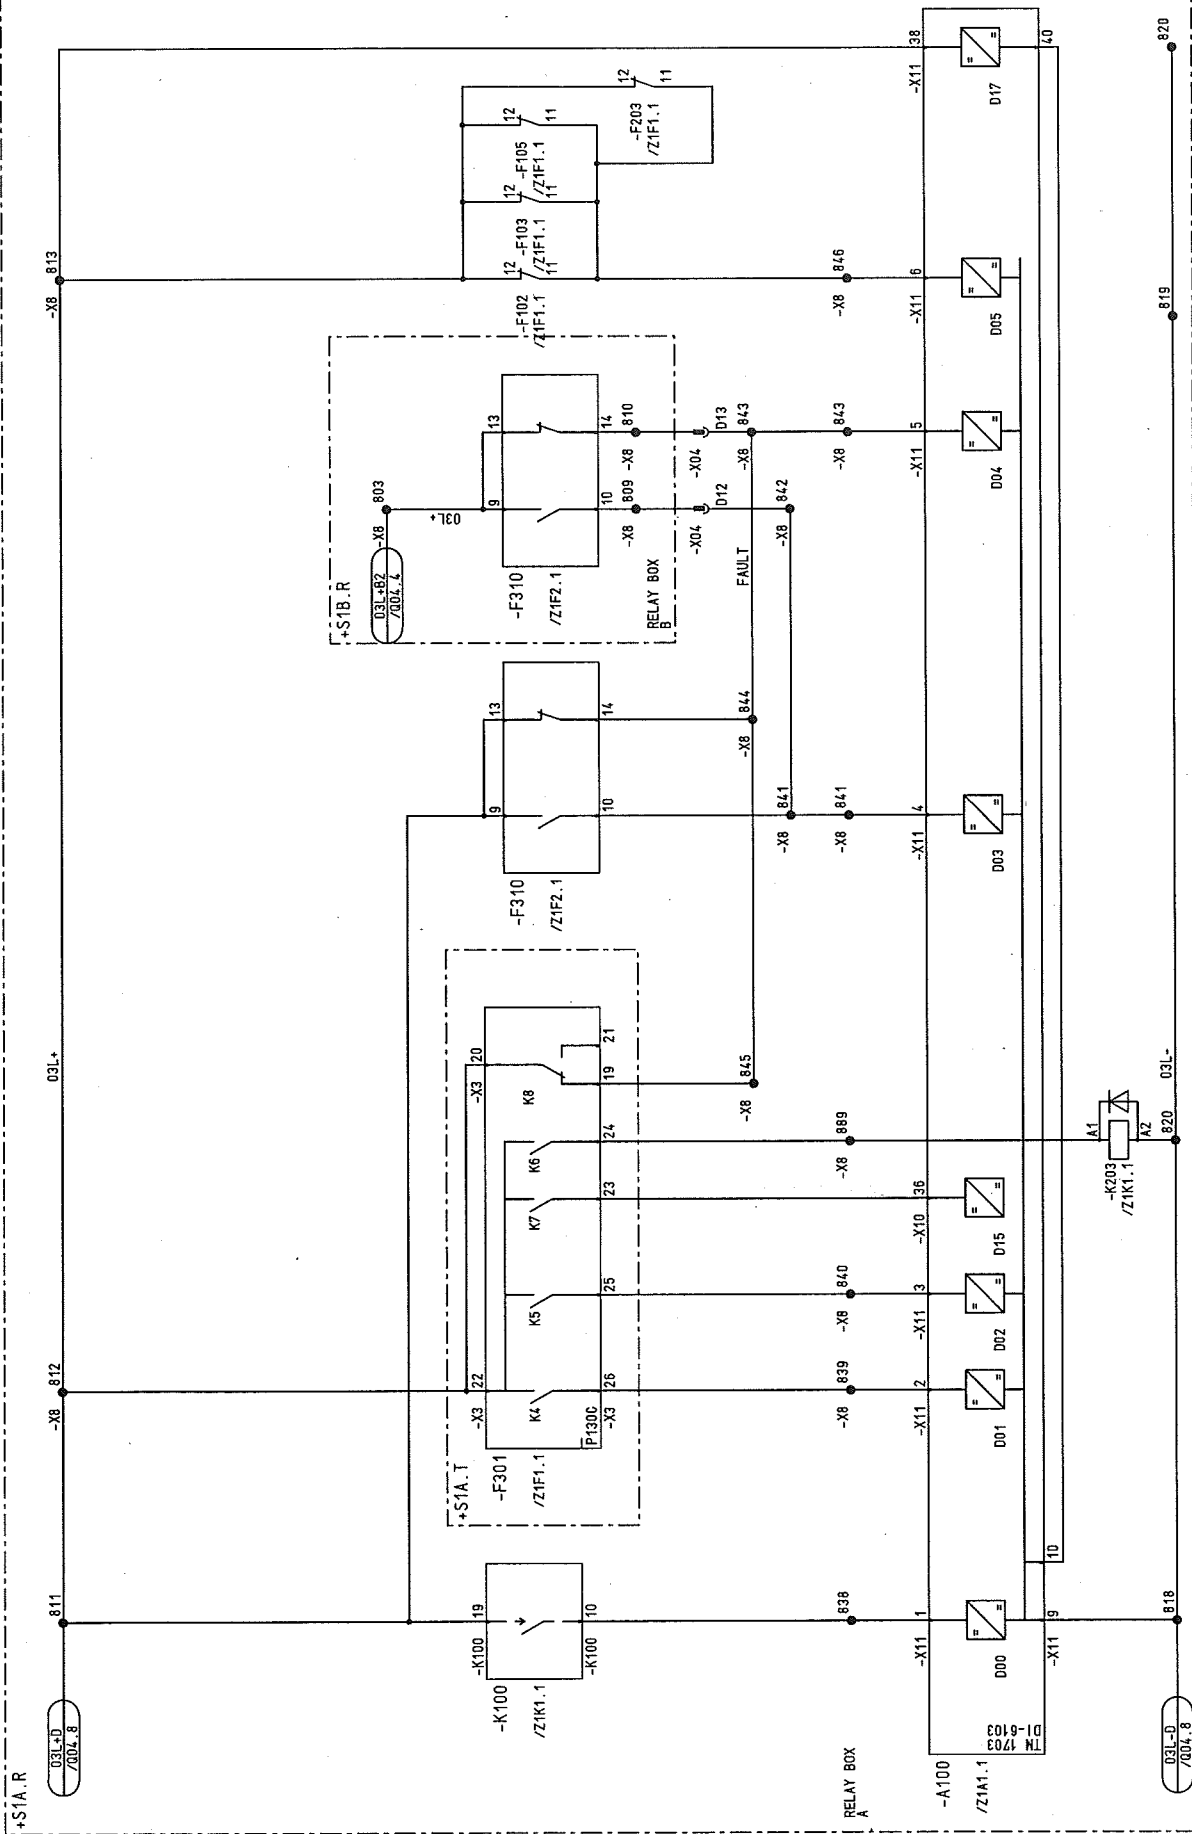

A	B	C	D	E	F
---	---	---	---	---	---

MEASUREMENT	
VOLTAGE	POWER
CURRENT	ACTIVE POWER REACTIVE POW..

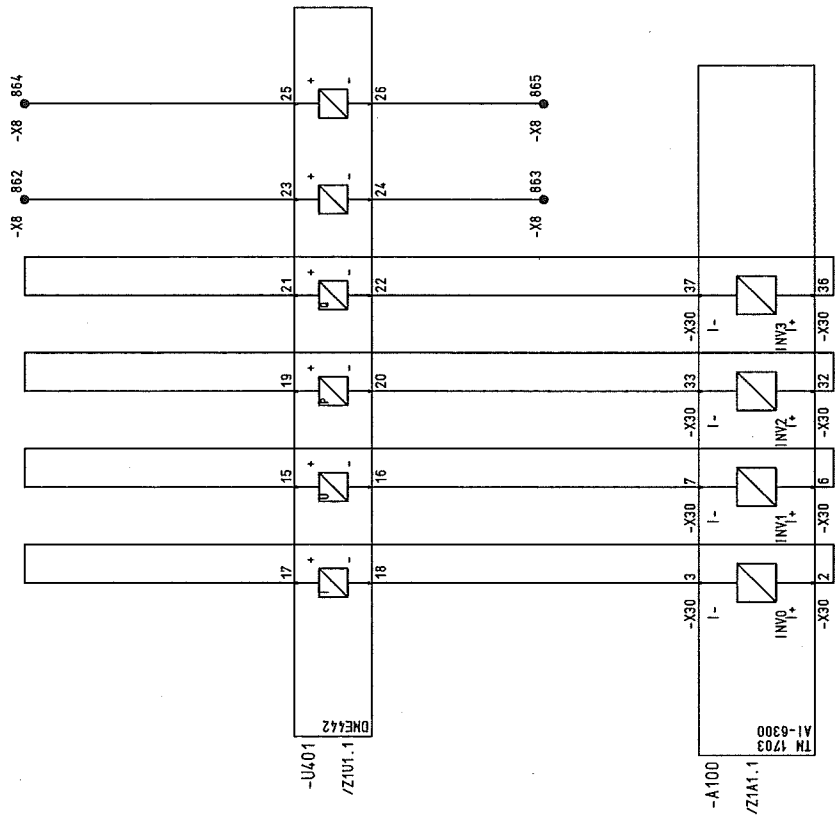

+S1A.R

RELAY BOX

03	AS BUILT	05.12.2005	AD	Date	13.07.2005	US STEEL KOSTICE/SLOVAKIA	 AREVA	CIRCUIT DIAGRAM		50.3023.01.A3.741.226		S=L04
02	Fact.-Rev.	08.11.2005	AD	Drawn	Brünnert	50.3023.01		INTERFACE		Typ: 09		/ Q06
01	Approval	20.03.2005	AD	Check	Adam	SUBSTATION T80		PANEL		MOTOR FEEDER		Sheet 26
NO.	Alteration	Date	Name	Std.	Orq:	Iss. for	Iss. by:	04	D009781.02.604-3.AHA		98Sh.	
		1			2	3	4	5	6	7	8	

Copyright as per DIN 34 to be observed!

FELD 04

HJ015MD
L04
007
ADAM


RELAY BOX

03	AS BUILT	05.12.2005 AD	Date	13.07.2005	US STEEL KOSICE/SLOVAKIA
02	Fact.-Rev.	08.11.2005 AD	Drawn/Brünnert	50.2023.01	
01	Approval	28.09.2005 AD	Check/Adam	SUBSTATION T80	
NO.	Alteration	Date	Name/Std.	Orig.	Iss. for



CIRCUIT DIAGRAM
SPARE CONTACTS
PANEL

50.3023.01.A3.741.226
S=L04
Typ: 09
MOTOR FEEDER
D009781.02.604-3.AHA
Sheet 27
98Sh.

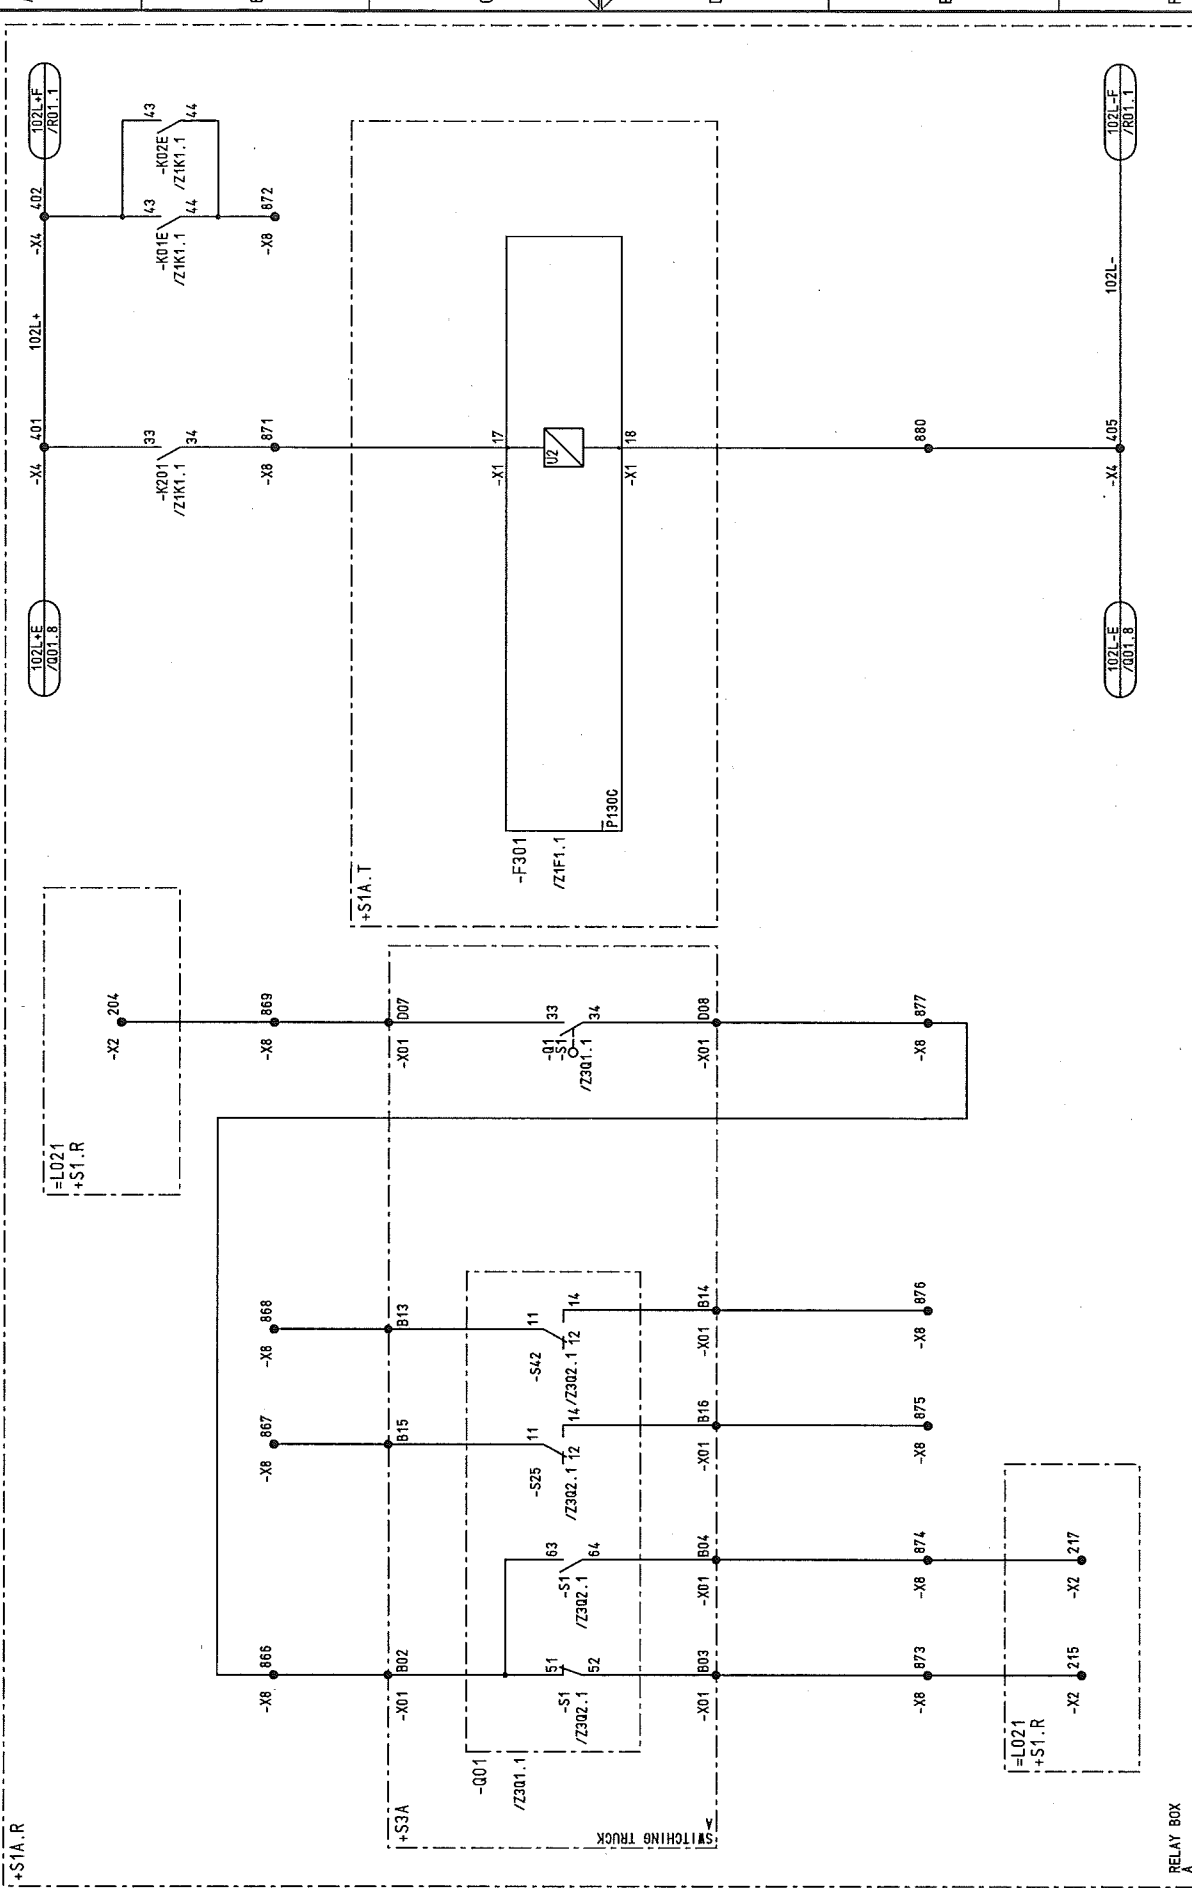

free
OUTPUT


TRUCK POS.
SERVICE POSITION

ACTUATION
ON/OFF

CIRCUIT-BREAKER
ON OFF


POSITION INDICA.

SPARE CONTACTS
001

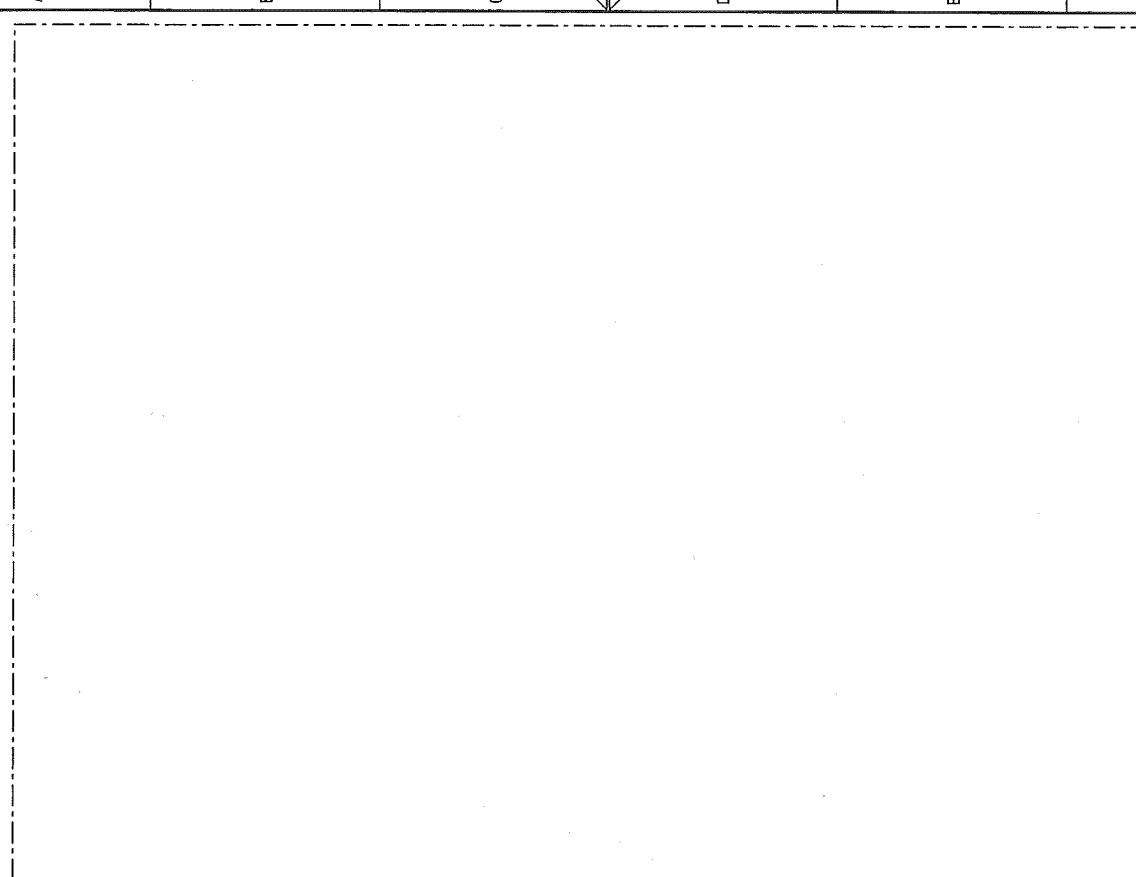

HJ0115MD
=L04
008
ADAM

33	AS BUILT	06.12.2005	AD	Date	13.07.2005	US STEEL KOSTICE/SLOVAKIA	 AREVA	CIRCUIT DIAGRAM		S = L04
32	Fact.-Rev.	09.11.2005	AD	Drawn	Brünert	50_3023_01		SPARE CONTACTS		
31	Approval	20.09.2005	AD	Check	Adam	SUBSTATION T60		PANEL		
NO.	Alteration	Date	Name	Sig.		Orig.	iss. for	iss. by:	04	Typ: 09 MOTOR FEEDER D009781_02_604-3_AHA 98Sh.

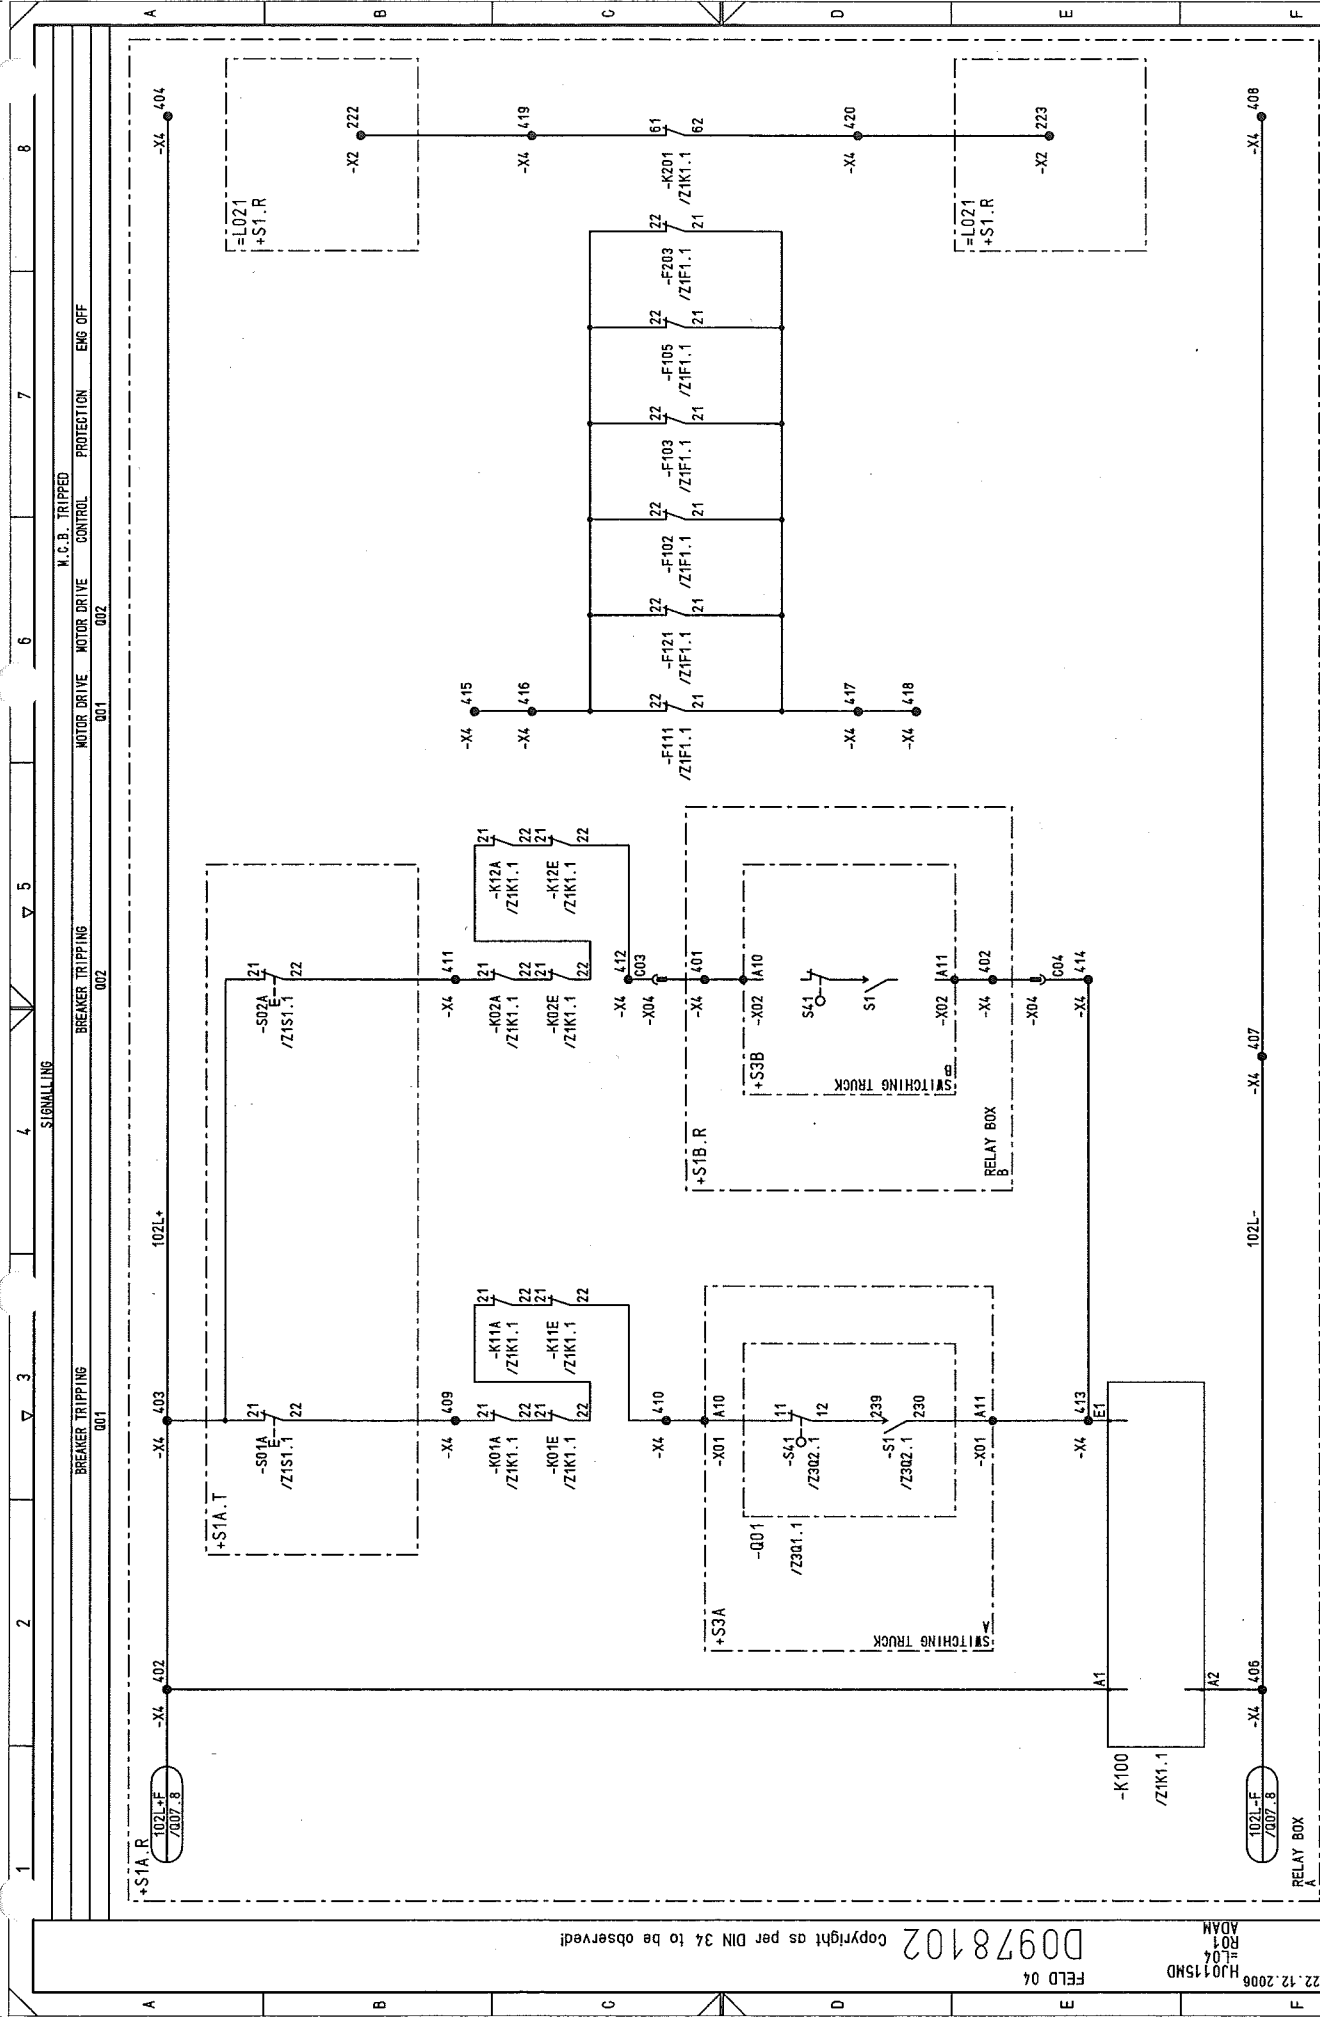

NO.		Alteration	Date	Name/Std.	Iss. for	Iss. by:	PANEL		SIGNALLING		CIRCUIT DIAGRAM		50.3023.01.A3.741.226		S1=L04		/ R01		Sheet29		98Sh.		8	
03		AS BUILT	06.12.2005	AD	Date	13.07.2005	US STEEL KOSTICE/SLOVAKIA		50.3023.01		SIGNALLING		50.3023.01.A3.741.226		S1=L04		/ R01		Sheet29		98Sh.		8	
02		Fact.-Rev.	08.11.2005	AD	Drawn	Brünnert	50.3023.01		SUBSTATION T80		PANEL		50.3023.01.A3.741.226		S1=L04		/ R01		Sheet29		98Sh.		8	
01		Approval	28.09.2005	AD	Check	Adam	50.3023.01		SUBSTATION T80		PANEL		50.3023.01.A3.741.226		S1=L04		/ R01		Sheet29		98Sh.		8	
00		Alteration	Date	Name/Std.	Iss. for	Iss. by:	PANEL		SIGNALLING		CIRCUIT DIAGRAM		50.3023.01.A3.741.226		S1=L04		/ R01		Sheet29		98Sh.		8	

Copyright as per DIN 34 to be observed!

22.12.2006
HJ015ND
L04
R01
ADAM


FELD 04

D00978102

1 2 3 4 5 6 7 8


METERING CURRENT MEASUREMENT

L1 L2 L3 N

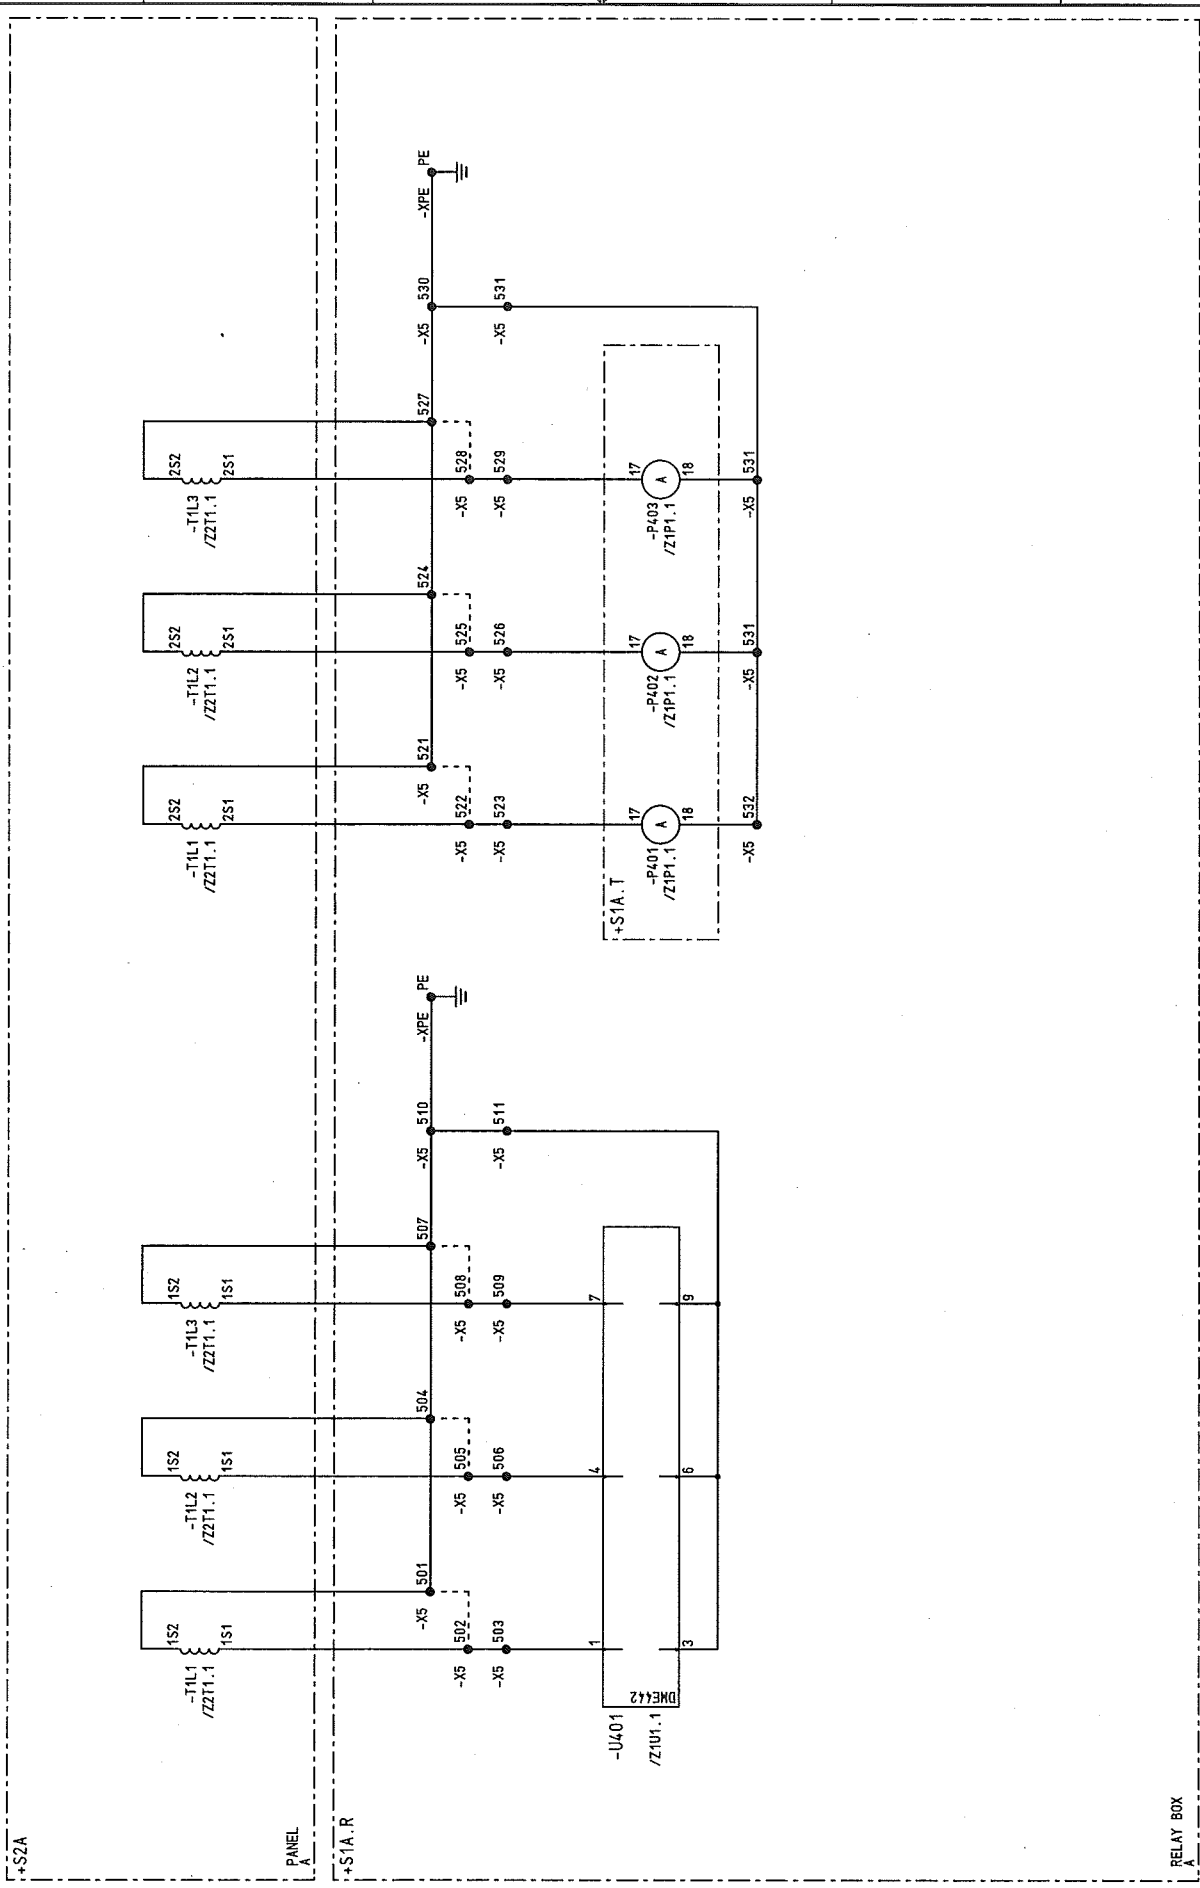

22.12.2008		HJ015MD		S01		L04		ADAM		FIELD 04		D00978102		Copyright as per DIN 34 to be observed!	
03	AS BUILT	05.12.2005	AD	Date	13.07.2005	US STEEL KOSICE/SLOVAKIA		CIRCUIT DIAGRAM		50.3023.01.A3.741.226		S=104		/ S01	
02	Fact.-Rev.	08.11.2005	AD	Drawn	Brünnert	50.3023.01		CURR. TRANSF.							
01	Approval	20.09.2005	AD	Check	Adam	SUBSTATION T80		PANEL		04					
NO.	Alteration	Date	Name	Std.	Iss.	for	Iss.	by	Iss.	by	Iss.	by	D009781.02.604-3.AHA		98SL

1 2 3 4 5 6 7 8

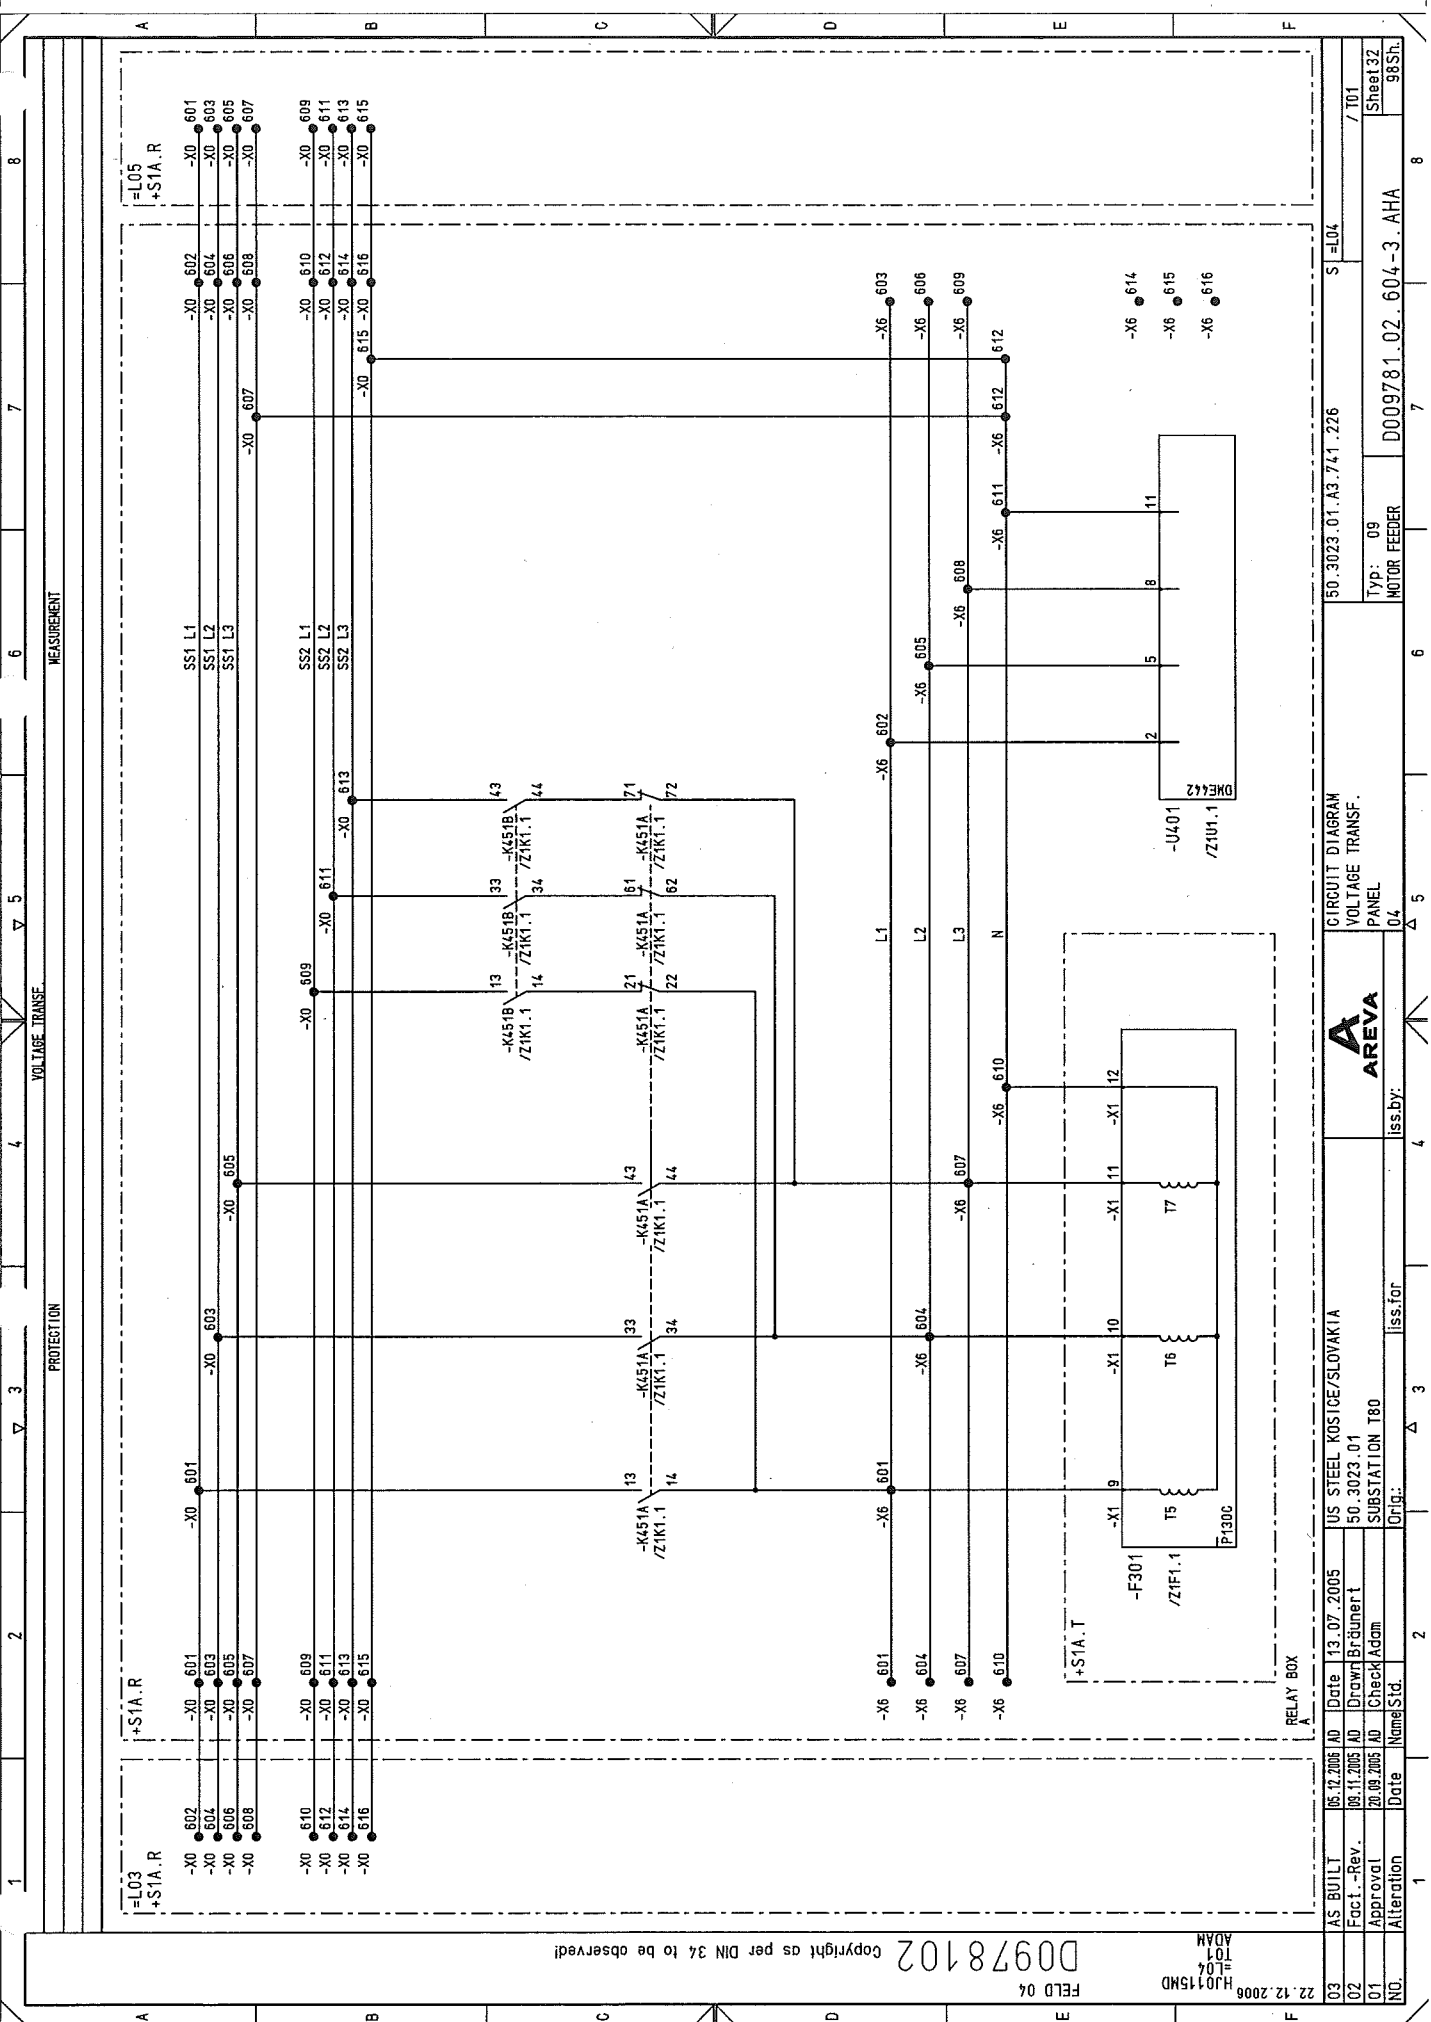

MEASUREMENT

PROTECTION

VOLTAGE TRANSF.


03	AS BUILT	06.12.2005	AD	Date	13.07.2005	US STEEL KOSTICE/SLOVAKIA	CIRCUIT DIAGRAM	50.3023.01.A3.741.226	S=L04	/ 101
02	Fact.-Rev.	06.11.2005	AD	Drawn	Brüner	50.3023.01	VOLTAGE TRANSF.			
01	Approval	26.09.2005	AD	Check	Adam	SUBSTATION T80	PANEL			
NO	Alteration	Date	Name	Std.	Iss.	For	Iss.	By		
1										
2										
3										
Copyright as per DIN 34 to be observed!


00978102

22.12.2006
HJ015MD
T01
ADAM

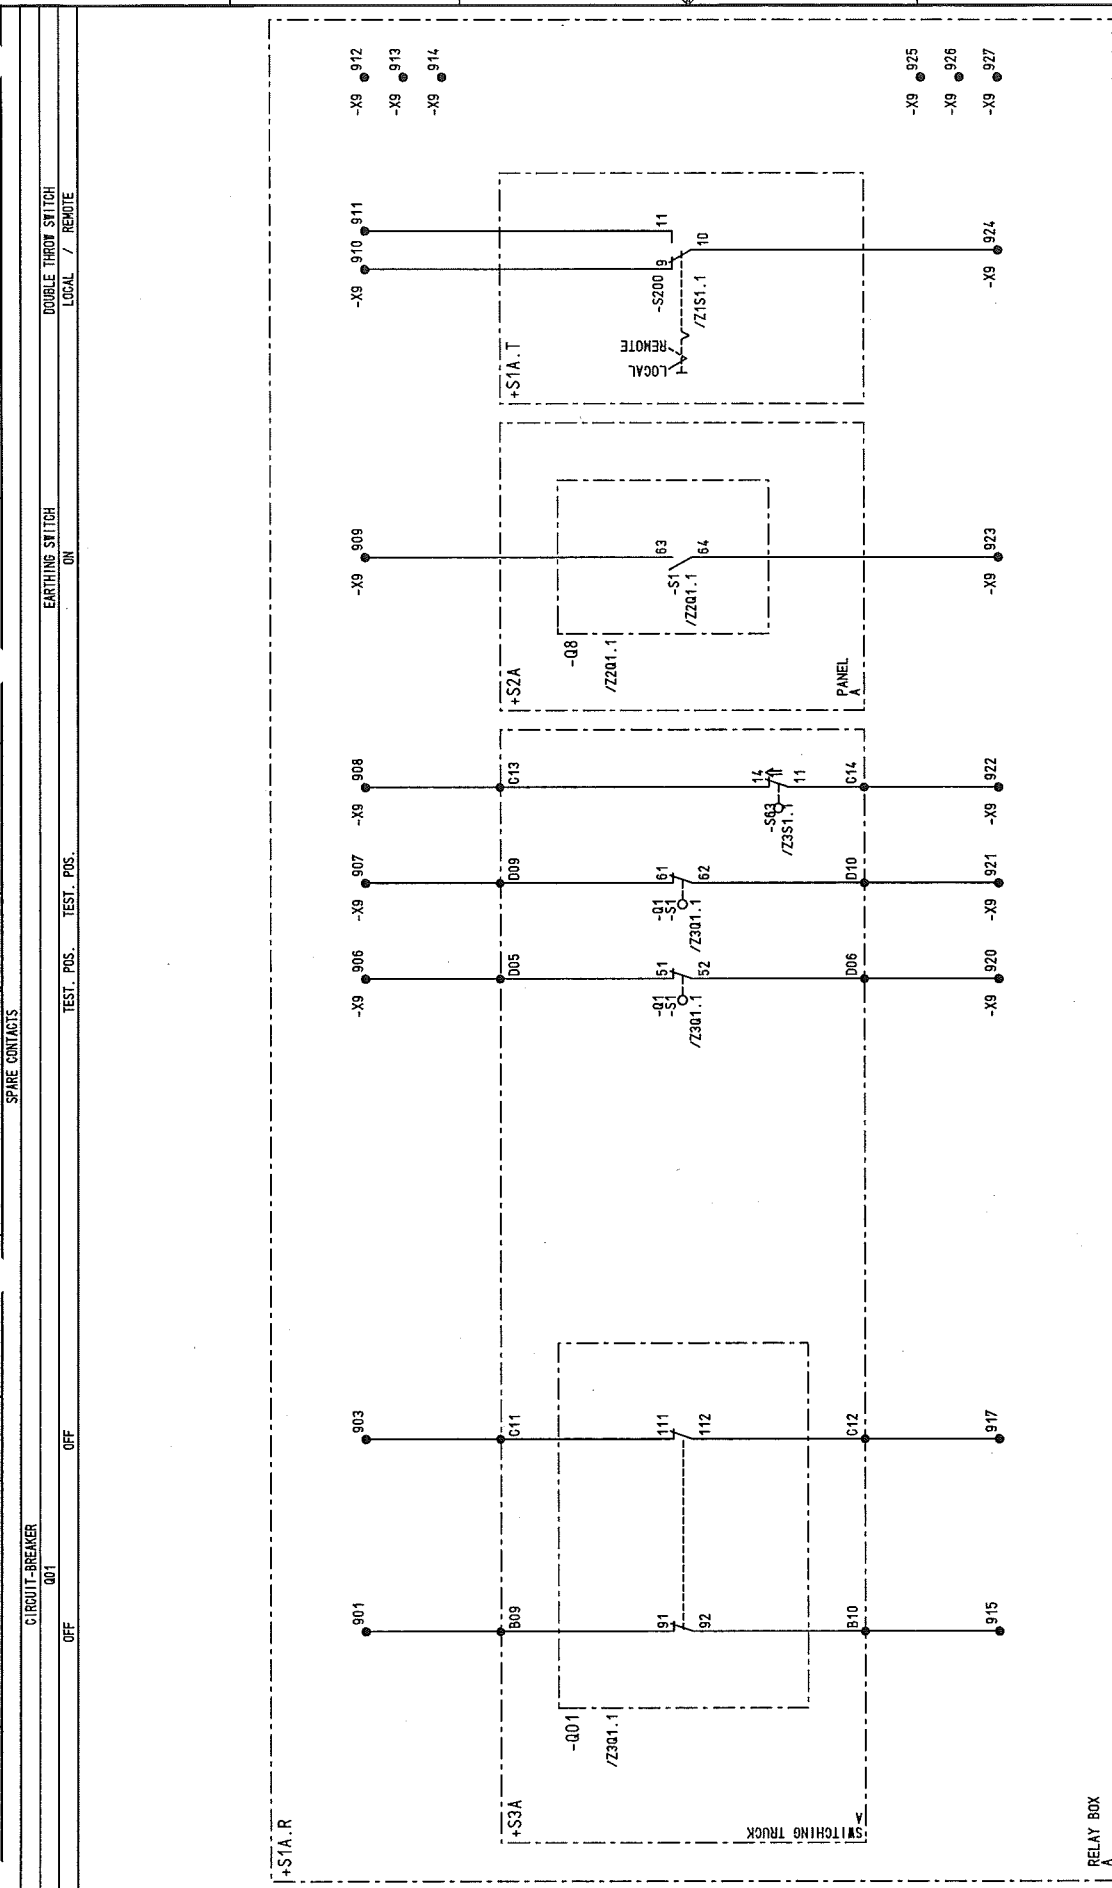FELD 04



03	AS BUILT	06.12.2005	AD	Date	13.07.2005	US STEEL KOSICE/SLOVAKIA		CIRCUIT DIAGRAM SPARE CONTACTS PANEL	50.3023.01.A3.741.226	S=L04	/ V01
02	Fact.-Rev.	09.11.2005	AD	Drawn	Brüner t	50.3023.01					
01	Approval	20.09.2005	AD	Check	Adam	SUBSTATION T80					
NO.	Alteration	Date	Name	Std.	Ortg.	Iss.for					
1.					2	3	4	5	6	7	8
											
Iss.by: 04 MOTOR FEEDER											
D009781.02.604-3.AHA 98Sh.											

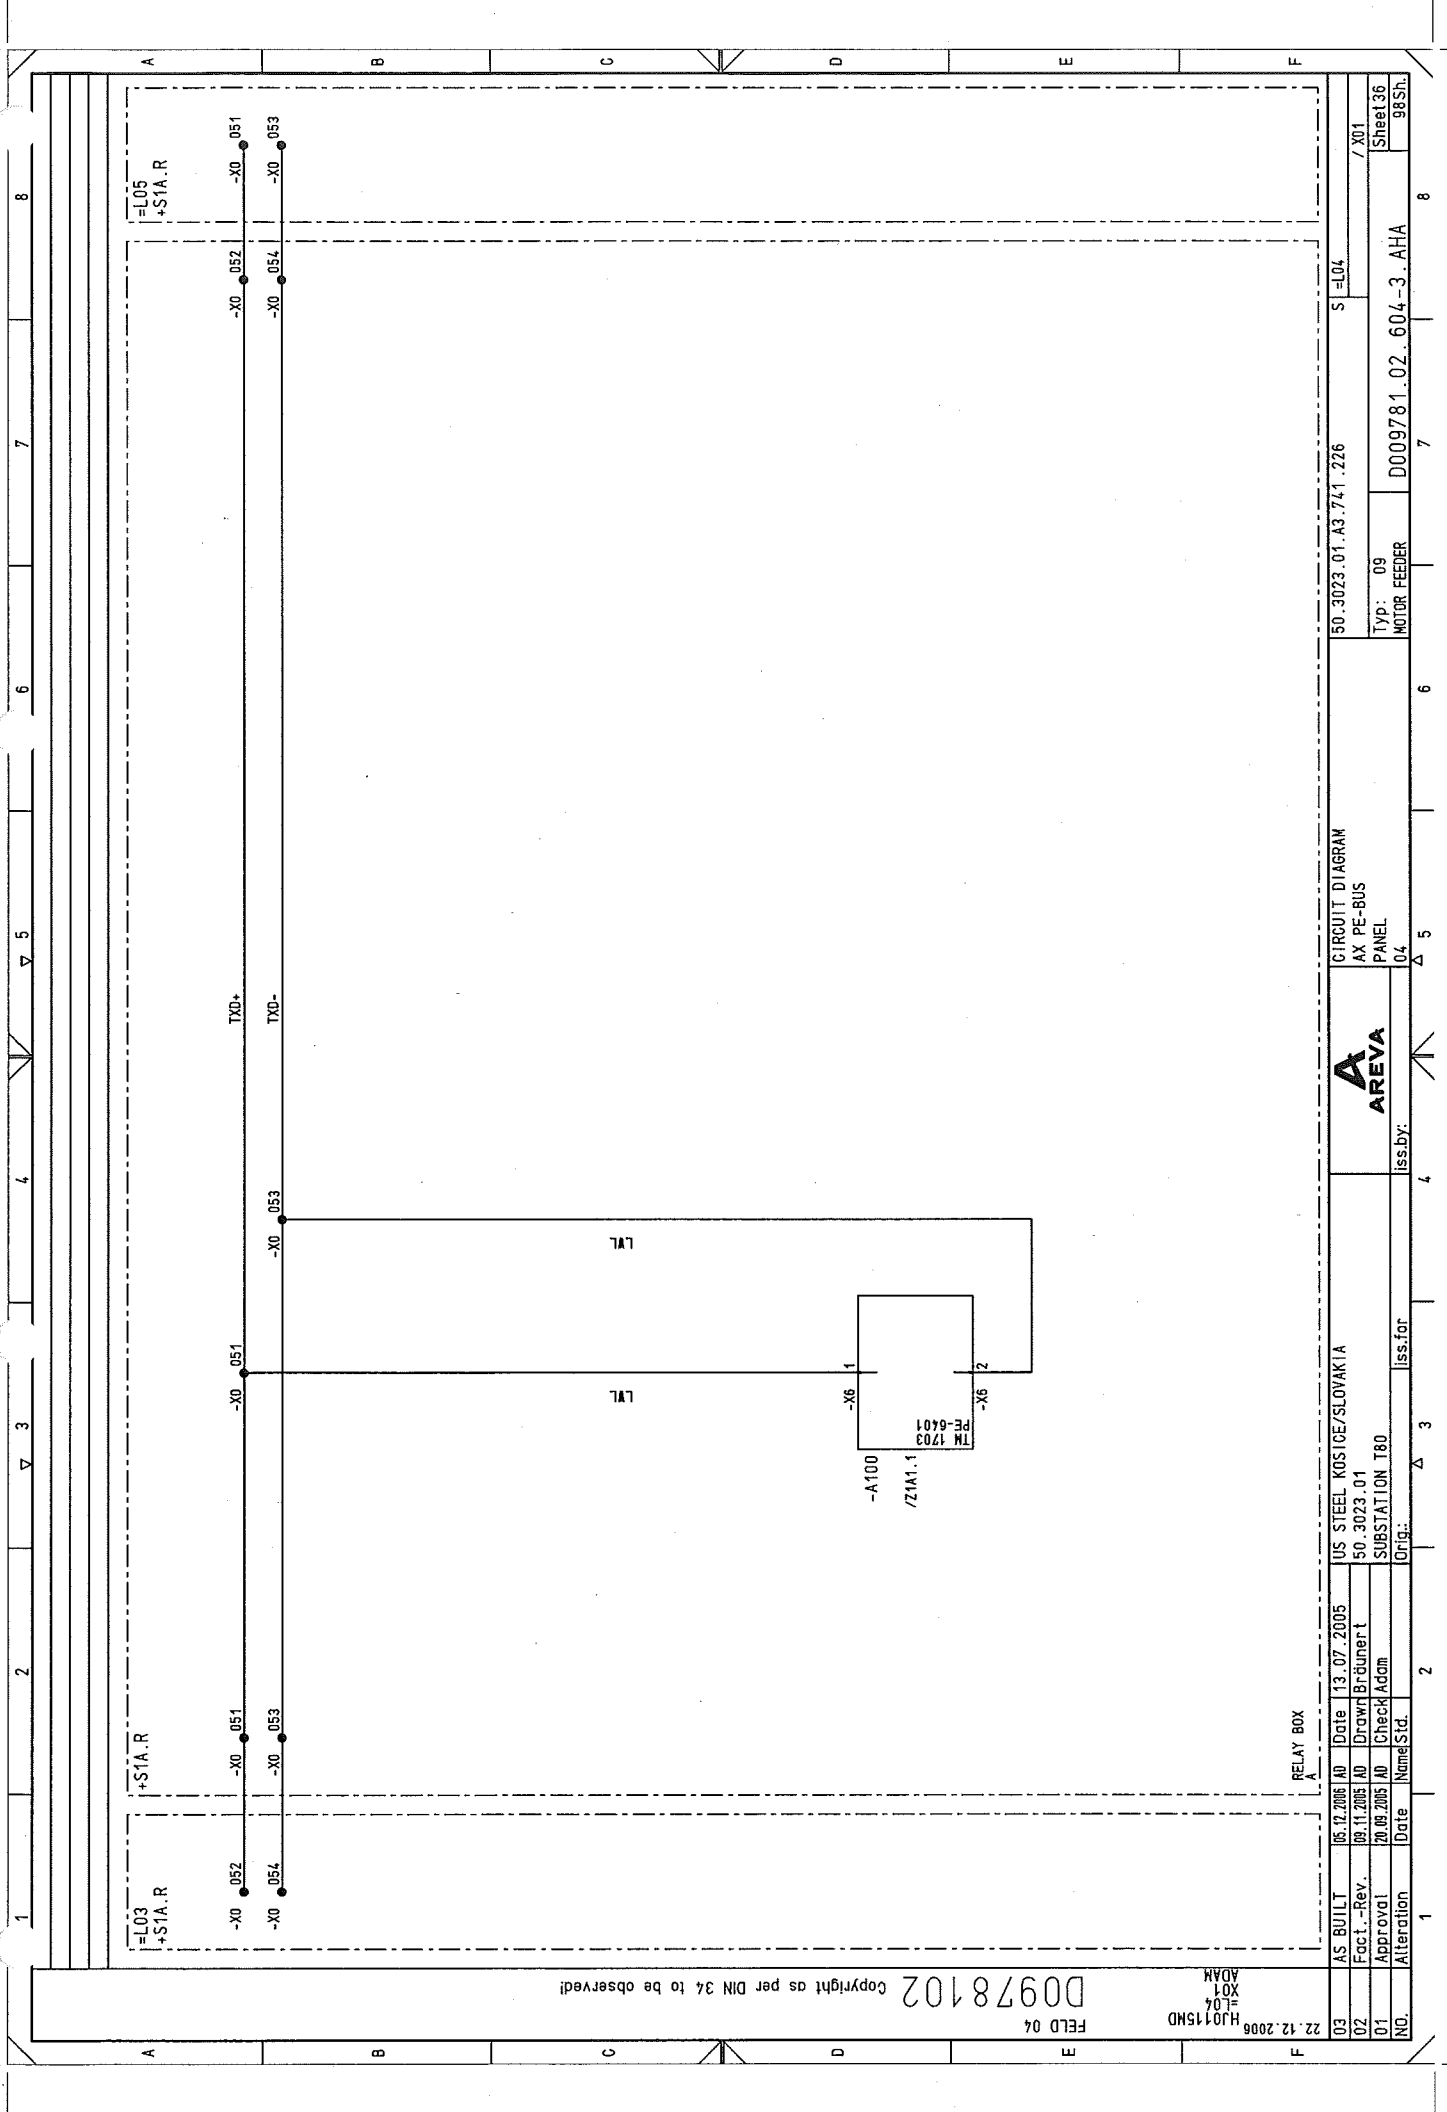


Copyright as per DIN 34 to be observed!

03	AS BUILT	05.12.2005	AD	Date	13.07.2005	AD	US STEEL KOSICE/SLOVAKIA	50.3023.01	A3.741.226	S=L04	/X01	Sheet 36
02	Fact.-Rev.	09.11.2005	AD	Drawn	Bräuner t	AD	50.3023.01	50.3023.01	A3.741.226	S=L04	/X01	Sheet 36
01	Approval	20.09.2005	AD	Check	Adm	AD	SUBSTATION T80	50.3023.01	A3.741.226	S=L04	/X01	Sheet 36
NO.	Alteration	Date	Name	Std.	Iss.	for	Iss.	by:	AX PE-BUS	PANEL	04	98SL
NO.	Alteration	Date	Name	Std.	Iss.	for	Iss.	by:	MOTOR FEEDER	D009781.02.604-3.AHA	8	98SL

[illegible]


peripheral control module
PE-6401

```
graph LR
    CPU[CPU] <-->|TN-BUS| PROM[PROM]
    CPU <-->|TN-BUS| RAM[RAM]
    CPU <-->|TN-BUS| PPOA[PPOA]
    PPOA --- BUSCONTROLLER-ASIC[BUSCONTROLLER-ASIC]
    BUSCONTROLLER-ASIC --- BUS[ ]
    style CPU fill:#fff,stroke:#000
    style PROM fill:#fff,stroke:#000
    style RAM fill:#fff,stroke:#000
    style PPOA fill:#fff,stroke:#000
    style BUSCONTROLLER-ASIC fill:#fff,stroke:#000
    style BUS fill:none,stroke:#000,stroke-width:2px
```

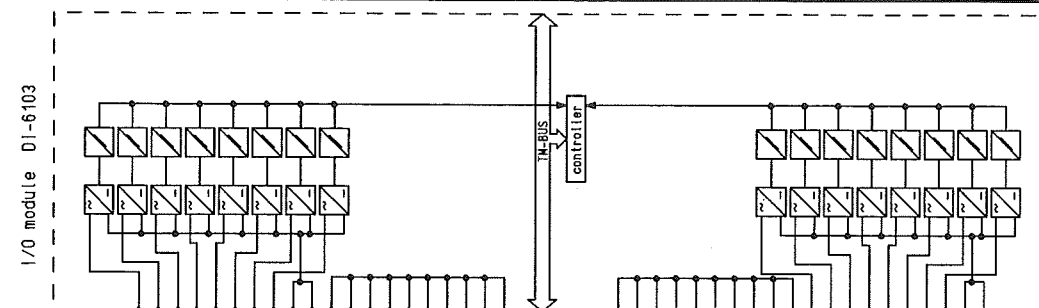
[illegible]

50.3023.01.A3.741.226	S	=L04
Type: 09 MOTOR FEEDER		/ Z1A10
D009781.02.604-3.AHA		Sheet 38
		98Sh.

I/O module DO-6212

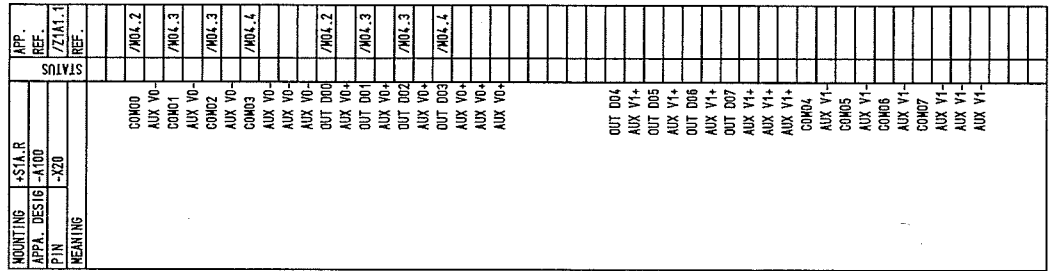

I/O module AI-6300

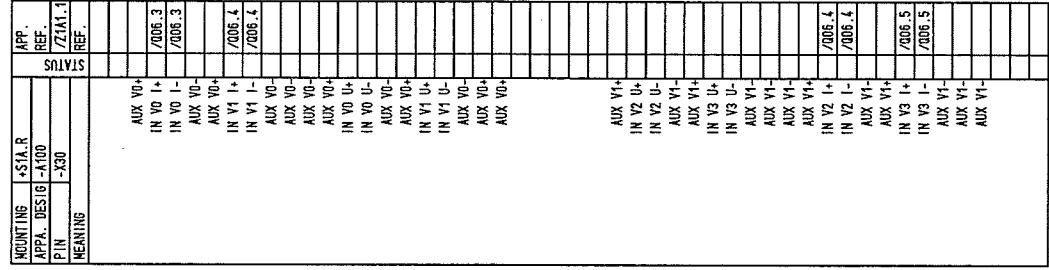

Copyright as per DIN 34 to be observed!

FIELD 04
Z1A11
ADAM

03	AS BUILT	05.12.2005	AD	Date	13.07.2005	US STEEL KOSICE/SLOVAKIA	LIST OF EQUIPMENT	50.3023.01.A3.741.226	S=L04	/Z1A11
02	Fact.-Rev.	09.11.2005	AD	Drawn	Brünnert	50.3023.01				
01	Approval	20.09.2005	AD	Check	Adam	SUBSTATION T80	PANEL	D009781.02.604-3.AHA	Typ: 09	Sheet 39
NO.	Alteration	Date	Name	Std.	Iss. for	Orig.	Iss. by:	MOTOR FEEDER		98 Sh.

AREVA

[illegible]

Pin Functions:


Pin	Function	Symbol
1	LEITERSTROM I1	
2	LEITERSTROM I2	
3	LEITERSTROM I3	
4	ERDSTROM IE	
5	SPANNUNG U1E	
6	SPANNUNG U2E	
7	SPANNUNG U3E	
8	HILFSSPANNUNG	
9		
10		
Internal Wiring Diagrams:

- PC-SCHNITTSTELLE:** Shows connections for pins 1-18 to various components like T1-T7, U1, U2, and PE.
- IR16-9:** Shows connections for pins 19-36 to components like K1-K8, X/Y, and RS 232.
- IR16-9:** Shows connections for pins 37-48 to components like U17-U23, X/Y, and RS 485.

Pinout Table:

Pin	Function	Symbol
1	LEITERSTROM I1	
2	LEITERSTROM I2	
3	LEITERSTROM I3	
4	ERDSTROM IE	
5	SPANNUNG U1E	
6	SPANNUNG U2E	
7	SPANNUNG U3E	
8	HILFSSPANNUNG	
9		
10		
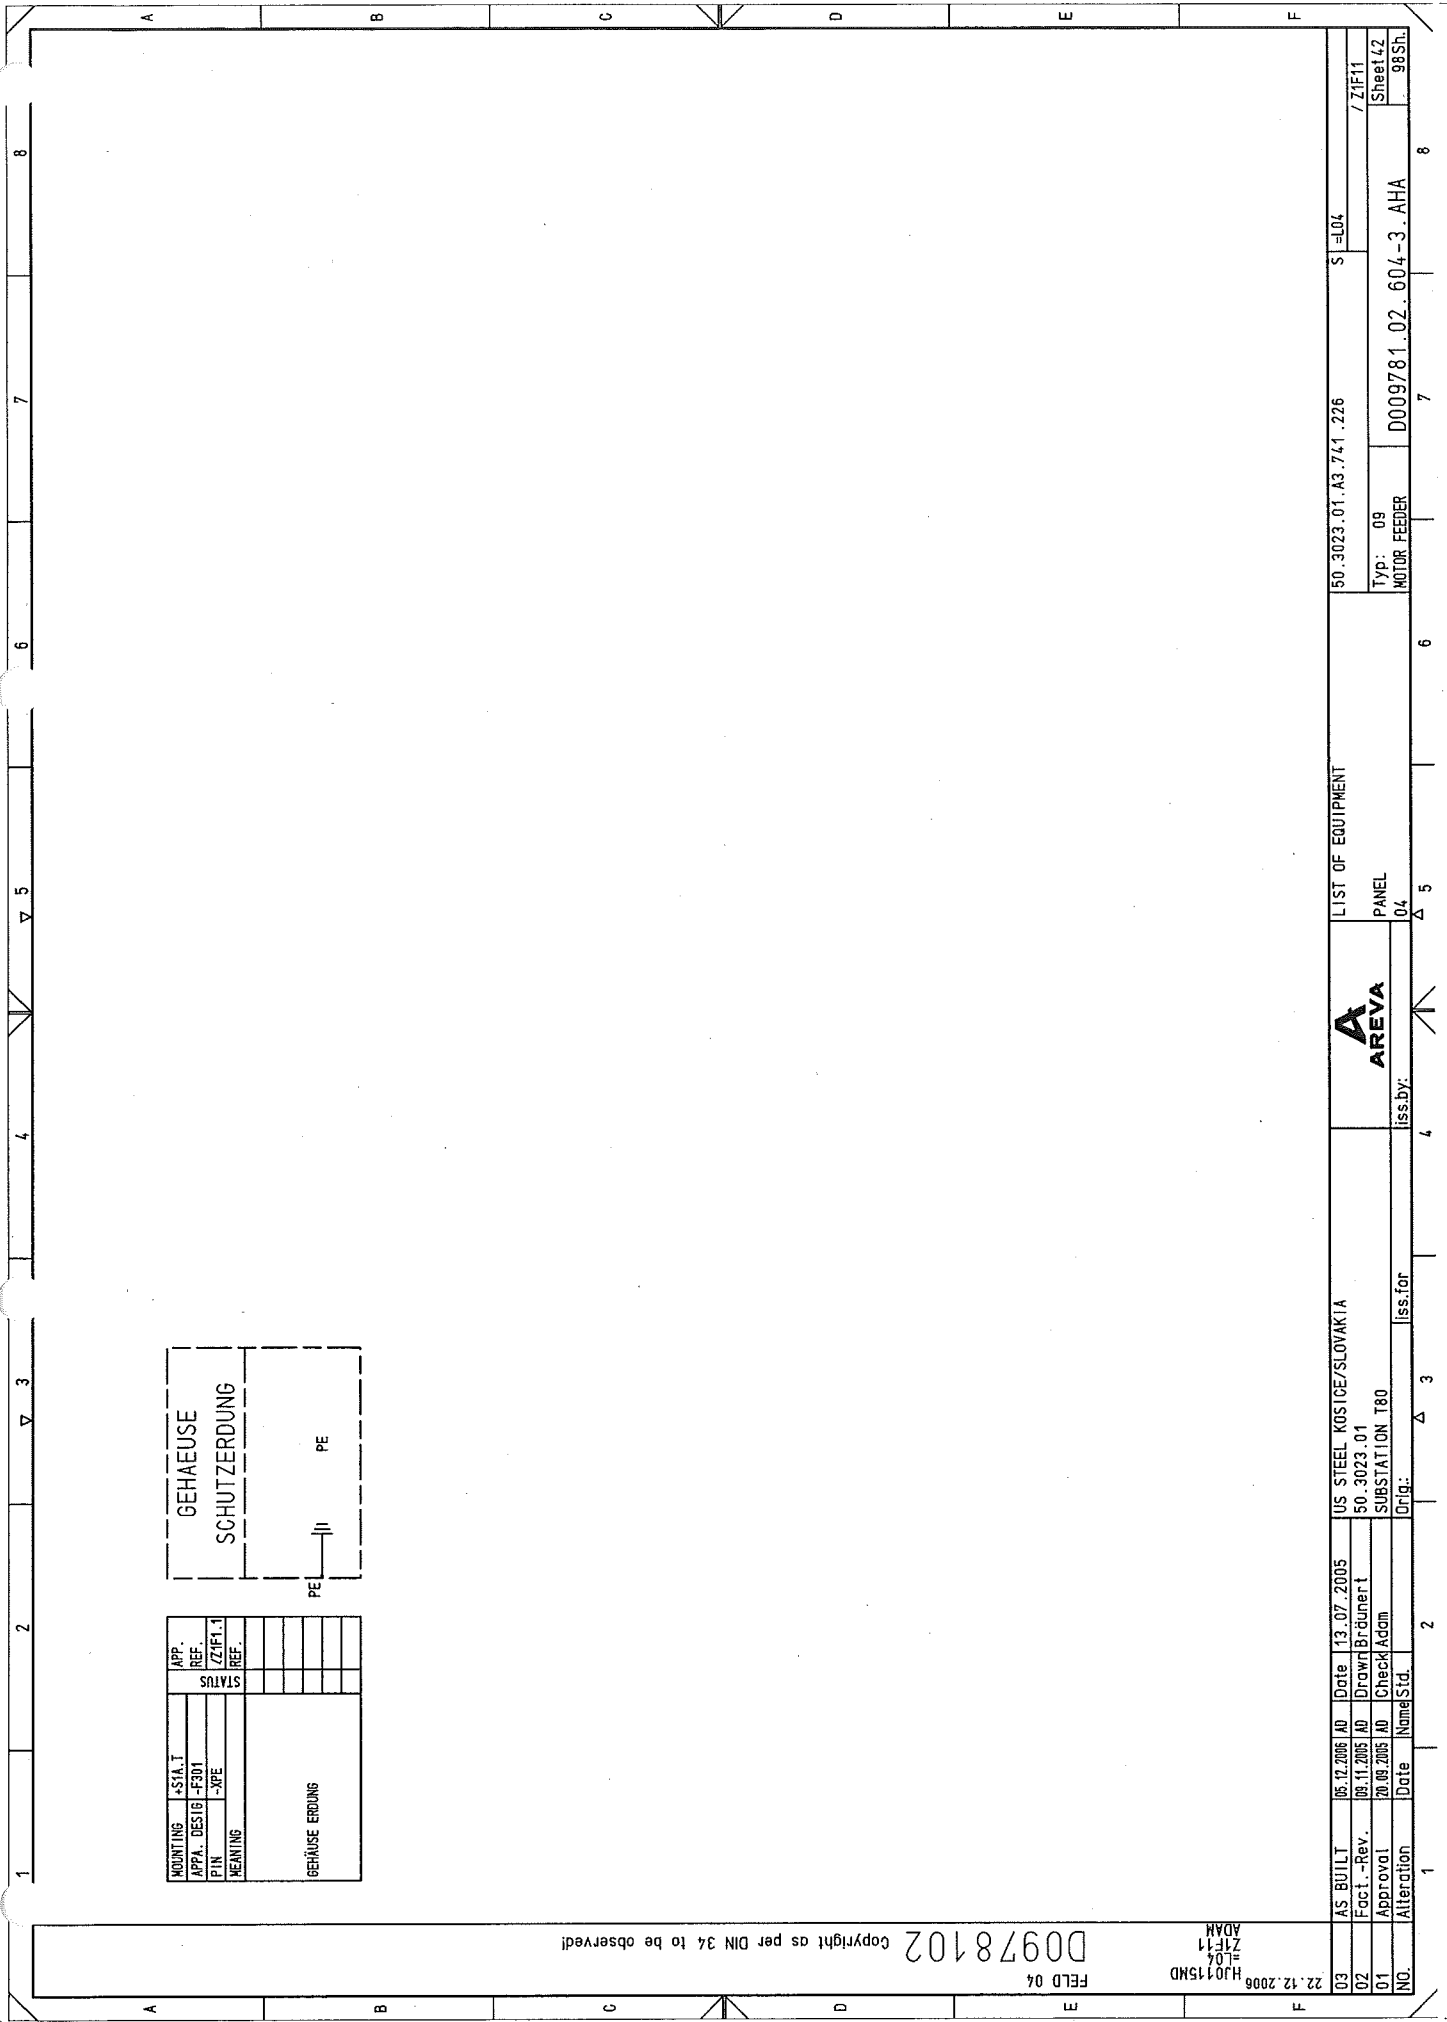

MOUNTING	+S1A.1	APP.
APPA. DESIG	-F201	REF.
PIN	-YPE	ZZIF1.1
MEANING		REF.
GEHÄUSE ERDUNG		
STATUS		
REF.		
PE		
PE		

GEHÄUSE
SCHUTZERDUNG
PE

Copyright as per DIN 34 to be observed!

D00978102


22.12.2006
HJ0115MD
ZIF11
LO4
ADAM

FELD 04

03	AS BUILT	05.12.2005 AD	Date	13.07.2005	US STEEL KOSTICE/SLOVAKIA	LIST OF EQUIPMENT	50.3023.01.A3.741.226	S=L04	/ ZIF11
02	Fact.-Rev.	09.11.2005 AD	Drawn	Brünnert	50.3023.01				Sheet 12
01	Approval	20.09.2005 AD	Check	Adom	SUBSTATION T80	PANEL	Typ: 09		Sheet 12
NO.	Alteration	Date	Name	Std.	Orig.	Iss. for	Iss. by:		98Sh.
1									
2									
3									
4									
5									
6									
7									
8									



AREVA

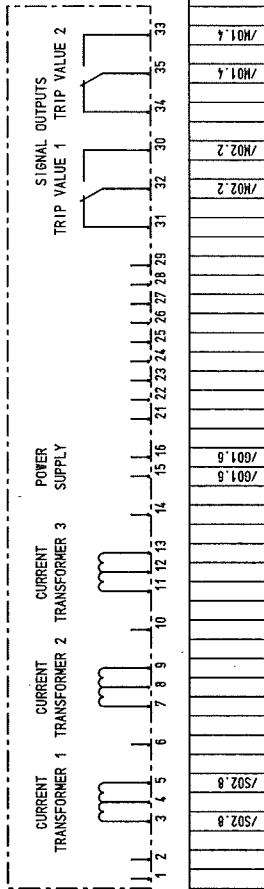

1		2		3		4		5		6		7		8	
STUCK-TITEL		DESCRIPTION, DESIGN, TECHNICAL DATA		MANUFACTURER, TYPE, ORDERING DATA		APPA. DESIG.		APPARATUS SYMBOL DIAGRAM		REFERENCE TO INDIVIDUAL TREATMENT		CIRCUIT DIAGRAM, SHEET NO., CIRCUIT NO.)		REMARK	
APPLICATION		SETTINGS		MOUNTING											
2	STELLUNGSMELDER	MANUF.: BRESSMO PO NO.: EST-L-1746-08-330-21		TYPE EST-L											
	RUECKMELDER	TRENNSCHALTER													
	: 220VAC/220VDC														
	TECHNICAL COMPONENTS		TYP												
		ORDER NO													
		APPLICATION		SETTINGS		MOUNTING		SYM IDENTIFIER							
		CIRCUIT-BREAKER	ON/OFF	+SIA.T		-H01									
		CIRCUIT-BREAKER	ON/OFF	+SIA.T		-H02									
2	STELLUNGSMELDER	MANUF.: BRESSMO PO NO.: EST-L-1746-08-231-21		TYPE EST-L											
	RUECKMELDER	SCHALTWAGEN													
	: 220VAC/220VDC														
	TECHNICAL COMPONENTS		TYP												
		ORDER NO													
		APPLICATION		SETTINGS		MOUNTING		SYM IDENTIFIER							
		SWITCHING TRUCK	SERVICE POS. TEST POS.	+SIA.T		-H01									
		SWITCHING TRUCK	SERVICE POS. TEST POS.	+SIA.T		-H02									
1	STELLUNGSMELDER	MANUF.: BRESSMO PO NO.: EST-L-1746-08-131-21		TYPE EST-L											
	RUECKMELDER	ERDER													
	: 220VAC/220VDC														
	TECHNICAL COMPONENTS		TYP												
		ORDER NO													
		APPLICATION		SETTINGS		MOUNTING		SYM IDENTIFIER							
		EARTHING SWITCH	OFF/ON	+SIA.T		-H8									

Copyright as per DIN 34 to be observed!

00978102

FIELD 04

NO. 01

Alteration

Date

Name

Std.

Check

Adm

Drawn

Brüner

50.3023.01

AS BUILT

05.12.2005

AD

Date

13.07.2005

AD

US STEEL KOSICE/SLOVAKIA

50.3023.01

Substation

T80

Orig.

Iss. for

Iss. by:

AREVA

LIST OF EQUIPMENT

50.3023.01.A3.741.226

S

=L04

Typ:

09

MOTOR FEEDER

D009781.02.604-3.AHA

Sheet 44

98 Sh.

03	AS BUILT	05.12.2005 AD	Date	13.07.2005	US STEEL KOSICE/SLOVAKIA	LIST OF EQUIPMENT	50.3023.01.A3.741.226	S	=L04	/ Z1H1		
02	Fact.-Rev.	09.11.2005 AD	Drawn	Bräunert	50.3023.01							
01	Approval	20.09.2005 AD	Check	Adcm	SUBSTATION T80							
NO.	Alteration	Date	Name	Std.	Orig.		Iss. by:		Typ: 09		MOTOR FEEDER	
					Iss. by:		PANEL 04		D009781.02.604-3.AHA		98Sh.	

[illegible]

[illegible]

[illegible]

AREVA

03	AS BUILT	05.12.2005	AD	Date	13.07.2005	US STEEL KOSICE/SLOVAKIA	 AREVA	LIST OF EQUIPMENT		50.3023.01.A3.741.226		S = L04
02	Fact - Rev.	09.11.2005	AD	Drawn	Brünnert	50.3023.01						
01	Approval	20.09.2005	AD	Checked	Adom	SUBSTATION T80		PANEL		Type: 09		
01	Approval	Date	Named	Std.		Orig.:		04		MOTOR FEEDER		
NO.								iss by:			D009781.02.604-3.AHA	

03	AS BUILT	05.12.2005	AD	Date	13.07.2005	US STEEL KOSICE/SLOVAKIA	 AREVA	LIST OF EQUIPMENT		50.3023.01.A3.741.226		S=L04		
02	Fact.-Rev.	09.11.2005	AD	Drawn	Bräuner t	50.3023.01								
01	Approval	20.09.2005	AD	Check	Adom	SUBSTATION T80			PANEL	Typ: 09			Sheet 50	/ Z8B1
NO.	Alteration	Date	Name	Std.		Orig.:	iss.for	iss.by:	04				D009781.02.604-3.AHA	98Sh.

						LIST OF EQUIPMENT		50.3023.01.A3.741.226		S=I04	
03	AS BUILT	05.12.2005	AD	Date	13.07.2005	US STEEL KOSICE/SLOVAKIA					
02	Fact.-Rev.	09.11.2005	AD	Drawn	Brünnert	50.3023.01					
01	Approval	20.09.2005	AD	Check	Adam	SUBSTATION T80					
NO.	Alteration	Date	Name	Std.		iss. for	04		D009781.02.604-3.AHA		
					Orig.:			iss. by:			
							PANEL		Type: 09		Sheet 51
							MOTOR FEEDER				98SD

[illegible]

33	AS BUILT	05.12.2006	AD	Date	13.07.2005	US STEEL KOSICE/SLOVAKIA	 AREVA	LIST OF EQUIPMENT		50_3023_01_A3_741_226		S=L04	
	Fact.-Rev.	09.11.2005	AD	Drawn	Brünnert	50_3023_01		PANEL					
11	Approval	20.09.2005	AD	Check	Adam	SUBSTATION T80		Typ: 09		MOTOR FEEDER		/ Z201	
NO.	Alteration	Date	Name	Std.		Orig.	iss. by:	04	D009781.02_604-3_AHA		98Sh.		

NO.	AS BUILT	06.12.2005	AD	Date	13.07.2005	US STEEL KOSICE/SLOVAKIA		LIST OF EQUIPMENT		50.3023.01.A3.741.226	S	=L04
02	Fact. -Rev.	09.11.2005	AD	Drawn	Bräunert	50.3023.01						/ Z2S1
01	Approval	20.09.2005	AD	Check	Adam	SUBSTATION T80		PANEL		Typ: 09		Sheet 54
	Alteration			Date	Name	Std.		Iss.by:		04	D009781.02.604-3.AHA	98Sh.

STOCK-TY		DESCRIPTION, DESIGN, TECHNICAL DATA APPLICATION		SETTINGS		MANUFACTURER, TYPE, ORDERING DATA		APPA. DESIG.		APPARATUS SYMBOL DIAGRAM REFERENCE TO INDIVIDUAL TREATMENT (CIRCUIT DIAGRAM, SHEET NO., CIRCUIT NO.)		REMARK	
3		CURR. TRANSF. 1000/1/1/1A		MANUF. : AEG PO NO. :		TYPE CT12							
TECHNICAL COMPONENTS													
APPLICATION													
CURR. TRANSF. L1		SETTINGS		MOUNTING		BTM IDENTIFIER							
				+S2A		-11L1							
CURR. TRANSF. L2				+S2A		-11L2							
CURR. TRANSF. L3				+S2A		-11L3							
4		CABLE-TYPE CT 60/1A		MANUF. : AEG PO NO. :		TYPE RKT 250/160							
TECHNICAL COMPONENTS													
APPLICATION													
CABLE-TYPE CT		SETTINGS		MOUNTING		BTM IDENTIFIER							
				+S2A		-191							
CABLE-TYPE CT				+S2A		-192							
CABLE-TYPE CT				+S2A		-193							
CABLE-TYPE CT				+S2A		-194							

00978102

Copyright as per DIN 34 to be observed

FIELD 04

ADAM

ZZ1

=L04

03	AS BUILT	05.12.2005 AD	Date	13.07.2005	US STEEL KOSICE/SLOVAKIA	LIST OF EQUIPMENT	50.3023.01.A3.741.226	S=L04
02	Fact.-Rev.	09.11.2005 AD	Drawn	Brudner t	50.3023.01	PANEL		/ZZT1
01	Approval	20.09.2005 AD	Check	Adom	SUBSTATION T80			
NO.	Alteration	Date	Named	Std.	Iss.by:	Iss.for	Orig.:	

009781.02. 604-3. AHA


Sheet 55

98Sh.

Typ: 09


MOTOR FEEDER

[illegible]

03	AS BUILT	05.12.2005	AP	Date	13.07.2005	US STEEL KOSTICE/SLOVAKIA		LIST OF EQUIPMENT			50_3023.01.A3.741.226	S=L04	/ 7304
02	Fact.-Rev.	09.11.2005	AP	Drawn	Brüner t	50_3023.01		PANEL			Typ: 09	Sheet 57	
01	Approval	20.09.2005	AP	Check	Adam	SUBSTATION T80		04			MOTOR FEEDER	D009781.02.604-3.AHA	
00	Alteration	Date	Name	Std.		Orlq:	iss.for	iss.by:					98Sh.

[illegible]

-S1 AUXILIARY SWITCH

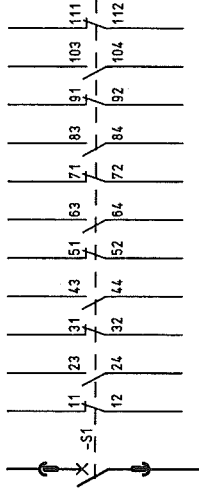


CIRCUIT-BREAKER


+S3A

-001

- S41 AUXILIARY CONTACT ON
PUSH-BUTTON ON/OFF
- S42 AUXILIARY CONTACT ON
PUSH-BUTTON ON/OFF
- F11 AUXILIARY TRIP RELEASE
- F12 AUXILIARY TRIP RELEASE
- F2 AUXILIARY CLOSING RELEASE
- S43 AUXILIARY CONTACT ON
PUSH-BUTTON OFF
- S21 AUX. CONTACT, ENERGY STORE
CONTROL
- AUXILIARY CONTACT
TRUCK INTERMEDIATE POSITION

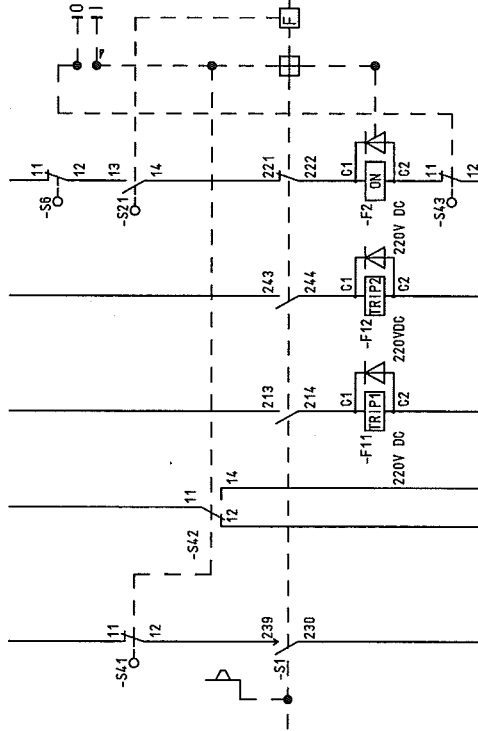

- AUXILIARY CONTACTS
ENERGY STORE MESSAGE
- AUXIL. CONTACTS
ENERGY STORE MESSAGE

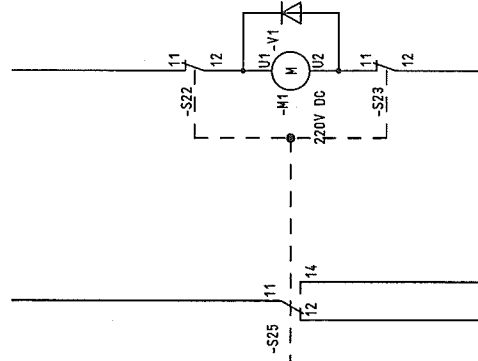

+S3A

/W01.7

/W01.6

/W01.5

/W01.4

/W01.3

/W01.2

/W01.1

/W01.0

/W01.0

US STEEL KOSTICE/SLOVAKIA



LIST OF EQUIPMENT

50.3023.01.A3.741.226

S1=L04

/Z302

Sheet 58

98Sh.

Substation T80

Iss. for

Panel

04

Typ: 09

MOTOR FEEDER

D009781.02.604-3.AHA

98Sh.

Copyright as per DIN 34 to be observed!

D00978102

FELD 04

HJ0115MD
Z302
L04

22.12.2006

AS BUILT 05.12.2005 AD Date 13.07.2005

Fact -Rev. 06.11.2005 AD Drawn Bräunert

Approval 20.08.2005 AD Check Adam

Alteration Date Name Std. Orig. Iss. for


Copyright as per DIN 34 to be observed

22.12.2006
HJO115MD
Z351
LO4
ADAM

FELD 04

D0978102

1	2	3	4	5	6	7	8
DESCRIPTION, DESIGN, TECHNICAL DATA APPLICATION	MANUFACTURER, TYPE, ORDERING DATA SETTINGS MOUNTING APPA. DESIG.	APPARATUS SYMBOL DIAGRAM REFERENCE TO INDIVIDUAL TREATMENT (CIRCUIT DIAGRAM, SHEET NO., CIRCUIT NO.)					
3	ANSTOßSCHALTER MANUF.: AREVA PO NO.:	TYPE					
TECHNICAL COMPONENTS		TYP	ORDER NO.				
APPLICATION	SETTINGS	MOUNTING	SYM IDENTIFIER				
CRANK INSERTED	SLIDE-IN MODULE	ASA	/P01.2				
CRANK INSERTED	SLIDE-IN MODULE	ASA	/P02.6				
CRANK INSERTED	SLIDE-IN MODULE	ASA	/P01.5				

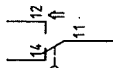

03	AS BUILT	05.12.2006 AD	Date	13.07.2005	US STEEL KOSTICE/SLOVAKIA			LIST OF EQUIPMENT	50.3023.01.A3.741.226	S1=LO4	/ Z351
02	Fact.-Rev.	09.11.2005 AD	Drawn	Bräunert	50.3023.01			PANEL	Typ: 09	MOTOR FEEDER	Sheet59
01	Approval	20.08.2005 AD	Check	Adam	SUBSTATION T80			04	D009781.02.604-3.AHA		
NO.	Alteration	Date	Name	Sta.	Orig.:	Iss.for	Iss.by:	88Sh.			



[illegible]

Copyright as per DIN 34 to be observed!

D00978102

FIELD 04

22.12.2006

03	AS BUILT	05.12.2005 AD	Date	13.07.2005	US STEEL KOSICE/SLOVAKIA	TERMINAL DIAGRAM	50.3023.01.A3.741.226	V = 04	8
02	Fact.-Rev.	08.11.2005 AD	Drawn	Brunert	50.3023.01			+S1A.R	/K01
01	Approval	20.09.2005 AD	Check	Adom	SUBSTATION T60				Sheet 61
NO.	Alteration	Date	Orig.	Iss.	Iss.	Iss.	Iss.	Iss.	Iss.
1									
2									
3									
CABLE WIRE USED SHEET STATE												CABLE TYPE SECTION												CORES												-ROUTE												CIRCUIT DIAGRAM												CABLE MATERIAL												COLOR												TERM. TYPE												STANDARD: UK5N												POS.:												H07V-K 1.5MM2 SW												H05V-K 1.0MM2 SW												H07V-K 2.5MM2 SW												REMARK																																																																																																																																																																																																																																																																																																																																																																																																																																																																																																																																																																																																																																																																																																																																																																																																																																																																																																																																																																																																																																																																																																		
CABLE												WIRES USED SHEET STATE												CABLE TYPE SECTION												CORES												-ROUTE												CIRCUIT DIAGRAM												CABLE MATERIAL												COLOR												TERM. TYPE												STANDARD: UK5N												POS.:												H07V-K 1.5MM2 SW												H05V-K 1.0MM2 SW												H07V-K 2.5MM2 SW												REMARK																																																																																																																																																																																																																																																																																																																																																																																																																																																																																																																																																																																																																																																																																																																																																																																																																																																																																																																																																																																																																																																																																						
RÜCK-REF.												NO												CORES/ LINE												DESTINAT. DESIG.												EXTERNAL												POT												NO												DESTINAT. DESIG.												INTERN												CORES/ LINE												REMARK																																																																																																																																																																																																																																																																																																																																																																																																																																																																																																																																																																																																																																																																																																																																																																																																																																																																																																																																																																																																																																																																																																																																						
/001.2																																																																																																																																																																																																																																																																																																																																																																																																																																																																																																																																																																																																																																																																																																																																																																																																																																																																																																																																																																																																																																																																																																																																																																																																																																																														

1 CABLE WIRES USED SHEET STATE CABLE-TYPE SECTION CORES -R001-												2		3		4		5		6		7		8	
CIRCUIT DIAGRAM												CABLE MATERIAL		TERM. TYPE											
INSTALLATION												H07V-K 1.5MM2 SW		STANDARD: UKSN											
												POS.: 2 H07V-K 2.5MM2 SW													

Copyright as per DIN 34 to be observed!

D00978102

FELD 04

22.12.2006

03	AS BUILT	06.12.2005	AD	Date	13.07.2005	US STEEL KOSTICE/SLOVAKIA	TERMINAL DIAGRAM	50.3023.01.A3.741.226	V = L04	8
02	Fact. -Rev.	06.11.2005	AD	Drawn	Bräunert	50.3023.01		+S1A.R		
01	Approval	20.09.2005	AD	Check	Adam	SUBSTATION T80				
NO.	Alteration	Date	Name	Std.	2	Iss. for	Iss. by:	Orig.:	D009781.02.604-3.AHA	98Sh.

1		2		3		4		5		6		7		8			
CABLE		WIRES USED SHEET/STATE		CABLE-TYPE SECTION		CORES		ROUTE		CIRCUIT DIAGRAM		CABLE MATERIAL		COLOR		TERM. TYPE	
												H07V-K 1.5MM2 SW		H07V-K 2.5MM2 SW		STANDARD: UKSN	
												2		2		SW	

[illegible]

03	AS BUILT	05.12.2005	AD	Date	13.07.2005	US STEEL KOSICE/SLOVAKIA	 AREVA	TERMINAL DIAGRAM		50_3023_01.A3.747_226		V = 04
02	Fact.-Rev.	09.11.2005	AD	Drawn	Bräuner	50_3023_01		PANEL		Type: 09		/ K12
01	Approval	20.09.2005	AD	Check	Adam	SUBSTATION T80		iss.by:		MOTOR FEEDER		Sheet66
INO.	Alteration	Date	Name	Std.	Orig.	iss.for	iss.by:		04		D009781.02.604-3.AHA	98Sh

003	AS BUILT	05.12.2005	AD	Date	13.07.2005	US STEEL KOSICE/SLOVAKIA	 AREVA	TERMINAL DIAGRAM	
002	Fact. - Rev.	09.11.2005	AD	Drawn	Bräunert	50.3023.01		50.3023.01.A3.741.226	V=L04
001	Approval	20.09.2005	AD	Check	Adam	SUBSTATION T80	PANEL		
NO.	Alteration	Date	Name	Sig.	Orig.	Iss. for	Iss. by:	04	
								Type: 09 MOTOR FEEDER D009781.02.604-3.AHA 98Sh.	

03	AS BUILT	05.12.2005	AD	Date	13.07.2005	US STEEL KOSICE/SLOVAKIA	 AREVA	TERMINAL DIAGRAM		50_3023_01_A3_741_226	V = 04
02	Fact. - Rev.	09.11.2005	AD	Drawn By	Dr. Bruner t	50_3023_01		PANEL			*STA.R
01	Approval	20.03.2005	AD	Check	Adam	SUBSTATION T80		Type: 09			Sheet 68
NO.	Alteration	Date	Name	Sid.	Orig.	Iss. for	Iss. by:	MOTOR FEEDER		D009781.02_604-3_AHA	98 Sh.

NO.	AS BUILT	05.12.2006	AD	Date	13.07.2005	US STEEL KOSICE/SLOVAKIA	 AREVA	TERMINAL DIAGRAM		50.3023.01.A3.741.226		V1=04	
02	Fact.-Rev.	09.11.2005	AD	Drawn	Brünnert	50.3023.01		PANEL		Typ: 09		S1A.R	
01	Approval	20.09.2005	AD	Check	Adam	SUBSTATION T80	iss.by:		iss.for		D009781.02.604-3.AHA		
	Alteration	Date	Name	Std.		Orig.	104		MOTOR FEEDER		Sheet 70 / 851		
											98Sh.		

[illegible]

1															2										3										4										5										6										7										8									
1															2										3										4										5										6										7										8									
1															2										3										4										5										6																													

003	AS BUILT	05.12.2005	AD	Date	13.07.2005	US STEEL KOSICE/SLOVAKIA	 AREVA	TERMINAL DI AGRAM	S0. 3023.01. A3. 7/4. 226		V = L04
002	Fact. - Rev.	09.11.2005	AD	Drawn	Brünert	50. 3023.01				+SIA.R	/ K82
001	Approval	20.09.2005	AD	Check	Adam	SUBSTATION T80		PANEL	Typ: 09	D009781.02. 604-3. AHA	
NO.	Alteration	Date	Name	Std.	Orig.	Iss for	Iss by:	04	MOTOR FEEDER		98Sh.

[illegible]

AREVA

XP-

CROSS CONNECTION									
REFERENCE	POTENTIAL ITEM CR. SECTION	CABLE MATERIAL COLOR	OUTPUT TERMINAL	DESTINATION 1	DESTINATION 2	DESTINATION 3	DESTINATION 4	DESTINATION 5	DESTINATION 6
600	08F+ 1 1.5MM2	H07V-K SW	-X0	5 -K203	13 -K203	33			
601	DC220V.L+ 2 2.5MM2	H07V-K SW	-X0	12 -F102	1 -F103	1 -F105	1 -F111	1 -F121	
601	DC220V.L- 2 2.5MM2	H07V-K SW	-X0	14 -F102	3 -F103	3 -F105	3 -F111	3 -F121	
602	1 1.5MM2	H07V-K SW		-K451A	81 -K451B	54			
602	1 1.5MM2	H07V-K SW	-X1	131 -K451A	54 -K451A	82			
M01	1 1.5MM2	H07V-K SW	-X1	136 -K01A	14 -K11A	14 -K201			
M01	1 1.5MM2	H07V-K SW	-X1	139 -K01A	13 -K11A	13			
M01	1 1.5MM2	H07V-K SW	-X1	140 -K01E	14 -K201	13 -K201			
M02	1 1.5MM2	H07V-K SW	-X1	156 -K02A	14 -K12A	14 -K202			
M02	1 1.5MM2	H07V-K SW	-X1	159 -K02A	13 -K12A	13			
M02	1 1.5MM2	H07V-K SW	-X1	160 -K02E	14 -K202	13 -K202			
M03	1 1.5MM2	H07V-K SW	-X1	130 -K01A	A2 -K01E	A2 -K02A	A2 -K02E	A2 -K71	A2 -K72
	---->			-K451A	A2 -K451B	A2			
M04	1 1.5MM2	H07V-K SW		-A100 -X20	1 -K01A	A1			
M04	1 1.5MM2	H07V-K SW		-A100 -X20	5 -K02A	A1			
M04	102L+ 1 1.5MM2	H07V-K SW	-X1	120 -A100 -X20	11 -A100 -X20	13 -A100 -X20	15 -A100 -X20	17	
P02	1 1.5MM2	H07V-K SW	-X9	904 -XPE	1 -X01	B11			
P02	1 1.5MM2	H07V-K SW	-X9	918 -XPE	2 -X01	B12			
002	1 1.5MM2	H07V-K SW		-A100 -X10	10 -A100 -X10	40			
004	03L+ 1 1.5MM2	H07V-K SW	-X8	808 -F111	12 -F121	12			
GROSS CONNECTION LIST				RELAY BOX				V -L04	
AREVA				PANEL				+STA.R	
Iss.by:				04				Typ: 09	
Iss.for:				09				MOTOR FEEDER	
Orig:				D009781.02.604-3.AHA				7	
Date				22.12.2006				8	
Name/Std				2				98Sh	
Approval				01				Sheet 77	
Fact.-Rev.				02				/ Q10	
AS BUILT				03					
Date				05.12.2005 AD					
Drawn/Brünnert				50.3023.01					
Date				09.11.2005 AD					
Check/Adom				SUBSTATION 780					
Date				20.09.2005 AD					
Name/Std				1					

Copyright as per DIN 34 to be observed!
D0978102
FIELD 04

CROSS CONNECTION

REFERENCE	POTENTIAL ITEM CR. SECTION	CABLE MATERIAL COLOR	OUTPUT TERMINAL	DESTINATION 1	DESTINATION 2	DESTINATION 3	DESTINATION 4	DESTINATION 5	DESTINATION 6
004	1 1.5MM2	H07V-K SW	-X8	833 -F111	11 -F121	11			
005	1 1.5MM2	H07V-K SW		-A100 -X11	10 -A100 -X11	40			
005	03L+ 1 1.5MM2	H07V-K SW	-X8	811 -F310	9 -F310	13 -K100	19		
005	03L+ 1 1.5MM2	H07V-K SW	-X8	813 -F102	12 -F103	12 -F105	12 -F203		
005	1 1.5MM2	H07V-K SW	-X8	846 -F102	11 -F103	11 -F105	11 -F203		
006	1 1.5MM2	H07V-K SW		-A100 -X30	2 -U401	17			
006	1 1.5MM2	H07V-K SW		-A100 -X30	3 -U401	18			
006	1 1.5MM2	H07V-K SW		-A100 -X30	6 -U401	15			
006	1 1.5MM2	H07V-K SW		-A100 -X30	7 -U401	16			
006	1 1.5MM2	H07V-K SW		-A100 -X30	32 -U401	19			
006	1 1.5MM2	H07V-K SW		-A100 -X30	33 -U401	20			
006	1 1.5MM2	H07V-K SW		-A100 -X30	36 -U401	21			
006	1 1.5MM2	H07V-K SW		-A100 -X30	37 -U401	22			
007	102L+ 1 1.5MM2	H07V-K SW	-X4	402 -K01E	43 -K02E	43			
007	1 1.5MM2	H07V-K SW	-X8	872 -K01E	44 -K02E	44			
R01	1 1.5MM2	H07V-K SW		-K01A	22 -K01E	21			
R01	1 1.5MM2	H07V-K SW		-K01E	22 -K11A	21			
R01	1 1.5MM2	H07V-K SW		-K02A	22 -K02E	21			
R01	1 1.5MM2	H07V-K SW		-K02E	22 -K12A	21			
R01	1 1.5MM2	H07V-K SW		-K11A	22 -K11E	21			

03	AS BUILT	05.12.2006 AD	Date	13.07.2005	US STEEL KOSICE/SLOVAKIA	CROSS CONNECT. LIST	150.3023.01.A3.741.225	V	-L04	8
02	Fact.-Rev.	09.11.2005 AD	Drawn	Brünnert	50.3023.01	RELAY BOX			-STA.R	8
01	Approval	20.09.2005 AD	Check	Adam	SUBSTATION T80	PANEL				8
NO.	Alteration	Date	Name	Std.	Iss. for	Iss. by:				8
							D009781.02.604-3.AHA			8
							MOTOR FEEDER			8
							Typ: 09			8
							Sheet 78			8

Copyright as per DIN 34 to be observed!

D00978102

FIELD 04

22.12.2006

[illegible]

03	AS BUILT	06.12.2005	AD	Date	13.07.2005	US STEEL KOSICE/SLOVAKIA		CROSS CONNECT. LIST RELAY BOX PANEL	50_3023_01_A3_74_1_226		V=104
02	Fact.-Rev.	09.11.2005	AD	Drawn	Bräuner	50_3023_01			/ 015		
01	Approval	20.09.2005	AD	Check	Adam	SUBSTATION T80			/ 015		
NO.	Alteration	Date	Name	Std.	Orig.	Iss.for	Iss.by:	04		Typ: 09	Sheet 83
								04		NOTION FEEDER	985h
								04		0009781.02_604-3_AHA	

+		A		B		C		+					
1	A01	-X1 /D01.2	H05V-K 1.0MM2 SW	101	-X8 /D02.4	H05V-K 1.0MM2 SW	822	-X1 /D01.5	H05V-K 1.0MM2 SW	145	-X3 /D01.3	H05V-K 1.0MM2 SW	325
2	A02	-X1 /D01.2	H05V-K 1.0MM2 SW	102	-X8 /D02.2	H05V-K 1.0MM2 SW	866	-X1 /D01.5	H05V-K 1.0MM2 SW	122	-X8 /D02.5	H05V-K 1.0MM2 SW	803
3	A03	-X1 /D01.6	H05V-K 1.0MM2 SW	136	-X8 /D02.2	H05V-K 1.0MM2 SW	873	-X8 /D02.5	H05V-K 1.0MM2 SW		-X8 /D02.5	H05V-K 1.0MM2 SW	823
4	A04	-X1 /D01.6	H05V-K 1.0MM2 SW	123	-X8 /D02.2	H05V-K 1.0MM2 SW	874	-X8 /D02.5	H05V-K 1.0MM2 SW		-X8 /D02.5	H05V-K 1.0MM2 SW	825
5	A05	-X1 /D01.7	H05V-K 1.0MM2 SW	138	-X0 /D01.3	H05V-K 1.0MM2 SW	5	-X0 /D01.2	H05V-K 1.0MM2 SW	025	-X9 /D01.4	H05V-K 1.0MM2 SW	906
6	A06	-X1 /D01.7	H05V-K 1.0MM2 SW	142	-X0 /D01.3	H05V-K 1.0MM2 SW	7	-X0 /D01.2	H05V-K 1.0MM2 SW	027	-X9 /D01.4	H05V-K 1.0MM2 SW	920
7	A07	-X8 /D04.3	H05V-K 1.0MM2 SW	809	-X1 /D03.5	H05V-K 1.0MM2 SW	116	-X8 /D02.4	H05V-K 1.0MM2 SW		-X8 /D02.4	H05V-K 1.0MM2 SW	869
8	A08	-X8 /D04.3	H05V-K 1.0MM2 SW	834	-X1 /D03.5	H05V-K 1.0MM2 SW	173	-X8 /D02.4	H05V-K 1.0MM2 SW		-X8 /D02.4	H05V-K 1.0MM2 SW	877
9	A09	-X8 /D04.3	H05V-K 1.0MM2 SW	836	-X9 /D01.2	H05V-K 1.0MM2 SW	901	-X9 /D01.2	H05V-K 1.0MM2 SW	902	-X9 /D01.5	H05V-K 1.0MM2 SW	907
10	A10	-X4 /D01.3	H05V-K 1.0MM2 SW	410	-X9 /D01.2	H05V-K 1.0MM2 SW	945	-X9 /D01.2	H05V-K 1.0MM2 SW	946	-X9 /D01.5	H05V-K 1.0MM2 SW	921
03	AS BUILT	06.12.2006	AD	Date	13.07.2005	US STEEL KOSICE/SLOVAKIA
02	Fact.-Rev.	09.11.2005	AD	Drawn	Bräunert	50_3023_01
01	Approval	20.09.2005	AD	Check	Adam	SUBSTATION T80
00	NOC Alteration	09.09.2005	AD	Name	Std.	Orig:
				Iss for		Iss by:
						04
						PANEL
						PLUG DIAGRAM CIRCUIT-BREAKER
						V = L04
						50_3023_01_A3_744_226
						*SIA.R
						/ S01
				Type:	09	Sheet 80
				MOTOR FEEDER		98Sh.
						D009781.02.604-3.AHA

1		2		3		4		5		6		7		8									
ASSEMBLY/INSTRUCT.						CABLE MATERIAL						TERM. TYPE											
						STANDARD: H07V-K 1.5MM2						STANDARD:											
-X04																							
RÜCK- REF.		LTG (Ø IN MM2) CABLE		CORE		DESTINAT. DESIG.		SOCKET		POT		NO		DESTINAT. DESIG.		PIN		LTG (Ø IN MM2) CABLE		CORE		REMARK	
/600.6						-X0		7				A01		+S1B.R -X0		5							
/600.6						-X0		9		CBF2'		A02		+S1B.R -X0		7		H05V-K		1.0MM2		SW	
/L01.4						-X1		103		121L+		A03		+S1B.R -X1		101							
/L01.4						-X1		104		121L-		A04		+S1B.R -X1		102							
/M02.6						-X1		155				A05		+S1B.R -X1		121							
/M02.7						-X1		158				A06		+S1B.R -X1		122							
/M02.6						-X1		126		102L-		A07		+S1B.R -X1		123							
/M02.7						-X1		162				A08		+S1B.R -X1		124							
/M02.4						-X1		118		102L+		A09		+S1B.R -X1		125							
/M02.4						-X1		152				A10		+S1B.R -X1		126							
/M03.3						-X1		115		102L+		A11		+S1B.R -X1		127							
/M03.3						-X1		171				A12		+S1B.R -X1		130							
/C0ST.1												A13											
/M03.6						-X1		174				A14		+S1B.R -X1		131							
/M03.7						-X1		175				A15		+S1B.R -X1		132							
/C0ST.1												A16											
/M01.6						-X0		092		ACR+		B01		+S1B.R -X1		141							
/M01.6						-X0		096		TRANSFER TRIPPING		B02		+S1B.R -X1		142							
/M01.6						-X0		098		I>		B03		+S1B.R -X1		143							
/M01.7						-X0		094		ACR-		B04		+S1B.R -X1		144							
/C0ST.2												B05											
/C0ST.2												B06											
/C0ST.2												B07											
/C0ST.2												B08											
/C0ST.2												B09											
/C0ST.2												B10											
/C0ST.2												B11											
/C0ST.2												B12											
/C0ST.2												B13											
/C0ST.2												B14											
/C0ST.2												B15											
/C0ST.2												B16											
/P02.6						-X1		184		DRANG UNIT RELEASE		C01		+S1B.R -X0		030							
/P02.4						-X1		181				C02		+S1B.R -X1		181							
/R01.5						-X4		412				C03		+S1B.R -X4		401							
/R01.5						-X4		414				C04		+S1B.R -X4		402							
/C0ST.2												C05											
/C0ST.2												C06											
/C0ST.2												C07											
/C0ST.2												C08											

03 AS BUILT 05.12.2005 AD Date 13.07.2005 US STEEL KOSICE/SLOVAKIA

02 Fact.-Rev. 09.11.2005 AD Drawn Bräuner t 50.3023.01

01 Approval 20.09.2005 AD Check Adam SUBSTATION T80

NO Alteration Date Name Sid 2

Orig: 1

Iss.by: 4

Iss.for: 3

2

1

03 22.12.2006

FIELD 04

00978102

Copyright as per DIN 34 to be observed!

PLUG DIAGRAM 50.3023.01.A3.741.226 V=L04

NIEDERSPG.-SCHR. A- NIEDERSPG.-SCHR. B

PANEL 04

Typ: 09 MOTOR FEEDER

D009781.02.604-3.AHA

98Sh.

Sheet 81

7

8

03	AS BUILT	05.12.2005	AD	Date	13.07.2005	US STEEL KOSICE/SLOVAKIA	PLUG DIAGRAM	50.3023.01.A3.741.226	V	404	7 S40
02	Fact.-Rev.	09.11.2005	AD	Drawn	Brüner	50.3023.01	NIEDERSPG.-SCHR.A-	NIEDERSPG.-SCHR.B	V	404	7 S40
01	Approval	30.09.2005	AD	Check	Adam	SUBSTATION T80	PANEL	Typ: 09	MOTOR FEEDER	D009781.02.604-3.AHA	Sheet 81
NO.	Alteration	Date	Name	Std.	Iss.for	Iss.by:	104	104	104	104	98Sh

Copyright as per DIN 34 to be observed!

D0978102

FIELD 04

22.12.2006

1		2		3		4		5		6		7		8									
ASSEMBLY/INSTRUCT.						CABLE MATERIAL						TERM. TYPE											
						STANDARD: HO7V-K 1.5MM2						STANDARD:											
						BK						-X04											
RÜCK-REF.		LTG (ø IN MM2) CABLE		CORE		DESTINAT. DESIG.		SOCKET		POT		NO		DESTINAT. DESIG.		PIN		LTG (ø IN MM2) CABLE		CORE		REMARK	
/N02.4						-X1		146		102L-		009		+S1B.R -X1		110							
/N02.4						-X1		126				010		+S1B.R -X1		111							
/C00T.2												011											
/C00T.2												012											
/C00T.2												013											
/C00T.2												014											
/C00T.2												015											
/C00T.2												016											
/001.5						-X3		305		102L+		001		+S1B.R -X3		301							
/001.5						-X3		326				002		+S1B.R -X3		303							
/001.5						-X3		327				003		+S1B.R -X3		304							
/001.5						-X3		328				004		+S1B.R -X3		305							
/001.6						-X3		330		03L+		005		+S1B.R -X3		306							
/003.4						-X8		806				006		+S1B.R -X8		801							
/003.4						-X8		828				007		+S1B.R -X8		805							
/003.4						-X8		829				008		+S1B.R -X8		806							
/003.5						-X8		830				009		+S1B.R -X8		807							
/003.5						-X8		832				010		+S1B.R -X8		808							
/C00T.3										FAULT		011		+S1B.R -X8		809							
/005.6						-X8		842				012		+S1B.R -X8		810							
/005.6						-X8		843				013		+S1B.R -X8									
/C00T.3												014											
/004.4						-X8		835				015		+S1B.R -X8		811							
/C00T.3												016											

22.12.2006

FIELD 04

D0978102

Copyright as per DIN 34 to be observed!

03	AS BUILT	06.12.2005	AD	Date	13.07.2005	US STEEL KOSICE/SLOVAKIA		PLUG DIAGRAM		50.3023.01.A3.741.226		V=L04		8	
02	Fact.-Rev.	09.11.2005	AD	Drawn	Bräunert	50.3023.01		NIEDERSPG.-SCHR.A-		NIEDERSPG.-SCHR.B		+S1A.R		7	
01	Approval	20.09.2005	AD	Check	Adam	SUBSTATION T80		PANEL		TYP: 09		MOTOR FEEDER		Sheet 82	
N0.	Alteration	Date	Name	Sld.	2	Orig:		Iss.for		04		D009781.02.604-3.AHA		98Sh.	

D0978102 Copyright as per DIN 34 to be observed!

FELD 04

22.12.2006

1																	2																	3																	4																	5																	6																	7																	8																
1																	2																	3																	4																	5																	6																	7																	8																
1																	2																	3																	4																	5																	6																																																		

033	AS BUILT	05.12.2005 AD	Date	13.07.2005	US STEEL KOSICE/SLOVAKIA	 AREVA	TERMINAL DIAGRAM	50_3023_01_A3_747_226	V=L04	Sheet 85					
001	Fact.-Rev.	09.11.2005 AD	Drawn	Bräunert	50_3023_01						PANEL	Type: 09	MOTOR FEEDER	D009781_02_604-3_AHA	985h
001	Approval	20.09.2005 AD	Check	Adam	SUBSTATION T80										
NO.	Alteration	Date	Name	Sid.	Orig.	iss. for	iss. by:	04							

03	AS BUILT	05.12.2005	AD	Date	13.07.2005	US STEEL KOSICE/SLOVAKIA		TERMINAL DIAGRAM	50.3023.01.A3.74.1.226	V = L04 +S1B.R	/ K30
02	Fact. - Rev.	09.11.2005	AD	Drawn	Brüderl	50.3023.01					
01	Approval	20.09.2005	AD	Checked	Adam	SUBSTATION T80					
NO.	Alteration	Date	Name	Std.	Orig.	Iss. for	Iss. by:	PANEL 04	Type: 09 MOTOR FEEDER	D009781.02.604-3.AHA	Sheet 86 98 Sh.

[illegible]

03	AS BUILT	05.12.2005	AD	Date	13.07.2005	US STEEL KOS(CE/SLOVAKIA)	 AREVA	TERMINAL DIAGRAM		50_3023_01.A3.747.226		V=L04	
	Fact.-Rev.	09.11.2005	AD	Drawn	Bräunert	50_3023_01			PANEL		*S1B_R		/K80
01	Approval	20.09.2005	AD	Check	Adam	SUBSTATION T80			Type: 09		MOTOR FEEDER		Sheet88
NO.	Alteration	Date	Name	Sld.	Orig.	Iss.for	iss.by:	04		D009781.02.604-3.AHA		98Sh.	

1		2		3		4		5		6		7		8	
CABLE		WIRES USED SHEET/STATE		CABLE-TYPE SECTION		CORES		-ROUTE		CIRCUIT DIAGRAM		CABLE MATERIAL		TERM. TYPE	
NO.		1		2		3		4		5		6		7	
REF.		1		2		3		4		5		6		7	
/V02.2															
/600.6															
/V02.3															
/V02.4															
/600.6															
/P01.4															
/V02.5															
/P01.4															
/V02.6															
/V02.6															
/V02.2															
/600.6															
/V02.3															
/V02.4															
/600.6															
/P01.4															
/V02.5															
/P01.4															
/V02.6															
/V02.6															
/V02.2															
/600.6															
/V02.3															
/V02.4															
/600.6															
/P01.4															
/V02.5															
/P01.4															
/V02.6															
/V02.6															
/V02.2															
/600.6															
/V02.3															
/V02.4															
/600.6															
/P01.4															
/V02.5															
/P01.4															
/V02.6															
/V02.6															
/V02.2															
/600.6															
/V02.3															
/V02.4															
/600.6															
/P01.4															
/V02.5															
/P01.4															
/V02.6															
/V02.6															
/V02.2															
/600.6															
/V02.3															
/V02.4															
/600.6															
/P01.4															
/V02.5															
/P01.4															
/V02.6															
/V02.6														</	

CROSS CONNECTION

[illegible]

003	AS BUILT	05.12.2005	AD	Date	13.07.2005	US STEEL KOSICE/SLOVAKIA	 AREVA	CROSS CONNECT. LIST	50.3023.01.A3.741.226	V=104
002	Fact. - Rev.	09.11.2005	AD	Drawn	Bräuner	50.3023.01		RELAY BOX		
001	Approval	20.09.2005	AD	Check	Adam	SUBSTATION T80		PANEL		
NO.	Alteration	Date	Name	Sid.	Orig.	Iss. for	Iss. by:	Typ: 09	MOTOR FEEDER	Sheet 60 / 810
									0009781.02.604-3.AHA	985h.

+S1B.R -X02
CABLE MATERIAL H05V-K 1.0mm2 SW

03	AS BUILT	06.12.2006	AD	Date	13.07.2005	US STEEL KOSICE/SLOVAKIA	 AREVA	PLUG DIAGRAM CIRCUIT-BREAKER PANEL	50_3023_01_A3_741_226 V=L04 \$1B.R	Sheet 91 98 Sh.
02	Fact.-Rev.	09.11.2005	AD	Drawn	Brüdnert	50_3023_01				
01	Approval	20.09.2005	AD	Check	Adam	SUBSTATION T80				
NO.	Alteration	Date	Name	Std.	Orig.	iss for				
						iss by:				
								Typ: 09	MOTOR FEEDER	D009781.02.604-3.AHA

CROSS CONNECTION									
REFERENCE	POTENTIAL ITEM CR. SECTION	CABLE MATERIAL COLOR	OUTPUT TERMINAL	DESTINATION 1	DESTINATION 2	DESTINATION 3	DESTINATION 4	DESTINATION 5	DESTINATION 6
D01	0 1.0MW2	H05Y-K SW	-X01	B05 -S1	-001 71				
D01	0 1.0MW2	H05Y-K SW	-X01	B06 -S1	-001 72				
L01	111L+ 0 1.0MW2	H05Y-K SW	-X01	A01 -S22	-001 11				
L01	111L- 0 1.0MW2	H05Y-K SW	-X01	A02 -S23	-001 12				
M01	0 1.0MW2	H05Y-K SW	-F2	-001 C1 -S1	-001 222				
M01	0 1.0MW2	H05Y-K SW	-F2	-001 C2 -S43	-001 11				
M01	0 1.0MW2	H05Y-K SW	-S1	-001 221 -S21	-001 14				
M01	0 1.0MW2	H05Y-K SW	-S21	-001 13 -S6	-001 12				
M01	0 1.0MW2	H05Y-K SW	-X01	A03 -S1	-001 213				
M01	102L- 0 1.0MW2	H05Y-K SW	-X01	A04 -F11	-001 C2				
M01	0 1.0MW2	H05Y-K SW	-X01	A05 -S6	-001 11				
M01	0 1.0MW2	H05Y-K SW	-X01	A06 -S43	-001 12				
M03	0 1.0MW2	H05Y-K SW	-X01	B07 -S1	-001 83				
M03	0 1.0MW2	H05Y-K SW	-X01	B08 -S1	-001 84				
P01	0 1.0MW2	H05Y-K SW	-S1	-01 32 -S61	14				
P01	0 1.0MW2	H05Y-K SW	-X01	C05 -S1	-01 31				
P01	BUSBAR ES RELEASE 0 1.0MW2	H05Y-K SW	-X01	C06 -S61	11				
P01	DRAWG. UNIT RELEASE 0 1.0MW2	H05Y-K SW	-X01	D13 -Y1	E1				
P01	214L- 0 1.0MW2	H05Y-K SW	-X01	D14 -Y1	E2				
Q01	102L+ 0 1.0MW2	H05Y-K SW	-X01	A12 -S1	-001 11 -S1 23				
US STEEL KOSICE/SLOVAKIA				CROSS CONNECT LIST SWITCHING TRUCK PANEL			50.3023.01.A3.741.226		
Date 13.07.2005				Date 09.11.2005			V -L04 +SSA		
Fact.-Rev. 09.11.2005 AD Drawt Bräunert				Date 20.09.2005 AD Check Adom			Typ: 09 MOTOR FEEDER		
Approval 20.09.2005 AD				Date 20.09.2005 AD			D009781.02.604-3.AHA		
Alteration				Name Std.			Sheet 193		
NO.				Iss. for			98 Sh.		

Copyright as per DIN 34 to be observed!

D0978102

FIELD 04

H1015MD
0304+SSA
ADAM

22.12.2006

CROSS CONNECTION									
REFERENCE	POTENTIAL ITEM CR. SECTION	CABLE MATERIAL COLOR	OUTPUT TERMINAL	DESTINATION 1	DESTINATION 2	DESTINATION 3	DESTINATION 4	DESTINATION 5	DESTINATION 6
001	0 1.0MW2	H05V-K SW	-X01	A13 -S1	-001 12				
001	0 1.0MW2	H05V-K SW	-X01	A14 -S1	-001 24				
001	0 1.0MW2	H05V-K SW	-X01	C15 -S1	-01 11 -S1	-01 13			
001	0 1.0MW2	H05V-K SW	-X01	C16 -S1	-01 12				
001	0 1.0MW2	H05V-K SW	-X01	D01 -S1	-01 14				
002	0 1.0MW2	H05V-K SW	-X01	A15 -S1	-001 31 -S1	-001 43			
002	0 1.0MW2	H05V-K SW	-X01	A16 -S1	-001 32				
002	0 1.0MW2	H05V-K SW	-X01	B01 -S1	-001 44				
002	0 1.0MW2	H05V-K SW	-X01	D02 -S1	-01 21 -S1	-01 23			
002	0 1.0MW2	H05V-K SW	-X01	D03 -S1	-01 22				
002	0 1.0MW2	H05V-K SW	-X01	D04 -S1	-01 24				
004	0 1.0MW2	H05V-K SW	-X01	A07 -S24	-001 11				
004	0 1.0MW2	H05V-K SW	-X01	A08 -S24	-001 12				
004	0 1.0MW2	H05V-K SW	-X01	A09 -S24	-001 14				
007	0 1.0MW2	H05V-K SW	-X01	B02 -S1	-001 51 -S1	-001 63			
007	0 1.0MW2	H05V-K SW	-X01	B03 -S1	-001 52				
007	0 1.0MW2	H05V-K SW	-X01	B04 -S1	-001 64				
007	0 1.0MW2	H05V-K SW	-X01	B13 -S42	-001 11				
007	0 1.0MW2	H05V-K SW	-X01	B14 -S42	-001 14				
007	0 1.0MW2	H05V-K SW	-X01	B15 -S25	-001 11				

22.12.2008
H0115MO
03-04+33A
ADAM

Copyright as per DIN 34 to be observed!

D0978102

03	AS BUILT	06.12.2005 AD	Date 13.07.2005	US STEEL KOSICE/SLOVAKIA	CROSS CONNECT. LIST		50.3023.01.A3.741.226	V=L04	8
02	Fact.-Rev.	09.11.2005 AD	Drawn Bräunert	50.3023.01	SWITCHING TRUCK			+53A	7
01	Approval	20.09.2005 AD	Check Adám	SUBSTATION T80	PANEL				6
NO.	Alteration	Date	Named Std.	Orig.:	Iss. for	Iss. by:	D009781.02.604-3.AHA		5
						MOTOR FEEDER			4
									3
									2
									1
									0
									98Sh

D0978102

FIELD 04

•

704+53A
032
ADAM

03	
02	
01	
NO.	

CROSS CONNECTION

[illegible]

03	AS BULLT	05.12.2006 AD	Date	13.07.2005	US STEEL KOSICE/SLOVAKIA		CROSS CONNECT. LIST SWITCHING TRUCK	50.3023.01.A3.741.226	V=04	
02	Fact.-Rev.	09.11.2005 AD	Drawn	Bräuner t	50.3023.01					
01	Approval	20.03.2005 AD	Check	Adom	SUBSTATION T80					
NO.	Alteration	Date	Name	Std.	Orig.					Iss for
NO.	Alteration	Date	Name	Std.	Orig.	Iss for	Iss by:	04	PANEL	
								Typ: 09	MOTOR FEEDER	Sheet 96 / 033
								D009781.02.604-3.AHA		985h.

Copyright as per DIN 34 to be observed!

HJ0115MD
=L07+S3A
030
ADAM

TERMINAL DIA., 64 POLIG, CIRCUIT-BREAKER
PIN

+S3A -X01
CABLE MATERIAL H05V-K 1.0mm2 SW

A				B				C				D				+
+																+
1	-001 /L01.2	-S22	11	-001 /B01.4	-S1	44	-001 /C01.5	-S1	243	-01 /D01.3	-S1	14				1
2	-001 /L01.2	-S23	12	-001 /B02	-S1	51	-001 /C02	-F12	C2	-01 /D02.5	-S1	21				2
3	-001 /L01.6	-S1	213	-001 /B03	-S1	52	-001 /C03			-01 /D02.5	-S1	22				3
4	-001 /M01.6	-F11	C2	-001 /B04	-S1	64	-001 /C04			-01 /D02.5	-S1	24				4
5	-001 /M01.7	-S6	11	-001 /B05	-S1	71	-001 /C05	-S1	31	-01 /D01.4	-S1	51				5
6	-001 /M01.7	-S43	12	-001 /B06	-S1	72	-001 /C06	-S61	11	-01 /D01.4	-S1	52				6
7	-001 /M01.7	-S24	11	-001 /B07	-S1	83	-001 /C07			-01 /D07.4	-S1	33				7
8	-001 /M04.3	-S24	12	-001 /B08	-S1	84	-001 /C08			-01 /D07.4	-S1	34				8
9	-001 /M04.3	-S24	14	-001 /B09	-S1	91	-001 /C09	-S1	103	-01 /D01.5	-S1	61				9
10	-001 /M01.3	-S41	11	-001 /B10	-S1	92	-001 /C10	-S1	104	-01 /D01.5	-S1	62				10
11	-001 /M01.3	-S1	230	-01 /B11	-S1	41	-001 /C11	-S1	111	-01 /D01.4	-S1	43				11
12	-001 /M01.2	-S1	11	-001 /B12	-S62	11	-001 /C12	-S1	112	-01 /D01.4	-S1	44				12
13	-001 /M01.2	-S1	12	-001 /B13	-S42	11	-001 /C13	-S63	14	-Y1 /D01.4		E1				13
14	-001 /M01.2	-S1	24	-001 /B14	-S42	14	-001 /C14	-S63	11	-Y1 /D01.4		E2				14
15	-001 /M02.3	-S1	31	-001 /B15	-S25	11	-001 /C15	-S1	11							15
16	-001 /M02.3	-S1	32	-001 /B16	-S25	14	-001 /C16	-S1	12							16
+																+

Subject to technical modifications!
Copyright as per DIN 34 to be observed!

FIELD 04
D0978102
H0115ND
L04+S3A
ADAM
S01

03	AS BUILT	05.12.2005	AD	Date	13.07.2005	US STEEL KOSICE/SLOVAKIA	PLUG DIAGRAM	50.3023.01.A3.741.226	VI=L04	7 S01
02	Fact.-Rev.	09.11.2005	AD	Drawn	Bräunert	50.3023.01	CIRCUIT-BREAKER		+S3A	
01	Approval	20.09.2005	AD	Check	Adam	SUBSTATION T80	PANEL			Sheet 97
NO.	Alteration	Date	Name	Std.	Iss.	for	Iss.	by:		98 Sh.

Typ: 09
MOTOR FEEDER

D009781.02.604-3.AHA

TERMINAL DIA. , 64 POLIG , CIRCUIT-BREAKER PIN

+S3B -X02
CABLE MATERIAL H05V-K 1.0mm2 SW

A				B				C				D				+
1	A01		B01				C01				D01				1	+
2	A02		B02				C02				D02				2	
3	A03		B03				C03				D03				3	
4	A04		B04				C04				D04				4	
5	A05		B05				C05				D05				5	
6	A06		B06				C06				D06				6	
7	A07		B07				C07				D07				7	
8	A08		B08				C08				D08				8	
9	A09		B09				C09				D09				9	
10	A10		B10				C10				D10				10	
11	A11		B11				C11				D11				11	
12	A12		B12				C12				D12				12	
13	A13		B13				C13				D13				13	
14	A14		B14				C14				D14				14	
15	A15		B15				C15				D15				15	
16	A16		B16				C16				D16				16	+

Subject to technical modifications!
Copyright as per DIN 34 to be observed!

FELD 04
D0978102
HJ0115MD
S01
L04+S3B
ADAM

03	AS BUILT	05.12.2005	AD	Date	13.07.2005	US STEEL KOSICE/SLOVAKIA	PLUG DIAGRAM	50.3023.01 A3 741.226	V	-L04	7 S01
02	Fact.-Rev.	09.11.2005	AD	Drawn	Bräunert	50.3023.01	CIRCUIT-BREAKER			+S3B	
01	Approval	20.09.2005	AD	Check	Adam	SUBSTATION T80	PANEL	Typ: 09			Sheet 98
NO.	Alteration	Date	Name	Sid.	iss. for	Orig.	iss. by:	MOTOR FEEDER			98Sh.
1								D009781.02 604-3 AHA			