


## As Built Documentation

### Chapter 5.5.1 Logic diagrams

- Function diagram  
Hardware logic
- Function diagrams

HZ 92001



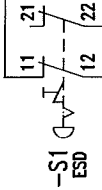


L+

L-

-K1

Emergency shut down relay  
PN0Z X4

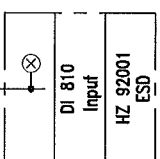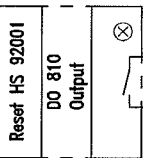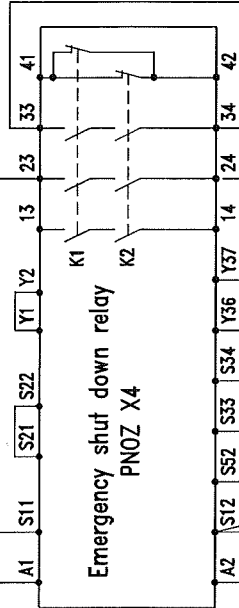


Shut down HZ 92002 - to page no. 02


Control room

Switch room

MCC


PROJECT				ASU KOSICE				DRAWING NAME:				SIZE		FUNCTION DIAGRAM		DATE	
NAME				TOTAL PLANT				AIR LIQUIDE				A3		FUNCTION DIAGRAM		17.06.2005	
PLANT				TOTAL PLANT				Air Liquide AGS GmbH Füllingsweg 34 47805 Krefeld				DRWG. NO.		K70101_HW_01.dwg		AUTHOR: rohn	
PART				TOTAL PLANT				Emergency SHUT DOWN TOTAL PLANT HZ 92001				PRD.J. NO.		K70101		CHECK: Eichler	
BY				CHKD.				REPLACES:				REPLACES:		K70101		STD.	
DATE				REV				REPLACES:				REPLACES:		K70101		Page no. 01	
NO				FILE				REPLACES:				REPLACES:		K70101		10 Pages	
REV				DATE				REPLACES:				REPLACES:		K70101		BASED:	

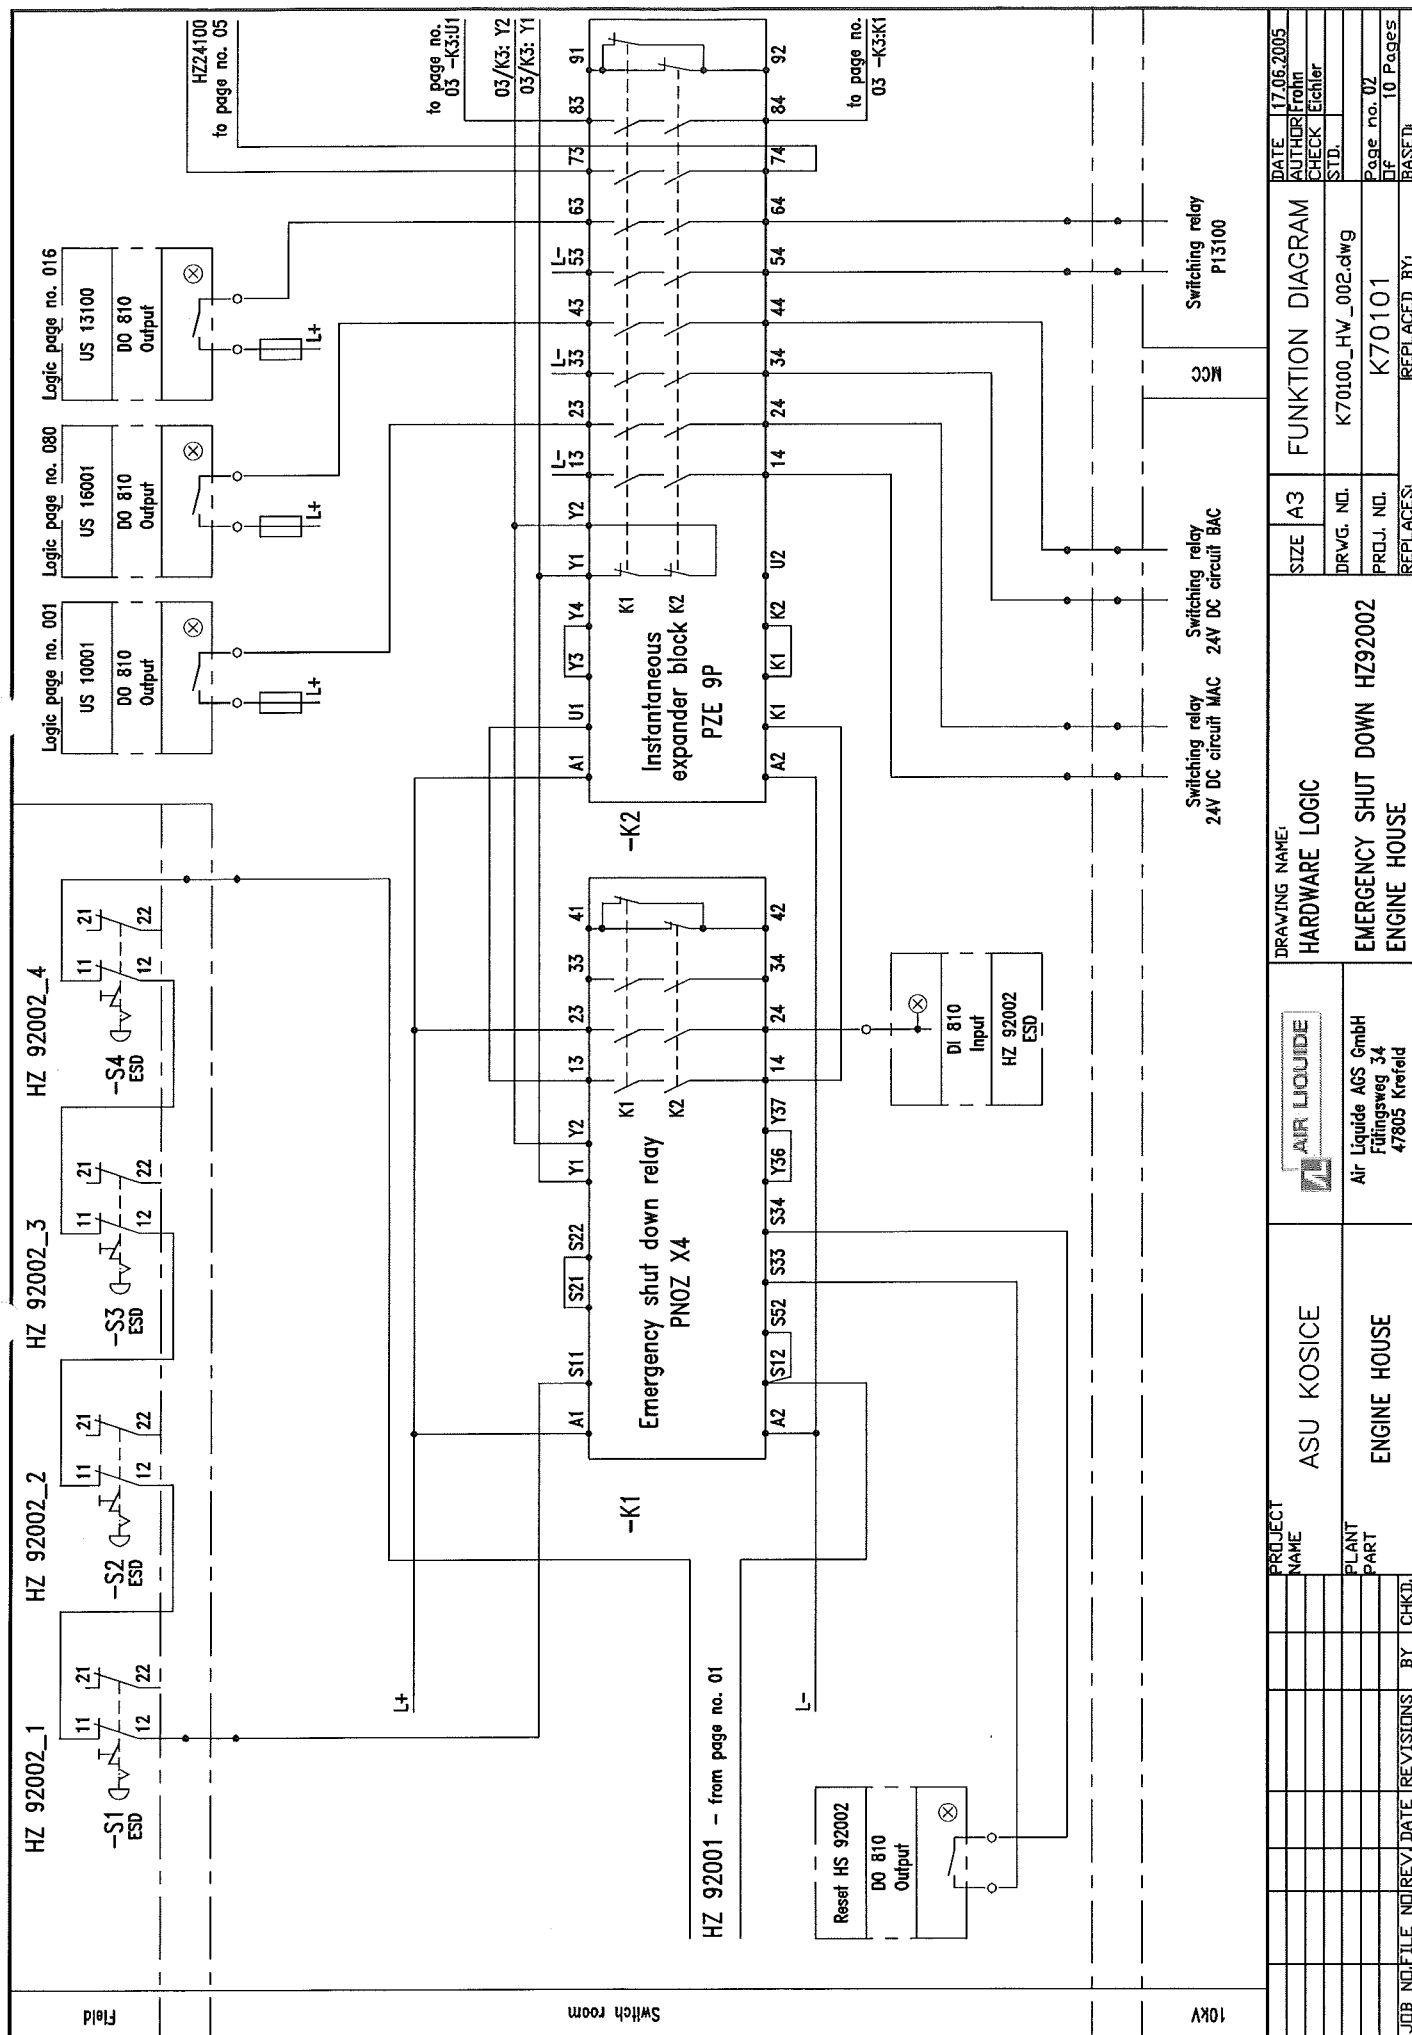
[illegible]

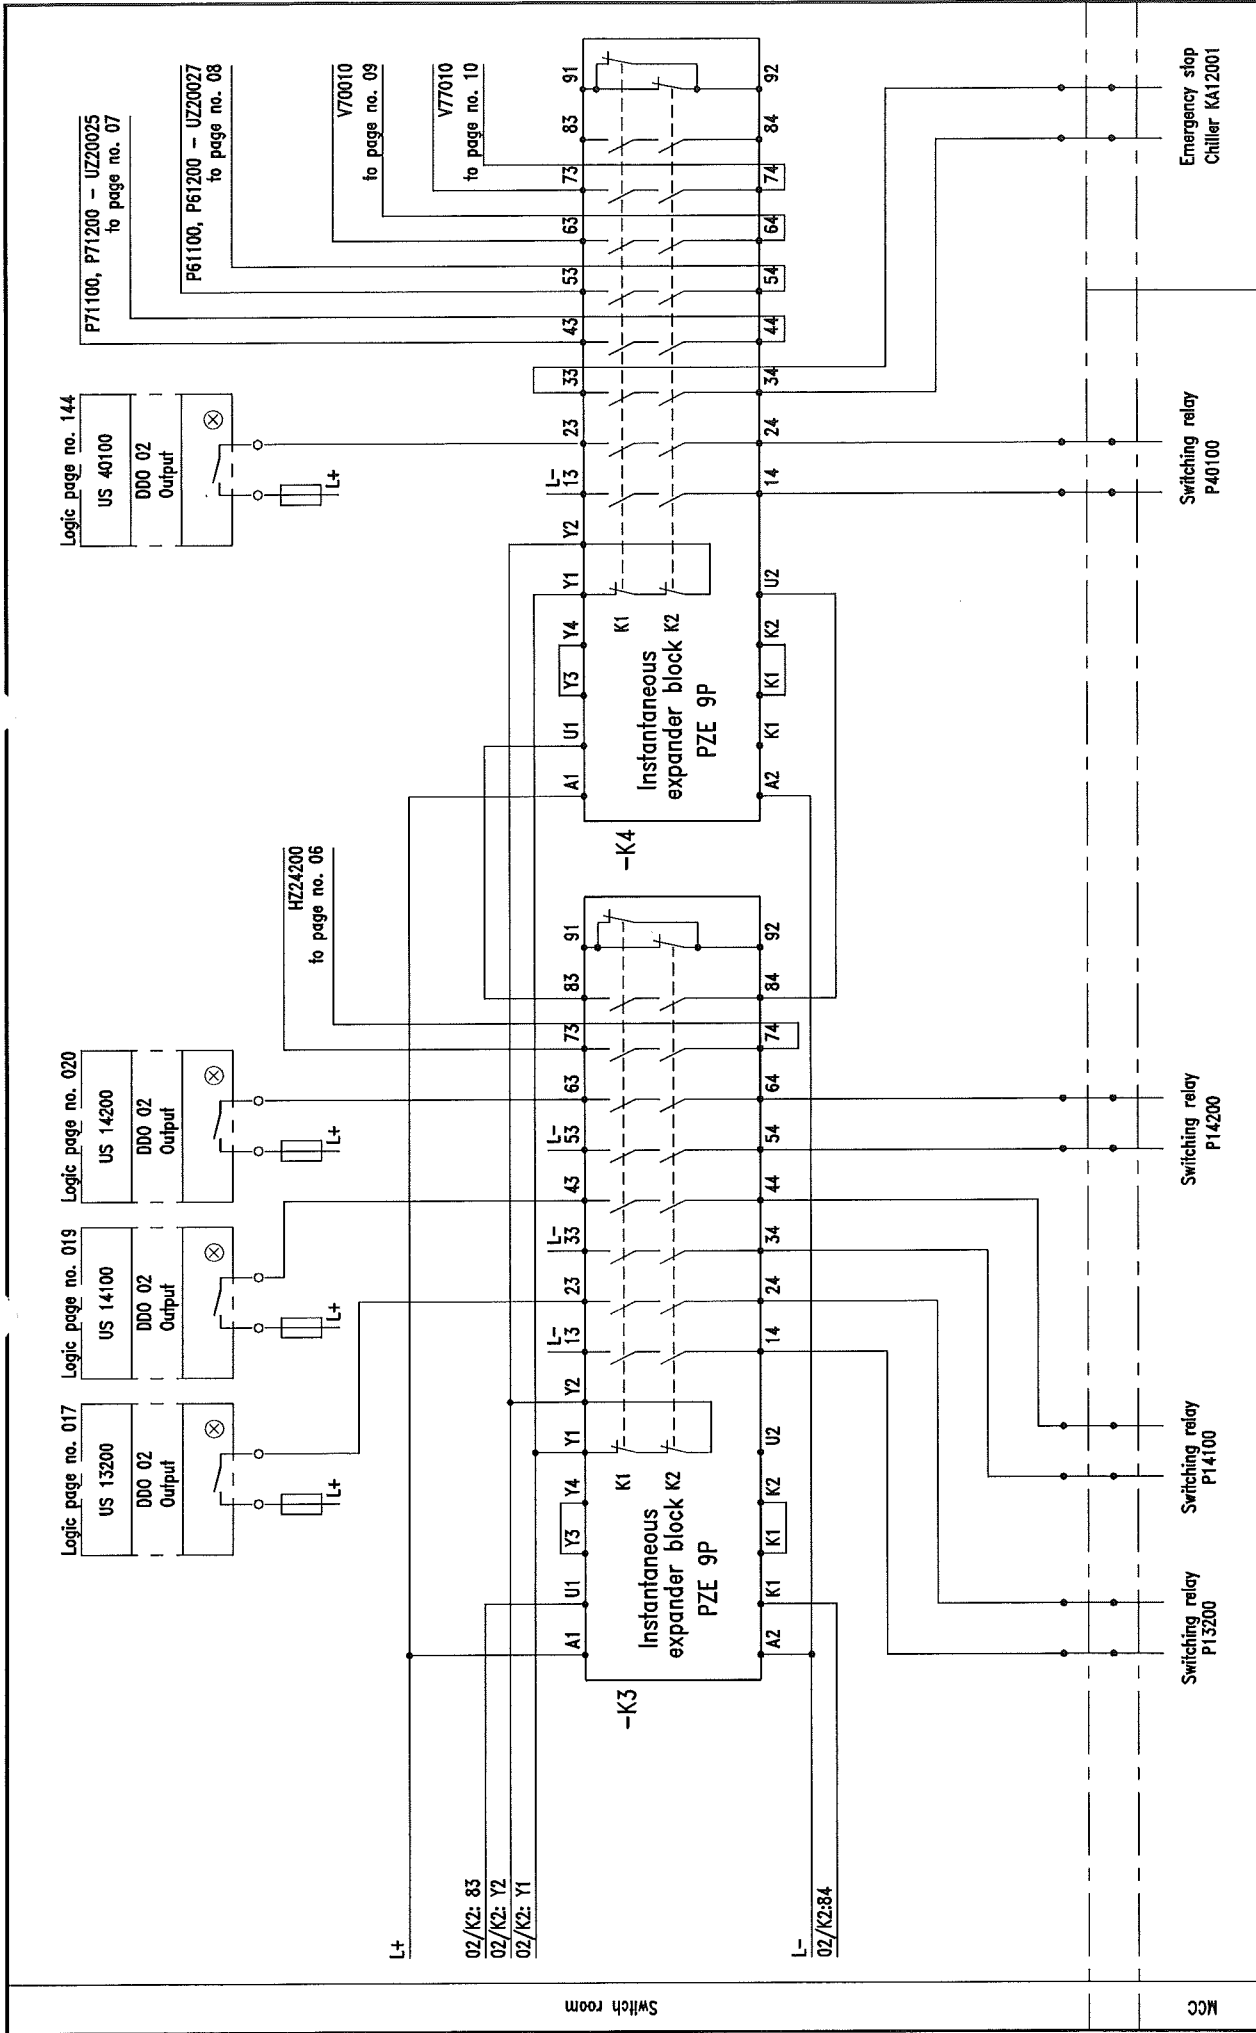


DATE	17.06.2005
AUTHOR	Frahm
CHECK	Eichler
STD.	
Page no. 03	
Of	10 Pages
BASED:	
REPLACES:	
PROJ. NO.	K70101
DRWG. NO.	K70100_HV_003.dwg
SIZE	A3
FUNKTION DIAGRAM	
DRAWING NAME	HARDWARE LOGIC
EMERGENCY SHUT DOWN HZ92002	
ENGINE HOUSE	
PROJECT NAME	ASU KOSICE
PLANT PART	ENGINE HOUSE
PLANT	Air Liquide AGS GmbH
PLANT	Füllingsweg 34
PLANT	47805 Krefeld
FILE NO.	
REV.	
DATE	
REVISIONS	
BY	CHKD.




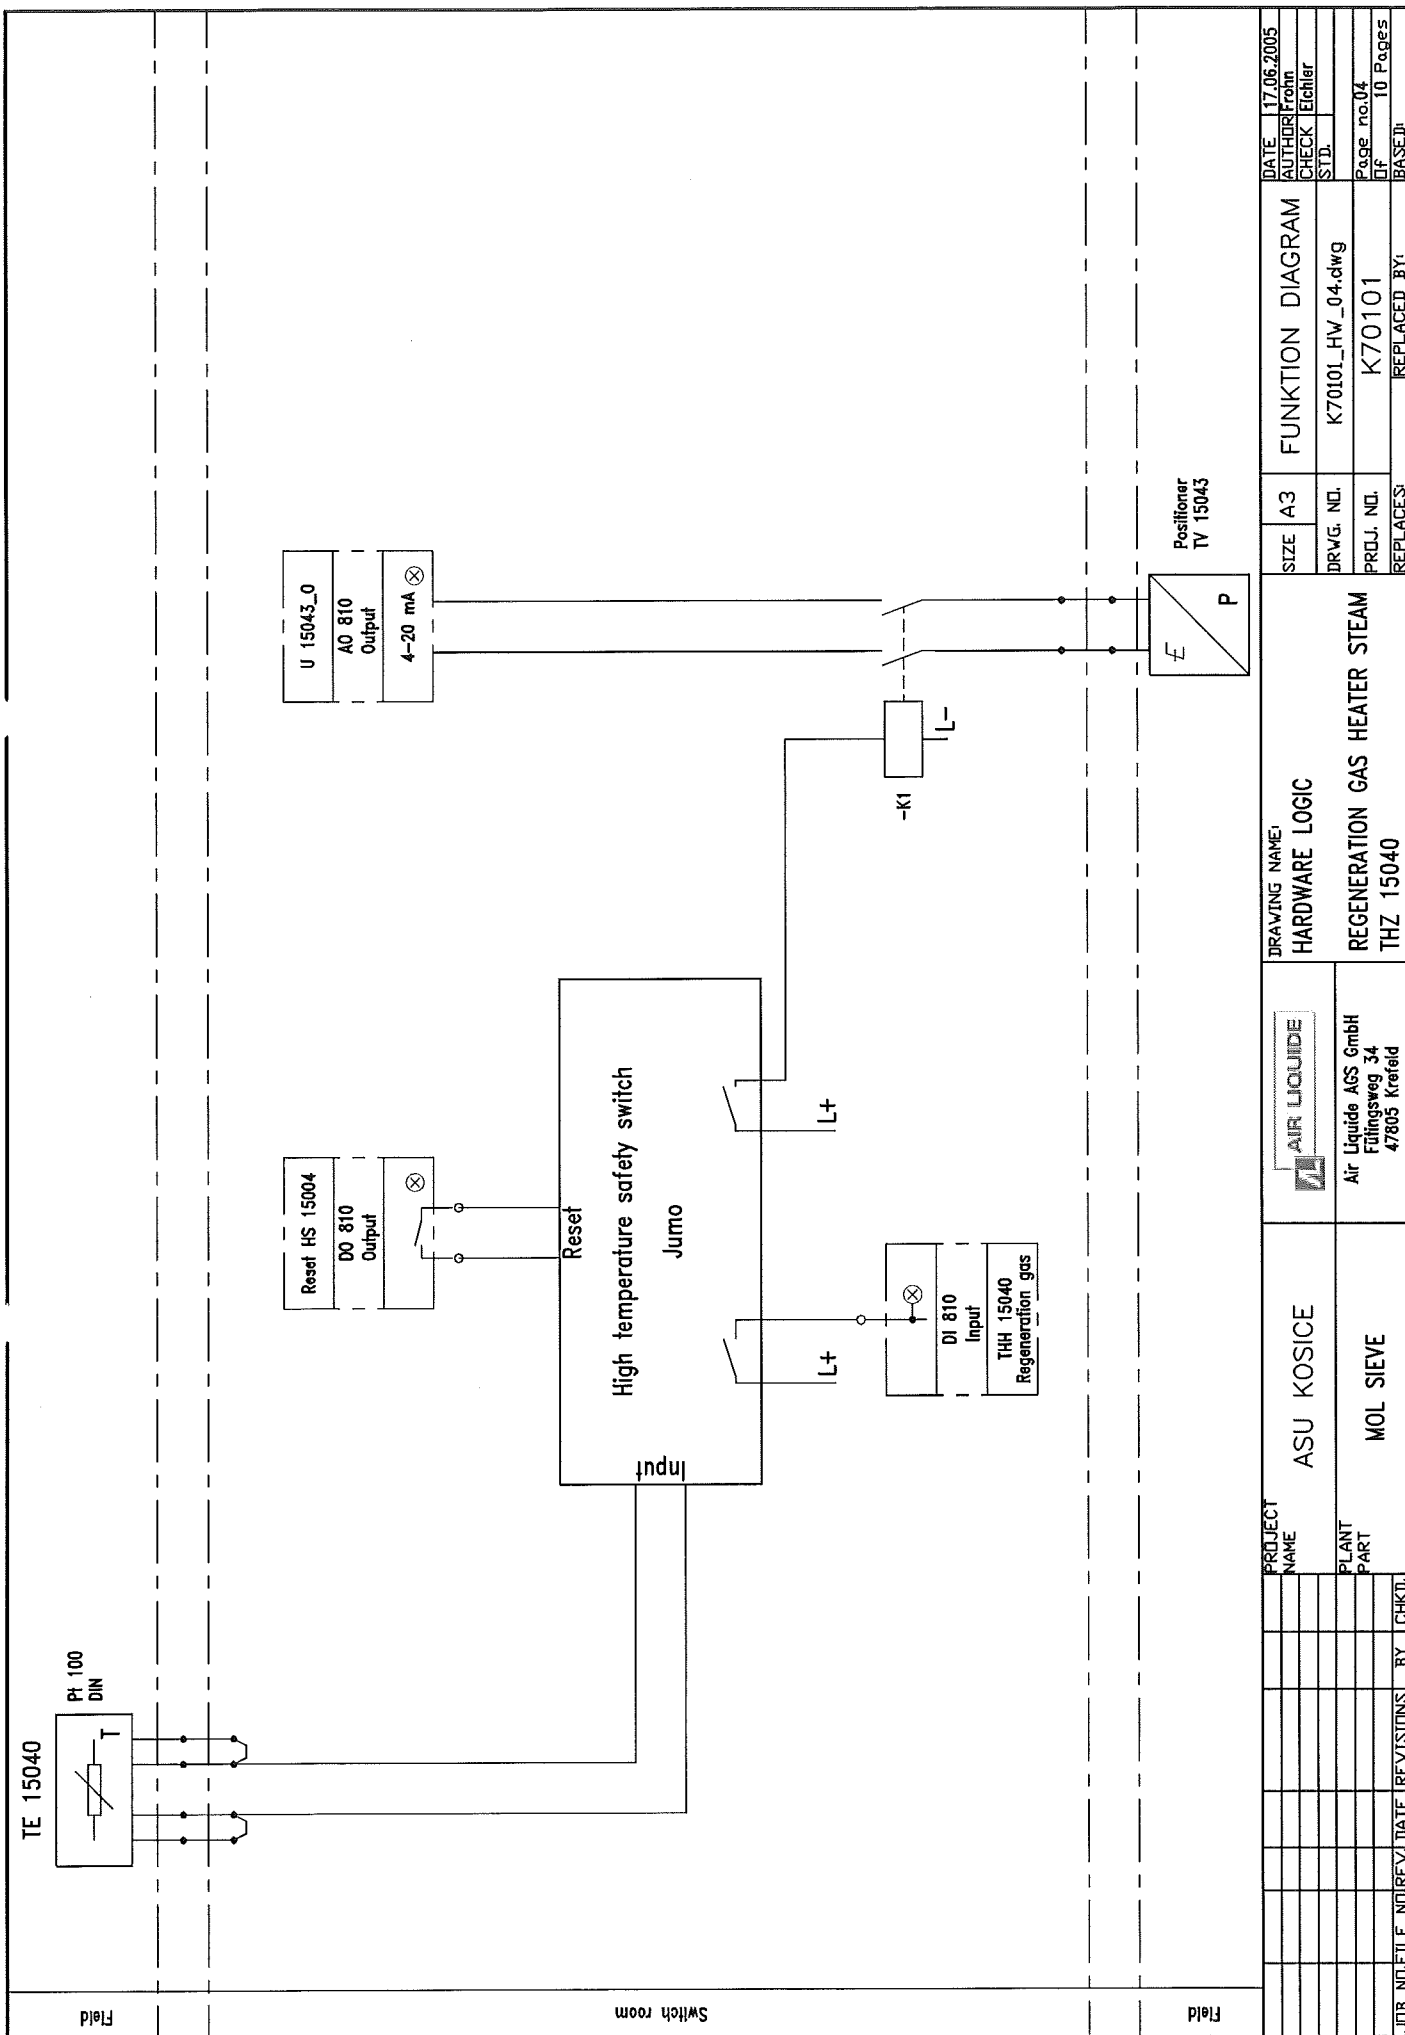

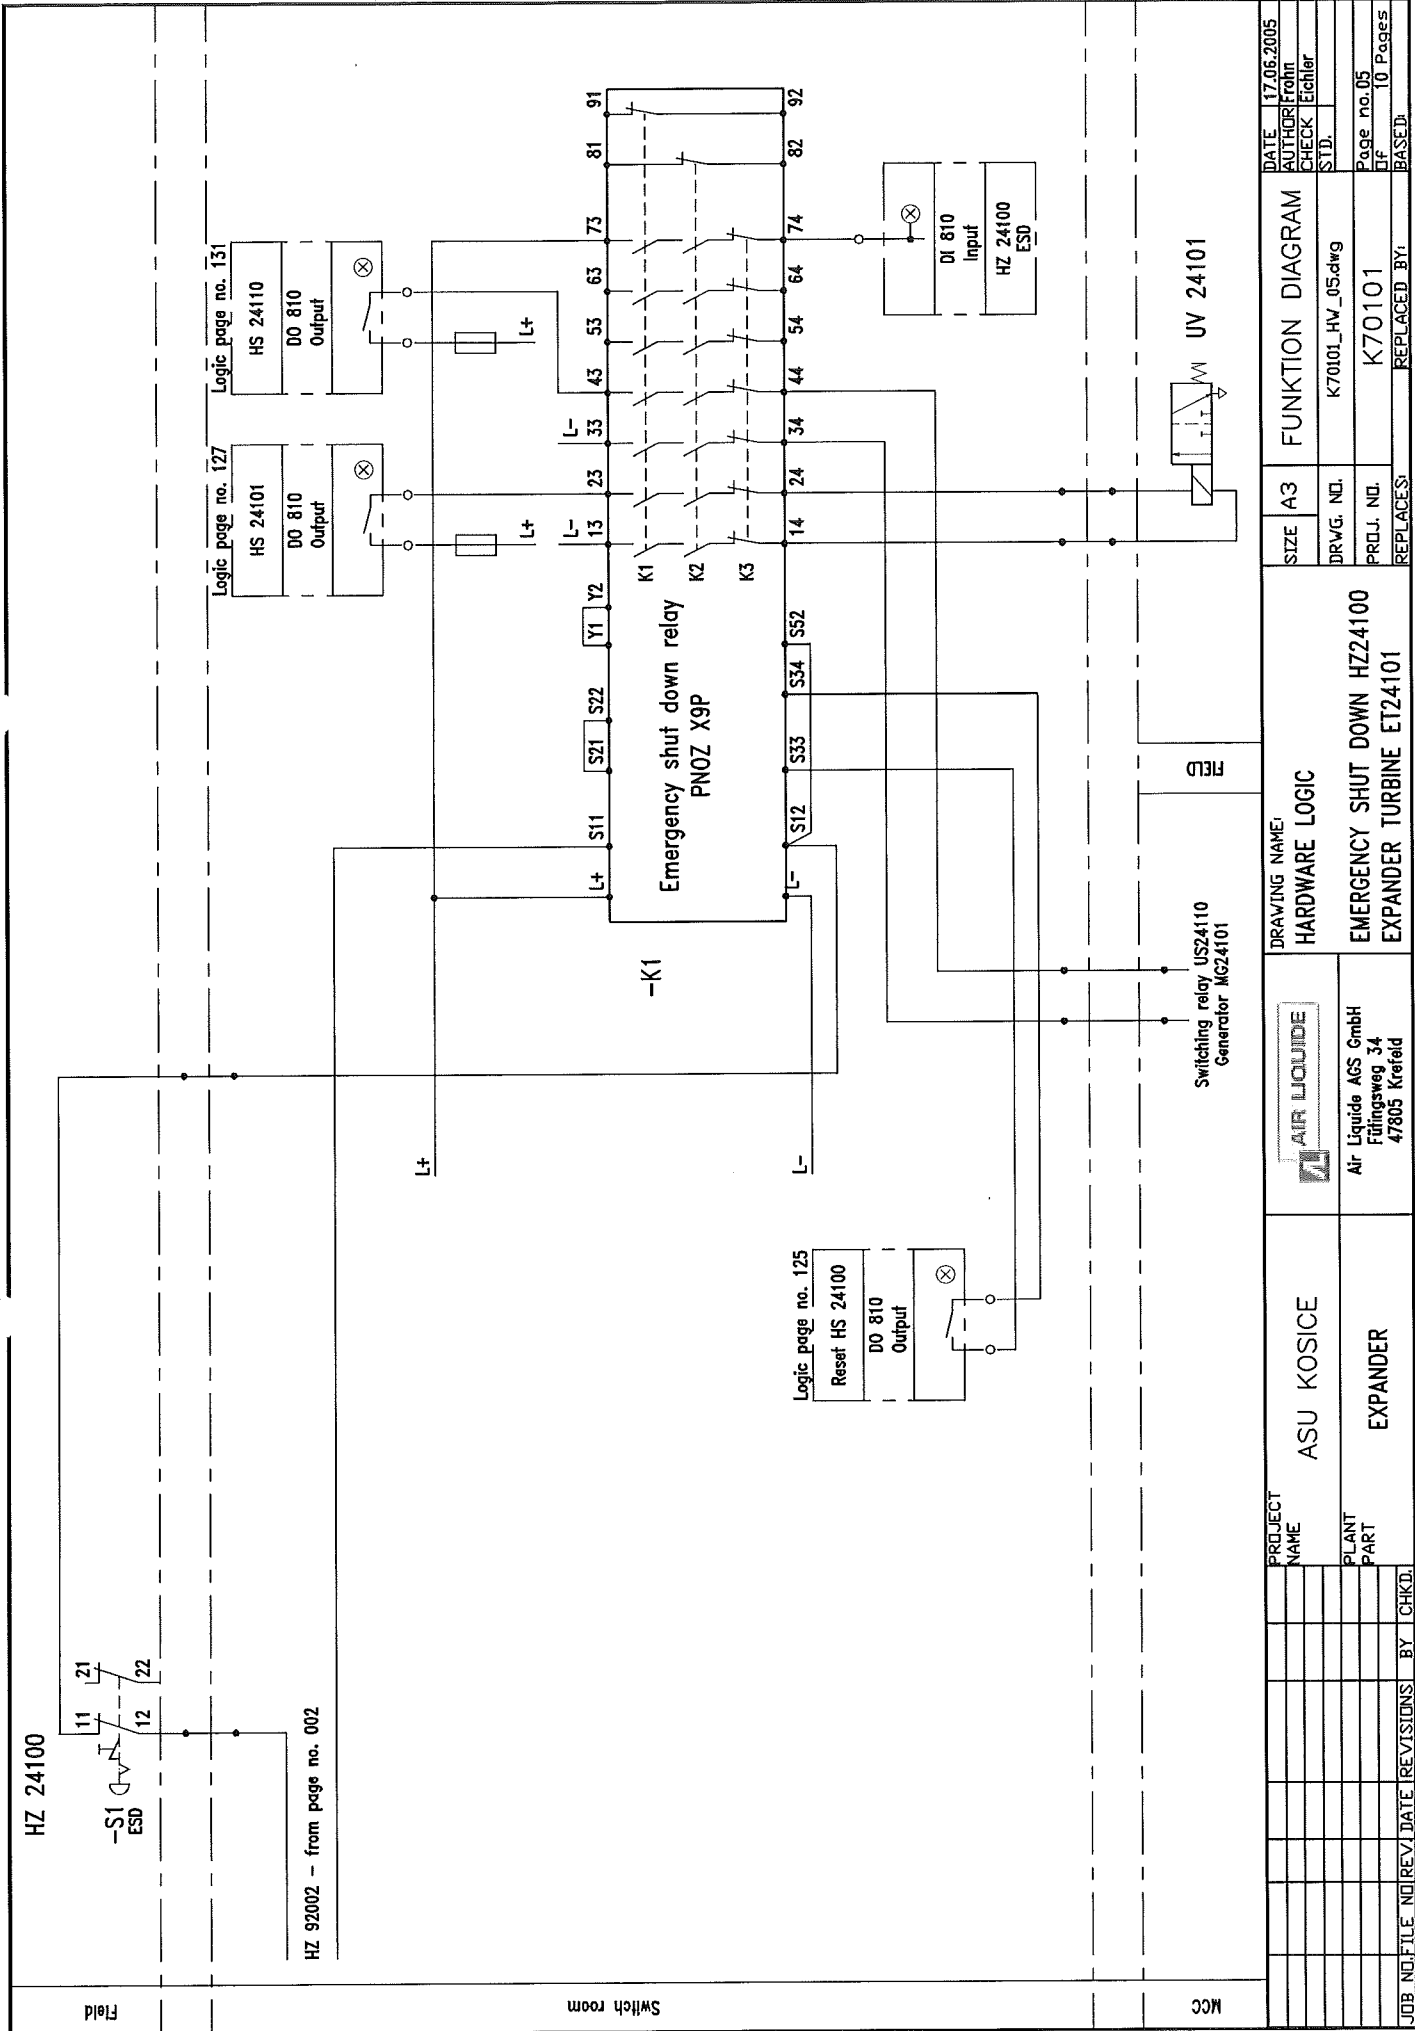


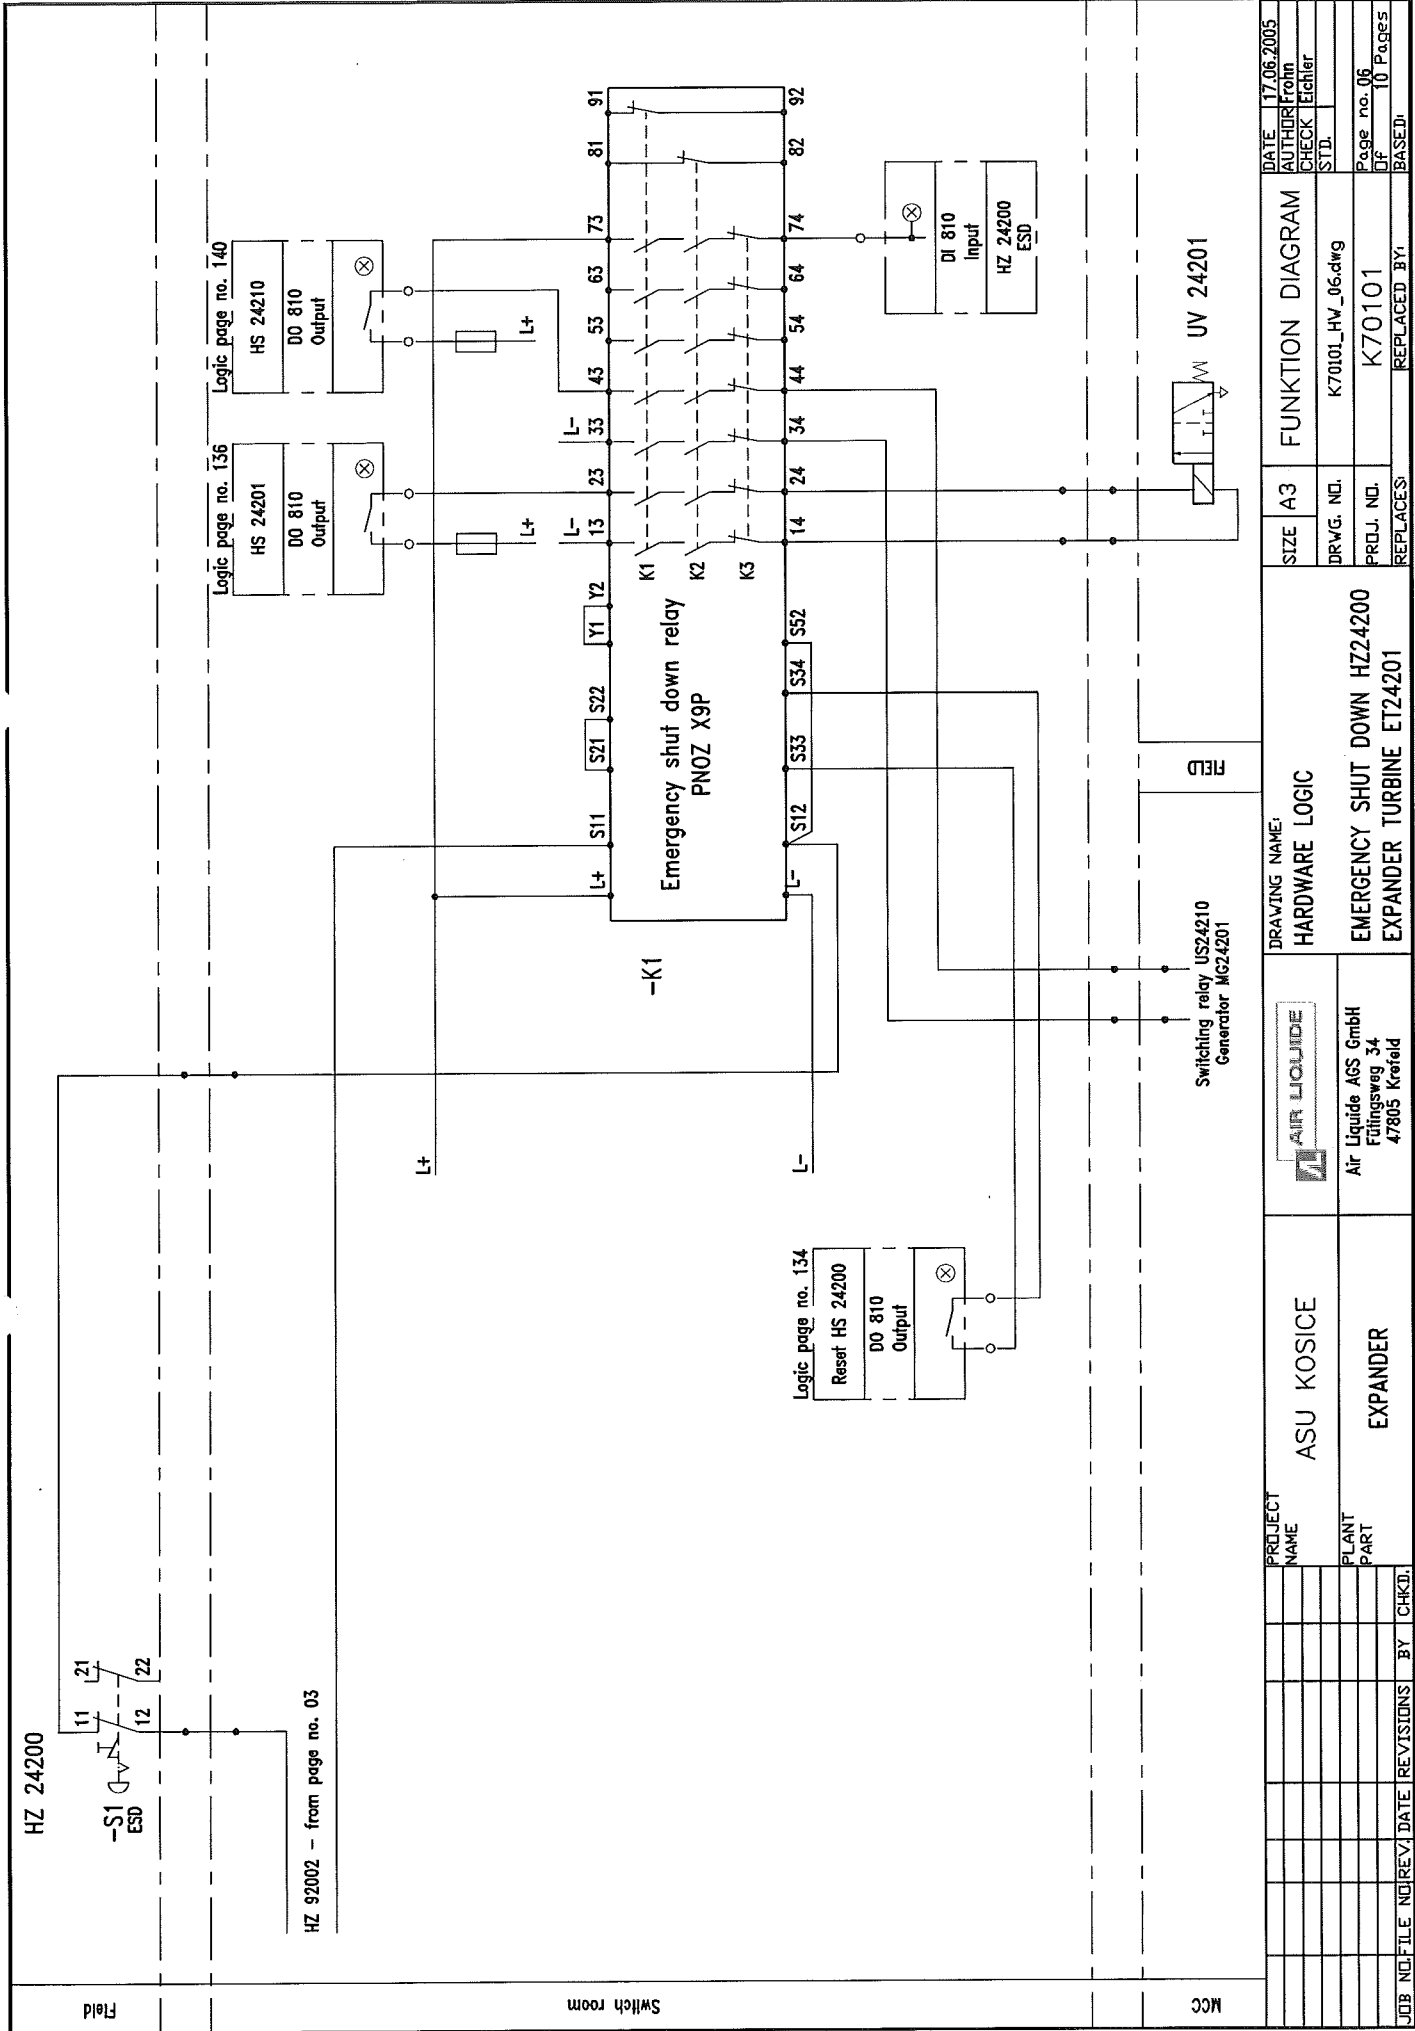


Field	Switch room	MCC
DATE	17.06.2005	
AUTHOR	From	
CHECK	Echler	
STD.		
Page no. 06		
Of	10	Pages
BASED		
SIZE	A3	
FUNKTION	DIAGRAM	
DRWG. NO.	K70101_HV_06.dwg	
PROJ. NO.	K70101	
REPLACES	REPLACED BY:	
DRAWING NAME:	HARDWARE LOGIC	
AIR LIQUIDE	EMERGENCY SHUT DOWN HZ24200	
Air Liquide AGS GmbH	EXPANDER TURBINE ET24201	
Füllingsweg 34		
47805 Krefeld		
PROJECT NAME	ASU KOSICE	
PLANT PART	EXPANDER	
JOB NO.	FILE NO.	REV.
DATE	REVISIONS	BY
CHKD.		

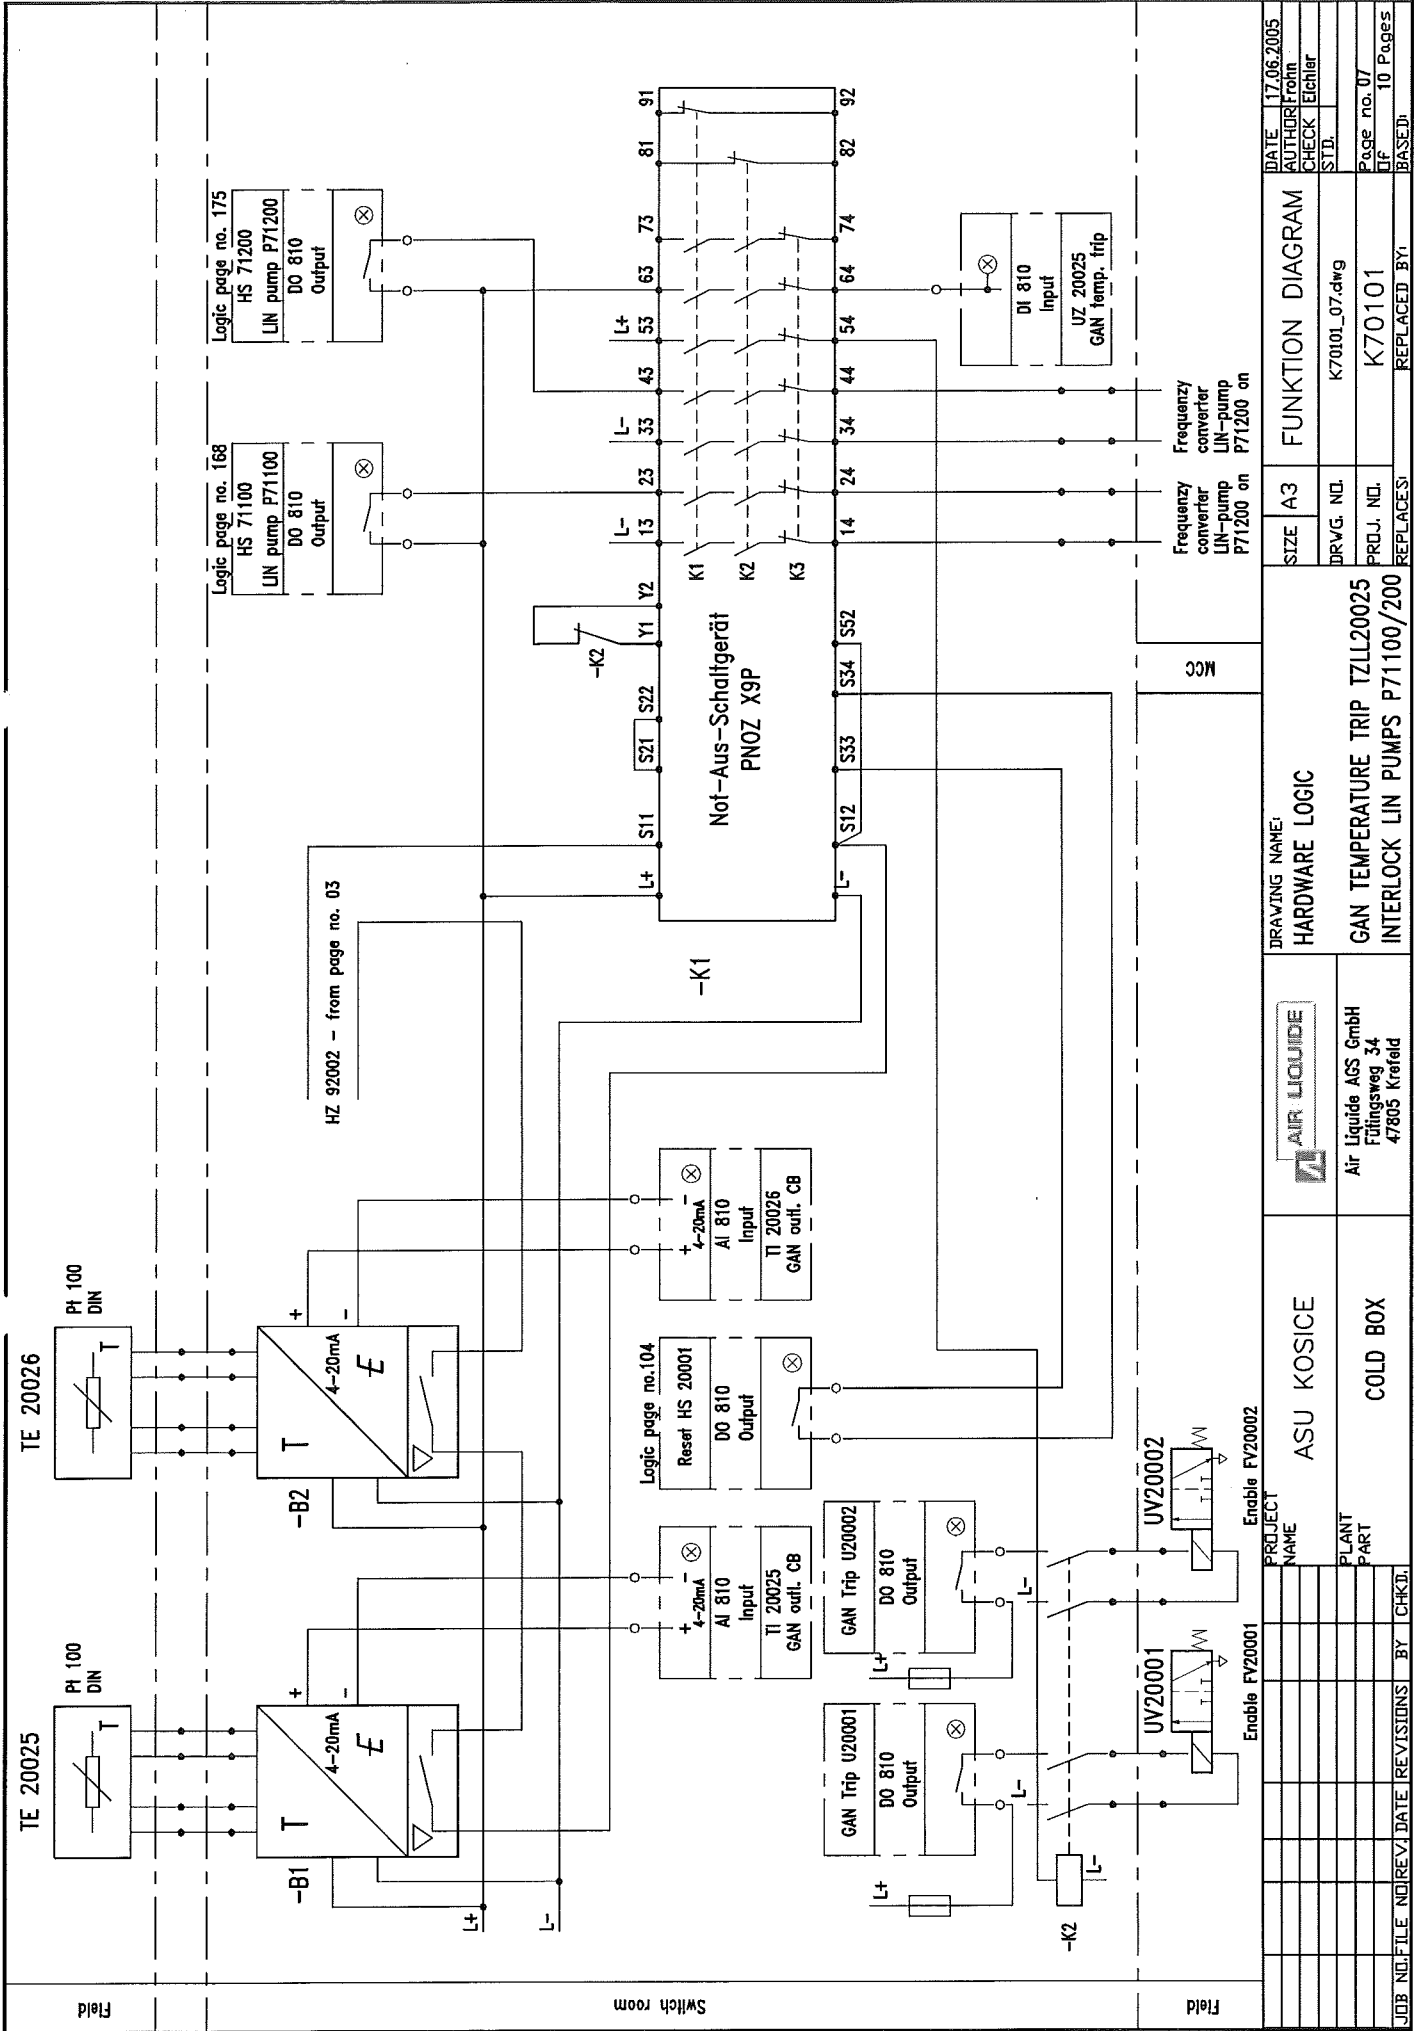


JOB NO.	FILE NO.	REV.	DATE	REVISIONS	BY	CHKD.
PROJECT NAME						
ASU KOSICE						
DRAWING NAME						
HARDWARE LOGIC						
AIR LIQUIDE						
Air Liquide AGS GmbH						
Füllingsweg 34						
47805 Krefeld						
DRAWING NO.						
K70101_07.dwg						
PROJECT NO.						
K70101						
REPLACES						
REPLACED BY						
DATE						
17.06.2005						
AUTHOR						
From						
CHECK						
Etchler						
STD.						
Page no. 07						
OF 10 Pages						
BASED						

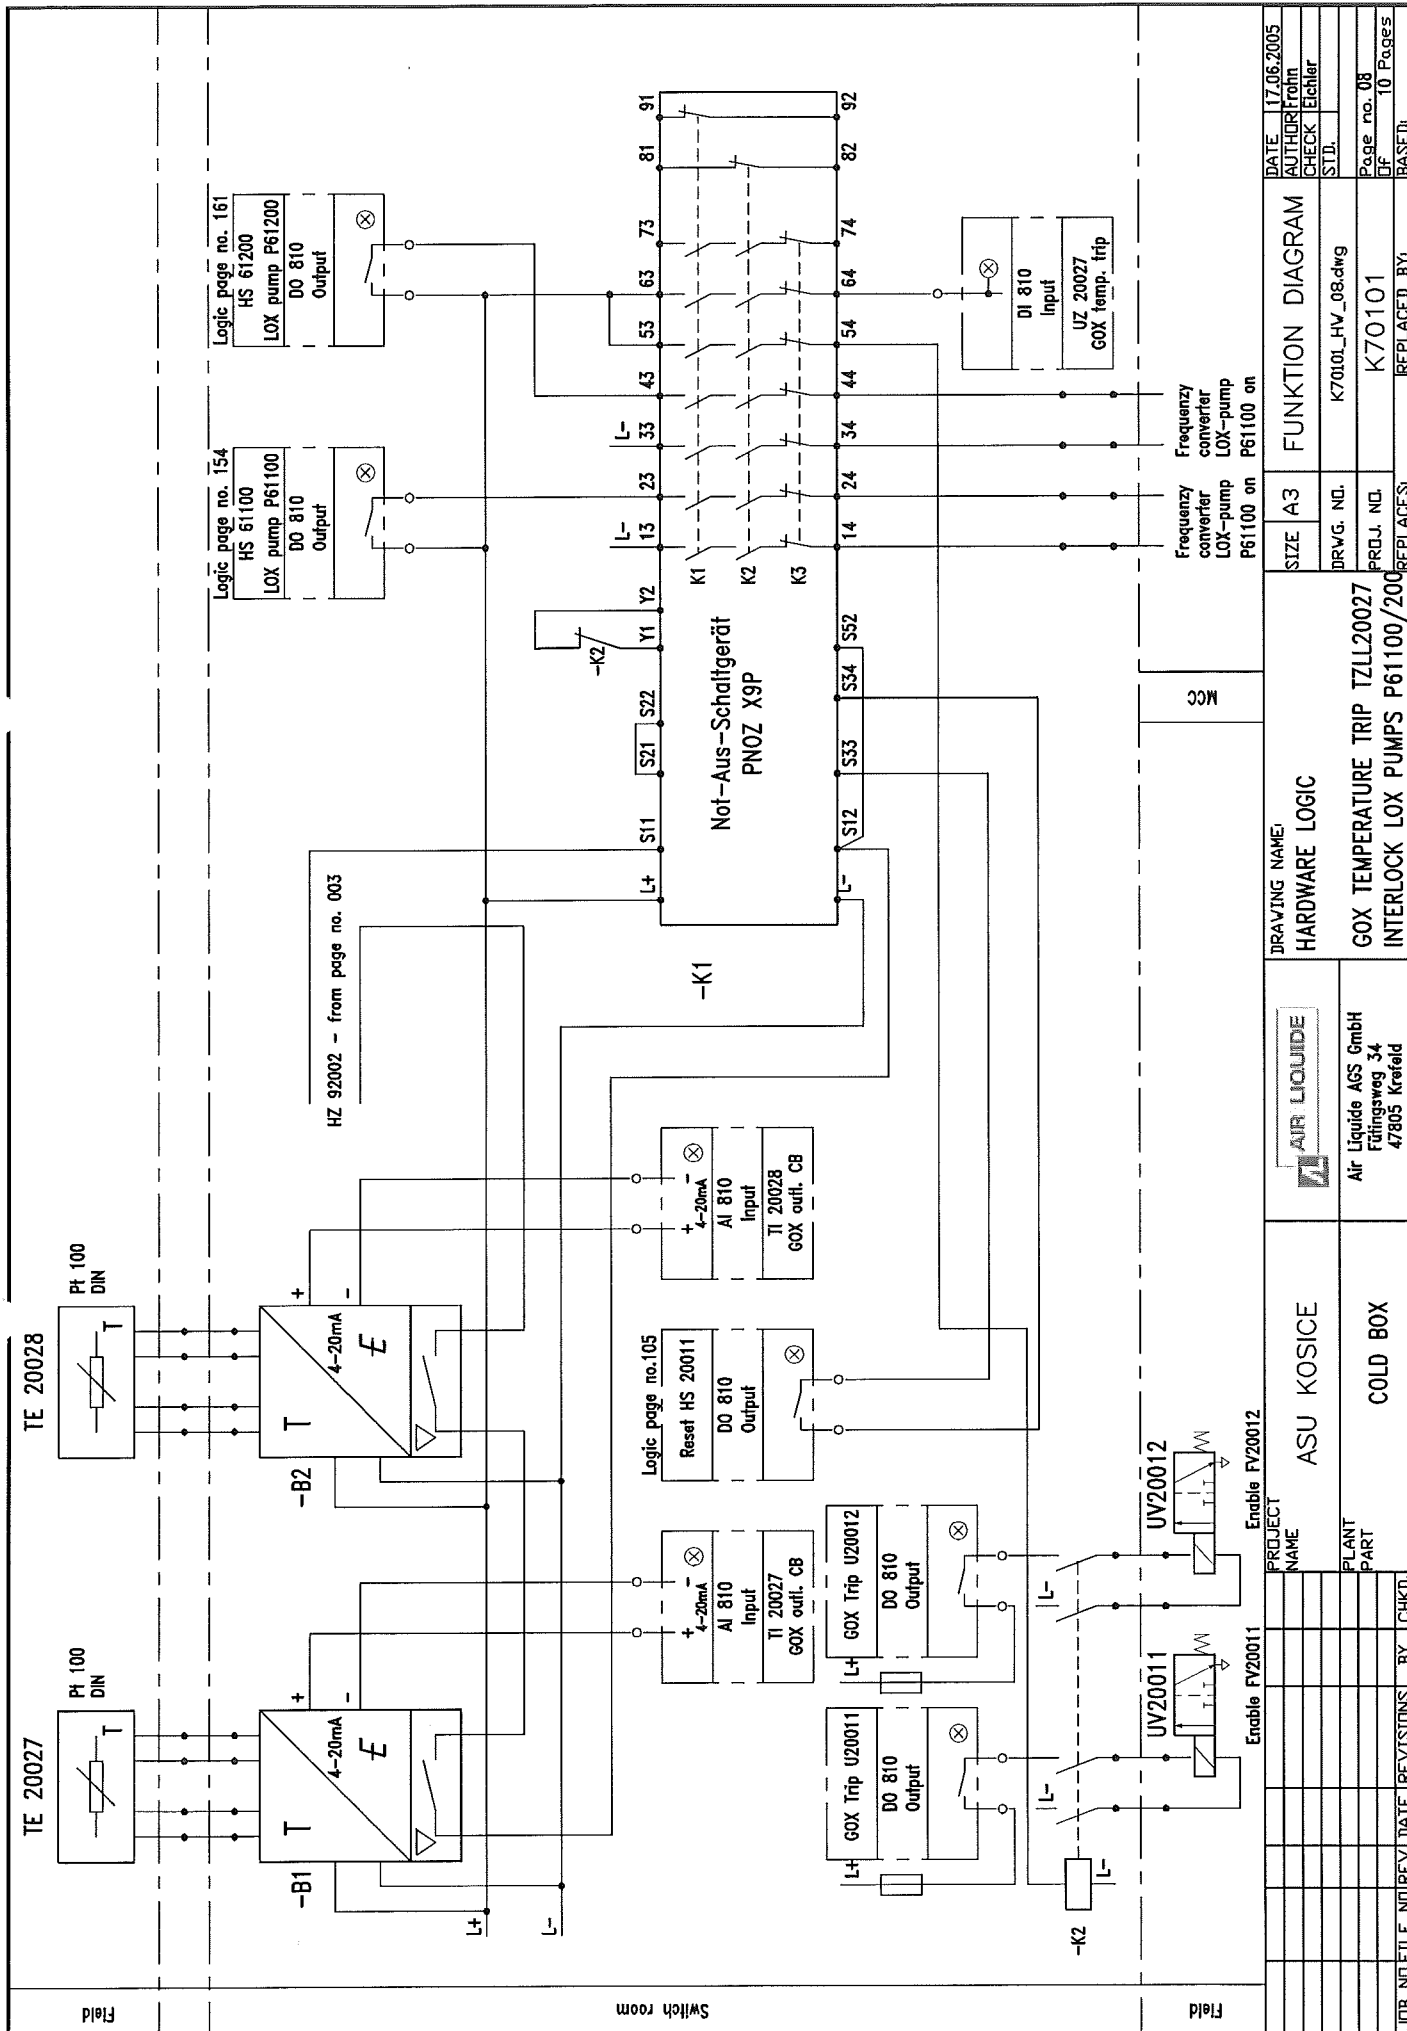

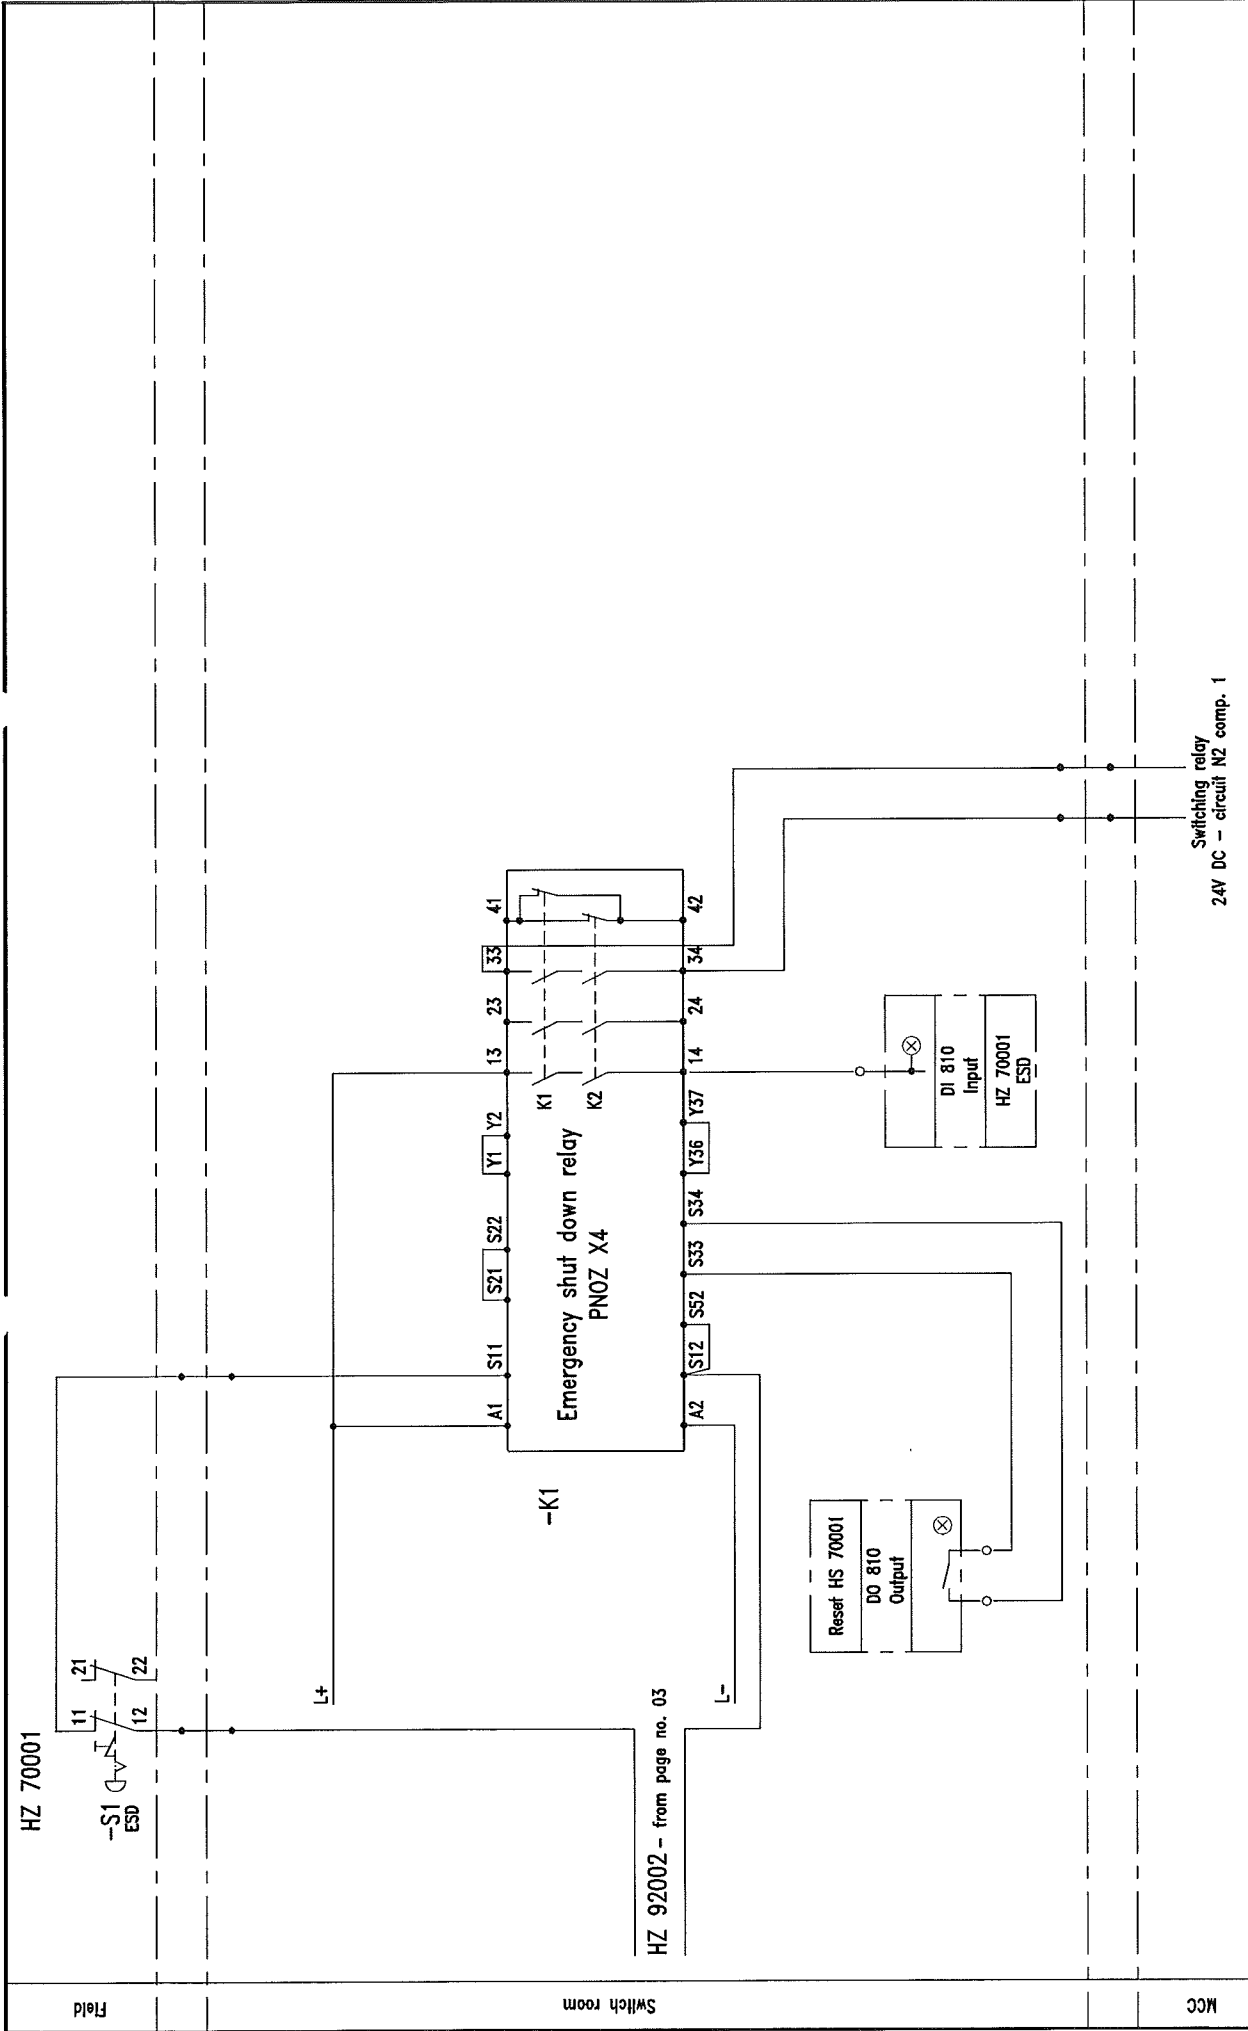

--	--	
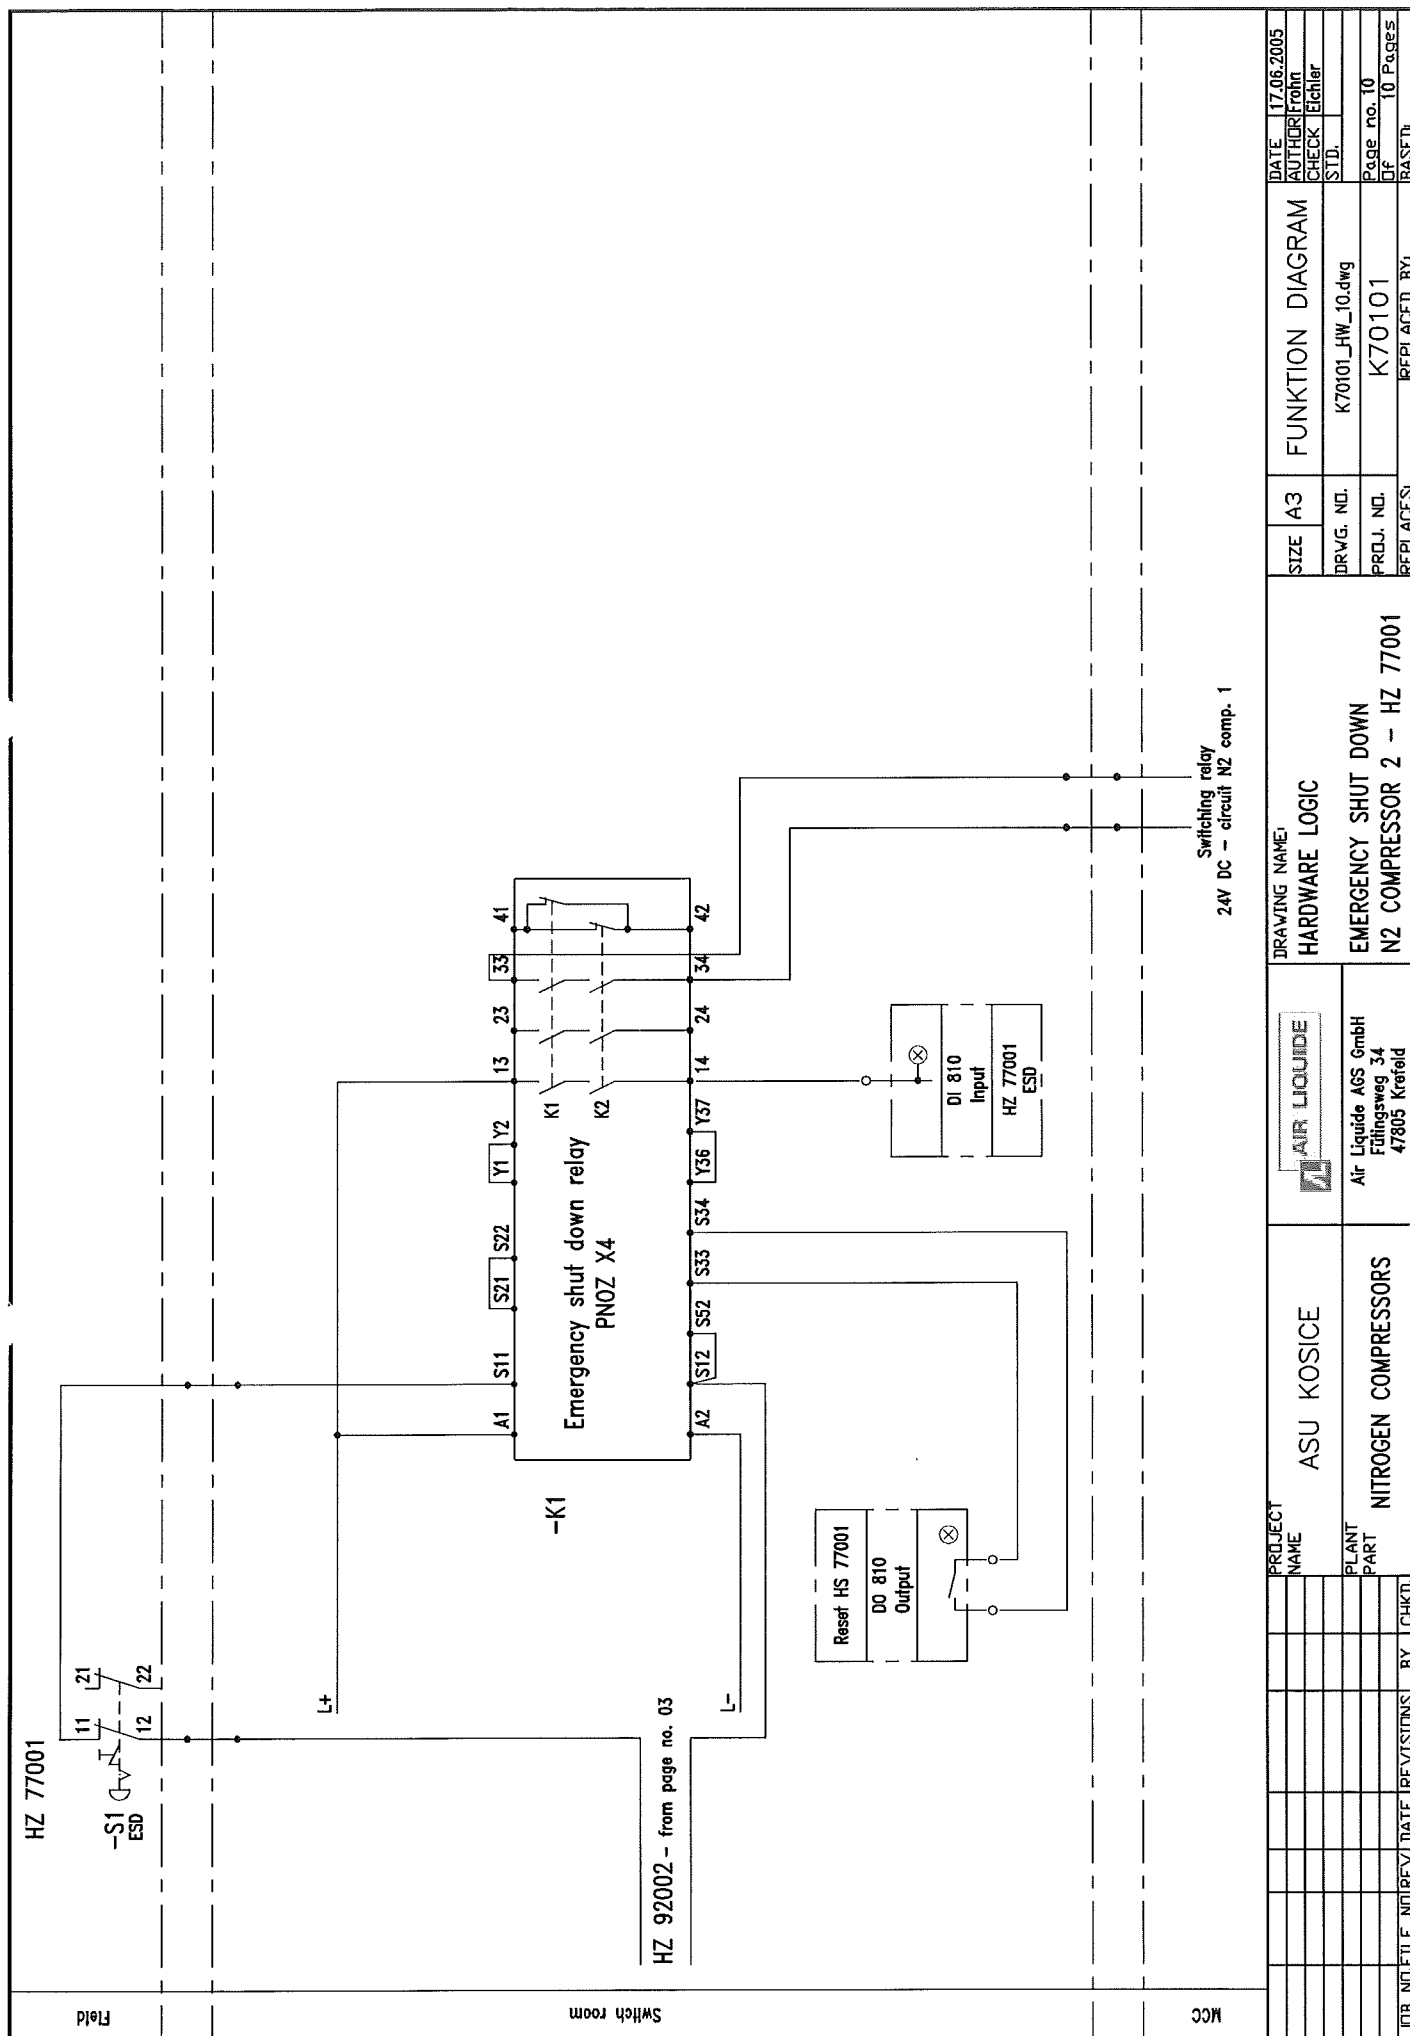

DATE	17.06.2005
AUTHOR	Frohn
CHECK	Eichler
STD.	
FUNKTION	DIAGRAM
SIZE	A3
DRWG. NO.	K70101_HW_10.dwg
PROJ. NO.	K70101
REF. ACES	REF. ACES BY:
PAGE NO.	10
OF	10 Pages
BASED	

Comment	Origin	Signal-/TAG-No.	Function
MAC main drive	Check back signal	1 EH 11001	T2 T1 = Start time MAC 60s T3 = Bypass on start 30s
Reset trip MAC	Reset button OS	1 HS 11000	S R HS 11001
Ready to start MAC	from page no. 5/70	1 UH 11003	Motor-Logic Safety Intervention On Interlock On Automatic On Operator Input On Operator Input Off Automatic Off Interlock Off Safety Intervention Off
Trip Main air compr.	from page no. 2/57	1 US 11000	Error Check Back Error Running Time

DATE 17.06.2005

AUTHOR From

CHECK Eichler

STD.

Page no. 001

OF 230 Pages

BASEDn

DRAWING NAME:

AIR LIQUIDE

ASU KOSICE

MAIN AIR COMPRESSOR (MAC)

MAIN DRIVE HS11001

Air Liquide AGS GmbH

Fillingweg 34

47805 Krefeld

PROJECT NAME

PLANT PART

Rev3 08.6.07 as built

Rev2 02.2.06

FROM FROM REVISIONS BY CHKD.

Slipstick

Eichler

BY CHKD.



## Function

Function									
Comment	Origin	Signal-/TAG-No.	Tag	Signal-/TAG-No.	Destination	Comment			
			1						
			2						
Reset Trip MAC	Software reset button	1 HS 11000	3						
			4		Alarm OS	Trip MAC			
			5						
			6						
			7		to page no. 1/44	Trip main air compressor			
			8						
Oil pressure MAC	Value < Min2	1 PLL 11847_2	9		to page no. 5/23	Ready to start			
			10			UH 11003			
			11						
Start up sequence		1 EH 11001_2	12		to page no. 10/7	Open blow off valve			
			13		to page no. 15/24	US 11074			
Axial displacement	Value > Max2	1 GHH 11742	14		to page no. 21/20	Produce Trip DCAC			
Axial displacement	Value < Min2	1 GLL 11742	15			US 13000			
Vibration gear HSS	Value > Max2	1 XHH 11740	16		to page no. 011/12	Produce trip molsieve			
Vibration gear HSS	Value > Max2	1 XHH 11743	17			US 15000			
Vibration comp. DS	Value > Max2	1 XHH 11745	18			US11706			
Vibration comp. SS	Value > Max2	1 XHH 11747	19		to page no. 78/15	FIC 15035			
			20						
Bearing gear LSS DE	Value > Max2	1 THH 11730	21						
Bear. gear LSS NOE	Value > Max2	1 THH 11733	22						
Thrust bearing I/B	Value > Max2	1 THH 11735	23						
Thrust bearing O/B	Value > Max2	1 THH 11737	24						
Bearing gear HSS NDE	Value > Max2	1 THH 11740	25						
Bearing gear HSS DE	Value > Max2	1 THH 11743	26						
Bearing comp. DS	Value > Max2	1 THH 11745	27						
Bearing comp. SS	Value > Max2	1 THH 11747	28						
			29						
			30						
			31						
			32						
			33						
			34						
			35						
			36						
			37						
			38						
			39						
			40						
Bearing main motor	Value > Max2	1 THH 11701	41						
Bearing main motor	Value > Max2	1 THH 11703	42						
Motor winding U	Value > Max2	1 THH 11715	43						
Motor winding V	Value > Max2	1 THH 11718	44						
Motor winding W	Value > Max2	1 THH 11721	45						
			46						
			47						
Trip conditions MAC	from page no. 3/79	1 US 11000_1	48						

110

111

S

1

1

R

5s

≥1

Tag	51	52	53	54	55	56	57	58	59	60	61	62	63	64	65	66	67	68	69	70	71	72	73	74	75	76	77	78	79	80	81	82	83	84	85	86	87	88	89	90	91	92	93	94	95	96	97	98				
Signal-/TAG-No.				UA 11000			US 11000		US 11000		US 11000		US 11000_dyn		US 11000_dyn		US 11000		US 11000																																	
Destination				Alarm OS			to page no. 1/44		to page no. 5/23		to page no. 10/7		to page no. 15/24		to page no. 21/20		to page no. 011/12		to page no. 78/15																																	
Comment				Trip MAC			Trip main air compressor		Ready to start		UH 11003		US 11074		Produce Trip DCAC		US 13000		Produce trip molsieve		US 15000		US11706																													

DATE 17.06.2005

AUTHOR Frohn

CHECK Echler

STD.

Page no.002

K70101\_002.dwg

K70101

230 Pages

REPLACES: REPLACED BY:

DRAWING NAME:  
MAIN AIR COMPRESSOR (MAC)  
Trip MAC US11000AIR LIQUIDE  
Air Liquide AGS GmbH  
Fulingsweg 34  
47805 Krefeld

ASU KOSICE

MAIN AIR COMPRESSOR

PLANT

PART

Shipped

Frohn

Echler

BY

CHKD.

Rev2 02.2.06

Rev3 08.6.07 as built

NO FILE

NO

REV

DATE

REVISIONS

Function																			
Comment	Origin	Signal-/TAG-No.	Tag	Type	Signal-/TAG-No.	Destination	Comment	Signal-/TAG-No.	Tag	Type	Signal-/TAG-No.	Destination	Comment	Signal-/TAG-No.	Tag	Type	Signal-/TAG-No.	Destination	Comment
			1																
			2																
			3																
			4																
Start air compressor	from page no. 1/82	1 HS 11001	5																
			6																
			7																
			8																
Emergency shut down	Contact ESD-relay	1 HA 92002	22																
			23																
			24																
			25																
			26																
			27																
Discharge MAC	Value > Max2	1 THH 11041	28																
			29																
Surge protection	from page 12/76	1 UHH 11074	30																
			31																
			32																
			33																
Sec 0

&

≥1

DATE 17.06.2005		AUTHOR Frohn		CHECK Eichler	
SIZE A3		FUNKTION DIAGRAM		STD:	
DRWG. NO.		K70101_003.dwg		Page no. 003	
PROJ. NO.		K70101		Of 230 Pages	
REPLACES:		REPLACED BY:		BASED:	


DRAWING NAME:  
MAIN AIR COMPRESSOR (MAC)  
TRIP CONDITIONS MAC US11000.1

AIR LIQUIDE  
Air Liquide AGS GmbH  
Füllingsweg 34  
47805 Krefeld

PROJECT NAME  
ASU KOSICE  
MAIN AIR COMPRESSOR

Rev3 08.6.07 "as built"	Frohn	Shipack	BY	CHKD.
Rev2 02.2.06	Frohn	Eichler		

## Function

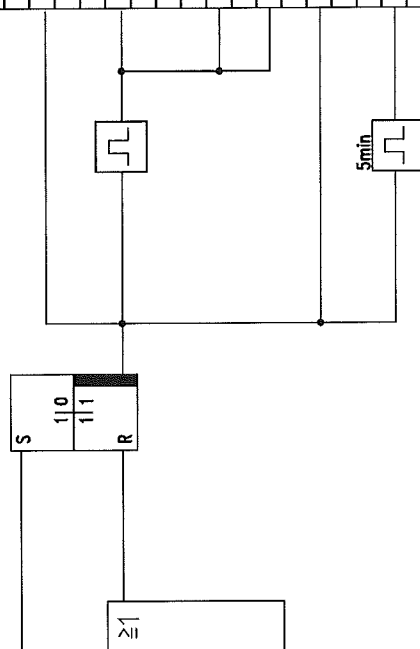[illegible]

Function										Signal/TAG-No.	Destination	Comment
Comment	Origin	Signal-/TAG-No.	Typ	Size	PROJ. NO.	DATE	REV.	DATE	REV.	Signal/TAG-No.	Destination	Comment
Trip DC/AC	from page no. 15/77	1 US 13000	51	A3	17.06.2005	1		17.06.2005		17.06.2005		
Position UK 15011	End position switch	1 GL 15011	52			2						
Position UK 15021	End position switch	1 GL 15021	53			3						
UK 15018 closed	from page no. 59/83	0 US 15018	54			4						
UK 15028 closed	from page no. 65/83	0 US 15028	55			5						
Guide vane MAC	End position switch	1 GL 11010	56			6						
Blow off valve MAC	End position switch	1 GH 11074	57			7						
Oil pressure MAC	Value < Min	1 PL 11854	58			8						
Oil circuit MAC	Value < Min	1 TL 11854	59			9						
Level oil Tank	Level switch > Min	1 LL 11812	60			10						
Trip MAC	from page no. 2/59	1 US 11000	61			11						
MAC main drive	Check back signal	1 EH 11001	62			12						
Enabling main motor disabled	from page no. 6/73	1 US11003_3	63			13						
Collective alarm	Contact from MCC	0 EH 11004	64			14						
Cooling water	Value < Min	1 FL 80001	65			15						
Air to MHE closed	End position switch	1 GL 20026	66			16						
Press. air to MHE	Y < 1%	1 HIC 20027	67			17						
Condensate Trap ok	Contact	1 LH 11080	68			18						
Condensate trap ok	Contact	1 LH 11084	69			19						
Seal chamber press.	Value < Min	1 PL 11754	70			20						
PK 16007 closed	Output Y < 1%	1 PIC 16007	71			21						
Aux. oilpump exp.1	Check back signal	1 EH 24163	72			22						
Aux. oilpump exp.2	Check back signal	1 EH 24263	73			23						
			74			24						
			75			25						
			76			26						
			77			27						
			78			28						
			79			29						
			80			30						
			81			31						
			82			32						
			83			33						
			84			34						
			85			35						
			86			36						
			87			37						
			88			38						
			89			39						
			90			40						
			91			41						
			92			42						
			93			43						
			94			44						
			95			45						
			96			46						
			97			47						
			98			48						

DRAWING NAME:				FUNCTION DIAGRAM				DATE 17.06.2005			
MAIN AIR COMPRESSOR (MAC)				K70101_005.dwg				AUTHOR From			
READY TO START UH11003				K70101				CHECK Eicher			
Air Liquide AGS GmbH				K70101				STD.			
Füllingsweg 34				K70101				Page no. 005			
47805 Krefeld				K70101				Of 230 Pages			
ASU KOSICE				REPLACES:				BASED:			
MAIN AIR COMPRESSOR				K70101				K70101			
PROJECT NAME				K70101				K70101			
ASU KOSICE				K70101				K70101			
PLANT				K70101				K70101			
Rev3 08.6.07 as built				K70101				K70101			
Rev2 02.2.04				K70101				K70101			
NO FILE NO REV DATE REVISIONS BY CHKD.				K70101				K70101			

Rang	Comment	Origin	Type	Signal-/TAG-No.	Pz	Function	Rang
					1		
					2		
					3		
					4		
					5		
					6		
	MAC motor drive	Check back signal	1 EH 11001		7		
					8		
					9		
					10		
T1 = Time for motor is cold  
T2 = Time for motor is warm  
T3 = Reset time after 3 failed cold starts  
T4 = Reset time after 1 successful warm start  
T5 = Minimum disable time  
C1 = Counter for cold starts  
C2 = Counter for warm starts

Rev3 08.6.07 as built\*  
Rev2 02.2.06  
BY: [Signature]  
DATE: [Date]

PROJECT NAME: ASU KOSICE  
PLANT PART: MAIN AIR COMPRESSOR  
FROHN STEPPICH  
Eichler

DATE: 17.06.2005  
AUTHOR: Frohn  
CHECK: Eichler  
STD.:  
Page no. 006  
OF 230 Pages  
BASED:  
K70101\_006.dwg  
K70101  
REPLACES:

[illegible]

Rang	Comment	Origin	Signal-/TAG-No.	Typ	Function	Rang
1						51
2						52
3	Oil pressure MAC	Value < Min1	1 PL 11747			53
4						54
5	Oil pressure MAC	Value < Min1	1 PL 11854			55
6						56
7						57
8						58
9						59
10	MAC main drive on	Check back signal	1 EH 11001			60
11						61
12						62
13						63
14	Seal camber press.	Value < Min	1 PL 11754			64
15						65
16	Lube oil reservoir	Contact < Min	1 LL11812			66
17						67
18	Lube oil reservoir	Value < Min2	1 TLL 11814			68
19						69
20						70
21						71
22						72
23						73
24	Aux. oil pump on	Check back signal	1 EH 11820			74
25						75
26						76
27						77
28						78
29						79
30						80
31						81
32						82
33						83
34						84
35						85
36						86
37						87
38						88
39						89
40	Reset Trip MAC	Software reset button	1 HS 11000			90
41						91
42						92
43						93
44						94
45						95
46						96
47						97
						98

**Function**

HS 11820

T2 = Relubrication time  
T3 = Start up time

SIZE	A3	FUNKTION DIAGRAM	DATE	17.06.2005
DRWG. NO.	K70101_008.dwg	AUTHOR	From	From
PROJ. NO.	K70101	CHECK	Eichler	Eichler
REPLACES		STD.		
		Page no.	008	
		OF	230	Pages
		REPLACED BY:		

Function				Page	Signal-/TAG-No.	Destination	Comment	Range
				1				51
				2				52
				3				53
				48				98

**HS 11803**

**Function Diagram**

DATE: 17.06.2005  
AUTHOR: Frohm  
CHECK: Etchler  
STD.  
Page no. 009  
of 230 Pages  
BASED:



[illegible][illegible]

Function										DRAWING NAME: MAIN AIR COMPRESSOR (MAC) SPARE MOTOR HEATING US 11706										DATE 17.06.2005 AUTHOR From CHECK Eichler STD.				DATE 17.06.2005 AUTHOR From CHECK Eichler STD.																																																																																																																																																																																																																																																																																																																																																																																																																																																																																																																																																																																																																																																																																																																																																				
Comment	Origin	Signal-/TAG-No.	Type	Signal-/TAG-No.	Destination	Comment	Comment	
Rev.	Comment	Origin	Type	Signal-/TAG-No.	Page	Function	Page	Tag	Type	Signal/TAG-No.	Destination	Comment	Rev.
					1		51						
					2			52					
					3			53					
					4			54					
					5			55	1	USHH 11074		to page no. 010/11	Surge protection
					6			56					
					7			57					
	Discharge pressure	P-Transmitter	1 PT 11041		8			58					
	MAC				9			59					
					10			60					
					11			61					
					12			62					
					13			63					
					14			64	1	UAH 11074		Alarm OS	"1 surge push"
					15			65					
					16			66	1	UH 11074		to page no. 013/25	
					17			67					
					18			68					
					19			69					
					20			70					
					21			71					
					22			72					
					23			73					
	Reset surge protect.	Software push button	1 US11074_RES		24			74	1	UAHH 11074		Alarm OS	"Surge protection"
					25			75					
					26			76	1	UHH 11074		to page no. 003/30	Surge protection
					27			77					
					28			78	1	USHHH 11074		to page no. 10/13	Surge protection
					29			79					
					30			80					
					31			81					
					32			82					
					33			83					
					34			84					
					35			85					
					36			86					
					37			87					
					38			88					
					39			89					
	Blow off valve open	End position switch	1 GH 11074		40			90					
					41			91					
					42			92					
					43			93					
					44			94					
					45			95					
					46			96					
					47			97					
							98						
DRAWING NAME: PROJECT NAME: ASU KOSICE PLANT PART: MAIN AIR COMPRESSOR (MAC) ANTI SURGE PROTECTION U11031													
DATE: 17.06.2005													
AUTHOR: Frohn													
CHECK: Echter													
SIZE: A3													
FUNKTION DIAGRAM													
DRVG. NO. K70101_012.dwg													
PRDJ. NO. K70101													
REPLACES: REPLACED BY:													
Page no. 012 of 230 Pages													
BASED:													

Function					
Comment	Origin	Type	Signal-/TAG-No.	Signal-/TAG-No.	Destination
		1			
		2			
		3			
		4			
		5			
		6			
		7			
		8			
		9			
		10			
		11			
		12			
		13			
		14	E FY 11074		
Output signal FIC11074	0...100%	15			
		16			
		17			
		18			
		19			
+ 10%	Constant	20			
		21			
		22			
		23			
		24			
Surge protection	from page no. 12/66 1 UH 11074	25			
		26			
		27			
		28			
		29			
		30			
Output signal	0...100%	31	E P11041_1_0		
		32			
		33			
		34			
HIC 11074

```

graph TD
    M[Manual control station] --> S((+))
    SV[Y Start value] --> S
    SS[Y Start switch] --> S
    S --> SP[Surge protection]
    SP --> O[Output signal MAX]
    
```

Date	Author	Check	Drawn	Rev	Description
17.06.2005	Frohn	Eichler		1	K70101_013.dwg
				2	K70101
				3	REPLACES:
				4	BY

DATE: 17.06.2005  
AUTHOR: Frohn  
CHECK: Eichler  
STD:  
Page no. 013  
Of 230 Pages

[illegible]

[illegible][illegible]

[illegible]

Function									
Range	Comment	Origin	Type	Signal-/TAG-No.	Page				
					51				Comment
					52				
	Motor logic HS13100 at "automatic"	Automatic	1		53				
	CW pump P13200 on Check back signal	1 EH 13200	1		54				
					55				
					56				
					57				
					58				
					59				
					60				
					61				
	Reset trip DCAC	Software button OS	1 HS 13100_RES		62				
					63				
					64				
					65				
					66				
					67				
					68				
					69	1 HS 13100	Signal to MCC	CW pump P13100 DCAC on	
					70				
					71				
					83	1 HS 13100_CB	Alarm OS	"Check back error"	
					84				
					85				
					86				
					87	1 HS 13100_RT	Alarm OS	"Running time error"	
					88				
					89				
					90				
					91				
					92				
					93				
					94				
					95				
					96				
					97				
					98				

PROJECT NAME				DRAWING NAME: DC / AC				FUNCTION DIAGRAM				DATE: 17.06.2005
ASU KOSICE				AIR LIQUIDE				SIZE A3				AUTHOR: Frohn
DC / AC				Air Liquide AGS GmbH Füllingsweg 34 47805 Krefeld				DRWG. NO. K70101_016.dwg				CHECK: Echler
Rev3 08.6.07 "as built"				Frohn				PRJ.J. NO. K70101				Page no. 016
Rev2 02.2.06				Frohn				REPLACES: K70101				Page 230
JOB NO./FILE NO./REV DATE				REVIEWS BY				REPLACES: K70101				BASED: K70101

PROJECT NAME				DRAWING NAME				DATE 17.06.2005			
ASU KOSICE				DC / AC				AUTHOR From			
				AIR LIQUIDE				CHECK Fehler			
				Air Liquide AGS GmbH				STD.			
				Füllingsweg 34				K70101_016.dwg			
				47805 Krefeld				K70101			
Rev3 08.6.07 "as built"				PLANT				Page no. 016			
Rev2 02.2.06				PART				If			
JOB NO. FILE NO. REV. DATE REVISIONS BY CHKD.				REPLACES:				REPLACED BY:			
				DC / AC				230 Pages			
				HS 13100				BASED:			






Function										Range
Range	Comment	Origin	Type	Signal-/TAG-No.	Pin	Pin	Diagram	Signal-/TAG-No.	Destination	Comment
51					1	10				
52					2	11				
53					3					
54					4					
55					5					
56					6					
57					7					
58					8					
59					9					
60	Reset trip chill tower	Software button OS	1	HS 14000	10			UA 14000	Alarm OS	"Trip CW chill tower"
61					11					
62					12					
63					13					
64	Level chill tower	Value < Min2	1	LLL 14003	14			US 14000	to page no. 19/39	CW pump P14100 off
65					15					HS 14100
66	Trip DCAC	from page no. 15/80	1	US 13000	16			US 14000	to page no. 20/39	CW pump P14200 off
67					17					HS 14200
68	Alarm fail P14100	from page no. 19/66	1	HS 14100_CB_RT	18					
69					19					
70	Alarm fail P14200	from page no. 20/66	1	HS 14200_CB_RT	20			US 14000_dyn	UC 14003	Level chill tower
71					21				Manual, Y = 0%	
72					22			US 14000_dyn	TIC 12003	Chilled water to DCAC
73					23				Manual, Y = 0%	
74					24			US 14000_dyn	FIC 13006	
75					25				Manual, Y = 0%	Chilled water to DCAC
76					26			US 14000_dyn	to page no. 14/42	Chiller off
77					27					
78					28					
79					29					
80					30					
81					31					
82					32					
83					33					
84					34					
85					35					
86					36					
87					37					
88					38					
89					39					
90					40					
91					41					
92					42					
93					43					
94					44					
95					45					
96					46					
97					47					
98					48					

PROJECT NAME		DRAWING NAME		FUNKTION DIAGRAM		DATE 17.06.2005	
ASU KOSICE		CHILL TOWER		A3		AUTHOR From	
CHILL TOWER		TRIP US14000		SIZE		CHECK Feichter	
Rev3 08.07.2005 as built		Air Liquide AGS GmbH		DRVG. NO.		STB.	
Rev2 02.04.06		Füllingsweg 34		PROJ. NO.		Page no. 018	
JOB NO. FILE NO. REV. DATE		47805 Krefeld		REPLACES		Of 230 Pages	
				REPLACED BY:		BASED:	


[illegible]

Range	Comment	Origin	Type	Signal-/TAG-No.	File	Function	File	Type	Signal-/TAG-No.	Destination	Comment	Range
					1							51
					2							52
	Motor logic HS14200 Automatic		1		3							53
	at "automatic"				4							54
	CW pump P14100 on Check back signal		1	EH 14100	5							55
					6							56
					7							57
					8							58
					9							59
					10							60
					11							61
	Reset trip chill tower	Software button OS	1	HS 14200_RES	12							62
					13							63
					14							64
					15							65
					16				HS 14200_CB_RT	to page no. 18/20	Alarm fail P14200	66
					17							67
					18							68
					19				HS 14200	Signal to MCC	CW pump P14200 on	69
					20							70
					21							71
					22							72
	Level chill tower	Value < Min	1	LL 14003	23							73
					24							74
					25							75
	Discharge MAC	Value < Min	1	PL 11041	26							76
					27							77
					28							78
					29							79
	CW pump P14100 on Check back signal		1	EH 14200	30							80
					31							81
					32							82
					33				HS 14200_CB	Alarm OS	"Check back error"	83
					34							84
					35							85
					36							86
					37				HS 14200_RT	Alarm OS	"Running time error"	87
					38							88
					39							89
	Trip chill tower	from page no. 18/68	1	US 14000	40							90
					41							91
					42							92
					43							93
					44							94
					45							95
					46							96
					47							97
					48							98
<div> <div>PROJECT NAME</div> <div>ASU KOSICE</div> <div>PLANT PART</div> <div>CHILL TOWER</div> </div> <div> <div>DRAWING NAME:</div> <div>CHILL TOWER</div> <div>COOLING WATER PUMP P14200</div> <div>HS 14200</div> </div> <div> <div>AIR LIQUIDE</div> <div>Air Liquide ACS GmbH</div> <div>Füllingsweg 34</div> <div>47805 Krefeld</div> </div> <div> <div>DATE</div> <div>17.06.2005</div> <div>AUTHOR</div> <div>Frohn</div> <div>CHECK</div> <div>Eichler</div> <div>STD.</div> <div>Page no. 020</div> <div>Of</div> <div>230 Pages</div> <div>BASED:</div> </div>												
<div> <div>SIZE</div> <div>A3</div> <div>FUNKTION DIAGRAM</div> <div>DRWG. NO.</div> <div>K70101_020.dwg</div> <div>PROJ. NO.</div> <div>K70101</div> <div>REPLACES:</div> <div>REPLACED BY:</div> </div>												

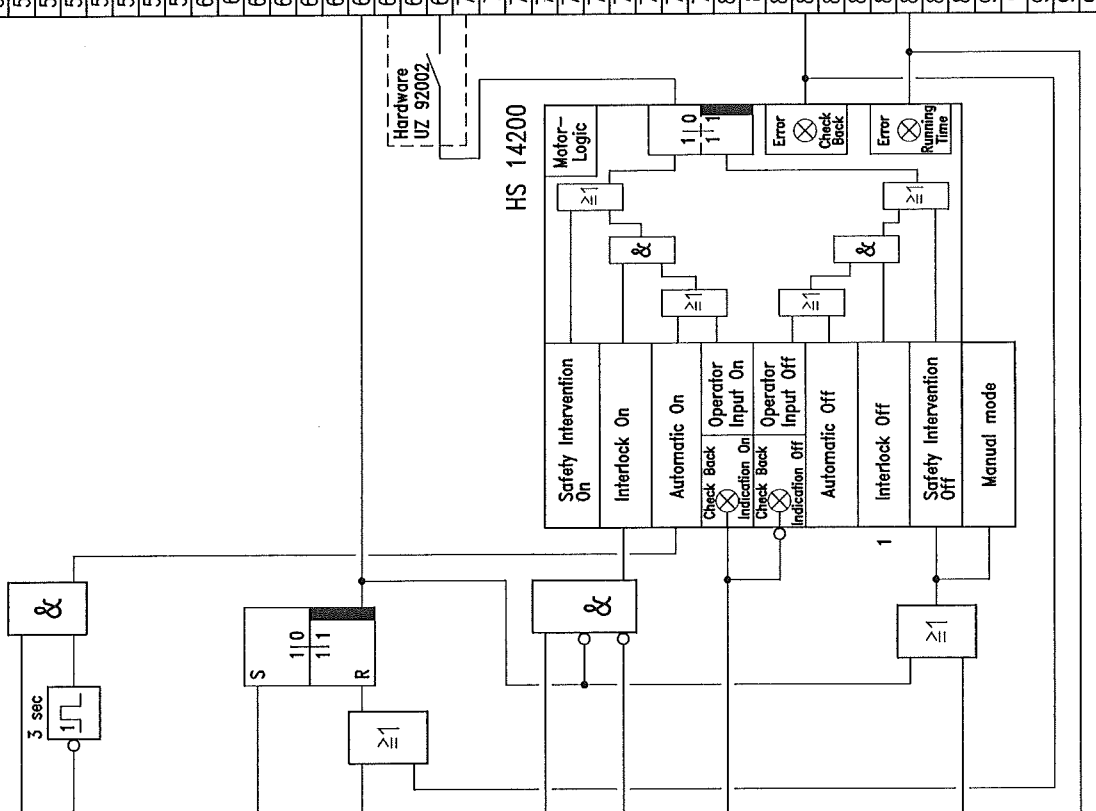

[illegible]

# Function

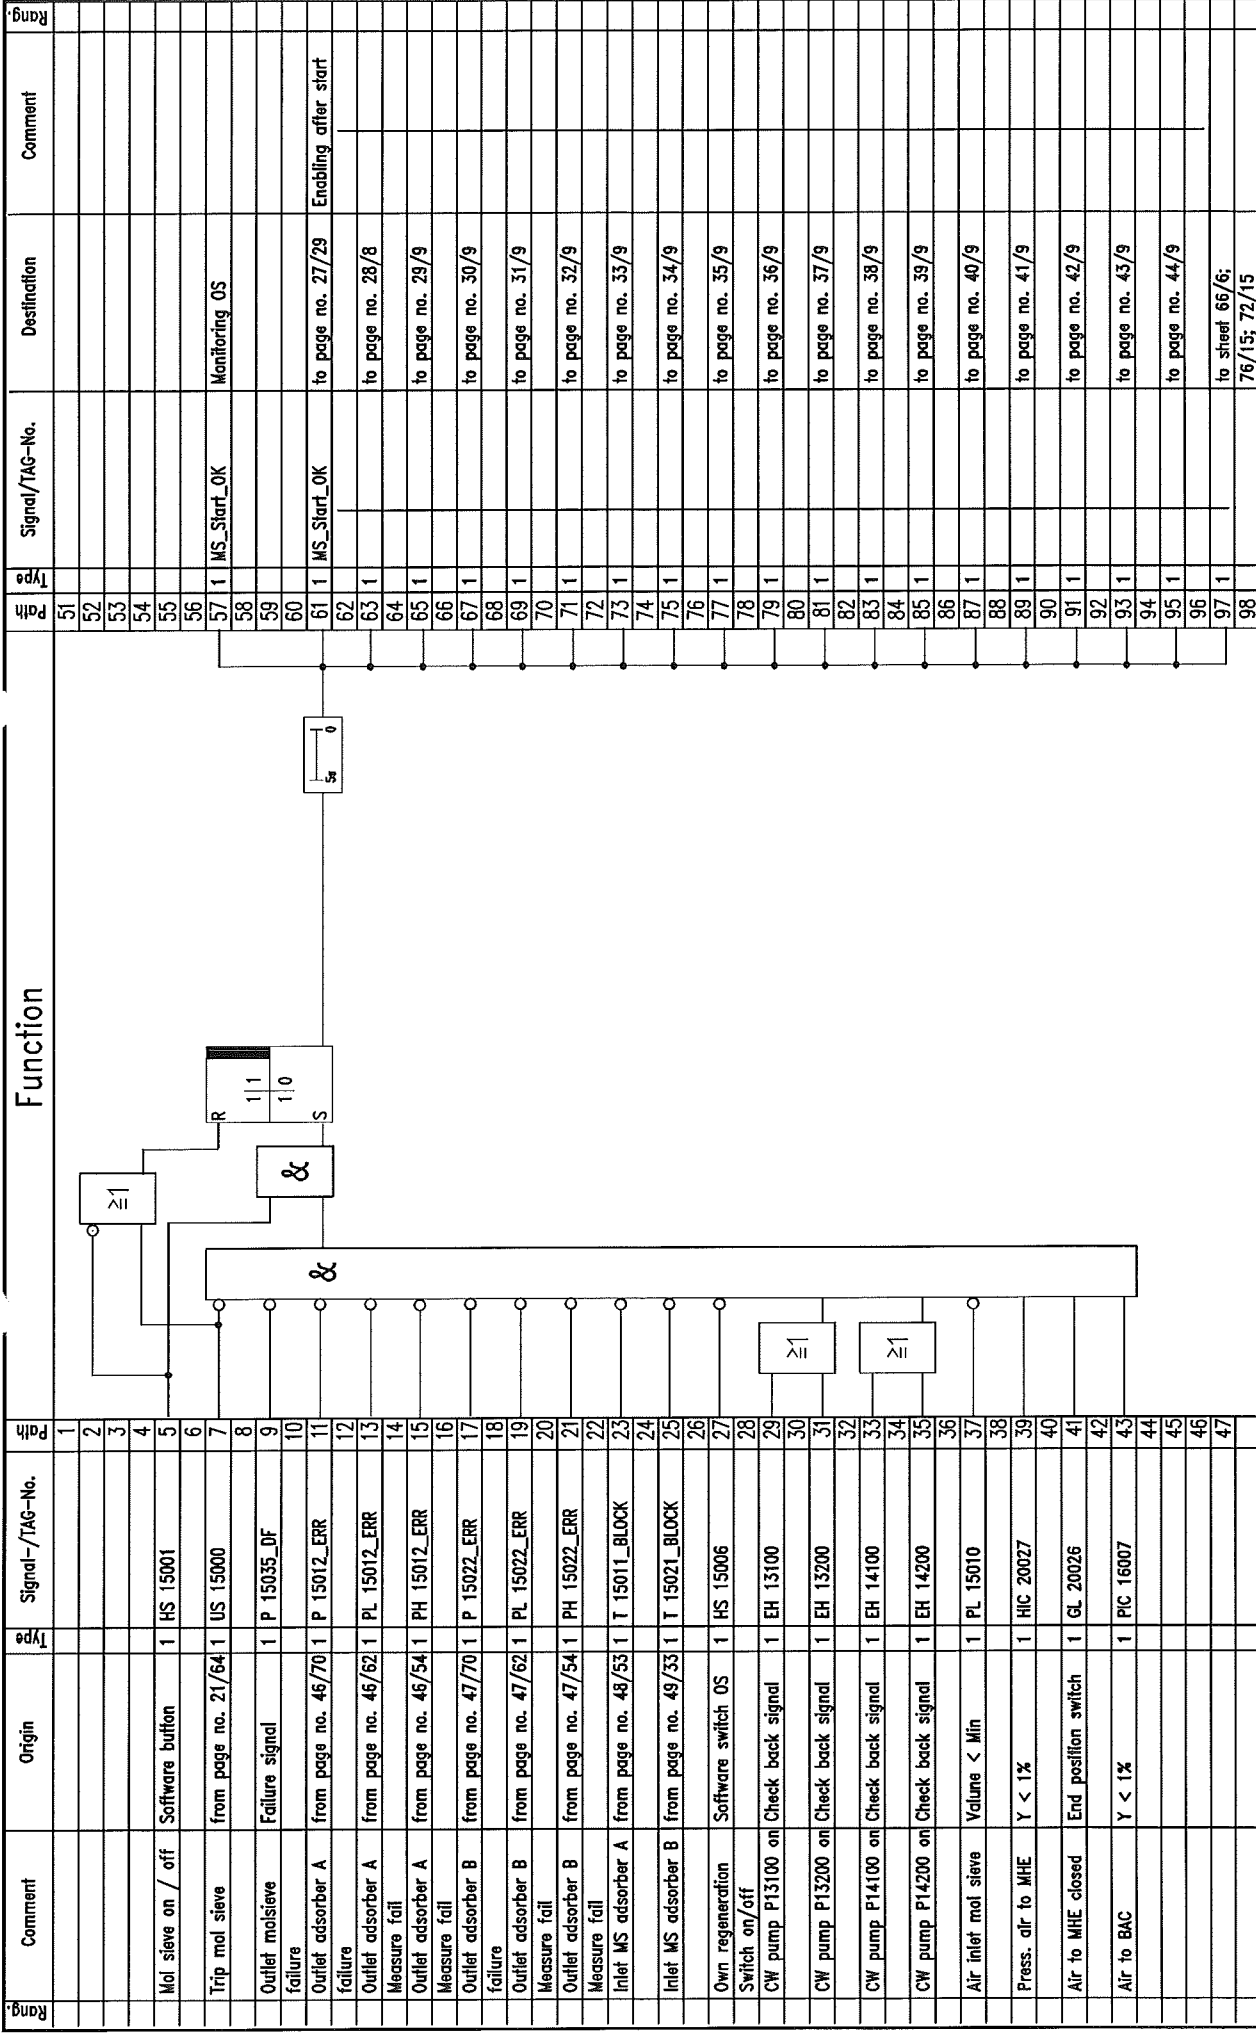

Rang.	Comment	Origin	Signal-/TAG-No.	Y	Y	Signal-/TAG-No.	Destination	Comment	Rang.
1									51
2									52
3									53
4									54
5	Mol sieve on / off	Software button	1 HS 15001						55
6	Trip mol sieve	from page no. 21/64	1 US 15000						56
7	Outlet mol sieve failure	Failure signal	1 P 15035_DF						57
8	Outlet adsorber A failure	from page no. 46/70	1 P 15012_ERR						58
9	Outlet adsorber A failure	from page no. 46/62	1 PL 15012_ERR						59
10	Measure fail	from page no. 46/54	1 PH 15012_ERR						60
11	Outlet adsorber A failure	from page no. 47/70	1 P 15022_ERR						61
12	Outlet adsorber B failure	from page no. 47/62	1 PL 15022_ERR						62
13	Measure fail	from page no. 47/54	1 PH 15022_ERR						63
14	Measure fail	from page no. 48/53	1 T 15011_BLOCK						64
15	Inlet MS adsorber B failure	from page no. 49/33	1 T 15021_BLOCK						65
16	Own regeneration Switch on/off	Software switch OS	1 HS 15006						66
17	CW pump P13100 on	Check back signal	1 EH 13100						67
18	CW pump P13200 on	Check back signal	1 EH 13200						68
19	CW pump P14100 on	Check back signal	1 EH 14100						69
20	CW pump P14200 on	Check back signal	1 EH 14200						70
21	Air inlet mol sieve	Value < Min	1 PL 15010						71
22	Press. air to MHE	Y < 1%	1 HIC 20027						72
23	Air to MHE closed	End position switch	1 GL 20026						73
24	Air to BAC	Y < 1%	1 PIC 16007						74
25									75
26									76
27									77
28									78
29									79
30									80
31									81
32									82
33									83
34									84
35									85
36									86
37									87
38									88
39									89
40									90
41									91
42									92
43									93
44									94
45									95
46									96
47									97
									98

																																																																																																																																																																																																																																																																																																																																																																																																																																																																																																																																																																																																																																																																																																																																																																																																																																																																																																																																																																																																																																																																																																																																																																																																																																																																																																																																																																																																																					</
--	--	----

Rang.	Comment	Origin	Type	Signal-/TAG-No.	Function	Rang.	Type	Signal-/TAG-No.	Destination	Comment
1					00 Start	51				
2						52				
3						53				
4						54				
5						55				
6					01 Depressurisation adsorber A+B	56				
7						57				
8						58				
9						59				
10						60				
11					1 Parallel operation adsorber A+B	61				
12						62				
13						63				
14						64				
15					2 Preparation depressurisation ads. B	65				
16						66				
17						67				
18						68				
19						69				
20					3 Depressurisation adsorber B	70				
21						71				
22						72				
23					4 Preparation heating adsorber B	73				
24						74				
25						75				
26						76				
27					5 Heating_B	77				
28						78				
29						79				
30						80				
31					6 Cooling_B	81				
32						82				
33						83				
34						84				
35					7 Preparation pressurisation B	85				
36						86				
37						87				
38						88				
39					8 Press. B	89				
40						90				
41						91				
42						92				
43						93				
44					9 Ready_B	94				
45						95				
46						96				
47						97				
48						98				

**ASU KOSICE**

Rev3 08.6.07 "as built"  
Rev2 02.2.08  
Rev1 01.1.08

Job No. FILE NO. REV. DATE

**PLANT PART**

Slipchart  
Frohn  
Frohn  
Eichler

BY

**MOL SIEVE STATION**

Rev3 08.6.07 "as built"  
Rev2 02.2.08  
Rev1 01.1.08

Job No. FILE NO. REV. DATE

**PROJECT NAME**

ASU KOSICE

**DRAWING NAME:**

MOL SIEVE STATION

ALL STEPS OF THE MOLECULAR SIEVE SEQUENCE CONTROL

**DATE** 17.06.2005

**AUTHOR** Frohn

**CHECK** Eichler

**STD.**

**Page no.** 023

**DF** 230 Pages

**BASED:**

**SIZE** A3

**DRWG. NO.**

**PROJ. NO.**

**REPLACES:**

**FUNKTION DIAGRAM**

K70101\_023.dwg

K70101

REPLACED BY:

**DATE** 17.06.2005

**AUTHOR** Frohn

**CHECK** Eichler

**STD.**

**Page no.** 023

**DF** 230 Pages

**BASED:**

Step		00	01	1	2	3	4	5	6	7	8	9	10	11	12	13	14	15	16	17	18
Actor																					
Depressure adsorber A	UK15013		X												X	(X)	(X)	(X)	X		
Depressure adsorber B	UK15023		X			X	(X)	(X)	(X)	X											
Inlet adsorber A	UK15011			X	X	X	X	X	X	X	X	X	X								
Outlet adsorber A	UK15016			X	X	X	X	X	X	X	X	X	X								X
Inlet adsorber B	UK15021			X									X	X	X	X	X	X	X	X	X
Outlet adsorber B	UK15026			X								X	X	X	X	X	X	X	X	X	X
Outlet reg. gas ads. A	UK15012															X	X	X	X		
Inlet reg gas ads. A	UK15014															X	X	X	X		
Outlet reg gas. ads. B	UK15022						X	X	X	X											
Inlet reg. gas ads. B	UK15024						X	X	X	X											
Bypass ads. A+B	UK15017										X	X								X	X
Inlet ads. A bypass	UK15018			X	X	X	X	X	X	X	X	X	X								
Inlet ads. B bypass	UK15028			X									X	X	X	X	X	X	X	X	X
Outlet condensate heat.	TCV15043							X									X				
Inlet reg. gas heater	UK15044							X									X				
Bypass regener. gas	UK15045								X									X			
X for 4min																					
PROJECT NAME		ASU KOSICE				AIR LIQUIDE		DRAWING NAME: MOL SIEVE STATION CONTROL DIAGRAM X = OPEN / RELEASE CONTROL				SIZE	A3	FUNKTION DIAGRAM				DATE	17.06.2005		
PLANT		MOL SIEVE STATION				Air Liquide AGS GmbH Füllingsweg 34 47805 Krefeld		K70101_024.dwg				DRWG. NO.						AUTHOR	From		
Rev3 08.6.07 as built												PROJ. NO.						CHECK	Echter		
Rev2 02.2.06												REPLACES						STD.			
Rev1 02.2.06												REPLACED BY						Page no.	024		
NO FILE																		OF	230 Pages		
NO REV DATE																		BASED			
BY CHKD.																					

Rang.	Comment	Origin	Signal-/TAG-No.	Pa	Function	Pa	Type	Signal-/TAG-No.	Destination	Comment	Rang.
				1	<div style="text-align: center;"> <div>Step 00</div> <div>Start</div> <div>NS Waiting time = 5min 1</div> <div>3s</div> <div>1 YES 0</div> </div>	51					
				2		52					
				3		53					
				4		54					
				5		55					
				6		56					
				7		57					
				8		58					
				9		59					
				10		60					
				11		61					
				12		62					
				13		63	1	Waitingtime_101	to page no. 26/9	Waiting time initial position	
				14		64					
				15		65					
				16		66					
				17		67	1	KC15001_INIT	to page no. 26/7	Delay initstep 1	
				18		68					
				19		69					
				20		70					
				21		71					
				22		72					
				23		73					
				24		74					
				25		75					
				26		76					
				27		77					
				28		78					
				29		79					
				30		80					
				31		81					
				32		82					
				33		83					
				34		84					
				35		85					
				36		86					
				37		87					
				38		88					
				39		89					
				40		90	1	Initial position	to page no. 26/2	New start sequence	
				41		91					
				42		92	1	Initial position	to page no. 45/3	New start sequence	
				43		93					
				44		94					
				45		95					
				46		96					
				47		97					
				48		98					

PROJECT NAME		ASU KOSICE		DRAWING NAME: MOL SIEVE STATION		SIZE A3		FUNKTION DIAGRAM		DATE 17.06.2005	
PLANT PART		MOL SIEVE STATION		AIR LIQUIDE		DRWG. NO.		K70101_025.dwg		AUTHOR From	
Rev3 08.6.07 as built				Air Liquide AGS GmbH		PROJ. NO.		K70101		CHECK Eicher	
Rev2 02.2.06				Füttingweg 34		REPLACES		REPLACED BY		Page no. 025	
Rev1 02.2.06				47805 Krefeld		REPLACES		REPLACED BY		Of 230 Pages	
JOB NO. FILE NO. REV. DATE REVISIONS BY CHKD.										BASED	



Rang.	Comment	Origin	Type	Signal-/TAG-No.	Function	Time	Range
	New start sequence	from page no. 25/90	1	initial position		1	
						2	
						3	
						4	
						5	
						6	
	Delay initstep 1	from page no. 25/67	1	KC15001_INIT		7	
						8	
	Time over	from page no. 25/63	1	Waitingtime_I01		9	
						10	
	Stop sequence	Software push button	1	HS 15002		11	
						12	
						13	
						14	
	Next step (Step+1)	Software push button	1	HS 15003		15	
						16	
	Step without cond.	Hand control	1	HS 15005		17	
						18	
	Switch time valves	from page no. 45/75	1	MS_switch_time		19	
						20	
						21	
						22	
**Step 01**


Depressurisation adsorber A+B

NS	US 15013	1
NS	US 15023	2
T	Waiting time = 10 min	3
T	Min wait. time = 10 min	4
T	Monitoring = 15 min	5

DATE	17.06.2005
AUTHOR	Frohn
CHECK	Eichler
STD.	
Page no.	026
Df	230 Pages
BASED:	

[illegible]


Function										Range
Range	Comment	Origin	Type	Signal-/TAG-No.	Pin	Pin	Type	Signal-/TAG-No.	Destination	Comment
	Depress AB	from page no. 26/97	1	Step01	1	51				
					2	52				
					3	53				
					4	54				
	Time over	from page no. 26/80	1	Waitingtime01	5	55				
	Next step	Software push button	1	HS 15003	6	56				
					7	57				
	Time over	from page no. 26/82	1	Minwaitingtime01	8	58				
					9	59				
					10	60				
	Adsorber A	from page no. 46/93	1	PL 15012	11	61				
					12	62				
	Adsorber B	from page no. 47/93	1	PL 15022	13	63				
					14	64				
	Stop sequence	Software button	1	HS 15002	15	65				
					16	66				
	Next step	Software push button	1	HS 15003	17	67				
					18	68				
	Step without cond.	Hand control	1	HS 15005	19	69				
	Switch time valves	from page no. 45/76	1	MS_switch_time	20	70				
					21	71				
	Ready_A	from page no. 44/97	1	Step18	22	72				
					23	73				
					24	74				
	Time over	from page no. 44/90	1	Waitingtime18	25	75				
					26	76				
	Next step	Software push button	1	HS 15003	27	77				
					28	78	1	Step1_US15011	to page no. 53/10	Open butterfly valve
	Enabling after start	from page no. 22/61	1	MS_Start_Ok	29	79				UK 15011
	Adsorber A	from page no. 46/81	1	PH 15012	30	80	1	Step1_US15016	to page no. 57/20	Open butterfly valve
					31	81				UK 15016
	Stop sequence	Software button	1	HS 15002	32	82	1	Step1_US15021	to page no. 60/19	Open butterfly valve
					33	83				UK 15021
	Time over	from page no. 44/92	1	Minwaitingtime18	34	84	1	Step1_US15026	to page no. 63/20	Open butterfly valve
	Outlet air ads. A	from page no. 57/81	1	US 15016	35	85				UK 15026
	BTY 15016 open				36	86	1	Step1_US15018	to page no. 59/10	Open butterfly valve
					37	87				UK 15018
	Next step	Software push button	1	HS 15003	38	88	1	Step1_US15028	to page no. 65/10	Open butterfly valve
					39	89				UK 15028
	Step without conditions	Hand control	1	HS 15005	40	90	1	Waitingtime1	to page no. 28/5	Time over
					41	91				
	Switch time valves	from page no. 45/77	1	MS_switch_time	42	92	1	Minwaitingtime1	to page no. 28/12	Time over
					43	93				
					44	94	1	KC15001_TM1	Alarm	"Check time over"
					45	95				
					46	96				
					47	97	1	Step1	to page no. 28/2	Parallel_B
					48	98	1		to page no. 45/7	

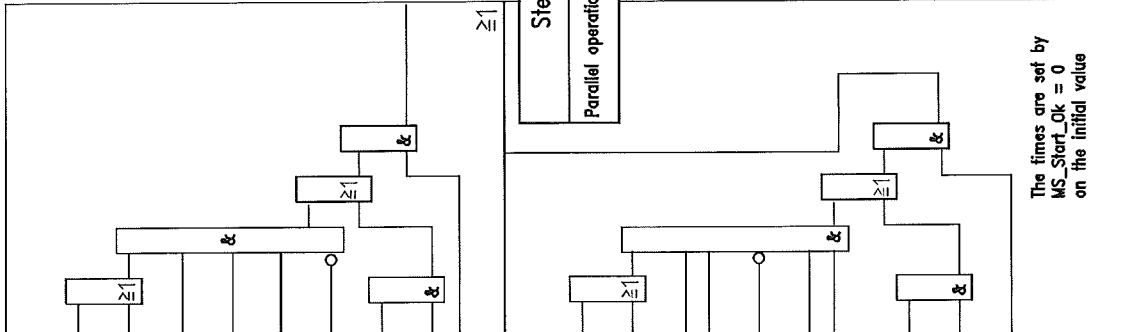

PROJECT NAME		DRAWING NAME		SIZE		FUNCTION DIAGRAM		DATE	
ASU KOSICE		MOL SIEVE STATION		A3		K70101_027.dwg		17.06.2005	
MOL SIEVE STATION		PARALLEL OPERATION ADSORBER A & B		DRWG. NO.		K70101_027.dwg		AUTHOR	
MOL SIEVE STATION		PARALLEL OPERATION ADSORBER A & B		PROJ. NO.		K70101		CHECK	
MOL SIEVE STATION		PARALLEL OPERATION ADSORBER A & B		REPLACES		REPLACED BY		STD.	
MOL SIEVE STATION		PARALLEL OPERATION ADSORBER A & B		Page no.		230		Page no.	
MOL SIEVE STATION		PARALLEL OPERATION ADSORBER A & B		Page no.		230		Page no.	

The times are set by  
MS\_Start\_Ok = 0  
on the initial value

Range	Comment	Origin	Type	Signal-/TAG-No.	Function	Path	Type	Signal-/TAG-No.	Destination	Comment	Range
	PrepDepress_B	from page no. 28/97	1	Step2		51					
						52					
						53					
						54					
	Time over	from page no. 28/86	1	Waitingtime2		55					
						56					
	Next step	Software push button	1	HS 15003		57					
						58					
	Enabling after start	from page no. 22/65	1	MS_Start_Ok		59					
						60					
						61					
						62					
	Stop sequence	Software button	1	HS 15002		63					
						64					
	Time over	from page no. 28/88	1	Minwaitingtime2		65					
						66					
						67					
	Next step	Software push button	1	HS 15003		68					
						69					
	Step without conditions	Hand control	1	HS 15005		70					
	Switch time valves	from page no. 45/79	1	MS_switch_time		71					
						72					
						73					
						74					
						75					
						76					
						77					
						78	1	Step3_US15023	to page no. 63/12	Open butterfly valve UK 15023	
						79					
						80	1	Step3_US15011	to page no. 53/12	Open butterfly valve UK 15011	
						81					
						82	1	Step3_US15016	to page no. 57/22	Open butterfly valve UK 15016	
						83					
						84	1	Step3_US15018	to page no. 59/12	Open butterfly valve UK 15018	
						85					
						86	1	Waitingtime3	to page no. 30/5	Time over	
						87	1	Minwaitingtime3	to page no. 47/47	Time over	
						88	1	Minwaitingtime3	to page no. 30/15	Time over	
						89					
						90	1	KCI15001_TM3	Alarm	"Check time over"	
						91					
						92					
						93					
						94					
						95					
						96					
						97	1	Step3	to page no. 30/2	Depress_B	
						98	1		to page no. 45/11		

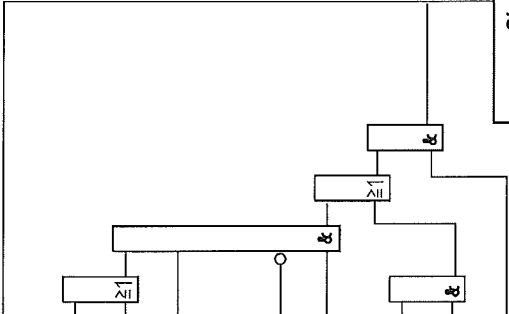

Step 3  
Depressurisation adsorber B

NS	US 15023	1
NS	US 15011	2
NS	US 15016	3
NS	US 15018	4
T	Waitingtime = 10 min	5
T	Minwaitingtime = 2 min	6
T	Monitoring = 15 min	7

The times are set by  
MS\_Start\_Ok = 0  
on the initial value

																																																																																																																																																																																																																																																																																																																																																																																																																																																																																																																																																																																																																																																																																																																																																																																																																																																																																																																																																																																																																																																																																																																																																																																																																																																																																																																																																																																																																					</
--	--	----

Function										Page	Signal/TAG-No.	Destination	Comment	Range
										51				
	Depress_B	from page no. 29/97	1	Step3						52				
			2							53				
			3							54				
	Time over	from page no. 29/86	1	Waitingtime3						55				
			4							56				
	Next step	Software push button	1	HS 15003						57				
			6							58				
	Endling after start	from page no. 22/67	1	MS_Start_Ok						59				
			9							60				
	Adsorber B	from page no. 47/92	1	PL 15022						61				
			11							62				
	Stop sequence	Software button	1	HS 15002						63				
			13							64				
	Time over	from page no. 29/88	1	Minwaitingtime3						65				
			15							66				
			16							67				
	Next step	Software push button	1	HS 15003						68				
			18							69				
	Step without conditions	Hand control	1	HS 15005						70				
			20							71				
	Switch time valves	from page no. 45/80	1	MS_switch_time						72				
			22							73				
			23							74				
			24							75				
			25							76				
			26							77				
			27							78				
			28							79				
			29							80	1 Step4_US15023	to page no. 62/13	Open butterfly valve	
			30							81			UK 15023	
			31							82	1 Step4_US15011	to page no. 53/13	Open butterfly valve	
			32							83			UK 15011	
			33							84	1 Step4_US15016	to page no. 57/23	Open butterfly valve	
			34							85			UK 15016	
			35							86	1 Step4_US15022	to page no. 61/10	Open butterfly valve	
			36							87			UK 15022	
			37							88	1 Step4_US15024	to page no. 63/11	Open butterfly valve	
			38							89			UK 15024	
			39							90	1 Step4_US15018	to page no. 59/13	Open butterfly valve	
			40							91			UK 15018	
			41							92	1 Waitingtime4	to page no. 31/5	Time over	
			42							93				
			43							94	1 Minwaitingtime4	to page no. 31/15	Time over	
			44							95				
			45							96	1 KC15001_TM4	Alarm	"Check time over"	
			46							97		to page no. 45/13		
			47							98	1 Step4	to page no. 31/2	Preheat_B	
			48											

Step 4

Preparation heating adsorber B

The times are set by MS\_Start\_Ok = 0 on the initial value

NS	US 15023	1
NS	US 15011	2
NS	US 15016	3
NS	US 15022	4
NS	US 15024	5
NS	US 15018	6
T	Waiting time = 125 sec	7
T	Minwaitingtime = 10 sec	8
T	Monitoring = 135 sec	9

DRAWING NAME:

MOL SIEVE STATION

PREPARATION HEATING ADSORBER B



Air Liquide AGS GmbH  
Fühlingweg 34  
47805 Krefeld

ASU KOSICE

MOL SIEVE STATION

PROJECT

NAME

PLANT

PART

Staploch

Echler

Frohn

Frohn

Rev3 08.6.07

as built

Rev2 02.2.08

DATE

NO FILE

REV

DATE

BY

CHKD.

REPLACES

K70101

OF 230 Pages

DATE 17.06.2005

AUTHOR Frohn

CHECK Echler


STD.

Page no. 030

BASED

# Function


Range	Comment	Origin	Signal-/TAG-No.	Step	Step	Signal-/TAG-No.	Destination	Comment	Range
1	Preheating_B	from page no. 30/98	1 Step4	51					
2				52					
3				53					
4				54					
5	Time over	from page no. 30/92	1 Waitingtime4	55					
6				56					
7	Next step	Software push button	1 HS 15003	57					
8				58					
9	Enabling after start	from page no. 22/69	1 MS_Start_Ok	59					
10				60					
11	Adsorber B	from page no. 47/91	1 PL 15022	61					
12				62					
13	Stop sequence	Software button	1 HS 15002	63					
14				64					
15	Time over	from page no. 30/94	1 Minwaitingtime04	65					
16				66					
17				67					
18	Next step	Software push button	1 HS 15003	68					
19				69					
20	Step without conditions	Hand control	1 HS 15005	70					
21				71					
22	Switch time valves	from page no. 45/81	1 MS_switch_time	72	1	Step5_US15023	to page no. 62/14	Open butterfly valve	
23				73				UK 15023	
24				74	1	Step5_US15011	to page no. 53/14	Open butterfly valve	
25				75				UK 15011	
26				76	1	Step5_US15016	to page no. 57/24	Open butterfly valve	
27				77				UK 15016	
28				78	1	Step5_US15022	to page no. 61/11	Open butterfly valve	
29				79				UK 15022	
30				80	1	Step5_US15024	to page no. 63/12	Open butterfly valve	
31				81				UK 15024	
32				82	1	Step5_US15018	to page no. 59/14	Open butterfly valve	
33				83				UK 15018	
34				84	1	Step5_US15040	to page no. 66/18	Reg. gas header on	
35				85				Controller on Auto	
36				86	1	Step5_T15043	to page no. 75/38		
37				87				Open butterfly valve	
38				88	1	Step5_US15044	to page no. 76/11	UK 15044	
39				89				Own regeneration	
40				90	1	Step5_US15037	to page no. 77/10	PCV 15037	
41				91				Time over	
42				92	1	Waitingtime5	to page no. 32/5		
43				93	1		to page no. 49/16		
44				94	1	Minwaitingtime5	to page no. 32/15		
45				95					
46				96	1	KC15001_TM5	Alarm	"Check time over"	
47				97	1		to page no. 45/15; 49/30; 51/11; 52/12/73/29		
48				98	1	Step5	to page no. 32/2	Heating_B	

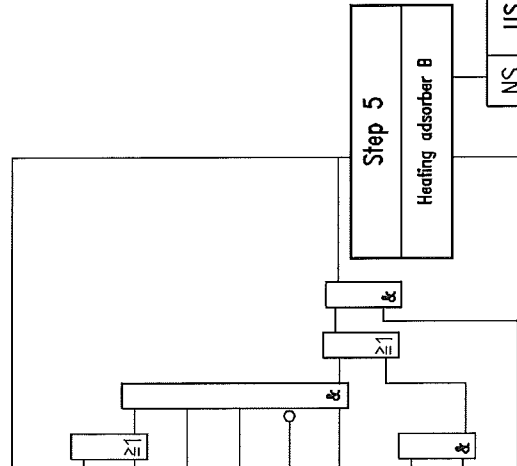

The times are set by MS\_Start\_Ok = 0 on the initial value

PROJECT NAME		DRAWING NAME		FUNCTION DIAGRAM	
ASU KOSICE		MOL SIEVE STATION		SIZE A3	
MOL SIEVE STATION		HEATING ADSORBER B		DATE 17.06.2005	
Rev3 08.6.07 "as built"		Air Liquide ACS GmbH		AUTHOR From	
Rev2 02.2.06		Füßingweg 34		CHECK Eichler	
Rev1 02.2.06		47805 Krefeld		STD.	
NO FILE NO (REV) DATE REVISIONS BY CHKD.		MOL SIEVE STATION		DRWG. NO.	
		MOL SIEVE STATION		PROJ. NO.	
				REPLACES:	
				K70101	
				Page no. 031	
				Of 230 Pages	
				BASED:	

Range	Comment	Origin	Type	Signal-/TAG-No.	Function	Type	Signal-/TAG-No.	Destination	Comment	Range
1	Heating_B	from page no. 31/98	1	Step5		51				
2						52				
3						53				
4	Time over	from page no. 31/92	1	Waitingtime5		54				
5						55				
6	Next step	Software push button	1	HS 15003		56				
7						57				
8	Enabling after start	from page no. 22/71	1	MS_Start_Ok		58				
9						59				
10	Adsorber B	from page no. 47/90	1	PL 15022		60				
11	Outlet reg. gas B	from page no. 49/62	1	TH 15021		61				
12	Stop sequence	Software button	1	HS 15002		62				
13						63				
14	Time over	from page no. 31/94	1	Minwaitingtime5		64				
15						65				
16						66				
17	Next step	Software push button	1	HS 15003		67				
18						68				
19	Step without conditions	Hand control	1	HS 15005		69				
20	Switch time valves	from page no. 45/82	1	MS_switch_time		70				
21						71				
22						72				
23						73				
24						74	1	Step6_US15045	to page no. 72/11	Open butterfly valve
25						75				UK 15045
26						76	1	Step6_US15023	to page no. 62/15	Open butterfly valve
27						77				UK 15023
28						78	1	Step6_US15011	to page no. 53/15	Open butterfly valve
29						79				UK 15011
30						80	1	Step6_US15016	to page no. 57/25	Open butterfly valve
31						81				UK 15016
32						82	1	Step6_US15022	to page no. 61/12	Open butterfly valve
33						83				UK 15022
34						84	1	Step6_US15024	to page no. 63/13	Open butterfly valve
35						85				UK 15024
36						86	1	Step6_US15018	to page no. 59/15	Open butterfly valve
37						87				UK 15018
38						88				
39						89				
40						90	1	Step6_US15037	to page no. 77/14	Own regeneration
41						91				PCV 15037
42						92	1	Waitingtime6	to page no. 33/5	Time over
43						93	1		to page no. 45/24	
44						94	1	Minwaitingtime6	to page no. 33/15	Time over
45						95				
46						96	1	KC15001_TM6	Alarm	"Check time over"
47						97	1		to sheet 45/17; 49/45; 69/27; 73/24	
48						98	1	Step6	to page no. 33/2	Cooling_B

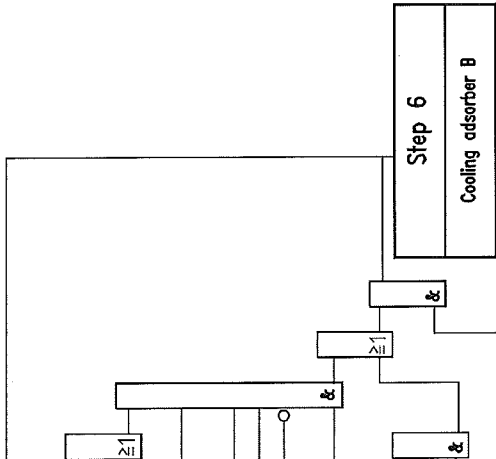

NS	US 15045	1
NS	US 15023	2
NS	US 15011	3
NS	US 15016	4
NS	US 15022	5
NS	US 15024	6
NS	US 15018	7
	Spare	
NS	US 15037	8
T	Waiting time = 210 min	9
T	Minwaitingtime = 180 min	10
T	Monitoring = 220 min	11

The times are set by  
MS\_Start\_Ok = 0  
on the initial value

PROJECT NAME	ASU KOSICE	DRAWING NAME	MOL SIEVE STATION	SIZE	A3	DATE	17.06.2005
PLANT						AUTHOR	Frohn
PART						CHECK	Eichler
Rev3 08.6.07 "as built"						STD.	
Rev2 02.2.06						DRWG. NO.	K70101_032.dwg
NO FILE NO						PRJ. NO.	K70101
DATE						REPLACES	REPLACED BY:
							BASED:

Range	Comment	Origin	Type	Signal-/TAG-No.	Page	Function	Page	Type	Signal-/TAG-No.	Destination	Comment	Range
51	Cooling_B	from page no. 32/98	1	Step6	1		51					
52			2		2		52					
53			3		3		53					
54			4		4		54					
55	Time over	from page no. 32/92	1	Waitingtime6	5		55					
56			6		6		56					
57	Next step	Software push button	1	HS 15003	7		57					
58	Enabling after start	from page no. 22/73	1	MS_Start_OK	8		58					
59			9		9		59					
60			10		10		60					
61	Outlet reg. gas B	from page no. 49/71	1	TL 15021	11		61					
62			12		12		62					
63	Stop sequence	Software button	1	HS 15002	13		63					
64			14		14		64					
65	Time over	from page no. 32/94	1	Minwaitingtime6	15		65					
66			16		16		66					
67			17		17		67					
68	Next step	Software push button	1	HS 15003	18		68					
69			19		19		69					
70	Step without conditions	Hand control	1	HS 15005	20		70					
71			21		21		71					
72	Switch time valves	from page no. 45/83	1	MS_switch_time	22		72					
73			23		23		73					
74			24		24		74					
75			25		25		75					
76			26		26		76					
77			27		27		77					
78			28		28		78	1	Step7_US15011	to page no. 53/16	Open butterfly valve UK 15011	
79			29		29		79					
80			30		30		80	1	Step7_US15016	to page no. 57/26	Open butterfly valve UK 15016	
81			31		31		81					
82			32		32		82	1	Step7_US15018	to page no. 59/16	Open butterfly valve UK 15018	
83			33		33		83					
84			34		34		84	1	Waitingtime7	to page no. 34/5	Time over	
85			35		35		85					
86			36		36		86	1	Minwaitingtime7	to page no. 34/15	Time over	
87			37		37		87					
88			38		38		88	1	KC15001_TW7	Alarm	"Check time over"	
89			39		39		89					
90			40		40		90					
91			41		41		91					
92			42		42		92					
93			43		43		93	1	Step7_US15022	to page no. 63/13	Open UK15022	
94			44		44		94	1	Step7_US15023	to page no. 64/16	Open UK15023	
95			45		45		95	1	Step7_US15024	to page no. 63/14	Open UK15024	
96			46		46		96	1		to page no. 47/4		
97			47		47		97	1	Step7	to page no. 34/2	PrePress_B	
98							98	1		to page no. 45/19		

Step 7  
Preparation pressurisation B

The times are set by  
MS\_Start\_Ok = 0  
on the initial value



DRAWING NAME:  
MOL SIEVE STATION  
PREPARATION PRESSURISATION  
ADSORBER B

AIR LIQUIDE  
Air Liquide AGS GmbH  
Füllingsweg 34  
47805 Krefeld

ASU KOSICE  
MOL SIEVE STATION

PROJECT NAME

PLANT PART

Rev3 08.6.07 "as built"  
Rev2 02.2.06  
Rev1 02.2.06

NO FILE NO REV DATE REVISIONS BY CHKD.

DATE 17.06.2005  
AUTHOR Frohn  
CHECK Eichler  
STD.  
Page no. 033  
Of 230 Pages  
BASED IN

SIZE A3  
FUNCTION DIAGRAM  
DRAWG. NO. K70101\_033.dwg  
PROJ. NO. K70101  
REPLACES: REPLACED BY:



Rang.	Comment	Origin	Type	Signal-/TAG-No.	Function	Time	Type	Signal-/TAG-No.	Destination	Comment	Rang.
	PrepPress_B	from page no. 33/97	1 Step7	2		1	51				
				3		2	52				
				4		3	53				
	Time over	from page no. 33/84	1 Waitingtime7	5		4	54				
	Next step	Software push button	1 HS 15003	6		5	55				
				7		6	56				
	Enabling after start	from page no. 22/75	1 MS_Start_Ok	8		7	57				
				9		8	58				
				10		9	59				
				11		10	60				
				12		11	61				
	Stop sequence	Software button	1 HS 15002	13		12	62				
				14		13	63				
	Time over	from page no. 33/86	1 Minwaitingtime7	15		14	64				
				16		15	65				
				17		16	66				
	Next step	Software push button	1 HS 15003	18		17	67				
				19		18	68				
	Step without conditions	Hand control	1 HS 15005	20		19	69				
	Switch time valves	from page no. 45/84	1 MS_switch_time	21		20	70				
				22		21	71				
				23		22	72				
				24		23	73				
				25		24	74				
				26		25	75				
				27		26	76				
				28		27	77				
				29		28	78	1 Step8_US15011	to page no. 53/17	Open butterfly valve UK 15011	
				30		29	79				
				31		30	80	1 Step8_US15016	to page no. 57/27	Open butterfly valve UK 15016	
				32		31	81				
				33		32	82	1 Step8_US15017	to page no. 58/11	Open butterfly valve UK 15017	
				34		33	83				
				35		34	84	1 Step8_US15018	to page no. 59/17	Open butterfly valve UK 15018	
				36		35	85				
				37		36	86	1 Waitingtime8	to page no. 35/5	Time over	
				38		37	87	1 Minwaitingtime8	to page no. 47/36	Time over	
				39		38	88		to page no. 35/15	Time over	
				40		39	89				
				41		40	90	1 KC15001_IM8	Alarm	"Check time over"	
				42		41	91				
				43		42	92				
				44		43	93				
				45		44	94				
				46		45	95				
				47		46	96				
				48		47	97	1 Step8	to page no. 35/2	Press_B	
							98	1	to page no. 45/21;	79/5	

**Step 8**

Pressurisation adsorber B

The times are set by  
MS\_Start\_Ok = 0  
on the initial value

DRAWING NAME:

MOL SIEVE STATION

PRESSURISATION ADSORBER B

AIR LIQUIDE

Air Liquide AGS GmbH  
Föhlingweg 34  
47805 Krefeld

PROJECT NAME

ASU KOSICE

PLANT PART

MOL SIEVE STATION

DATE

17.06.2005

AUTHOR Frohn

CHECK Eichler

STD.

Page no. 034

Of 230 Pages

BASED:

REPLACES BY:

SIZE A3

FUNKTION DIAGRAM

DRWG. NO.

K70101\_034.dwg

PROJ. NO.

K70101

DATE

17.06.2005

AUTHOR Frohn

CHECK Eichler

STD.

Page no. 034

Of 230 Pages</

Rank	Comment	Origin	Type	Signal-/TAG-No.	Function	Type	Signal-/TAG-No.	Destination	Comment	Rank
			1			51				
	Press_B	from page no. 34/97	1	Step8		52				
			2			53				
			3			54				
	Time over	from page no. 34/86	1	Waitingtime8		55				
			4			56				
			5			57				
	Next step	Software push button	1	HS 15003		58				
			6			59				
	Enabling after start	from page no. 22/77	1	MS_Start_Ok		60				
			7			61				
	Adsorber B	from page no. 47/79	1	PH 15022		62				
			8			63				
	Stop sequence	Software button	1	HS 15002		64				
			9			65				
	Time over	from page no. 34/88	1	Minwaitingtime8		66				
			10			67				
			11			68				
	Next step	Software push button	1	HS 15003		69				
			12			70				
	Step without conditions	Hand control	1	HS 15005		71				
			13			72				
	Switch time valves	from page no. 45/85	1	MS_switch_time		73				
			14			74				
			15			75				
			16			76				
			17			77				
			18			78				
			19			79				
			20			80	1	Step9_US15011	to page no. 53/18	Open butterfly valve UK 15011
			21			81				
			22			82	1	Step9_US15016	to page no. 57/28	Open butterfly valve UK 15016
			23			83				
			24			84	1	Step9_US15026	to page no. 64/21	Open butterfly valve UK 15026
			25			85				
			26			86	1	Step9_US15017	to page no. 58/12	Open butterfly valve UK 15017
			27			87				
			28			88	1	Step9_US15018	to page no. 59/18	Open butterfly valve UK 15018
			29			89				
			30			90	1	Waitingtime9	to page no. 36/5	Time over
			31			91				
			32			92	1	Minwaitingtime9	to page no. 36/15	Time over
			33			93				
			34			94	1	KC 15001_TM9	Alarm	"Check time over"
			35			95				
			36			96				
			37			97	1	Step9	to page no. 36/2	Ready_B
			38			98	1		to Page no. 45/23	

**Step 9**

Ready adsorber B

The times are set by  
MS\_Start\_Ok = 0  
on the initial value

**PROJECT NAME**

ASU KOSICE

**PLANT**

MOL SIEVE STATION

**DRAWING NAME:**

MOL SIEVE STATION

READY ADSORBER B

**DATE** 17.06.2005

**AUTHOR** From

**CHECK** Eichler

**STD.**

**Page no.** 035

**DF** 230 Pages

**BASED:**

**SIZE** A3

**FUNKTION DIAGRAM**

**DRWG. NO.** K70101\_035.dwg

**PROJ. NO.** K70101

**REPLACES:**

Rank.	Comment	Origin	Type	Signal-/TAG-No.	Signal-/TAG-No.	Destination	Comment	Rank.
	Ready_B	from page no. 35/97	1	Step9				
			2					
			3					
	Time over	from page no. 35/90	4	Waitingtime9				
			5					
	Next step	Software push button	6	HS 15003				
			7					
	Enabling after start	from page no. 22/79	8	MS_Start_Ok				
			9					
	Adsorber B	from page no. 47/78	10	PH 15022				
			11					
	Stop sequence	Software button	12	HS 15002				
			13					
	Time over	from page no. 35/92	14	Minwaitingtime9				
			15					
	Outlet air ads. B	from page no. 64/81	16	GH 15026				
	BTV 15026 open		17					
	Next step	Software push button	18	HS 15003				
			19					
	Step without conditions	Hand control	20	HS 15005				
			21					
	Switch time valves	from sheet 47/86	22	MS_switch_time				
			23					
			24					
			25					
Rang.	Comment	Origin	Type	Signal-/TAG-No.	Function	Type	Signal-/TAG-No.	Destination	Comment	Rang.
1	PrepDepress_A	from page no. 37/97	1	Step11		51				1
2			2			52				2
3			3			53				3
4			4			54				4
5	Time over	from page no. 37/86	5	Waitingtime11		55				5
6			6			56				6
7	Next step	Software push button	7	HS 15003		57				7
8			8			58				8
9	Enabling after start	from page no. 22/83	9	MS_Start_Ok		59				9
10			10			60				10
11			11			61				11
12			12			62				12
13	Stop sequence	Software button	13	HS 15002		63				13
14			14			64				14
15	Time over	from page no. 37/88	15	Minwaitingtime11		65				15
16			16			66				16
17			17			67				17
18	Next step	Software push button	18	HS 15003		68				18
19			19			69				19
20	Stop without conditions	Hand control	20	HS 15005		70				20
21			21			71				21
22	Switch time valves	from page no. 45/88	22	MS_switch_time		72				22
23			23			73				23
24			24			74				24
25			25			75				25
26			26			76				26
27			27			77				27
28			28			78	Step12_US15013	to page no. 55/12	Open butterfly valve BTV 15013	28
29			29			79				29
30			30			80	Step12_US15021	to page no. 60/12	Open butterfly valve BTV 15021	30
31			31			81				31
32			32			82	Step12_US15026	to page no. 64/24	Open butterfly valve BTV 15026	32
33			33			83				33
34			34			84	Step12_US15028	to page no. 65/13	Open butterfly valve BTV 15028	34
35			35			85				35
36			36			86	Waitingtime12	to page no. 39/5	Time over	36
37			37			87	Minwaitingtime12	to page no. 46/17	Time over	37
38			38			88		to page no. 39/15	Time over	38
39			39			89				39
40			40			90	KCI5001_TM12	Alarm	"Check time over"	40
41			41			91				41
42			42			92				42
43			43			93				43
44			44			94				44
45			45			95				45
46			46			96				46
47			47			97	Step12	to page no. 39/2	Depress_A	47
48			48			98		to page no. 45/29		48

**Step 12**

Depressurisation adsorber A

The times are set by  
MS\_Start\_Ok = 0  
on the initial value

**Function**

**Project Name**  
ASU KOSICE

**Plant Part**  
MOL SIEVE STATION

**Project Name**  
MOL SIEVE STATION

**Plant Part**  
DEPRESSURISATION ADSORBER A

**Project Name**  
ASU KOSICE

**Plant Part**  
MOL SIEVE STATION

**Project Name**  
MOL SIEVE STATION

**Plant Part**  
DEPRESSURISATION ADSORBER A

**Project Name**  
ASU KOSICE

**Plant Part**  
MOL SIEVE STATION

**Project Name**  
MOL SIEVE STATION

**Plant Part**  
DEPRESSURISATION ADSORBER A

**Project Name**  
ASU KOSICE

**Plant Part**  
MOL SIEVE STATION

**Project Name**  
MOL SIEVE STATION

**Plant Part**

Rang.	Comment	Origin	Type	Signal-/TAG-No.	Function
1					
2	Depress_A	from page no. 38/97	Step12		
3					
4					
5	Time over	from page no. 38/86	Waitingtime12		
6					
7	Next step	Software push button	HS 15003		
8					
9	Enabling after start	from page no. 22/85	MS_Start_Ok		
10					
11	Adsorber A	from page no. 46/92	PL 15012		
12					
13	Stop sequence	Software button	HS 15002		
14					
15	Time over	from page no. 38/88	Minwaitingtime12		
16					
17					
18	Next step	Software push button	HS 15003		
19					
20	Step without conditions	Hand control	HS 15005		
21					
22	Switch time valves	from page no. 45/89	MS_switch_time		
23					
24					
**Step 13**  
Preparation heating adsorber A

The times are set by  
MS\_Start\_Ok = 0  
on the initial value

The times are set by  
MS\_Start\_Ok = 0  
on the initial value