

[illegible]

Function				Signal-/TAG-No.	Destination	Comment
Comment	Origin	Type	Signal-/TAG-No.	Type	Signal-/TAG-No.	Destination
				51		
				52		
				53		
				54		
				55		
				56		
				57		
				58		
				59		
Main drive	from page no. 80/71 1 HS 16001			60 1 US16706_0	Signal to MCC	Motor heating on
Trip BAC	from page no. 82/73 1 US 16000			61		
				62		
				63		
				64		
				65		
				66		
				67		
				68		
				69		
Motor heating on	Check back signal	1 EH 16706		70 1 EO 16706	Monitoring OS	Motor heating on
				71		
				72		
				73		
			</			

Rang.	Comment	Origin	Type	Signal-/TAG-No.	Funktion	Pf.
						1
						2
						3
	Charge press. BAC	P-transmitter	E PT 16007			18
	Main drive BAC on	Check back signal	1 EH 16001			19
						20
						21
						22
						23
						24
						25
						26
						27
						28
	Trip BAC	from page no. 82/75	1 US 16000			29
						30
						31
						32
PIC 16007

PI - Controller

X Input signal
W ext. Setpoint
W ext. on
Y Start value
Y Start value switch on
Manual mode
Automatic mode
Slave mode

Control algorithm Y
Control deviation


fast controller

Rang.	Comment	Origin	Type	Signal-/TAG-No.	Funktion	Pf.
						51
						52
						53
DATE	17.06.2005
AUTHOR	From
CHECK	Eichler
STD.	
Page no.	092
Of	230
PAGES	
BASED	

SIZE	A3
SIGNAL / TAG-NO.	
DESTINATION	
FUNCTION DIAGRAM	
DRVG. NO.	K70101_092.dwg
PRDJ. NO.	K70101
REPLACES	REPLACES BY:

[illegible][illegible]

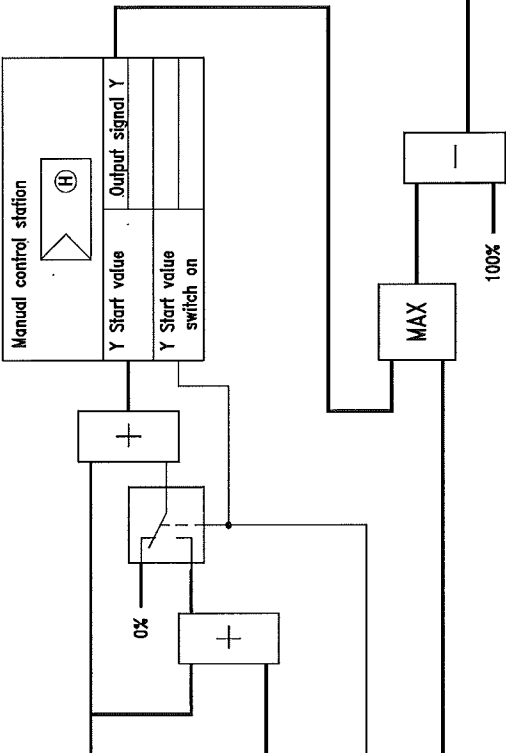Function												
Comment	Origin	Type	Signal-/TAG-No.	Page	Function				Page	Destination	Comment	
				1					51			
				2					52			
				3					53			
				4					54			
				5					55			
				6					56			
				7					57			
				8					58			
				9					59			
				10					60			
				11					61			
				12					62			
				13					63			
Output signal FIC16074	0...100%	E	F1 16074	14					64			
				15					65			
				16					66			
				17					67			
				18					68			
				19					69			
				20					70			
+ 10%	Factor 0,1	E		21					71			
				22					72			
				23					73			
				24					74			
Surge protection	from page no. 93/66 1	UH	16045	25					75			
				26					76			
				27					77			
Air discharge contr.	from page no. 97/88 E	P16045_2		28					78			
				29					79	E HIC16074	to AC-controller anti surge valve	
				30					80			
				31					81			
				32					82			
				33					83			
				34					84			
				35					85			
				36					86			
				37					87			
				38					88			
				39					89			
				40					90			
				41					91			
				42					92			
				43					93			
				44					94			
				45					95			
				46					96			
				47					97			
				48					98			
					HIC 16074							
												
					Manual control station							
					Y Start value							
					Y Start value switch on							
					Output signal Y							
					+							
					0%							
					+							
					MAX							
					100%							
					-							
					to AC-controller FIC 16074							
					Manual output signal anti surge valve							

Function				Signal-/TAG-No.	Destination	Comment
Comment	Origin	Type	Signal-/TAG-No.			
Partial Trip BAC	from page no. 84/76 1	US 16000_2	1			
			2			
			3			
Air discharge BAC	Analog value	E P 16045	4			
			5			
			6			
			7			
			8			
			9			
Charge press. BAC	Analog value	E P 16007	10			
			11			
			12			
			13			
Trip BAC	from page no. 82/65 1	US 16000	28			
			29			
			30			
			31			
			91	HIC 16071	Positioner 20...4mA	Control valve
			92		= 0-100%	HV16071
			93			Blow off valve BAC
			94			
			95			
			96			
			97			
			98			

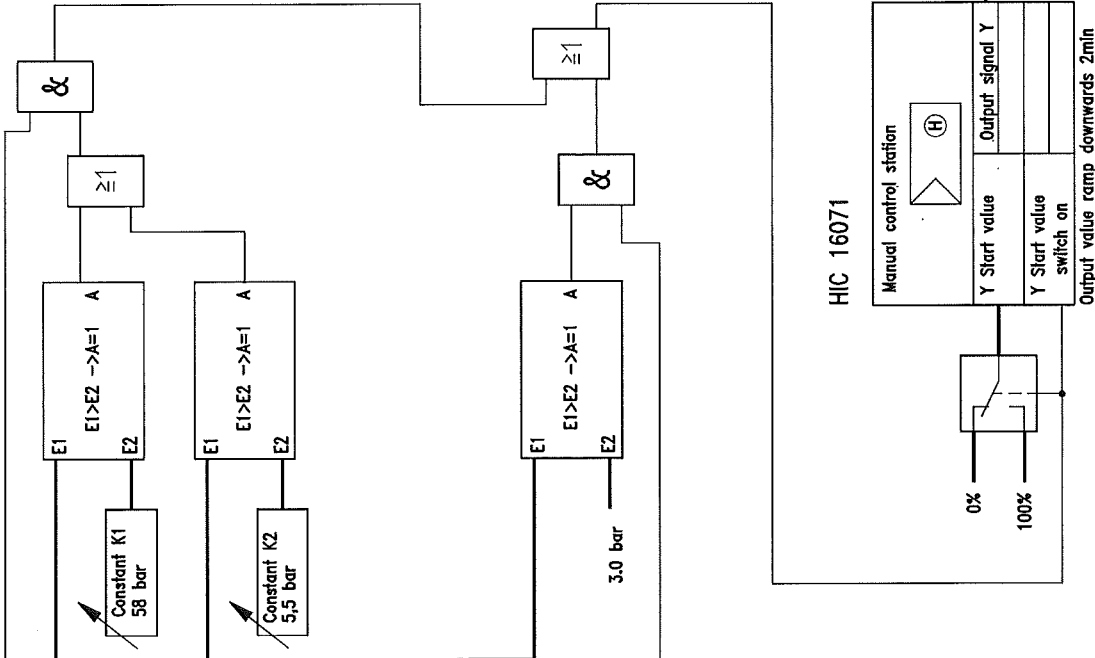


PROJECT				DRAWING NAME:				FUNCTION DIAGRAM				DATE 17.06.2005			
NAME				ASU KOSICE				BOOSTER AIR COMPRESSOR (BAC)				AUTHOR rohn			
PLANT				BOOSTER AIR COMPRESSOR				BLOW OFF VALVE HIC 16071				CHECK Echler			
PART				ASU KOSICE				K70101_095.dwg				STD.			
REVISIONS				Rev3 08.6.07 as built				K70101				Page no. 095			
BY				From Echler				REPLACES:				OF 230 Pages			
DATE				Rev2 07.22.06				REPLACED BY:				BASED:			


Function				Type	Signal-/TAG-No.	Destination	Comment
				51			
				52			
				53			
HK 16073 open	End position switch	1	GH 16073	54	1 GH 16073	OS	HK 16073 open
				55			
HK 16073 closed	End position switch	1	GL 16073	56			
				57	1 GL 16073	OS	HK 16073 closed
				58			
				59			
				75	E HK 16073	Positioner 4...20mA = 0-100%	Butterfly valve HK16073 Air from booster
				76			
				77			
				348	</		

Function				Signal-/TAG-No.	Destination	Comment
	1					
	2					
	3					
	4					
	5					
	6					
	7					
	8					
	9					
Air discharge BAC	10	E PT 16045				
	11					
	12					
	13					
	14					
	15					
	16					
Partial trip BAC	17	from page no. 84/70 1 US 16000_2_dyn				
	18					
	19	from page no. 82/77 1 US 16000				
	20					
	21					
Function				Signal-/TAG-No.	Destination	Comment
	51					
	52					
	53					
	54					
	55					
	56					
	57					
	58					
	59					
Air discharge BAC	60	E UY 16010			Positioner 0-100% = 4-20 mA	Guide vane 1.stage
	61					
	62					
	63					
	88	E P16045_2_OUT			to page 94/28	HIC 16074
	89					
	90					
	91					
	92					
	93					
	94					
	95					
	96					
	97					
	98					

PIC 16045_1

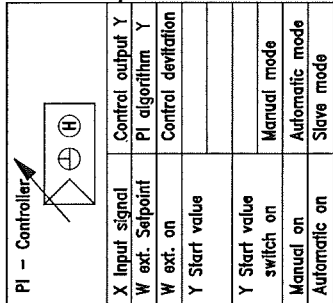

PIC 16045_2

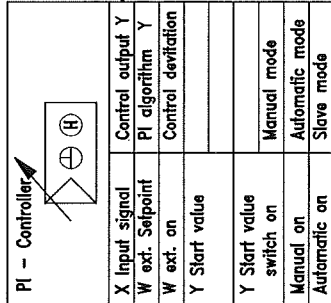

--	--	
[illegible]

[illegible]

Function

Range	Comment	Origin	Type	Signal-/TAG-No.	Signal-/TAG-No.	Destination	Comment	Range
1					51	UA 20000	Alarm OS	"Trip cold box"
2					52	US 20000	PIC 15041	UN2 to chiller
3					53	US 20000	Controller "Automatic"	WE = 500 mbar
4					54	US 20000	to page no. 66/4	Heating off reg. gas
5					55	US 20000	to page no. 125/4	US 15040
6	Reset trip cold box	Software button OS	1	HS 20000	56	US 20000	Trip expander turbine	US24100
7					57	US 20000	Trip expander turbine	US24200
8					58	US 20000	Trip LP-GAN	US20005
9					59	US 20000	Trip HP-GAN	US20001
10					60	US 20000	Trip GOX	US20011
11					61	US 20000_TRCO	GAN blow off FIC 20002	Contr. Manual/Y=0%
12					62	US 20000_TRCO	GOX blow off FIC 20012	Contr. Manual/Y=0%
13					63	US 20000_TRCO	LP GAN blow off FIC20006	Contr. Manual/Y=0%
14					64	US 20000	to page no. 75/33	TIIC15043
15					65	US 20000	to page no. 038/21	Close air to MHE
16					66	US 20000	to page no. 039/22	Pressurised. air to MHE
17					67	US 20000	Trip LOX to storage	US 22001
18					68	US 20000	Trip LIN to storage	US 23013
19					69	US 20000	Trip pure Argon column	US 43000
20					70	US 20000	PIC 40003 on "Auto"	Crude Ar blow off
21					71	US 20000	switch to HK40012	WE = 300 mbar
22					72	US 20000_dyn	to page no. 101/3	Trip cold box one shot
23					73	US 20000_dyn		
24					74	US 20000_dyn		
25					75	US 20000_dyn		
26					76	US 20000_dyn		
27					77	US 20000_dyn		
28					78	US 20000_dyn		
29					79	US 20000_dyn		
30					80	US 20000_dyn		
31					81	US 20000_dyn		
32					82	US 20000_dyn		
33					83	US 20000_dyn		
34					84	US 20000_dyn		
35					85	US 20000_dyn		
36					86	US 20000_dyn		
37					87	US 20000_dyn		
38					88	US 20000_dyn		
39					89	US 20000_dyn		
40					90	US 20000_dyn		
41					91	US 20000_dyn		
42					92	US 20000_dyn		
43					93	US 20000_dyn		
44					94	US 20000_dyn		
45					95	US 20000_dyn		
46					96	US 20000_dyn		
47					97	US 20000_dyn		
48					98	US 20000_dyn		

PROJECT NAME		DRAWING NAME		FUNKTION DIAGRAM		DATE 17.06.2005	
ASU KOSICE		COLD BOX		SIZE A3		AUTHOR Frohn	
COLD BOX		TRIP US 20000		DRWG. NO.		CHECK Echler	
COLD BOX		Air Liquide AGS GmbH Füllingsweg 34 47805 Krefeld		PROJ. NO.		STD.	
COLD BOX		Air Liquide AGS GmbH Füllingsweg 34 47805 Krefeld		REPLACES		Page no. 100 Of 230 Pages	
COLD BOX		Air Liquide AGS GmbH Füllingsweg 34 47805 Krefeld		REPLACES		BASED	

Function									
Comment	Origin	Type	Signal-/TAG-No.	Signal-/TAG-No.	Destination	Comment			
				51					
				52					
Trip cold box	from page no.100/96	1	US 20000_dyn	53	to page 73/35	FIC 15041			
one shot		4		54		Contr. manual/Y=0%			
		5		55	TIC 20008	Liquid air outlet MHE			
		6		56	Manual / Y=100%				
		7		57	FIC 23073	LIN product to dump			
		8		58	Manual / Y=0%				
		9		59	to page no.113/38	LOX product to dump			
		10		60	LIC 23076	Manual / Y=0%			
		11		61	LIC 21003	Level sump Hp-column			
		12		62	Manual Y=0%				
		13		63	HIC 21006	LIN reflux HP-column			
		14		64	Y = 0%				
		15		65	HIC 21014	LAIR to HP-column			
		16		66	Y = 0%				
		17		67	to page no.117/34	W/LIN to LP-column			
		18		68	FIC 22013	Manual / Y=0%			
		19		69	to page no. 118/41	Control GOX			
		20		70	Manual / Y=0%	GOX FIC 22043			
		21		71	HIC 73001 / Y=0%	LIN assist			
		22		72					
		23		73	LIC 21060	LAR			
		24		74	Manual / Y=0%				
		25		75	to page no.142/20	LAR-pump P40100			
		26		76	to page no.145/41	HS 40100			
		27		77	LIC 22002	LOX LGCC			
		28		78	Manual / Y=0%				
		29		79	to page no.151/14	LOX-pump P61100			
		30		80	to page no.155/43	HS 61110			
		31		81					
		32		82					
		33		83	to page no.158/14	LOX-pump P61200			
		34		84	to page no.162/43	HS 61210			
		35		85					
		36		86					
		37		87	to page no.165/14	LIN-pump P71100			
		38		88	to page no.169/43	HS 71100			
		39		89					
		40		90					
		41		91	to page no.172/14	LIN-pump P71200			
		42		92	to page no.176/43	HS 71200			
		43		93					
		44		94	to page no.004/15	Partial trip MAC			
		45		95	to page no.084/15	Partial trip BAC			
		46		96					
		47		97	to page no.102/3	Trip cold box one shot			
				98					
				FUNCTION DIAGRAM			DATE: 17.06.2005 AUTHOR:Frohm CHECK:Eichler STD:		
ASU KOSICE				SIZE A3	DRAWG. NO. K70101_101.dwg				
COLD BOX				PROJ. NO. K70101	Page no. 101 OF 230 Pages				
TRIP ONE SHOT US 20000_1				REPLACES:	REPLACED BY:				
PROJECT NAME: ASU KOSICE				DRAWING NAME: COLD BOX					
PLANT PART				AIR LIQUIDE					
Rev3 08.6.07 as built"				Air Liquide AGS GmbH					
Rev2 02.2.08				Füllingsweg 34					
DATE: REVISIONS BY CHKD.				47805 Krefeld					

Function

[illegible]

[illegible]

Range	Comment	Origin	Type	Signal-/TAG-No.	Pin	Function	Pin	Signal-/TAG-No.	Destination	Comment	Range
					1						51
					2						52
					3						53
					4						54
					5						55
	Reset trip GAN	Software button OS	1	HS 20001	6						56
					7						57
					8						58
					9						59
					10				Alarm OS	"Trip HP-GAN product"	60
					11						61
					12						62
					13						63
					14						64
					15						65
	Trip cold box	from page no.100/64	1	US 20000	16						66
					17				to page 107/25	HP-GAN from coldbox	67
					18					FIC 20001 manual / Y=0%	68
					19						69
	GAN outlet coldbox ppm02 analyzer	Value > Max2	1	QHH 20001	20						70
					21						71
					22						72
	Trip LIN-pump P71100	from page no.165/68	1	US 71100	23				Close solenoid valve UV 20001	HP-GAN product Close FV 20001	73
					24						74
	Trip LIN-pump P71200	from page no.172/68	1	US 71200	25						75
					26				to page no. 108/25	HP-GAN blow off	76
					27					FIC 20002 on "Automatic"	77
					28						78
					29						79
					30				Contact	Reset ESD-relay	80
					31						81
					32						82
					33						83
					34						84
	GAN product	Value < Min2	1	TLL 20001	35				Alarm OS	HP-GAN temp. trip	85
					36						86
	GAN outlet coldbox	Value < Min2	1	TLL 20025	37						87
					38				to page no. 108/22	HP-GAN blow off	88
	GAN outlet coldbox	Value < Min2	1	TLL 20026	39					FIC 20002 manual / Y=0%	89
					40				Solenoid valve	Close UV20002	90
	Trip cold trap GAN	Shut down relay	0	UA 20025	41						91
					42						92
					43						93
					44				to page 165/20	Shut off P7100	94
					45						95
					46				to page 172/20	Shut off P71200	96
					47						97
					48						98

PROJECT NAME	ASU KOSICE	DRAWING NAME	COLD BOX
PLANT			
SHIPPART			
From			
From			
BY			
DATE			
REVISIONS			
CHKD.			

Rev3 08.6.07 "as built"	Rev2 02.2.06	Rev1 02.2.06
NO FILE	NO FILE	NO FILE


Size	A3	Function Diagram
DRWG. NO.	K70101_104.deg	
PROJ. NO.	K70101	
REPLACES	REPLACED BY:	
DATE	17.06.2005	
AUTHOR	From	
CHECK	Echler	
STD.		
Page no.	104	
Of	230 Pages	
BASED		

Range	Comment	Origin	Type	Signal-/TAG-No.	Page	Function	Page	Signal-/TAG-No.	Destination	Comment	Range		
					1		51						
					2		52						
					3		53						
					4		54						
					5		55						
					6		56						
	Reset trip GOX	Software button OS	1 HS 20011		7		57						
					8		58						
					9		59						
					10		60	1 UA 20011	Alarm OS	"Trip GOX product"			
					11		61						
					12		62						
					13		63						
					14		64						
					15		65						
	Trip cold box	from page no.100/66	1 US 20000		16		66						
					17		67	1 US 20011	to page no. 109/25	GOX from coldbox			
					18		68			FIC 20011			
					19		69			manual / Y=0%			
					20		70						
	GOX outlet coldbox	Value < Min2	1 QLL 20011		21		71						
	%O2 analyzer				22		72	0 US 20011	Close solenoid valve	GOX product			
					23		73		UV 20011	Close FCV 20011			
					24		74						
	Trip LOX-pump	from page no.151/68	1 US 61100		25		75						
	P61100				26		76	1 US 20011	to page no. 110/25	GOX blow out			
	Trip LOX-pump	from page no.158/68	1 US 61200		27		77			FIC 20012 on			
	P61200				28		78			automatic			
					29		79						
					30		80	1 HS 20011	Contact	Reset ESD-relay			
					31		81			UZ 20027			
					32		82						
					33		83						
					34		84						
	GOX product	Value < Min2	1 TLL 20011		35		85	1 UA 20027	Alarm OS	GOX temperature trip			
					36		86						
	GOX outlet coldbox	Value < Min2	1 TLL 20028		37		87						
					38		88	1 US 20027	to page no. 110/22	GOX blow out			
	GOX outlet coldbox	Value < Min2	1 TLL 20027		39		89			FIC 20012			
					40		90			manual / Y=0%			
	Trip cold trap GOX	Shut down relay	1 UA 20027		41		91	0 US 20027	Solenoid valve	Close UV20012			
					42		92						
					43		93						
					44		94	1 US 20027_dyn	to page no. 151/20	Shut off P61100			
					45		95						
					46		96						
					47		97	1 US 20027_dyn	to page no. 158/20	Shut off P61200			
							98						
						DRAWING NAME: COLD BOX						DATE: 17.06.2005	
						PROJECT NAME: ASU KOSICE						AUTHOR: Frohn	
						COLD BOX						CHECK: Eichler	
						AIR LIQUIDE						STD.	
						Air Liquide ACS GmbH Füßingweg 34 47805 Krefeld						K70101_105.dwg	
						PLANT						Page no. 105	
						Rev3 08.6.07" as built"						OF 230 Pages	
						Rev2 02.2.06						K70101	
						DATE REVISIONS						REPLACES:	
						BY						REPLACED BY:	
						CHKD.						BASED:	
						JOB NO. FILE NO. REV. DATE						TRIP UZ20027	

Rang	Comment	Origin	Type	Signal-/TAG-No.	Tag	Function	Type	Signal-/TAG-No.	Destination	Comment	Rang
					1		51				
					2		52				
					3		53				
					4		54				
					5		55				
	Reset trip GAN	Software button OS	1	HS 20005	6		56				
					7		57				
					8		58				
					9		59				
					10		60	1 UA 20005	Alarm OS	"Trip LP-GAN product"	
					11		61				
					12		62				
					13		63				
					14		64				
					15		65				
	Trip cold box	from page no.100/52	1	US 20000	16		66				
					17		67	1 US 20005	to page 111/25	LP-GAN from coldbox	
					18		68			FIC 20005	
					19		69			manual / Y=0%	
	LP-GAN outlet CB	Value > Max2	1	QHH 20005	20		70				
	ppm02 analyzer				21		71				
					22		72				
					23		73				
					24		74				
					25		75				
					26		76	1 US 20005	to page no. 112/25	LP-GAN blow off	
					27		77			FIC 20006 on	
					28		78			"Automatic"	
					29		79				
					30		80				
					31		81				
					32		82				
					33		83				
					34		84				
					35		85				
					36		86				
					37		87				
					38		88				
					39		89				
					40		90				
					41		91				
					42		92				
					43		93				
					44		94				
					45		95				
					46		96				
					47		97				
					48		98				

PROJECT NAME		DRAWING NAME		FUNKTION DIAGRAM		DATE	
ASU KOSICE	COLD BOX	TRIP LP-GAN PURITY US20005	AIR LIQUIDE	COLD BOX	SIZE	A3	17.06.2005
PLANT		FILLING WEG 34		DRVG. NO.		K70101_106.deg	
PART		47805 Krefeld		PRDJ. NO.		K70101	
REV. 08.6.07 as built		FROHN		REPLACES		REPLACED BY	
REV. 07.2.06		FROHN		PAGE NO.		106	
DATE		BY		OF		230	
REVISIONS		CHKD.		BASED		PAGE	

[illegible]

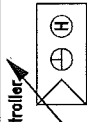Function																											
Rang.	Comment	Origin	Type	Signal-/TAG-No.	Path	Diagram			Path																		
					1	<div><div></div><div>FIC 20002 PI - Controller</div><div><table><tr><td>X Input signal</td><td>Control output Y</td></tr><tr><td>W ext. Setpoint</td><td>PI algorithm Y</td></tr><tr><td>W ext. on</td><td></td></tr><tr><td>Y value for auto</td><td>Actual setpoint</td></tr><tr><td>Y value for man.</td><td>Control deviation</td></tr><tr><td>Y Start value</td><td></td></tr><tr><td>switch on</td><td>Manual mode</td></tr><tr><td>Manual on</td><td>Automatic mode</td></tr><tr><td>Automatic on</td><td>Slave mode</td></tr></table></div></div>			X Input signal	Control output Y	W ext. Setpoint	PI algorithm Y	W ext. on		Y value for auto	Actual setpoint	Y value for man.	Control deviation	Y Start value		switch on	Manual mode	Manual on	Automatic mode	Automatic on	Slave mode	51
X Input signal	Control output Y																										
W ext. Setpoint	PI algorithm Y																										
W ext. on																											
Y value for auto	Actual setpoint																										
Y value for man.	Control deviation																										
Y Start value																											
switch on	Manual mode																										
Manual on	Automatic mode																										
Automatic on	Slave mode																										
					2				52																		
					3				53																		
					4				54																		
					5	55																					
					6	56																					
					7	57																					
					8	58																					
					9	59																					
					10	60																					
					11	61																					
					12	62																					
					13	63																					
	GAN ex cold box	Flow PT-corrected from page no.107/71	E F 20001 E F20001_ASP		14	64	E FV 20002	Positioner 0-100% ±4-20mA	GAN blow off valve FCV 20002																		
					15	65																					
					16	66																					
					17	67																					
					18	68	E F 20002_X0		Control deviation																		
					19	69																					
	Trip cold box	from page no.100/68	1 US20000_TRCO		20	70																					
	Track Y=0%				21	71																					
	GAN temperature trip	from page no.104/88	1 US 20025		22	72																					
					23	73																					
					24	74																					
					25	75																					
	Trip GAN product	from page 104/76	1 US 20001		26	76																					
					27	77																					
					28	78																					
					29	79																					
					30	80																					
					31	81																					
					32	82																					
					33	83																					
					34	84																					
					35	85																					
					36	86																					
					37	87																					
					38	88																					
					39	89																					
					40	90																					
					41	91																					
					42	92																					
					43	93																					
					44	94																					
					45	95																					
					46	96																					
					47	97																					
					48	98																					

DRAWING NAME: COLD BOX				FUNKTION DIAGRAM				DATE 17.06.2005
ASU KOSICE				SIZE A3	K70101_108.dwg			AUTHOR: From
COLD BOX				DRVG. NO.				CHECK: Etchler
Air Liquide AGS GmbH Füllingsweg 34 47805 Krefeld				PROJ. NO.	K70101			STD.
Rev3 08.6.07" as built"				REPLACES:	REPLACED BY:			Page no. 108
Rev2 02.2.06								OF 230 Pages
JOB NO. FILE NO. REV. DATE REVISIONS BY								BASED:


JOB NO.		FILE NO.	REV	DATE	BY	CHKD.	DATE	17.06.2005
PROJECT NAME		ASU KOSICE		DRAWING NAME		COLD BOX		DATE
PLANT		COLD BOX		AIR LIQUIDE		GAN BLOW OFF CONTROL		AUTHOR
SHEET PART		COLD BOX		Air Liquide ACS GmbH		FIC 20002		CHECK
FROM		FROM		Füllungsweg 34		K70101		STD.
FROM		FROM		47805 Krefeld		K70101_108.dwg		Page no. 108
BY		BY		REVISED		REPLACED BY		Of 230 Pages
BASED		BASED		BASED		BASED		BASED

Function				
No.	Type	Signal-/TAG-No.	Destination	Comment
51				
52				
53				
54				
55				
56	E F 20011		to page no. 110/14 GOX outlet coldbox	
57				Flow Pt corrected
58				
59				
60				
61				
62				
63				
64				
65				
66				
67				
68	E FV 20011		Positioner 4...20mA GOX to Customer	
69			= 0-100%	
70				
71				
86	E PIC20011_Y		to page no. 156/10 Set point PIC 61170	
87				
88				
89				
90	E PIC20011_Y		to page no. 163/10 Set point PIC 61270	
91				
92				
93				
94				
95				
96				
97				
98				

<

[illegible]

[illegible]

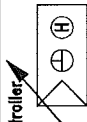Function																											
Rang.	Comment	Origin	Type	Signal-/TAG-No.	Tag.	FIC 20006																					
					1	<div>PI - Controller</div> <div></div> <div><table><tr><td>X Input signal</td><td>Control output Y</td></tr><tr><td>W ext. Setpoint</td><td>PI algorithm Y</td></tr><tr><td>W ext. on</td><td></td></tr><tr><td>Y value for auto</td><td>Actual setpoint</td></tr><tr><td>Y value for man. switch on</td><td>Control deviation</td></tr><tr><td>Y Start value</td><td></td></tr><tr><td>Manual on</td><td>Manual mode</td></tr><tr><td>Automatic on</td><td>Automatic mode</td></tr><tr><td></td><td>Slave mode</td></tr></table></div> <div>0%</div>				X Input signal	Control output Y	W ext. Setpoint	PI algorithm Y	W ext. on		Y value for auto	Actual setpoint	Y value for man. switch on	Control deviation	Y Start value		Manual on	Manual mode	Automatic on	Automatic mode		Slave mode
X Input signal	Control output Y																										
W ext. Setpoint	PI algorithm Y																										
W ext. on																											
Y value for auto	Actual setpoint																										
Y value for man. switch on	Control deviation																										
Y Start value																											
Manual on	Manual mode																										
Automatic on	Automatic mode																										
	Slave mode																										
					2																						
					3																						
FIC 20006		COLD BOX		ASU KOSICE		PROJECT NAME		PLANT	
PI - Controller		AIR LIQUIDE		ASU KOSICE		NAME		PLANT	
X Input signal		Control output Y		Flow PT-corrected		E F 20005		Frohn	
W ext. Setpoint		PI algorithm Y						Frohn	
W ext. on								Frohn	
Y value for auto		Actual setpoint						Frohn	
Y value for man. switch on		Control deviation						Frohn	
Y Start value								Frohn	
Manual on		Manual mode						Frohn	
Automatic on		Automatic mode						Frohn	
		Slave mode						Frohn	

FIC 20006		COLD BOX		ASU KOSICE		PROJECT NAME		PLANT	
PI - Controller		AIR LIQUIDE		ASU KOSICE		NAME		PLANT	
X Input signal		Control output Y		Flow PT-corrected		E F 20005		Frohn	
W ext. Setpoint		PI algorithm Y						Frohn	
W ext. on								Frohn	
Y value for auto		Actual setpoint						Frohn	
Y value for man. switch on		Control deviation						Frohn	
Y Start value								Frohn	
Manual on		Manual mode						Frohn	
Automatic on		Automatic mode							

[illegible]

Function																			
Comment	Origin	Type	Signal-/TAG-No.	Pos.	Pos.	Pos.	Pos.	Pos.	Pos.	Signal-/TAG-No.	Destination	Comment	Size	A3	FUNKTION DIAGRAM	DATE	17.06.2005	AUTHOR	Frohn
				1															
				2															
				3															
HP-GOX to customer	DP-transmitter	E FT 20013		4															
HP-GOX to customer	P-transmitter	E PT 20013		5															
HP-GOX to customer	PT100	E TE 20013		6															
				7															
				8															
				9															
Difference press.	Value < Min	1 PDL20013		32															
Difference press.	Value < Min	1 DPL20015		33															
				34															
				35															
				36															
Function									
Comment	Origin	Type	Signal-/TAG-No.	Page	Page	Type	Signal-/TAG-No.	Destination	Comment
				1		51			
				2		52			
				3		53			
				4		54			
				5		55			
				6		56			
				7		57			
				8		58			
				9		59			
				10		60			
				11		61			
				12		62			
				13		63			
				14		64			
				15		65			
				16		66			
				17		67			
				18		68			
				19		69			
				20		70			
				21		71	E H20014	Positioner 0-100% = 4...20mA	Bypass valve HV200014
				22		72			
				23		73			
				24		74			
				25		75			
				26		76			
				27		77			
				28		78			
				29		79			
				30		80			
				31		81			
				32		82			
				33		83			
				34		84			
				35		85			
				36		86	1 US 20014	Solenoid valve	Open product butterfly valve HK20014
				37		87			
				38		88			
				39		89			
				40		90			
				41		91			
				42		92			
				43		93			
				44		94			
				45		95			
				46		96			
				47		97			
				48		98			
<div> <div>HIC 20014</div> <div> <div>Manual control station</div> <div> <div>Y Start value</div> <div>Output signal Y</div> <div>Y Start value switch on</div> </div> </div> </div> <div> <div>US 20014</div> <div> <div>Safety Intervention Open</div> <div>Interlock Open</div> <div>Automatic Open</div> <div> <div>Check Back</div> <div>Operator Input Open</div> <div>Interlock Open</div> <div>Operator Input Close</div> <div>Interlock Close</div> <div>Safety Intervention Close</div> </div> <div> <div>Valve-Logic</div> <div> <div>1 0</div> <div>1 1</div> <div>Error</div> <div>Check Back</div> <div>Error</div> <div>Running Time</div> </div> </div> </div> </div>									
PROJECT NAME				DRAWING NAME				SIZE	
ASU KOSICE				AIR LIQUIDE				A3	
COLD BOX				COLD BOX				FUNCTION DIAGRAM	
Rev3 08.6.07 as built				Air Liquide AGS GmbH				DRWG. NO.	
Rev2 02.2.06				Füllungsweg 34				PRQJ. NO.	
Rev1 02.2.06				47805 Krefeld				REPLACES	
Rev0 02.2.06				HP-GOX PROD. TO CUSTOMER 2				K70101	
Rev0 02.2.06				HIC/US20014				REPLACED BY	
Rev0 02.2.06				DATE				17.06.2005	
Rev0 02.2.06				AUTHOR				Frohn	
Rev0 02.2.06				CHECK				Eichler	
Rev0 02.2.06				STD.				K70101_115.dwg	
Rev0 02.2.06				Page no.				115	
Rev0 02.2.06				OF				230 Pages	
Rev0 02.2.06				BASED					

[illegible][illegible]

[illegible]

Function														
Comment	Origin	Type	Signal-/TAG-No.	Pin	Pin	Diagram				Type	Signal-/TAG-No.	Destination	Comment	
				1	51	<div>QIC 40011</div> <div>PI - controller</div> <div><div>X process value</div><div>W ext. set point</div><div>Y manipulated variable</div><div>Y manipulated variable on</div><div>Manual on</div><div>Automatic on</div></div> <div><div>Output</div><div>PI-Algorithm. Y</div><div>Control difference</div><div>Status Manual</div><div>Status Automatic</div><div>Status W ext.</div></div> <div>50%</div>								
				2	52									
				3	53									
				4	54									
				5	55									
				6	56									
				7	57									
				8	58									
				9	59									
Argon sidearmgas	%O2-analyzer	E Q 40011		10	60									
				11	61	<div>FIC 22043</div> <div>PI - controller</div> <div><div>X process value</div><div>W ext. set point</div><div>Y manipulated variable</div><div>Y manipulated variable on</div><div>Manual on</div><div>Automatic on</div></div> <div><div>Output</div><div>PI-Algorithm. Y</div><div>Control difference</div><div>Status Manual</div><div>Status Automatic</div><div>Status W ext.</div></div> <div>0%</div>								
				12	62									
				13	63									
				14	64									
				15	65									
				16	66									
				17	67									
				18	68									
				19	69									
				20	70									
				21	71	<div>PT-Korrektur</div> <div>$A = E1 \sqrt{\frac{(E2+1.013)^{K1}}{(E3+273.15)^{K2}}}$</div>								
				22	72									
				23	73									
				24	74									
				25	75									
				26	76									
				27	77									
				28	78									
				29	79									
				30	80									
GOX from LP-column	F-transmitter	E FT 20043		31	81	<div>PI - controller</div> <div><div>X process value</div><div>W ext. set point</div><div>Y manipulated variable</div><div>Y manipulated variable on</div><div>Manual on</div><div>Automatic on</div></div> <div><div>Output</div><div>PI-Algorithm. Y</div><div>Control difference</div><div>Status Manual</div><div>Status Automatic</div><div>Status W ext.</div></div>								
				32	82									
				33	83									
LP-column bottom	P-transmitter	E PT 22001		34	84					E FV 22043	Positioner 0-100% =4-20mA	Control valve GOX from LP-column FV 22043		
Constant for temp.	- 180°C	E		35	85									
				36	86									
				37	87									
				38	88									
				39	89									
				40	90									
Trip Cold box	from page no.101/69 1	US 20000_dyn		41	91	<div>PI - controller</div> <div><div>X process value</div><div>W ext. set point</div><div>Y manipulated variable</div><div>Y manipulated variable on</div><div>Manual on</div><div>Automatic on</div></div> <div><div>Output</div><div>PI-Algorithm. Y</div><div>Control difference</div><div>Status Manual</div><div>Status Automatic</div><div>Status W ext.</div></div>								
				42	92									
				43	93									
				44	94									
				45	95									
				46	96									
				47	97									
				48	98									
PROJECT NAME					DRAWING NAME:					SIZE A3	FUNKTION DIAGRAM		DATE 17.06.2005	
ASU KOSICE					COLD BOX					DRWG. NO.	K70101_0118.dwg		AUTHOR Frohn	
COLD BOX					CASCADE SIDEARMGAS ANALYSIS					PROJ. NO.	K70101		CHECK Eichler	
QIC 40011 / FIC 22043					REPLACES:					REPLACED BY:	BASED:			
PLANT					Air Liquide AGS GmbH					Page no. 118				
Slipstick					Fridingsweg 34					OF 230 Pages				
Rev3 08.6.07 "as built"					47805 Krefeld					FV 22043				
Rev2 02.2.06														
NO REV DATE REVISIONS BY CHKD.														

[illegible]

Rev	Comment	Origin	Signal-/TAG-No.	Function	Size	Project Name	ASU KOSICE	AIR LIQUIDE	Drawing Name	FUNCTION DIAGRAM	DATE	17.06.2005
Rev	Comment	Origin	Signal-/TAG-No.	Function	Size	Project Name	ASU KOSICE	AIR LIQUIDE	Drawing Name	FUNCTION DIAGRAM	DATE	17.06.2005
1	Reset trip LOX	Software button OS	1 HS 22001		51							
2					52							
3					53							
4					54							
48					98							

Range	Comment	Origin	Type	Signal-/TAG-No.	Pin	Function	Pin	Range
					1		51	
					2		52	
					3		53	
					4		54	
					5		55	
	Reset trip LIN	Software button OS	1	HS 23013	6		56	
					7		57	
					8		58	
					9		59	
					10		60	1 UA 23013
					11		61	
					12		62	
					13		63	
					14		64	
					15		65	
	Trip cold box	from page no.100/82	1	US 20000	16		66	
					17		67	1 US 23013
					18		68	
					19		69	
					20		70	
					21		71	0 US 23013
					22		72	
					23		73	
					24		74	
	LIN to storage	Value > Max2	1	QHH 23013	25		75	1 FIC23073_dym1
	ppm02 analyzer				26		76	
					27		77	
	Hardware logic	Contact ESD-relay	1	UA 72051	28		78	
					29		79	
	Inlet valve LIN-Tank	from page TF_55/62	1	HS 72051	30		80	
	open				31		81	
					32		82	
	Trip LIN-Pump	from page no.165/70	1	US 71100	33		83	
	P71100				34		84	1 US 23013
	Trip LIN-Pump	from page no.172/70	1	US 71200	35		85	
	P71200				36		86	1 US 23013
					37		87	
					38		88	
					39		89	
					40		90	
					41		91	
					42		92	
					43		93	
					44		94	
					45		95	
					46		96	
					47		97	
					48		98	

DRAWING NAME:

COLD BOX

PROJECT NAME:

AIR LIQUIDE

ASU KOSICE

PROJECT NAME:

PLANT

PART

SHIP

Rev3 08.6.07 as built

Rev2 02.2.06

JOB NO. FILE NO. REV. DATE

REVISIONS BY CHKD.

TRIP LIN-PRODUCT TO STORAGE
US 23013Air Liquide AGS GmbH
Fuldastr. 34
47805 Krefeld

COLD BOX

SHIP

Rev3 08.6.07 as built

Rev2 02.2.06

JOB NO. FILE NO. REV. DATE

REVISIONS BY CHKD.

Rang	Comment	Origin	Type	Signal-/TAG-No.	Pos.	Function	Ref.	Type	Signal-/TAG-No.	Destination	Comment	Rang
					1							51
					2							52
					3							53
					4							54
					5							55
					6							56
					7							57
	LIN to storage	Flow-transmitter	E F 23013		8					Positioner 4...20mA = 0-100%	Control valve LV23013 LIN to storage	58 E
					9							59
					10							60
					11							61
					12							62
					13							63
					14							64
	Trip LIN-product	from page no.121/67	1 US 23013		15							65
					16							66
					17							67
					18							68
					19							69
					20							70
					21							71
					22							72
					23							73
					24							74
					25							75
					26							76
					27							77 E
					28					Positioner 4-20mA = 0-100%	Control valve LV23073 LIN to dump	78
					29							79
					30							80
					31							81
					32							82
					33							83
					34							84
	Trip LIN-product	from page no.121/75	1 US 23013.dyn1		35							85
					36							86
	Trip cold box	from page no.101/57	1 US 20000.dyn		37							87
					38							88
	LIN dump not ready		1 US 90013		39							89
					40							90
					41							91
					42							92
					43							93
					44							94
					45							95
					46							96
					47							97
					48							98

FIC 23013

PI - Controller

X Input signal	Control output Y
W ext. Setpoint	PI algorithm Y
Y Start value	Control deviation
	Internal setpoint
Y Start value switch on	Manual mode
Manual on	Automatic mode
Automatic on	Slave mode

FIC 23073

PI - Controller

X Input signal	Control output Y
W ext. Setpoint	PI algorithm Y
Y Start value	Control deviation
Y Start value switch on	Manual mode
Manual on	Automatic mode
Automatic on	Slave mode

≥1

DRAWING NAME:
COLD BOX

AIR LIQUIDE

ASU KOSICE

COLD BOX

PLANT
Stübel PART

Rev3 08.6.07 as built

Rev2 02.2.06

JOB NO. FILE NO. DATE REVISIONS BY CHKD.

PROJECT NAME

PLANT

Stübel PART

Rev3 08.6.07 as built

Rev2 02.2.06

JOB NO. FILE NO. DATE REVISIONS BY CHKD.

DATE 17.06.2005

A

Function									
Comment	Origin	Type	Signal-/TAG-No.	Signal-/TAG-No.	Destination	Comment			
			1	51					
			2	52					
			3	53					
			48	98					

PROJECT NAME				DRAWING NAME: SPARE				DATE 17.06.2005			
ASU KOSICE				AIR LIQUIDE				AUTHOR Frohn			
COLD BOX				Air Liquide AGS GmbH Fillingweg 34 47805 Krefeld				CHECK Eichler			
PLANT				PLANT				STD.			
Rev3 08.5.07 as built				Rev3 08.5.07 as built				Page no. 123			
Rev2 07.2.06				Rev2 07.2.06				Of 230 Pages			
JOB NO. FILE NO. REV. DATE				JOB NO. FILE NO. REV. DATE				BASED IN			
BY				BY				REPLACES:			
CHKD.				CHKD.				K70101_123.dwg			
								K70101			
								REPLACED BY:			


[illegible][illegible]

Function					EXPANDER TURBINE 1			EXPANDER		
Rang.	Comment	Origin	Type	Signal-/TAG-No.	Ref.	ASU KOSICE	PROJECT NAME	ASU KOSICE	EXPANDER	
					1					
					2					
					3					
					4					
					5					
	Reset trip turbine 1	Software button OS	1	HS 24100	6					
					7					
					8					
					9					
	Emergency shut down	ESD button	0	HZ 24100	10					
					11					
	Derating turb. 1 on	Software switch OS	1	HS 24106	12					
					13					
	Trip cold box	from page no.100/58	1	US 20000	14					
					15					
	Speed expander	Value > Max2	1	SHH 24124	16					
					17					
	Speed expander	Contact > Max2	0	SHH 24124	18					
					19					
					20					
					21					
	Quick shut off valve	from page no.127/75	1	HS 24101	22					
	open				23					
	Speed expander	Value < Min2	1	SLL 24124	24					
					25					
	Vibration expander	Value > Max2	1	XHH 24124	26					
	Expander on	from page no.127/80	1	HS 24101	27					
	Air Inlet expander	Value < Min2	1	TLL 24101	28					
					29					
	Bearing expander	Value > Max2	1	THH 24120	30					
	Bearing expander	Value > Max2	1	THH 24121	31					
	Bearing expander	Value > Max2	1	THH 24123	32					
					33					
	Seal gas supply	Value < Min2	1	PLL 24144	34					
	Oil press. expander	Value < Min2	1	PLL 24169	35					
	Oil press. expander	Contact < Min2	0	PLL 24168	36					
	Oil temp. expander	Value > Max2	1	THH 24169	37					
	Oil behind gearbox	Value > Max2	1	THH 24151	38					
					39					
	Bearing generator	Value > Max2	1	THH 24171	40					
	Bearing generator	Value > Max2	1	THH 24173	41					
					42					
	Winding U generator	Value > Max2	1	THH 24175	43					
	Winding V generator	Value > Max2	1	THH 24176	44					
	Winding W generator	Value > Max2	1	THH 24177	45					
					46					
	Fail generator	from page no.131/95	1	US 24110_fail	47					
					48					

Function				EXPANDER TURBINE 1				EXPANDER			
S				AIR LIQUIDE				PROJECT NAME			
1/0				Air Liquide AGS GmbH				PLANT			
1/1				Füllingsweg 34				Sigloch PART			
R				47805 Krefeld				From			
								Rev3 08.6.07* as built*			
								Rev2 02.2.06			
								DATE			
								REV			
								BY			
								CHECK			
								FROM			
								TO			
								DATE			
								REV			
								BY			
								CHECK			
								FROM			
								TO			
								DATE			
								REV			
								BY			
								CHECK			

Function

Comment	Origin	Signal-/TAG-No.	Typ	Signal-/TAG-No.	Destination	Comment
Auxiliary oil pump on	Check back signal	1 EH 24163	1			
Speed expander	Value < Min1	1 SL 24124	1			
Trip expander turb. 1	from page no.125/60	1 US 24100	1			
Nozzle ring closed	End position switch	1 GL 24105	1			
Nozzle ring	Y-Value < 1%	1 HIC 24105	1			
Air to expander	Output signal Y<1%	1 FIC 24101	1			
Deriving mode	from page no.128/57	1 HS 24106	1			
Level oil tank	Level switch < Min	1 LL 24160	1			
Oil behind cooler	Value > Max1	1 TH 24169	1			
Oil press. expander	Value < Min1	1 PL 24169	1			
Seal gas to gap gas	Value < Min	1 PDL 24141	1			
Seal gas supply	Value < Min1	1 PL 24144	1			
Vibration expander	Value > Max1	1 XH 24124	1			
Quick shut closed	End position switch	1 GL 24101	1			
Air to MHE open	End position switch	1 GH 20026	1			
Air exh. BAC open	End position switch	1 GH 16073	1			
Top HP-column	Value > Max	1 PHS 21002	1			
Air exh. expander	P-Transmitter	E PT 24102	E			
HP-column Top	PD-Transmitter	E PDT 21002	E			
HP-column	P-Transmitter	E PDT 21003	E			
Constant		E 1.000	E			

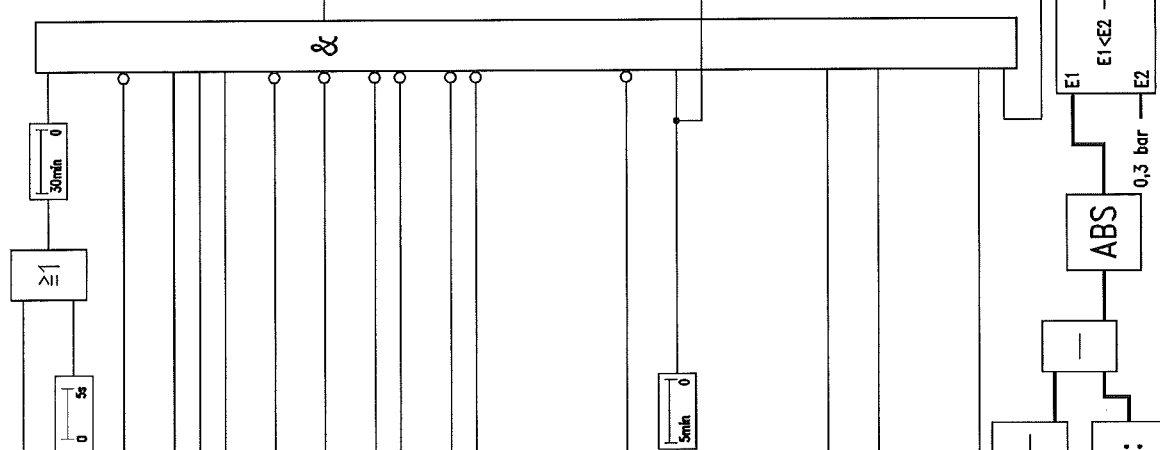

DATE	17.06.2005
AUTHOR	Frohm
CHECK	Eichler
STD.	
Page no.	126
Of	230 Pages
DATE	17.06.2005
AUTHOR	Frohm
CHECK	Eichler
STD.	
Page no.	126
Of	230 Pages

DRAWING NAME:
EXPANDER TURBINE 1
START CONDITIONS UH24103

AIR LIQUIDE
Air Liquide AGS GmbH
Füllingsweg 34
47805 Krefeld

ASU KOSICE
EXPANDER

PROJECT NAME	
PLANT PART	
Rev3 08.6.07 "as built"	Frohm
Rev2 02.2.06	Frohm
Rev1 02.2.06	Eichler
DATE	
REVISIONS	
BY	
CHKD.	

[illegible][illegible]

Rank	Comment	Origin	Type	Signal-/TAG-No.	Function	Signal-/TAG-No.	Destination	Comment	Rank
1									51
2									52
3	Defrost expander	Software switch OS	1 HS 24106				to page no.127/42	Open shut off valve	53
4									54
5	Shut off valve closed	from page no.126/80	1 GL 24101_delay				Monitoring OS	"Deriming mode expander turbine 1 on"	55
6									56
7							to page no.126/13	Start conditions	57
8									58
9									59
10	Oil pump on	from page no.130/71	1 HS 24163						60
11									61
12	Nozzle ring drive ETI	End position switch	1 GL 24105						62
13									63
14	Quick shut off valve	End position switch	1 GL 24101						64
15									65
16									66
17									67
18									68
19									69
20	Sad gas supply	Value < Min1	1 PL 24144						70
21									71
22	Oil expander	Contact < Min2	0 PLL 24168						72
23									73
24									74
25									75
26									76
27									77
28									78
29									79
30									80
31									81
32									82
33									83
34	Speed expander	Value > Max	1 SH 24124_1						84
35									85
36									86
37									87
38									88
39									89
40									90
41									91
42	Outlet expander	Value > Max	1 PH 24102				Alarm OS	"Pressure outlet exp. too high"	92
43									93
44									94
45	Emergency shut down	ESD button	0 HA 24100						95
46									96
47									97
48									98

Function

SIZE	A3	FUNKTION DIAGRAM	DATE	17.06.2005
DRWG. NO.		K70101_128.dwg	AUTHOR	From
PROJ. NO.		K70101	CHECK	Eichler
REPLACES		RELACED BY:	STD.	
			Page no.	128
			Of	230 Pages
			BASED:	

[illegible]

[illegible]


Function					Typ	Signal-/TAG-No.	Destination	Comment
					51			
					52			
					53			
					54			
					55			
					56			
					57			
					58			
					59			
					60			
					61			
					62			
					63			
					64	1 US 24110	Signal to MCC	Generator exp. turb.1 on
					65			
					66			
					79	1 US 24110_CB	Alarm OS	"Check back error"
					80			
					81			
					82			
					83	1 US 24110_RT	Alarm OS	"Running time error"
					84			
					85			
					86			
					87			
					88			
					89			
					90			
					91			
					92			
					93			
					94			
					95	1 US 24110_fall	to page no.125/47	Fall generator
					96			
					97			
					98			

PROJECT				DRAWING NAME				DATE			
NAME				EXPANDER TURBINE 1				17.06.2005			
PLANT				GENERATOR US24110				From			
PART				Air Liquide ACS GmbH				CHECK			
BY				Füßingweg 34				STD.			
CHKD.				47805 Krefeld				K70101_131.dwg			
REV. 01				Rev3 08.6.07 "as built"				K70101			
REV. 02				Rev2 02.2.06				Page no. 131			
REV. 03				Rev3 08.6.07 "as built"				230 Pages			
REV. 04				Rev4 08.6.07 "as built"				BASED			
REV. 05				Rev5 08.6.07 "as built"				REPLACES:			
REV. 06				Rev6 08.6.07 "as built"				K70101			
REV. 07				Rev7 08.6.07 "as built"				K70101			
REV. 08				Rev8 08.6.07 "as built"				K70101			
REV. 47				Rev47 08.6.07 "as built"				K70101			

Function									
Comment	Origin	Type	Signal-/TAG-No.	P. No.	EXPANDER				
				1	ASU KOSICE				
				2	PROJECT NAME				
				3	EXPANDER TURBINE 1				
				4	AIR LIQUIDE				
				5	Air Liquide AGS GmbH				
				6	Füßingweg 34				
				7	47805 Krefeld				
				8	PLANT				
				9	PART				
				10	Frohn				
				11	Frohn				
					DATE 17.06.2005				
					AUTHOR Frohn				
					CHECK Eichler				
					STD.				
					Page no. 132				
					Of 230 Pages				
					BASED:				

[illegible]

Rank	Comment	Origin	Signal-/TAG-No.	Type	Function	Signal-/TAG-No.	Destination	Comment	Rank
51									51
52									52
53						1 HA 24200	Alarm OS	"Emergency shut down" turbine 2	53
54									54
55									55
56									56
57	Reset trip turbine 2	Software button OS	1 HS 24200	1			Alarm OS	"Trip expander turbine 2"	57
58									58
59	Emergency shut down	ESD button	0 HZ 24200	0					59
60									60
61									61
62	Dermining turb. 2 on	Software switch OS	1 HS 24206	1					62
63									63
64	Trip cold box	from page no.100/60	1 US 20000	1					64
65									65
66	Speed expander	Value > Max2	1 SHH 24224	1					66
67									67
68	Speed expander	Contact > Max2	0 SHH 24224	0					68
69									69
70									70
71	Quick shut off valve open	from page no.128/75	1 HS 24201	1					71
72									72
73	Speed expander	Value < Min2	1 SLL 24224	1					73
74									74
75									75
76	Vibration expander	Value > Max2	1 XHH 24224	1					76
77	Expander 2 on	from page no.137/80	1 HS 24201	1					77
78	Air Inlet expander	Value < Min2	1 TLL 24201	1					78
79									79
80	Bearing expander	Value > Max2	1 THH 24220	1					80
81									81
82	Bearing expander	Value > Max2	1 THH 24221	1					82
83									83
84	Seal gas supply	Value < Min2	1 PLL 24244	1					84
85	Oil press. expander	Value < Min2	1 PLL 24269	1					85
86									86
87	Oil temp. expander	Contact < Min2	0 PLL 24268	0					87
88									88
89	Oil behind gearbox	Value > Max2	1 THH 24269	1					89
90									90
91	Bearing generator	Value > Max2	1 THH 24271	1					91
92	Bearing generator	Value > Max2	1 THH 24273	1					92
93									93
94	Winding U generator	Value > Max2	1 THH 24275	1					94
95	Winding V generator	Value > Max2	1 THH 24276	1					95
96	Winding W generator	Value > Max2	1 THH 24277	1					96
97									97
98	Fail generator	from page no.131/95	1 US 24210_fail	1					98

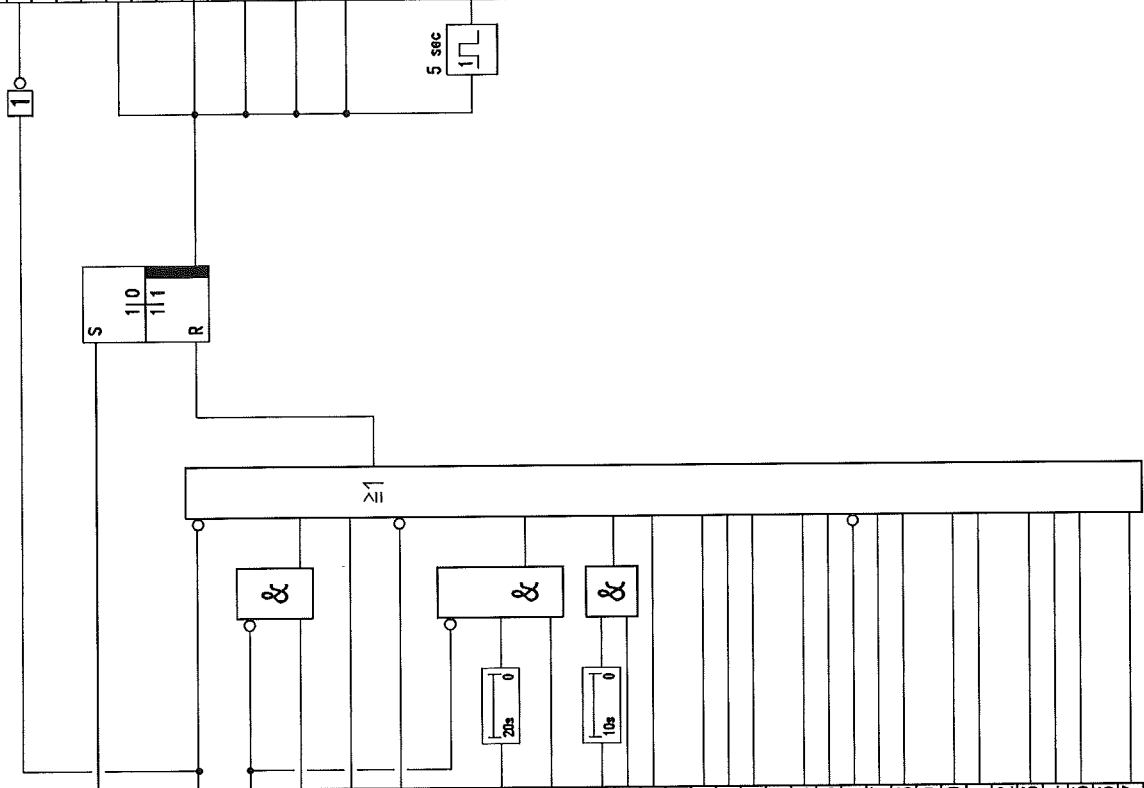

DRAWING NAME:		EXPANDER TURBINE 2		FUNKTION DIAGRAM		DATE: 17.06.2005	
PROJECT NAME:		ASU KOSICE		SIZE: A3		AUTHOR: Frohnt	
PLANT PART:		EXPANDER		DRWG. NO.:		CHECK: Eichler	
FROM: Stückl		EXPANDER		PROJ. NO.:		STD.:	
REV: 08.6.07 as built		EXPANDER		REPLACES:		Page no. 134	
REV: 02.2.06		EXPANDER		K70101		Of 230 Pages	
JOB NO: FILE NO: REV: DATE: REVISIONS: BY: CHKD:		EXPANDER		K70101		BASED:	

Function					
Comment	Origin	Type	Signal-/TAG-No.	Signal-/TAG-No.	Destination
Auxiliary oil pump on	Check back signal	1 EH 24263			
Speed expander	Value < Min1	1 SL 24224			
Trip expander turb. 2	from page no.134/60	1 US 24200			
Nozzle ring closed	End position switch	1 GL 24205			
Nozzle ring	Y-Value < 1%	1 HC 24205			
Air to expander	Output signal Y<1%	1 FC 24201			
Dermining mode	from page no.137/57	1 HS 24206			
Level oil tank	Level switch < Min	0 LL 24260			
Oil behind cooler	Value > Max1	1 TH 24269			
Oil press. expander	Value < Min1	1 PL 24269			
Seal gas to gap gas	Value < Min	1 PDL 24241			
Seal gas supply	Value < Min1	1 PL 24244			
Vibration expander	Value > Max1	1 XH 24224			
Quick shut closed	End position switch	1 GL 24201			
Air to MHE open	End position switch	1 GH 20026			
Air exh. BAC open	End position switch	1 GH 16073			
Top HP-column	Value > Max	1 PH 21002			
Air exh. expander	P-Transmitter	E PT 24202			
Top HP-column	PD-Transmitter	E PDT 21002			
HP-column	PD-Transmitter	E PDT 21003			
Constant		E 1000			

The diagram illustrates the functional connections between different parts of the system. It includes symbols for pumps, control valves, and transmitters, all interconnected to show the flow of signals or materials. Key elements include a check back signal, speed expander, trip expander, nozzle rings, air supply/expansion points, dermining mode, level oil tank, oil behind cooler, seal gas systems, vibration expander, quick shut, air to MHE/BAC, and HP-columns with their respective transmitters.

This small diagram shows a specific connection point involving a valve and a transmitter, likely related to the seal gas or vibration monitoring functions mentioned in the table.

Detailed schematic of the ABS (Anti-lock Braking System) component. It shows two input/output lines labeled E1 and E2, and a central unit labeled A. The diagram indicates the internal wiring and signal paths for this critical safety system.

AIR LIQUIDE
AGS GMBH
Füllingsweg 34
47805 Krefeld

ASU KOSICE

EXPANDER TURBINE 2
START CONDITIONS EL24210

EXPANDER

PROJECT NAME

PLANT PART

Rev3 08.6.07 "as built"
Rev2 02.2.06 From Echler
Rev1 02.2.06 From CHKD

JOB NO./FILE NO.

REVISIONS

BY

CHECKED

DATE

AUTHOR

CHECK

From

To

Page no. 135

Of 230 Pages

BASED

REPLACED BY:

SIZE

A3

FUNKTION DIAGRAM

DWG. NO. K70101_135.dwg

PROJ. NO. K70101

DATE 17.06.2005

AUTHOR

CHECK

FROM

TO

STD.

Page no. 135

Of 230 Pages

BASED

REPLACED BY:


[illegible]

Range	Comment	Origin	Type	Signal-/TAG-No.	Function	Type	Signal-/TAG-No.	Destination	Comment	Range
1						1				51
2						2				52
3	Defrost expander	Software switch OS	1 HS 24206			3				53
4						4			Open shut off valve	54
5	Shut off valve closed	from page no.135/80	1 GL 24201_delay			5				55
6						6			"Deriming mode expander turbine 2 on"	56
7						7				57
8						8			to page no.135/13	58
9						9				59
10	Oil pump on	from page no.139/71	1 HS 24263			10				60
11						11				61
12	Nozzle ring drive ET2	End position switch	1 GL 24205			12				62
13						13				63
14	Nozzle valve closed	End position switch	1 GL 24201			14				64
15						15				65
16						16				66
17						17				67
18						18				68
19						19				69
20	Sed. gas supply	Value < Min1	1 PL 24244			20				70
21						21				71
22	Oil expander	Contact < Min2	0 PLL 24268			22				72
23						23				73
24						24				74
25						25				75
26						26				76
27						27				77
28						28				78
29						29				79
30						30				80
31						31				81
32						32				82
33						33				83
34	Speed expander	Value > Max	1 SH 24224			34				84
35						35				85
36						36				86
37						37				87
38						38				88
39						39				89
40						40				90
41						41				91
42	Outlet expander	Value > Max	1 PH 24202			42				92
43						43				93
44						44				94
45	Emergency shut down	ESD button	0 HA 24200			45			"Pressure outlet exp. too high"	95
46						46				96
47						47				97
48						48				98

DATE	17.06.2005
AUTHOR	Frohn
CHECK	Eichler
STD.	
Page no. 13/	
Of	230 Pages
BASED	
SIZE	A3
FUNKTION	DIAGRAM
DRWG. NO.	K70101_137.dwg
PROJ. NO.	K70101
REPLACES	REPLACED BY:
DRAWING NAME	EXPANDER TURBINE 2
DERIMING MODE	HS24206
AIR LIQUIDE	
Air Liquide AGS GmbH	
Fußingweg 34	
47805 Krefeld	
ASU KOSICE	
EXPANDER	
PROJECT	
NAME	
PLANT	
Rev3 08.6.07 "as built"	Frohn
Rev2 02.2.06	Frohn
Rev1 02.2.06	Eichler
NO FILE NO	DATE
REVISIONS	BY
CHKD.	

[illegible][illegible]

Range	Comment	Origin	Type	Signal-/TAG-No.	Function	Type	Signal-/TAG-No.	Destination	Comment	Range
1						51				51
2						52				52
3						53				53
4						54				54
5						55				55
6	Ex turbine off	from page no.136/77	0	HS 24201		56				56
7						57				57
8						58				58
9	Trip exp. turbine 2	from page no.134/64	1	US 24200		59				59
10						60				60
11						61				61
12	Shut off valve closed	End position switch	1	GL 24201		62				62
13						63				63
14						64				64
15	Temp. oil tank	Value < Min	1	TL 24261		65				65
16						66				66
17	Seal gas supply	Value < Min1	1	PL 24244		67				67
18						68				68
19	Level oil tank	Level switch < Min1	0	LL 24260		69				69
20						70				70
21						71	0	HS 24263	to page no.137/10	71
22	Ex turbine on/off	Check back signal	1	EH 24210		72			Deriving mode off	72
23						73	1	HS 24263	Signal to MCC	73
24	Oil pump on	Check back signal	1	EH 24263		74			Oil pump P24263 on	74
25						75				75
26						76				76
27	Shut off valve closed	End position switch	1	GL 24201		77				77
28	Speed expander	Value < Min1	1	SL 24224		78	1	HS 24263_CB	Alarm OS	78
29	Shut off expander	from page no.127/77	1	HS 24201		79			"Check back error"	79
30						80				80
31						81				81
32						82	1	HS 24263_RT	Alarm OS	82
33						83				83
34	Seal gas supply	Value < Min2	1	PL 24244		84				84
35						85				85
36	Shut off valve closed	End position switch	1	GL 24101		86				86
37						87				87
38						88				88
39						89				89
40	Reset trip exp. turb.2	Reset button OS	1	HS 24200		90				90
41						91				91
42						92				92
43						93				93
44						94				94
45						95				95
46						96				96
47						97				97
48						98				98

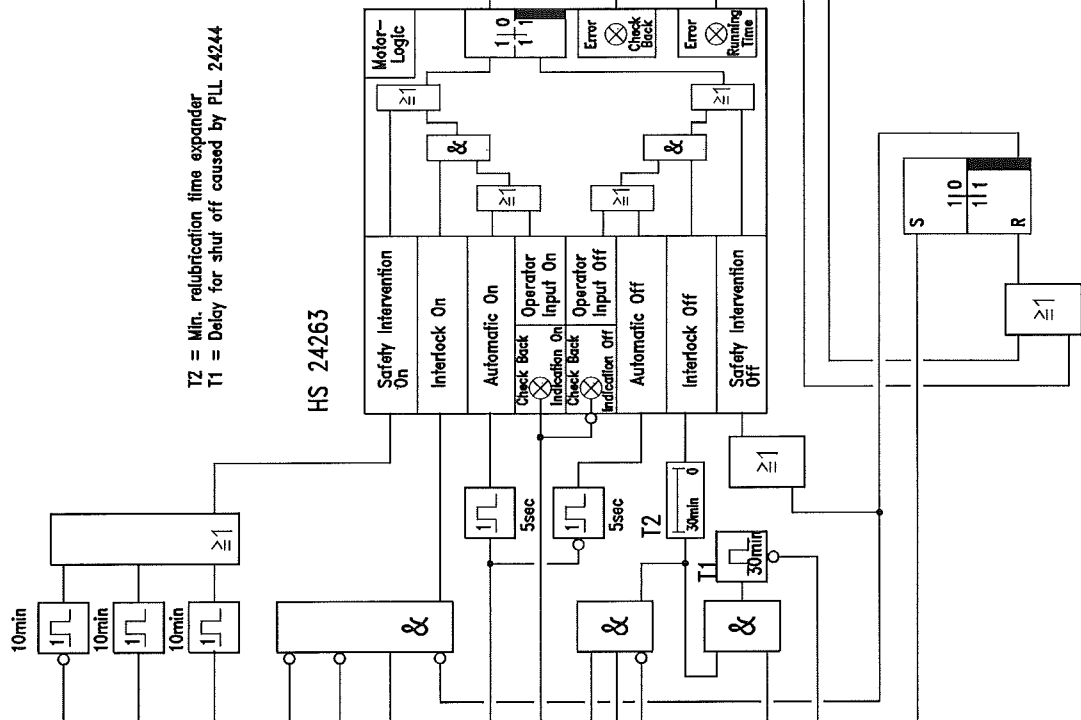

--	--	