



Function					Signal-/TAG-No.	Destination	Comment
Comment	Origin	Type	Signal-/TAG-No.	Ref.	Signal-/TAG-No.	Destination	Comment
				51			
				52			
Speed expander	Contact > Max1	1 SH 24224_2		53			
Speed expander	Contact > Max2	1 SHH 24224_1		54			
				55			
				56			
				57			
				58			
Quick shut off valve	End position switch	1 GL 24101		59			
				60			
				61			
				62			
				63			
				64	1 US 24210	Signal to MCC	Generator exp. turb.2 on
				65			
				66			
				67			
				68			
				69			
				70			
				71			
				72			
				73			
				74			
				75			
Generator turb. 2 on	Check back signal	1 EH 24210		76			
				77			
				78			
				79	1 US 24210_CB	Alarm OS	"Check back error"
				80			
				81			
				82			
Trip exp. turbine 2	from page no.134/66	1 US 24200		83	1 US 24210_RT	Alarm OS	"Running time error"
				84			
Quick shut down	from page no.136/73	0 HS 24201		85			
				86			
				87			
				88			
				89			
Quick shut off valve	End position switch	1 GL 24101		90			
Reset generator exp.1	Software button	1 US24210_RES		91			
				92			
				93			
				94			
				95	1 US 24210_tail	to page no.134/47	Fail generator
				96			
				97			
				98			

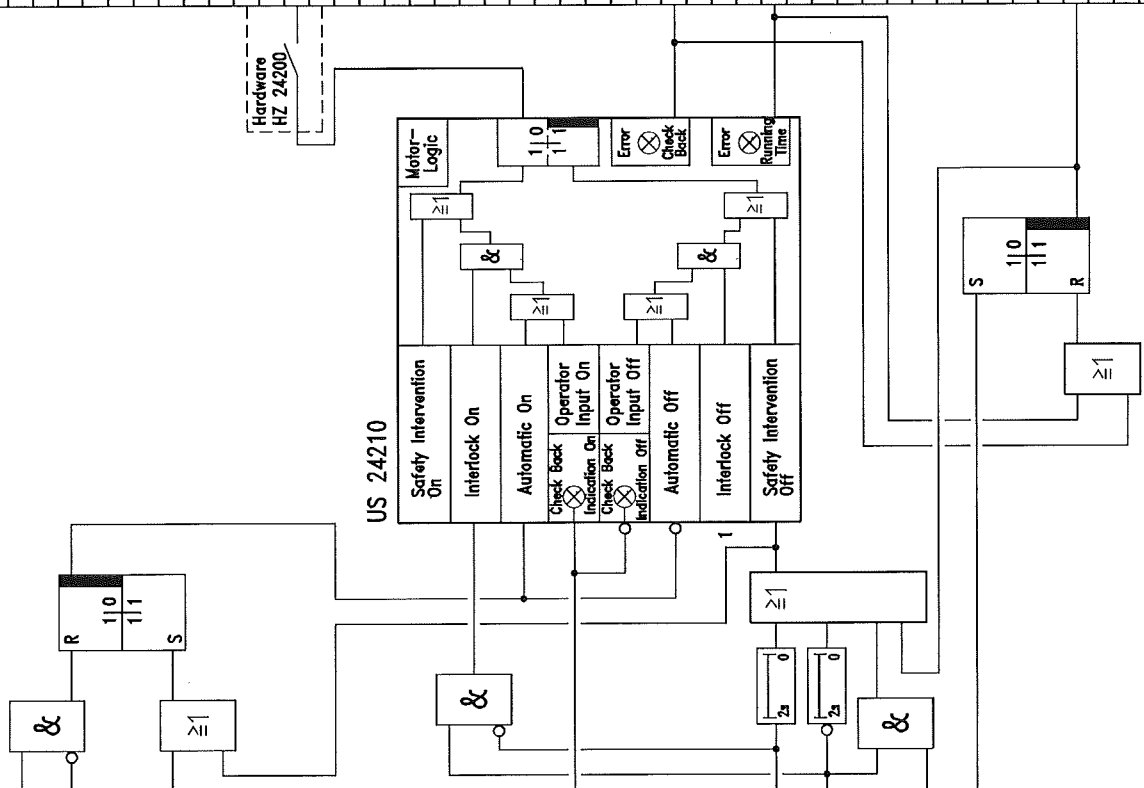

																																																																																																																																																																																																																																																																																																																																																																																																																																																																																																																																																																																																																																																																																																																																																																																																																																																																																																																																																																																																																																																																																																																																																																																																																																																																																																																																																																																																																																																																																																																																																																																																																																																																					</
--	--	----

Function									
Comment	Origin	Type	Signal-/TAG-No.	№	№	№	Signal-/TAG-No.	Destination	Comment
				1					
				2					
				3					
				DRAIVING NAME: EXPANDER TURBINE 2				DATE 17.06.2005	
				ASU KOSICE				AUTHOR Frohn	
				EXPANDER				CHECK Echter	
				PROJECT NAME				SIZE A3	
				PLANT PART				FUNKTION DIAGRAM	
				Rev3 08.6.07 as built				DRWG. NO. K70101_141.dwg	
				Rev2 02.2.06				PROJ. NO. K70101	
				JOB NO. FILE NO. REV. DATE REVISIONS BY CHKD.				REPLACES: REPLACED BY:	
				Slovakia				Page no. 141	
				Frohn				Of 230 Pages	
				Echter				BASED:	

Rank.	Comment	Origin	Type	Signal-/TAG-No.	Path	Function			Path	Type	Signal-/TAG-No.	Destination	Comment	Rank.
-------	---------	--------	------	-----------------	------	----------	--	--	------	------	-----------------	-------------	---------	-------

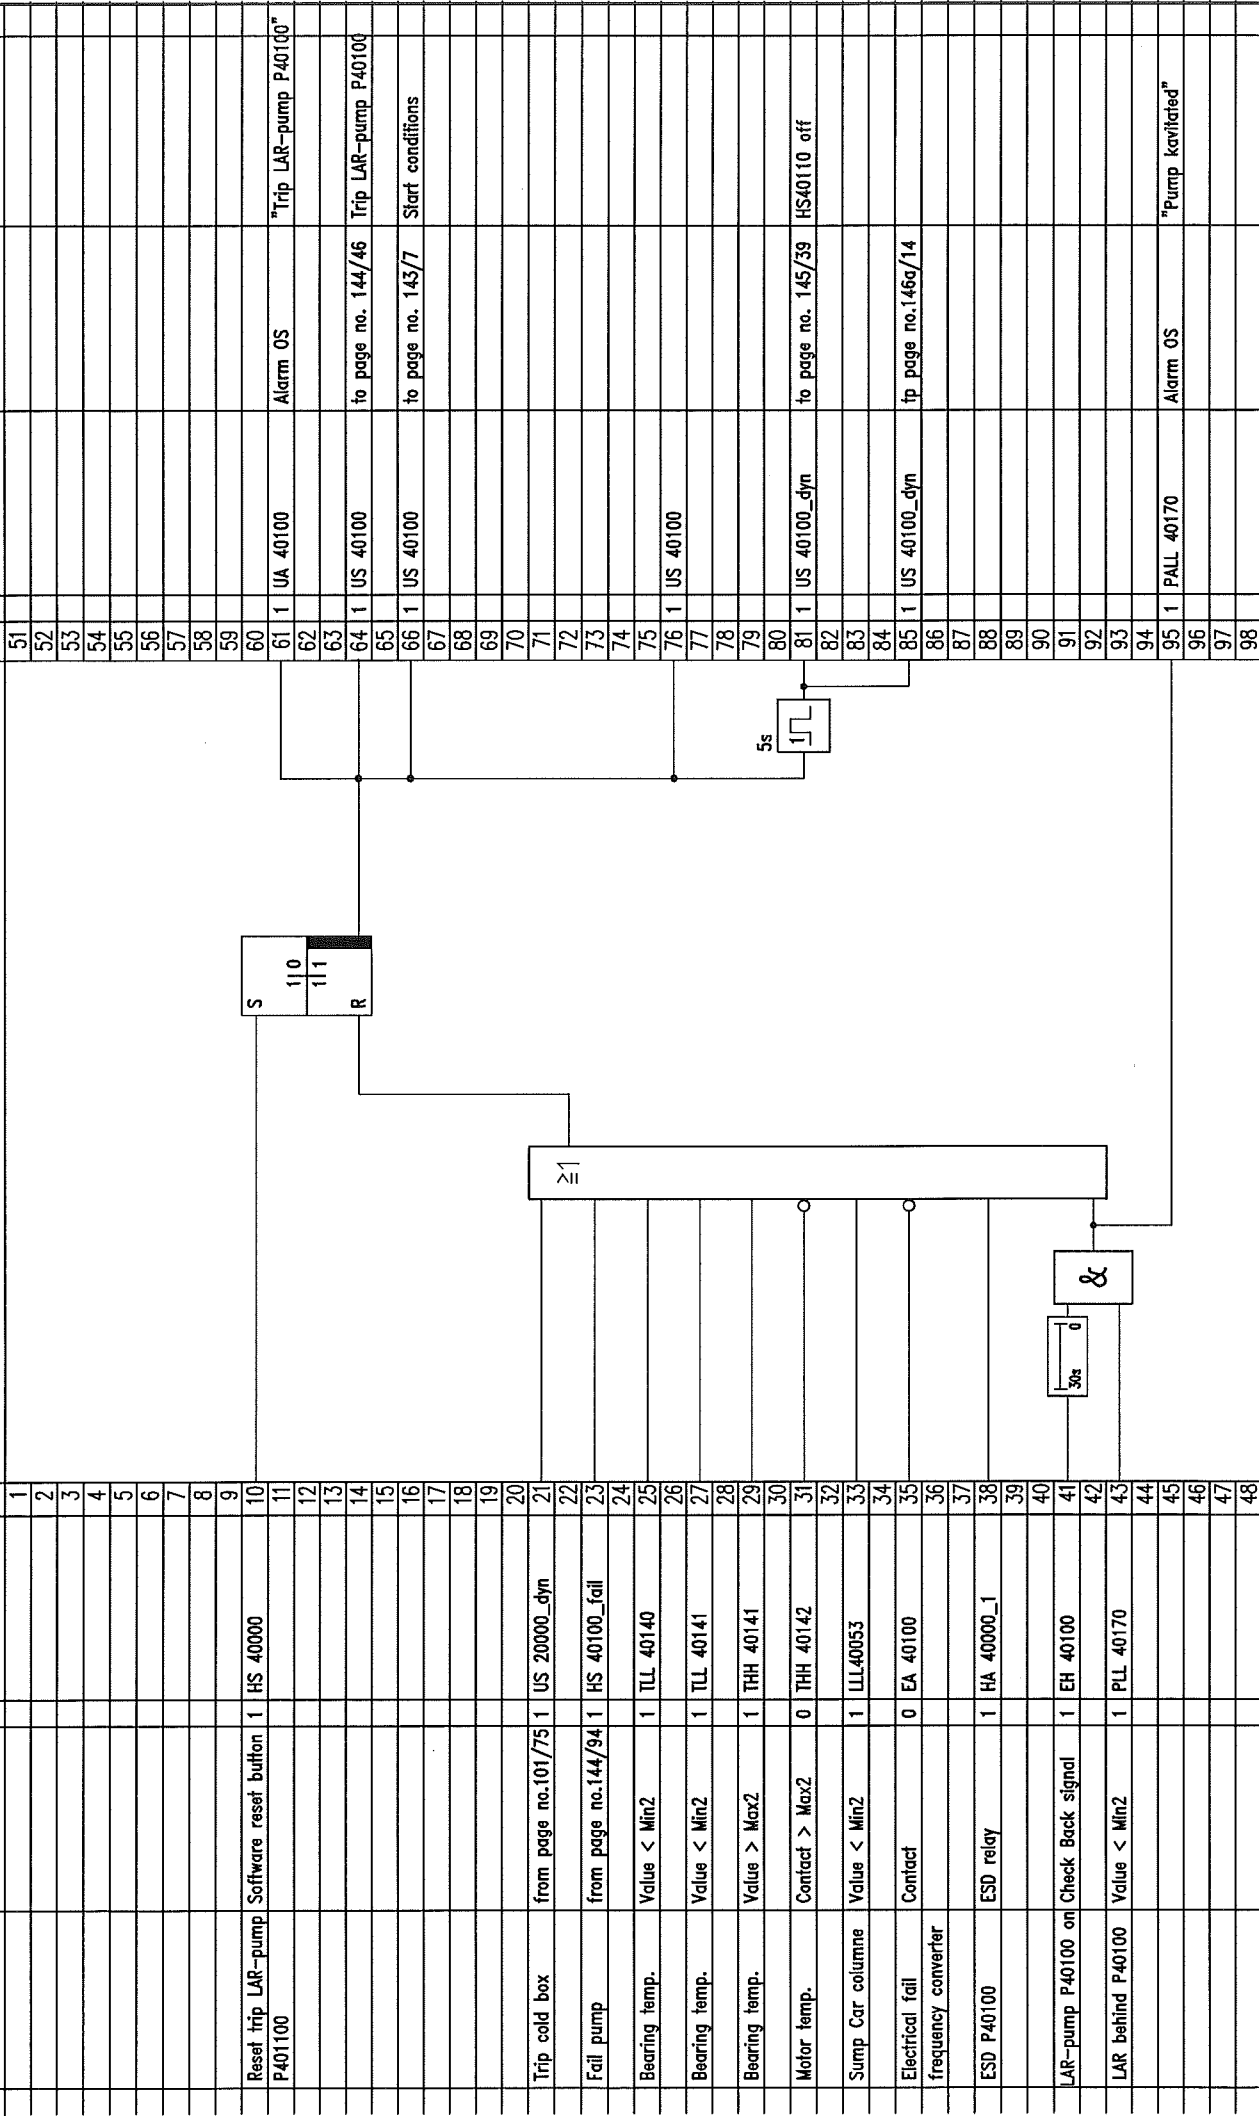[illegible]

Function				FUNKTION			
Comment	Origin	Signal-/TAG-No.	Diagram	Signal-/TAG-No.	Destination	Comment	
Start cool down	Software switch	1 HS 40101					
Trip Lar-pump	from page no.142/66	1 US 40100					
Bearing temp.	Value < Min1	1 TL 40140					
Bearing temp.	Value < Min1	1 TL 40141					
Bearing temp.	Value > Max1	1 TH 40141					
PV 40170 open	Y > 50%	1 UY 40170_50					
HV 40110 closed	from page no.145/69	0 HS 40110					
Cool down pump	Value < Min	1 TL 40130					
Lar-pump on	Check back signal	1 EH 40100					
Start pump	Software push button	1 HS 40101_S					
Level sump Car col.1	Value < Min	1 LL40053					

№	Signal	Destination	Comment
51			
52			
53			
54			
55			
56			
57	1 UL 40100	to page no.144/26	Lar-pump off from seq.
58			
59			
60			
61	1 TAH 40130	Alarm OS	"Cool down seq. fault"
62			
63			
79	1 UH 40110	to page no. 145/27	Open HV 40110
80			
81			
82			
83			
84			
85	1 LIC 40053_Y60	to page no. 146/14	
86			
87			
88			
89			
90	1 UOH 40101	Monitoring OS	"Lar-Pump ready to start"
91			
92	1 US 40101	to page no. 144/18	Ready to start
93			
94			
95	1 UH 40100	to page no. 144/20	Lar-pump on from sequence
96			
97			
98			

ASU KOSICE

Rev3 08.6.07 "as built"

Rev2 02.2.06

Rev1 01.1.06

ARGON

PLANT PART

FROM: Frohn

BY: Frohn

DATE: 01.1.06

REVISIONS

PROJECT NAME

ASU KOSICE

DRAWING NAME

ARGON PUMP P40100

START SEQUENCE US40101

DATE

17.06.2005

AUTHOR

Frohn

CHECK

Eichler

STD.

FUNKTION DIAGRAM

SIZE

A3

DRWG. NO.

K70101_143.dwg

PRJ. NO.

K70101

REPLACES

REPLACED BY:

Page no. 143

Df

230 Pages

BASED

DATE

17.06.2005

AUTHOR

Frohn

CHECK

Eichler

STD.

[illegible]

Function					Page	Signal-/TAG-No.	Type	Signal-/TAG-No.	Destination	Comment
LIC 40053					51					
PIC 40170					52					
MAX					53					
PI - controller					54					
PI - controller					55					
0%					56					
5s					57					
32%					58					
≥1					59					
35%					60					
85%					61					
to page no.146a/10					62					
to page no.146a/25					63					
Ext. setpoint					64					
					65					
					66					
					67					
Sump CAr-column 1 DP-transmitter					51					
LIC 40053					52					
PIC 40170					53					
MAX					54					
PI - controller					55					
PI - controller					56					
0%					57					
5s					58					
32%					59					
≥1					60					
35%					61					
85%					62					
to page no.146a/10					63					
to page no.146a/25					64					
Ext. setpoint					65					
					66					
					67					
					68					
Discharge CLOX pump Pressure transmitter					51					
PIC 40170					52					
MAX					53					
PI - controller					54					
PI - controller					55					
0%					56					
5s					57					
32%					58					
≥1					59					
35%					60					
85%					61					
to page no.146a/10					62					
to page no.146a/25					63					
Ext. setpoint					64					
					65					
					66					
					67					
LAR-pump i. operation from page no.143/85					51					
PIC 40170_A					52					
					53					
					54					
					55					
					56					
					57					
					58					

Function									
Comment	Origin	Type	Signal-/TAG-No.	Pos	Pos	Type	Signal-/TAG-No.	Destination	Comment
				1					
				2					
				3					
				4					
				5					
				6					
				7					
				8					
				9					
Bypass Lar-pump	from page no.146/70	E	UY40170_OUT	10					
				11					
				12					
				13					
Trip LAr-pump	from page no.142/85	1	US40100_dyn	14					
				15					
				16					
				17					
				18					
				19					
				20					
				21					
				22					
				23					
				24					
Ext. Setpoint	from page no.146/72	E	UY40170H_OUT	25					
				26					
				27					
				28					
Manual control station

Y Start value

Y Start value switch on

Manual

Automatic

Output signal Y

Status manual

Status Automatic

Y Start value

Y Start value switch on

Manual

Automatic

Output signal Y

Status manual

Status Automatic

Y Start value

Y Start value switch on

DATE 17.06.2005		AUTHOR Frohn		CHECK Eichler		STD.		Page no. 146		Of 230 Pages	
SIZE A3		FUNKTION DIAGRAM		DRAWG. NO.		PROJ. NO.		K70101		REPLACES	
REPLACES		REPLACED BY:		BASED:							

[illegible]

Function										Range
Range	Comment	Origin	Type	Signal-/TAG-No.	Pin	Pin	Type	Signal-/TAG-No.	Destination	Comment
					1	51				
					2	52				
					3	53				
					4	54				
					5	55				
					6	56				
					7	57				
					8	58				
					9	59				
					10	60				
	Reset trip LAR-prod.	Software reset button	1	HS 43023		61	1	UA 43023	Alarm OS	"Trip LAR-product"
					11	62				
					12	63				
					13	64	1	US 43023		Trip LAR-product
					14	65				
					15	66				
					16	67				
					17	68	1	US 43023	to page no. 149/15	Level pure Ar-column LIC 43023
					18	69				Contr. Manual/Y=0%
					19	70				
					20	71				
	Trip pure Ar-column	from page no.147/64	1	US 43000		72	0	US 43023	Solenoid valve UV 43023	
					21	73				
	ppmN2 in LAR-prod.	Value > Max2	1	QHH 43034_2		74				
	analyzer				22	75	1	US 43023	to page no. 184/22	TIC90008 on "Auto"
					23	76				Steam to dump vap.
					24	77	1	US 43023	to page no. 232/20	Open HV 90015
					25	78				
	ppmO2 in crude-Ar	Value > Max2	1	QHH 40012		79				
	column analyzer				26	80				
					27	81				
					28	82				
	ppmO2 in pure-Ar	Value > Max2	1	QHH 43033		83				
	column analyzer				29	84				
					30	85				
					31	86				
					32	87				
					33	88	1	US 43023_dyn1	to page no. 149/35	LAR-product to dump LIC 43033
					34	89				Contr. on Automatic
	Level B44101	Value > Max2	1	LHH 44105		90				
	Pressure B44101	Value > Max2	1	PHH 44105		91				
	Overflow B44101	Value < Min	1	TL 44104		92				
					35	93				
					36	94				
					37	95				
					38	96				
					39	97				
	Level B44201	Value > Max2	1	LHH 44205		98				
	Pressure B44201	Value > Max2	1	PHH 44205						
	Overflow B44201	Value < Min	1	TL 44204						
	Trip LP-LAR-Tank	ESD-Relay	1	UA 44010						
					40					
					41					
					42					
					43					
					44					
					45					
					46					
					47					
					48					

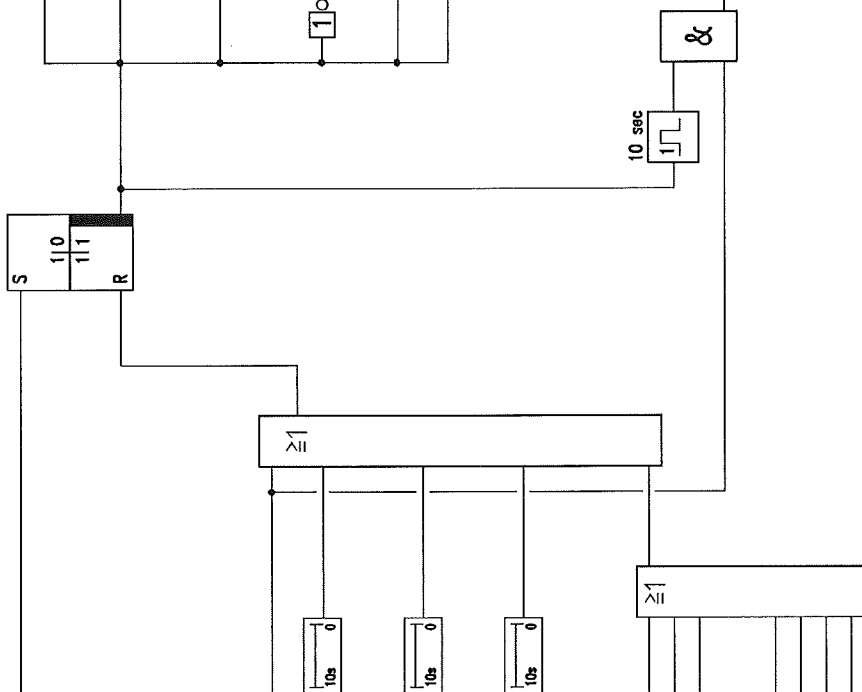

PROJECT NAME		DRAWING NAME		SIZE A3		FUNKTION DIAGRAM		DATE 17.06.2005	
ASU KOSICE		PURE ARGON COLUMN		DRWG. NO.		K70101_148.dwg		AUTHOR From	
ARGON		TRIP LAR PRODUCT US43023		PROJ. NO.		K70101		CHECK Eicher	
Rev3 08.6.07 "as built"		Rev2 02.2.06		REPLACES		Page no. 148		STD.	
Rev1 08.6.07 "as built"		Rev0 02.2.06		REPLACES		Page no. 148		Page no. 148	
Rev0 02.2.06		Rev0 02.2.06		REPLACES		Page no. 148		Page no. 148	
Rev0 02.2.06		Rev0 02.2.06		REPLACES		Page no. 148		Page no. 148	
Range	Comment	Origin	Type	Signal-/TAG-No.	Ref.	Function										Type	Signal-/TAG-No.	Destination	Comment	Range		
					1	<div>LIC 43023</div> <div><div>PI - Controller</div><div><div>X Input signal</div><div>W ext. Setpoint</div><div>W ext. on</div><div>Y Start value</div><div>Y Start value switch on</div><div>Manual on</div><div>Automatic on</div></div><div><div>Control output Y</div><div>PI algorithm</div><div>Control deviation</div><div>Internal setpoint</div><div>Manual mode</div><div>Automatic mode</div><div>Slave mode</div></div></div> <div><div>0%</div><div><div>≥1</div></div></div> <div>LIC 43033</div> <div><div>PI - Controller</div><div><div>X Input signal</div><div>W ext. Setpoint</div><div>W ext. on</div><div>Y Start value</div><div>Y Start value switch on</div><div>Manual on</div><div>Automatic on</div></div><div><div>Control output Y</div><div>PI algorithm</div><div>Control deviation</div><div>Manual mode</div><div>Automatic mode</div><div>Slave mode</div></div></div> <div><div>0%</div><div><div>≥1</div></div></div>																
					2																	
					3																	
					4																	
					5																	
					6																	
					7																	
					8																	
	Sump pure-Ar col.	PD-Transmitter	E L 43023		9																	
		0-100%			10																	
					11																	
					12																	
					13																	
					14																	
	Trip LAR-product	from page no.148/68	1 US 43023		15																	
					16																	
	Trip PAR-column	from page no.147/74	1 US 43000_dyn		17																	
					18																	
					19																	
					20																	
	Trip PAR-column	from page no.147/72	1 US 43000_dyn		34																	
	Trip LAR-product	from page no.148/88	1 US 43023_dyn1		35																	
					36																	
					37																	
					38																	
					39																	
					40																	
					41																	
					42																	
					43																	
					44																	
					45																	
					46																	
					47																	
					48																	

Function									
Comment	Origin	Type	Signal-/TAG-No.	≡	≡	≡	≡	≡	≡
				1	51				
				2	52				
				3	53				
				48	98				
				DRAWING NAME:		SIZE A3		FUNKTION DIAGRAM	
				PROJECT NAME		DATE 17.05.2005		AUTHOR Frohn	
				PLANT		CHECK		Eichler	
				PART		STD.			
				Rev3 08.6.07 as built		DRWG. NO.		K70101_150.dwg	
				Rev2 02.2.06		PROJ. NO.		K70101	
				Rev1		REPLACES:		REPLACED BY:	
				DATE		BASED:			
				FILE NO.		Page no. 150		230 Pages	

Rang.	Comment	Origin	Type	Signal-/TAG-No.	Function	Type	Signal-/TAG-No.	Destination	Comment	Rang.
						51				
						52				
						53				
						54				
						55				
						56				
						57				
						58				
						59				
						60				
	Reset trip LOX-pump P61100	Software reset button	1	HS 61100_Res		61	1 UA 61100	Alarm OS	"Trip LOX-pump P61100"	
						62				
						63				
	Trip cold box	from page no.101/79	1	US 20000_dyn		64	1 US 61100	to page no. 155/40	Trip LOX-pump P61100	
						65				
	GOX temp. trip	Contact ESD relay	1	UA 20027		66	1 US 61100	to page no. 152/7	Start conditions	
						67				
						68	1 US 61100	to page no. 105/24	GOX-trip	
						69				
	GOX temp. trip	from page no.105/94	1	US 20027_dyn		70	1 US 61100	to page no. 120/33	LOX-trip	
						71				
						72				
	Fail pump	from page no.154/78	1	HS 61100_fail		73				
						74				
	Bearing temp.	Value < Min2	1	TLL 61140		75				
						76	1 US 61100_dyn	to page no. 155/39	HS61110 off	
	Bearing temp.	Value < Min2	1	TLL 61141		77				
						78				
	Bearing temp.	Value > Max2	1	THH 61141		79				
						80				
	ESD P61100/P61200	Contact ESD-Relay	0	HA61000_1		81				
						82				
	LP columnne sump	Value < Min2	1	LLL 22001		83				
						84				
	Electrical fail frequency converter	Contact	0	EA 61100		85				
						86				
						87				
						88				
						89				
						90				
						91				
	LOX-pump P61100 on	Check back signal	1	EH 61100		92				
						93				
	LOX behind P61100	Value < Min2	1	PLL 61170		94				
						95	1 FALL 61170	Alarm OS	"Pump kavitated"	
						96				
						97				
						98				

Function

PROJECT NAME
ASU KOSICE

PLANT
LOX-PUMPS

DATE
17.06.2005

Author
Frohn

Check
Eichler

Size
A3

Function Diagram
K70101_J51.dwg

Page no.
151

Page no.
230


Page no.
230

Function					Signal-/TAG-No.	Destination	Comment
Comment	Origin	Type	Signal-/TAG-No.	Id	Id		
				1			
				2			
				3			
				4			
Start cool down pump	Software switch	1	HS 61101S	5			
Lock LOX-pump	from page no.154/94	1	HS61100_IL	6			
Trip LOX-pump	from page no.151/66	1	US 61100	7			
				8			
LOX-pump on	Check back signal	1	EH 61100	9			
				10			
Bearing temp.	Value < Min1	1	TL 61140	11			
Bearing temp.	Value < Min1	1	TL 61141	12			
Bearing temp.	Value > Max1	1	TH 61141	13			
				14			
Bearing temp.	Value > Max1	1	TH 61141	15			
				16			
PV 61170 open	Y > 50%	1	P 61170_Y50	17			
				18			
HV 61110 closed	from page no.155/69	0	HS 61110	19			
				20			
Cool down pump	Value < Min	1	TL 61130	21			
				22			
				23			
				24			
LOX-pump on	Check back signal	1	EH 61100	36			
				37			
				38			
				39			
				40			
				41			
				42			
				43			
				44			
				45			
				46			
Start pump	Software push button	1	HS 61101_S1	47			
				48			

51							
52							
53							
54							
55							
56							
57	1	UL	61100_A			to page no.154/26	LOX-pump off from seq.
58							
59							
60							
61	1	TAH	61130			Alarm OS	*Cool down seq. fault*
62							
63							
64							
65							
66							
67							
68							
69							
70							
71							
72							
73	1	US	61103_A			to page no. 153/14	Start valve HH61103
74							
75							
76							
77							
78							
79	1	UH	61110			to page no. 155/27	Open HV 61110
80							
81							
82							
83							
84							
85	1	P	61170_A			to page no. 156/14	
86							
87							
88							
89	1	UOH	61101			Monitoring OS	*LOX-Pump ready to start*
90							
91							
92	1	US	61101			to page no. 154/18	Ready to start
93							
94							
95	1	UH	61100_A			to page no. 154/20	LOX-pump on from sequence
96							
97							
98							

DATE 17.06.2005		AUTHOR From		CHECK Echter	
SIZE A3		FUNKTION DIAGRAM		REPLACES:	
DRAWG. NO.		K70101_152.dwg		Page no. 152	
PROJ. NO.		K70101		Of 230 Pages	
REPLACES:		REPLACED BY:		BASED:	

Function				Signal-/TAG-No.	Destination	Comment
Comment	Origin	Type	Signal-/TAG-No.	Ref	Size	Diagram
				51		
				52		
				53		
				54		
				55		
				56		
				57		
				58		
				59		
				60		
				61		
				62		
				63		
Start sequence	from page no.152/73	1	US 61103_A	64	1 HS 61103	Solenoid valve
				65		Open start ball valve
				66		HH 61103
				67		
				68		
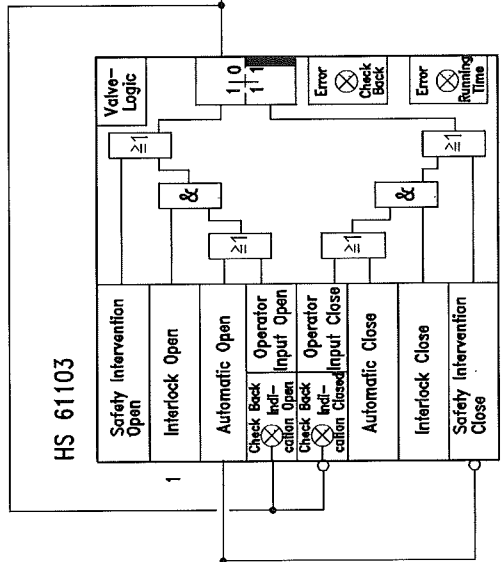

DATE 17.06.2005		AUTHOR Frohn		CHECK Eichler	
SIZE A3		FUNKTION DIAGRAM		K70101_153.dwg	
DRAWG. NO.		PROJ. NO.		REPLACES:	
K70101		K70101		REPLACED BY:	
Page no. 153		Page no. 153		Page no. 153	
TIF 230 Pages		TIF 230 Pages		TIF 230 Pages	
BASED:		BASED:		BASED:	


PROJECT NAME		ASU KOSICE		LOX-PUMPEN	
DRAWING NAME		LOX PUMP P61100		START BALL VALVE HS61103	
AIR LIQUIDE		Air Liquide AGS GmbH		Füßingweg 34	
		47805 Krefeld			

Rev3 08.6.07 as built		Frohn		Sipac	
Rev2 02.2.06		Frohn		Eichler	
JOB NO. FILE NO.		DATE		REVISED BY	

Function					Signal-/TAG-No.	Destination	Comment
Comment	Origin	Type	Signal-/TAG-No.	Ref.	Type		
				1			
				2			
				3			
Ready to start	from page no.152/92	1	US 61101	19			
Pump on from seq.	from page no.152/95	1	UH 61100_A	20			
LOX-pump on	Check back signal	1	EH 61100	21			
				22			
				23			
				24			
				25			
Pump off from seq.	from page no.152/97	1	UL 61100_A	26			
				27			
				28			
				29			
Trip LOX-Pump	from page no.151/64	1	US 61100	30			
				31			
				32			
				33			
				34			
				35			
				36			
				37			
				38			
				39			
Reset trip LOX-pump	Software button	1	HS61100_RES	40			
				41			
				42			
				43			
FreqC M61100 fault	Contact	0	EA 61100	44			
				45			
				46			
				47			
				48			
				51			
				52			
				53			
				54			
				55			
				56			
				57			
				58	1	HS 61100	Signal to MCC
				59			
				60			
				61			
				62			
				63			
				64			
				65			
				66			
				67			
				68			
				69			
				70	1	HS 61100	
				71			
				72			
				73			
				74			
				75			
				76	1	HS 61100_CB	Alarm OS
				77			
				78	1	HS 61100_fail	to page no. 151/23 LOX-pump fail
				79			
				80	1	HS 61100_RT	Alarm OS
				81			
				82			
				94	1	HS61100_IL	to page no. 152/6 Lock LOX-pump
				95			
				96			
				97			
				98			
<div> <div>PROJECT NAME</div> <div>ASU KOSICE</div> </div> <div> <div>DRAWING NAME</div> <div>LOX PUMP P61100</div> </div> <div> <div>PLANT PART</div> <div>LOX-PUMPS</div> </div> <div> <div>DATE</div> <div>17.06.2005</div> </div> <div> <div>AUTHOR</div> <div>Frohn</div> </div> <div> <div>CHECK</div> <div>Eichler</div> </div> <div> <div>SIZE</div> <div>A3</div> </div> <div> <div>FUNKTION DIAGRAM</div> </div> <div> <div>DRWG. NO.</div> <div>K70101_154.dwg</div> </div> <div> <div>PROJ. NO.</div> <div>K70101</div> </div> <div> <div>REPLACES</div> <div>REPLACED BY:</div> </div> <div> <div>Page no. 154</div> <div>Of 230 Pages</div> </div> <div> <div>BASED</div> </div>							

Function

Comment	Origin	Signal-/TAG-No.	Pin	Pin	Signal-/TAG-No.	Destination	Comment
			1	51			
			2	52			
			3	53			
			4	54			
			5	55			
			6	56			
			7	57			
			8	58			
			9	59			
			10	60			
			11	61			
			12	62			
			13	63			
			14	64			
			15	65			
			16	66			
			17	67			
			18	68			
			19	69	US 61110	to page no. 151/19	Start conditions
			20	70			
			21	71			
			22	72			
			23	73			
			24	74			
			25	75			
			26	76			
			27	77	US 61110	Solenoid valve	Open valve HV61110 LOX from K22001
			28	78			
			29	79			
			30	80			
			31	81			
			32	82			
			33	83			
			34	84			
			35	85			
			36	86			
			37	87			
			38	88			
			39	89			
			40	90			
			41	91			
			42	92			
			43	93			
			44	94			
			45	95			
			46	96			
			47	97			
			48	98			

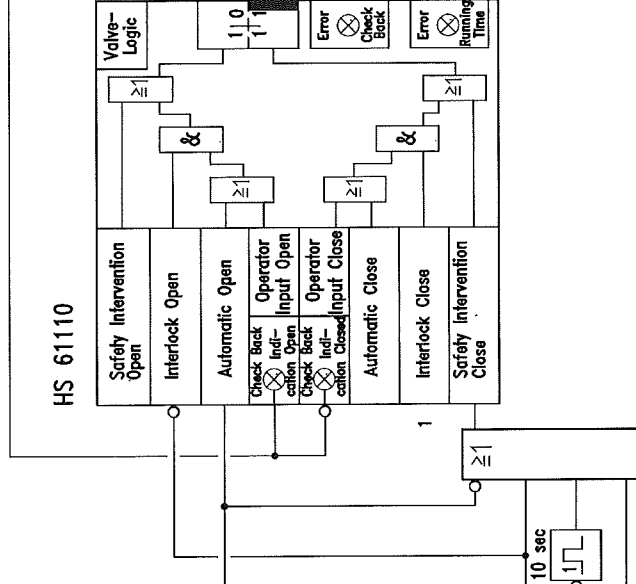


PROJECT NAME		DRAWING NAME		DATE	
ASU KOSICE		LOX PUMP P61100		17.06.2005	
LOX-PUMPS		LOX FROM LP-COLUMN		FUNKTION DIAGRAM	
PLANT		HS 61110		SIZE A3	
Rev3 08.6.07 as built		Air Liquide AGS GmbH		DRWG. NO.	
Rev2 02.2.06		Füllungsweg 34		PROJ. NO.	
Rev1 02.2.06		47805 Krefeld		REPLACES	
JOB NO FILE NO		DATE		REPLACED BY	
NO		REV		BY	
CHKD.		CHKD.		CHKD.	
PAGE NO. 155		PAGE NO. 155		PAGE NO. 155	
OF 230		OF 230		OF 230	
BASED		BASED		BASED	

[illegible]


SIZE	A3	FUNKTION DIAGRAM	DATE	17.06.2005
DRWG. NO.			AUTHOR	From
PROJ. NO.			CHECK	Eichler
REPLACES:			STD.	
REPLACED BY:		K70101_156.dwg	Page no.	156
			OF	230 Pages
		K70101	BASED:	

Function				Signal-/TAG-No.	Destination	Comment
Comment	Origin	Tag	Signal-/TAG-No.	Tag		
Bearing temp. P61100 PH100		E	T61141_I	51		
				52		
				53		
				54		
Limit value	Constant	E	20.0°C	55		
				56		
				57		
				58		
				59		
				60		
Limit value	Constant	E	0.0°C	61		
				62		
				63		
				64		
				65		
				66		
				67		
				68		
				69		
				70	1 US 61110	Signal to MCC
				71		Heating M61110 on
Heating on	Check back signal	1	EH 61110	72		
				73		
				74		
				75		
				94	1 US 61110_FRTEP	Alarm OS
				95		Heating fail
				96		
				97		
				98		

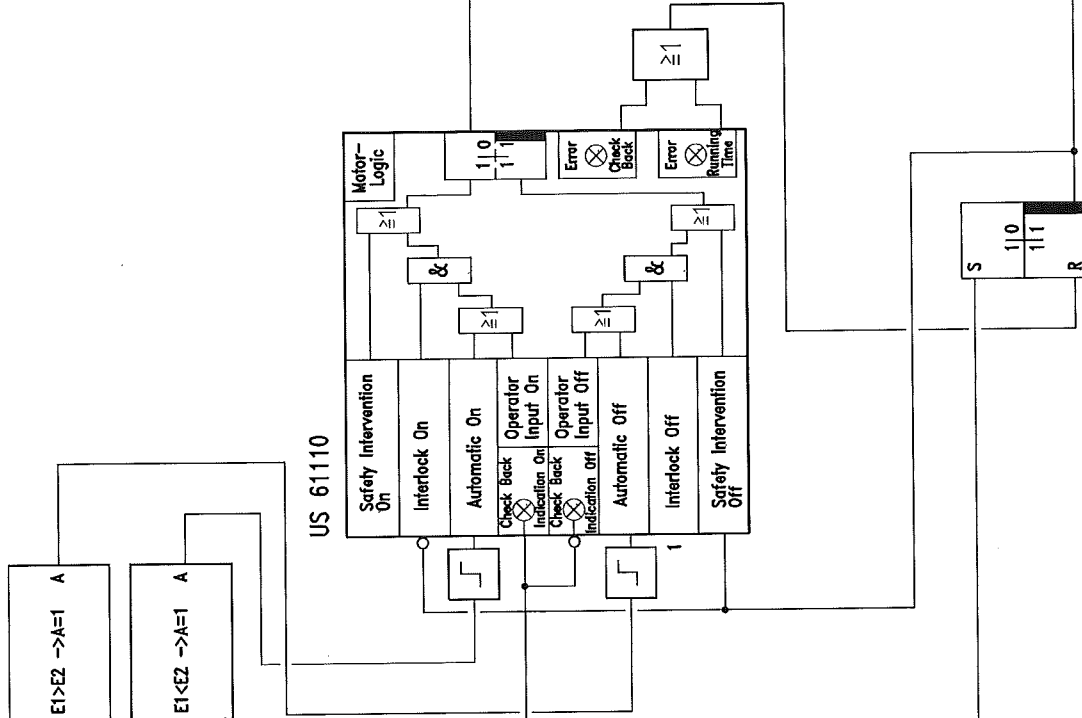

--	--	
Range	Comment	Origin	Type	Signal-/TAG-No.	Signal-/TAG-No.	Destination	Comment	Range
1								51
2								52
3								53
4								54
5								55
6								56
7								57
8								58
9								59
10	Reset trip LOX-pump P61200	Software reset button	1	HS 61200_Res	UA 61200	Alarm OS	"Trip LOX-pump P61200"	60
11								61
12								62
13								63
14	Trip cold box	from page no.101/83	1	US 20000_dyn	US 61200	to page no. 161/40	Trip LOX-pump P61200	64
15								65
16	GOX temp. trip	Contact ESD relay	1	UA 20027	US 61200	to page no. 159/7	Start conditions	66
17								67
18								68
19								69
20	GOX temp. trip	from page no.105/97		US 20027_dyn	US 61200	to page no. 120/35	LOX-trip	70
21								71
22								72
23	Fail pump	from page no.161/78	1	HS 61200_fail				73
24								74
25	Bearing temp.	Value < Min2	1	TLL 61240				75
26								76
27	Bearing temp.	Value < Min2	1	TLL 61241	US 61200_dyn	to page no. 162/39	HS61210 off	77
28								78
29	Bearing temp.	Value > Max2	1	THH 61241				79
30								80
31	ESD P61100/P61200	Contact	0	HA 61000_1				81
32								82
33	LP columnne sump	Value < Min2	1	LLL22000				83
34								84
35	Electrical fail frequency converter	Contact	0	EA 61200				85
36								86
37								87
38								88
39								89
40								90
41	LOX-pump P61200 on Check back signal		1	EH 61200				91
42								92
43	LOX behind P61200	Value < Min2	1	PLL 61270	PALL 61270	Alarm OS	"Pump kavitated"	93
44								94
45								95
46								96
47								97
48								98

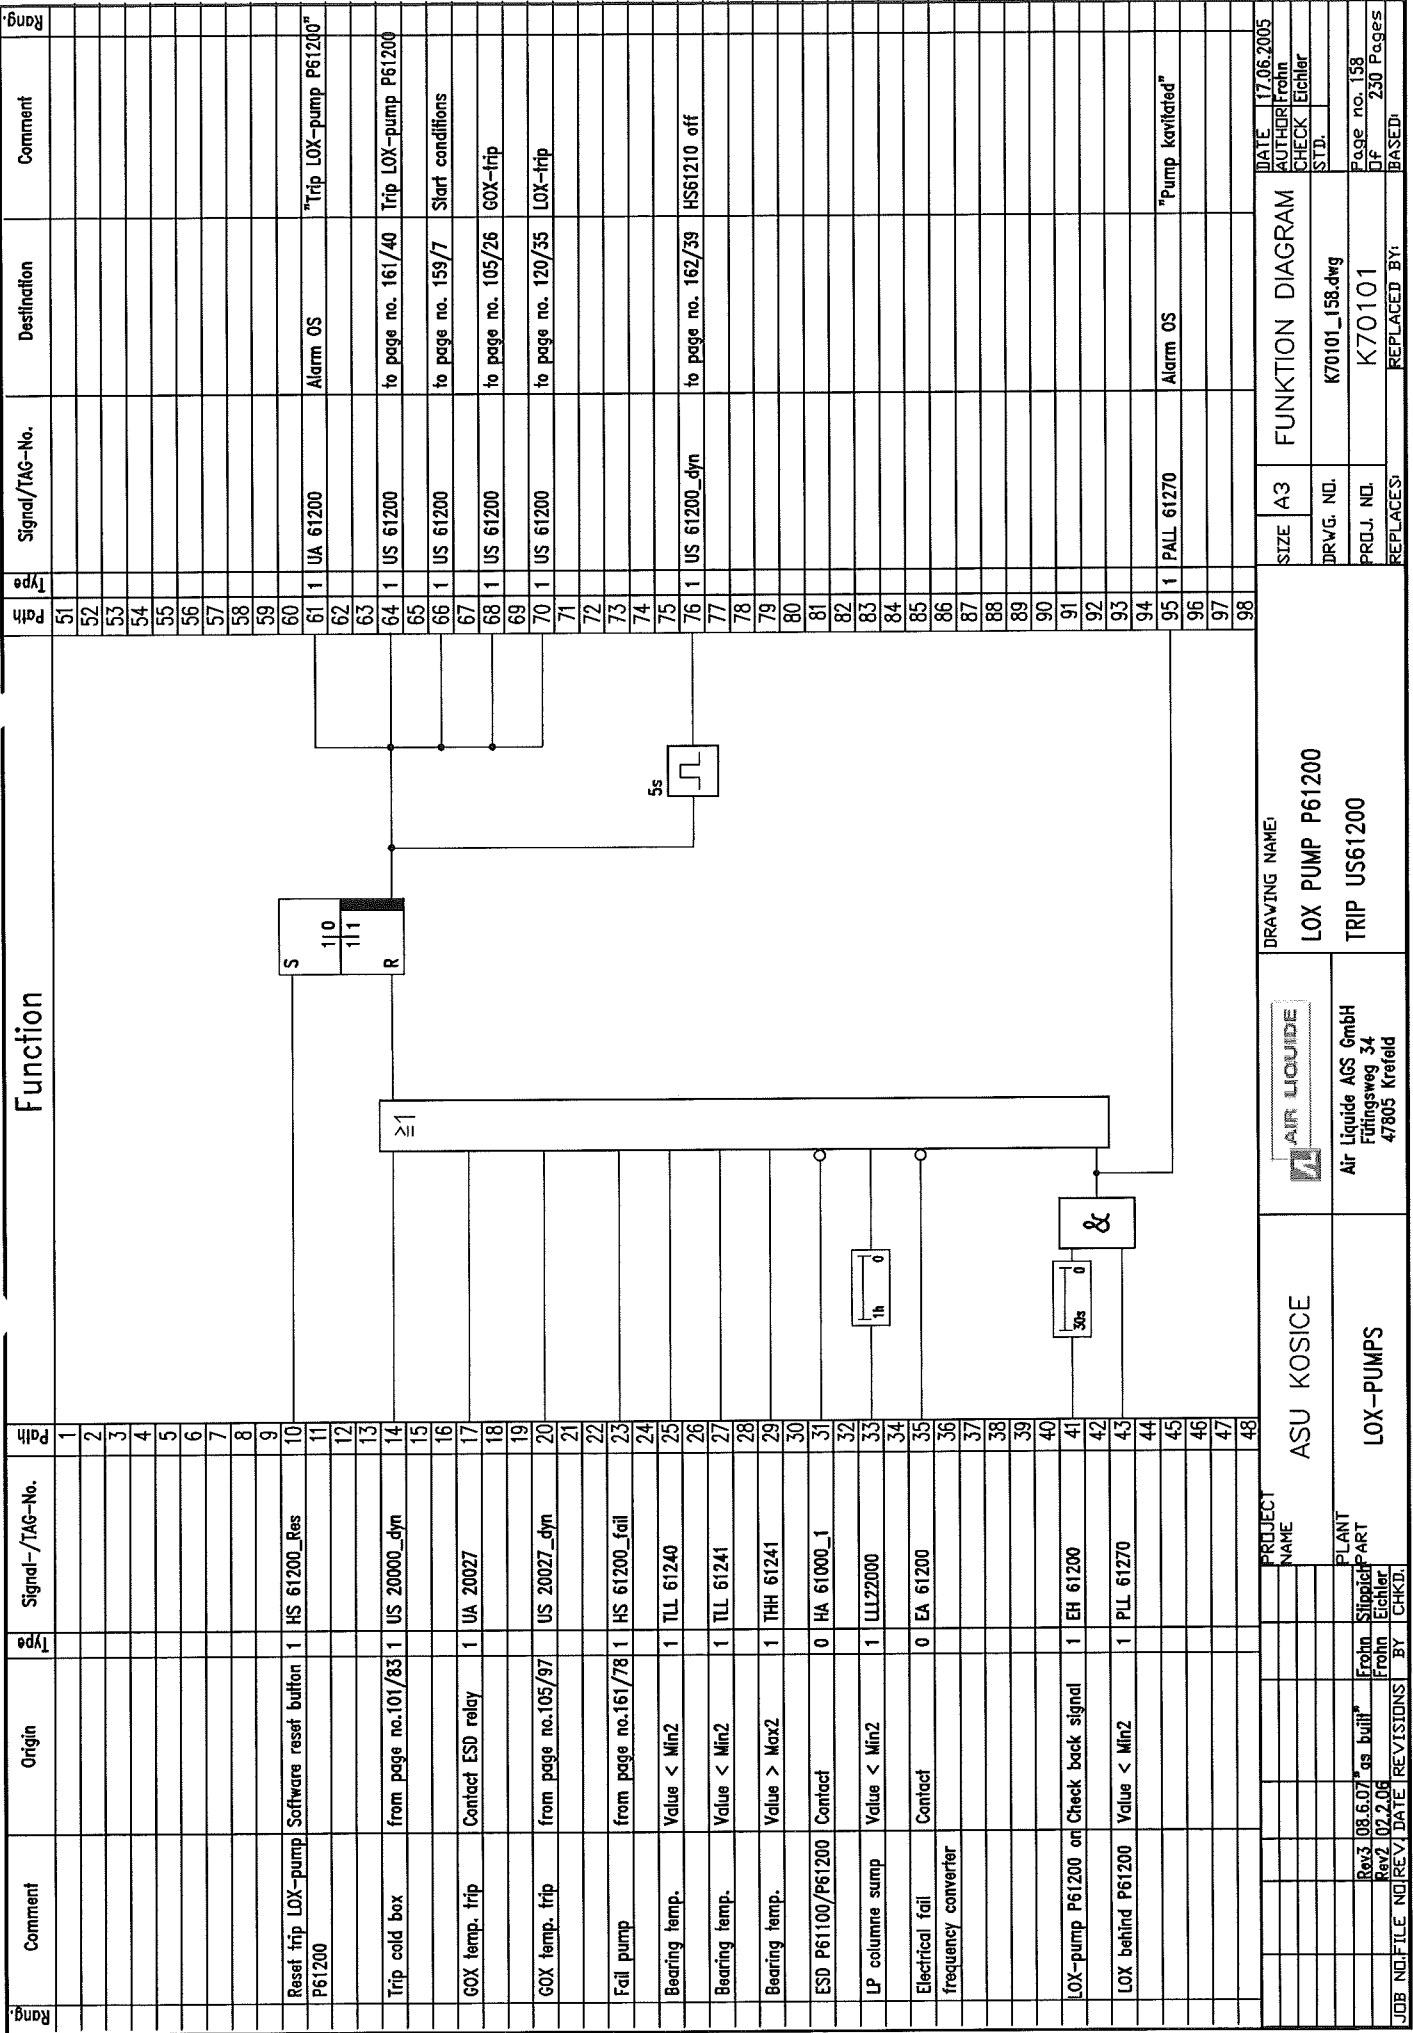

Range	Comment	Origin	Type	Signal-/TAG-No.	Signal-/TAG-No.	Destination	Comment	Range
1								51
2								52
3								53
4								54
5								55
6								56
7								57
8								58
9								59
10	Reset trip LOX-pump P61200	Software reset button	1	HS 61200_Res	UA 61200	Alarm OS	"Trip LOX-pump P61200"	60
11								61
12								62
13								63
14	Trip cold box	from page no.101/83	1	US 20000_dyn	US 61200	to page no. 161/40	Trip LOX-pump P61200	64
15								65
16	GOX temp. trip	Contact ESD relay	1	UA 20027	US 61200	to page no. 159/7	Start conditions	66
17								67
18								68
19								69
20	GOX temp. trip	from page no.105/97		US 20027_dyn	US 61200	to page no. 120/35	LOX-trip	70
21								71
22								72
23	Fail pump	from page no.161/78	1	HS 61200_fail				73
24								74
25	Bearing temp.	Value < Min2	1	TLL 61240				75
26								76
27	Bearing temp.	Value < Min2	1	TLL 61241	US 61200_dyn	to page no. 162/39	HS61210 off	77
28								78
29	Bearing temp.	Value > Max2	1	THH 61241				79
30								80
31	ESD P61100/P61200	Contact	0	HA 61000_1				81
32								82
33	LP columnne sump	Value < Min2	1	LLL22000				83
34								84
35	Electrical fail frequency converter	Contact	0	EA 61200				85
36								86
37								87
38								88
39								89
40								90
41	LOX-pump P61200 on Check back signal		1	EH 61200				91
42								92
43	LOX behind P61200	Value < Min2	1	PLL 61270	PALL 61270	Alarm OS	"Pump kavitated"	93
44								94
45								95
46								96
47								97
48								98


Range	Comment	Origin	Type	Signal-/TAG-No.	Signal-/TAG-No.	Destination	Comment	Range
1								51
2								52
3								53
4								54
5								55
6								56
7								57
8								58
9								59
10	Reset trip LOX-pump P61200	Software reset button	1	HS 61200_Res	UA 61200	Alarm OS	"Trip LOX-pump P61200"	60
11								61
12								62
13								6

Function					Page	Signal-/TAG-No.	Destination	Comment
					51			
					52			
					53			
					54			
					55			
					56			
					57	1 UL 61200_A	to page no.161/36	LOX-pump off from seq.
					58			
					59			
					60			
					61	1 TAH 61230	Alarm OS	*Cool down seq. fault*
					62			
					63			
					64			
					65			
					66			
					67			
					68			
					69			
					70			
					71			
					72			
					73	1 US 61203_A	to page no. 160/14	Start valve HH61203
					74			
					75			
					76			
					77			
					78			
					79	1 UH 61210	to page no. 162/27	Open HV 61210
					80			
					81			
					82			
					83			
					84			
					85	1 P 61270_A	to page no. 163/14	
					86			
					87			
					88			
					89			
					90	1 UOH 61201	Monitoring OS	*LOX-Pump ready to start*
					91			
					92	1 US 61201	to page no. 161/28	Ready to start
					93			
					94			
					95	1 UH 61200_A	to page no. 161/30	LOX-pump on from sequence
					96			
					97			
					98			
Function					FUNCTION DIAGRAM			
					SIZE A3 DRAWG. NO. K70101_159.dwg PROJ. NO. K70101 REPLACES:			
LOX PUMP P61200 START SEQUENCE US61201					DATE 17.06.2005 AUTHOR Frohn CHECK Eichler STD.			
ASU KOSICE LOX-PUMPS					Page no. 159 Of 230 Pages BASED:			
PROJECT NAME AIR LIQUIDE					DRAWING NAME LOX PUMP P61200			
PLANT PART					DRAWING NO. K70101_159.dwg			
Rev3 08.6.07 as built Rev2 02.2.06					PROJ. NO. K70101			
JOB NO. FILE NO. REV. DATE REVISIONS BY CHKD.					REPLACES:			
Start cool down pump from page no.161/78					ASU KOSICE			
Lock LOX-pump from page no.158/66					LOX-PUMPS			
Trip LOX-pump					ASU KOSICE			
LOX-pump on Check back signal					LOX-PUMPS			
Bearing temp. Value < Min1					ASU KOSICE			
Bearing temp. Value < Min1					LOX-PUMPS			
Bearing temp. Value > Max1					ASU KOSICE			
PCV 61170 open Y > 50%					LOX-PUMPS			
HV 61210 closed from page no.162/69					ASU KOSICE			
Cool down pump Value < Min					LOX-PUMPS			
					21			
					22			
					23			
Function

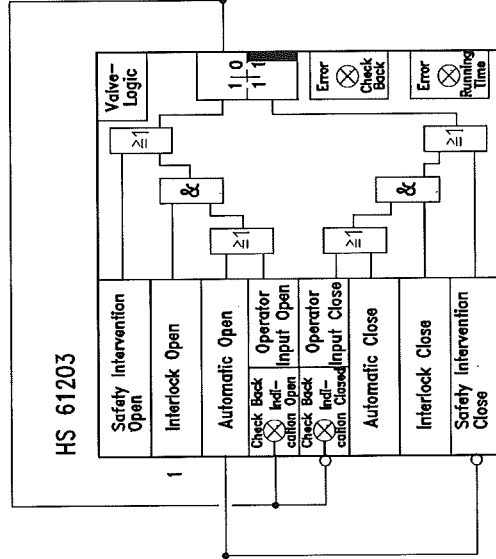[illegible]

[illegible]

Function				Signal-/TAG-No.	Destination	Comment
Comment	Origin	Type	Signal-/TAG-No.	Pa	Size	DATE
				51		17.06.2005
				52		AUTHOR Frohn
				53		CHECK Eichler
				54		STD.
				55		Page no. 163
				56		Of 230 Pages
				57		BASED
				58		
				59		
End pressure LOX-pump P61200	P-transmitter from page no.109/90	E	PT 61270	60		
				61		
				62		
				63		
				77	E PV 61270	Positioner 0-100% = 20-4mA
				78		Control valve
				79		Recycled LOX product PV 61270
				80		
				81		
				82		
				83		
				84		
				85		
				86		
				87		
				88		
				89		
				90		
				91	E HC 61200	Frequency converter Speed control
				92		0-100% = 4-20mA
				93		
				94		
				95		
				96		
				97		
				98		

PI - controller

X process value

W ext. set point

Y Manipulated variable

Y manipulated variable on

Manual on

Automatic on

Output Y

PI-Algorithm.

Control difference

Status Manual

Status Automatic

Status W ext.

5 sec

32%

35%

80%

HIC 61270

Manual control station

Y Start value

Y Start value switch on

Manual

Automatic

Output signal Y

Status manual

Status Automatic

HIC 61200

Manual control station

Y Start value

Y Start value switch on

Manual

Automatic

Output signal Y

Status manual

Status Automatic

PROJECT NAME	ASU KOSICE	DRAWING NAME	LOX PUMP P61200
PLANT	LOX-PUMPS	AIR LIQUIDE	SPEED/PRESSURE CONTROL
Rev3 08.6.07* as built*		Air Liquide AGS GmbH	PIC 61270 / HIC 61200
Rev2 02.2.06		Fulingsweg 34	
Rev1 01.12.05		47805 Krefeld	
NO FILE			
NO REVISIONS			
BY			
CHKD			

Comment	Origin	Signal-/TAG-No.	Function	Signal-/TAG-No.	Destination	Comment
Bearing temp. P61200 P1100		E T61241_J				
Limit value	Constant	E 20.0°C				
Limit value	Constant	E 0.0°C				
Heating on	Check back signal	1 EH 61210				
Reset trip heating	Software button	1 US61210_RES				

Function

Signal-/TAG-No.	Function	Destination	Comment
51			
52			
53			
70	1 US 61210	Signal to MCC	Heating M61210 on
71			
72			
94	1 US 61210_FRTEP	Alarm OS	Heating fail
95			
96			
97			
98			

PROJECT NAME: ASU KOSICE

PLANT: LOX-PUMPS

Rev3 08.6.07 "as built"

Rev2 02.2.06

DRAWING NAME: LOX PUMP P61200 BEARING HEATING M61200 US 61210

AIR LIQUIDE

Air Liquide AGS GmbH
Fällingweg 34
47805 Krefeld

DATE	17.06.2005
AUTHOR	Frohn
CHECK	Eichler
STD.	
DRWG. NO.	K70101_164.dwg
PRJ. NO.	K70101
REPLACES	REPLACED BY:
SIZE	A3
FUNCTION DIAGRAM	

DATE: 17.06.2005

AUTHOR: Frohn

CHECK: Eichler

STD:

DRWG. NO.: K70101_164.dwg

PRJ. NO.: K70101

REPLACES: REPLACED BY:


Page no. 164

OF 230 Pages

BASED:

[illegible]


Function										Page	Comment	Destination	Signal/TAG-No.	Type	Range
										51					
										52					
										53					
										54					
										55					
										56					
										57					
										58					
										59					
										60					
										61	Reset trip LIN-pump P71100	Alarm OS	UA 71100	1	"Trip LIN-pump P71100"
										62					
										63					
										64	Trip cold box	to page no. 168/40	US 71100	1	Trip LIN-pump P71100
										65					
										66	GAN temp. trip	to page no. 169/7	US 71100	1	Start conditions
										67					
										68		to page no. 104/24	US 71100	1	GAN-trip
										69					
										70	GAN temp. trip	to page no. 121/33	US 71100	1	LIN-trip
										71					
										72					
										73					
										74					
										75					
										76	Bearing temp.	to page no. 169/39	US 71100_dyn	1	HS71110 off
										77					
										78					
										95	LIN behind P71100	Alarm OS	PALL 71170	1	"Pump kavitated"
										96					
										97					
										98					
										48					

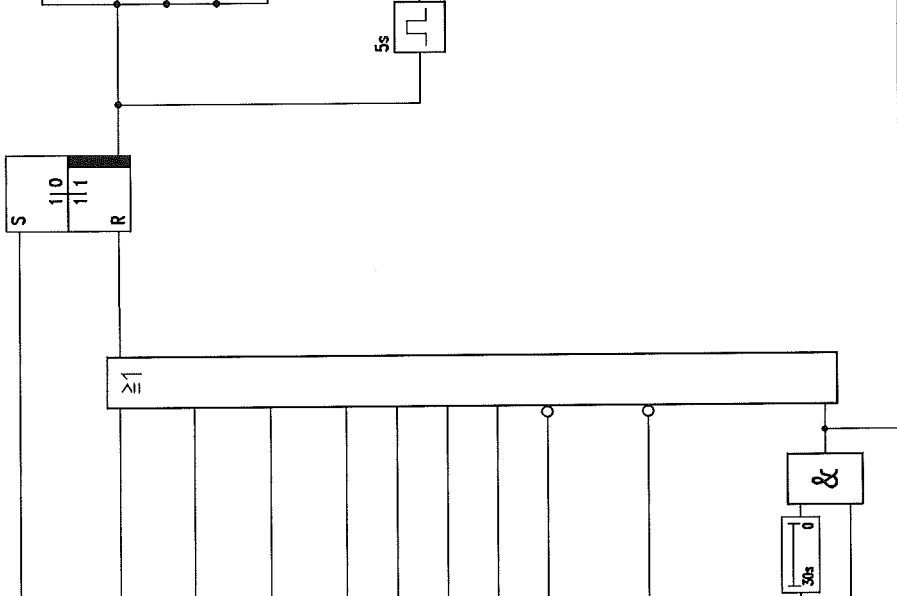

PROJECT NAME				DRAWING NAME			
ASU KOSICE				LIN PUMP P71100			
LIN-PUMPS				TRIP US71100			
AIR LIQUIDE				Air Liquide AGS GmbH			
				Füllingsweg 34			
				47805 Krefeld			
PLANT				Stippich			
Rev2 08.6.07 "as built"				Frohn			
Rev2 02.2.06				Frohn			
NO FILE NO				REV			
DATE				BY			
CHKD.							
SIZE A3				FUNCTION DIAGRAM			
DATE 17.06.2005				AUTHOR Frohn			
				CHECK Eichler			
				STD.			
				K70101_165.dwg			
				Page no. 165			
				K70101			
				230 Pages			
				REPLACES			
				REPLACED BY			

[illegible]

Function					Signal-/TAG-No.	Destination	Comment
Comment	Origin	Type	Signal-/TAG-No.	Ref.	Size	Replaces	DATE
				51			17.06.2005
				52			AUTHOR: Frohn
				53			CHECK: Etchler
				54			STD.
				55			Page no. 167
				56			Of 230 Pages
				57			BASED:
				58			
				59			
				60			
				61			
				62			
				63			
Start sequence	from page no.166/73	1	US 71103_A	64	1	HS 71103	Open start ball valve
				65			HH 71103
				66			
				67			
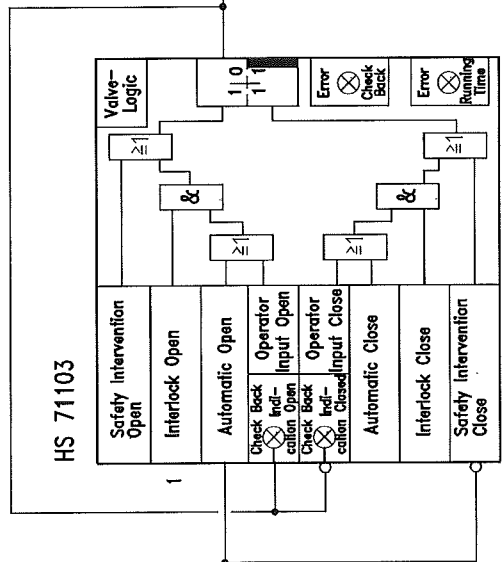

PROJECT NAME		DRAWING NAME		DATE	
ASU KOSICE		LIN PUMP P71100		17.06.2005	
LIN-PUMPS		START BALL VALVE HS71103		AUTHOR: Frohn	
PLANT PART		AIR LIQUIDE		CHECK: Etchler	
Rev3 08.6.07 as built		Air Liquide AGS GmbH		STD.	
Rev2 02.2.06		Füllingsweg 34		DRVG. NO.	
Rev1 02.2.06		47805 Krefeld		PRQJ. NO.	
Rev0 02.2.06				REPLACES:	
Rev0 02.2.06				K70101	
Rev0 02.2.06				REPLACED BY:	
Rev0 02.2.06				K70101	
Rev0 02.2.06				REPLACED BY:	
Rev0 02.2.06					

[illegible]

[illegible]

Function				Function			
Comment	Origin	Signal-/TAG-No.	Ref.	Type	Signal-/TAG-No.	Destination	Comment
			1				
			2				
			3				
			4				
Cascade P20001 to	Software button	1 HS 71140	5				
LIN-pumps			6				
Selector for cascade	Software button	0 HS 71141	7				
	0=P71100		8				
			9				
End pressure LIN-	P-transmitter	E PT 71170	10				
pump P71100	from page no.107/86	E U71140	11				
			12				
			13				
			14				
LIN-pump i. operation	from page no.166/85	1 P71170_A	15				
			16				
			17				
			18				
Ref.	Type	Signal-/TAG-No.	Destination	Comment
51				
52				
53				
77	E	PV 71170	Positioner 0-100% = 20-4mA	Control valve
78				Recycled LIN
79				product PV 71170
80				
81				
82				
83				
84				
85				
86				
87				
88				
89				
90				
91	E	HC 71100	Frequency converter 0-100% = 4-20mA	Speed control
92				
93				
94				
95				
96				
97				
98				

PROJECT NAME: ASU KOSICE

PLANT PART: LIN-PUMPS

Rev3 08.6.07 as built
Rev2 02.2.06

NO FILE NO REV DATE REVISIONS BY CHKD.

DRAWING NAME: LIN PUMP P71100

SPEED/PRESSURE CONTROL

PIC 71170 / HIC 71100

AIR LIQUIDE

Air Liquide AGS GmbH
Fällingsweg 34
47805 Krefeld

DATE: 17.

[illegible]

DRAWING NAME:

LIN PUMP P71100

BEARING HEATING M71100
US 71110

AIR LIQUIDE


Air Liquide AGS GmbH
Fütlingweg 34
47805 Krefeld

ASU KOSICE

LOX-PUMPS

PROJECT NAME	PLANT PART
	From Shipyard
	From Lumber
	From GEYSERS
	Rev3 08.6.01" as built"
	Rev2 02.2.06

Rank	Comment	Origin	Signal-/TAG-No.	Typ	Function	Typ	Signal-/TAG-No.	Destination	Comment	Rank
1						51				
2						52				
3						53				
4						54				
5						55				
6						56				
7						57				
8						58				
9						59				
10	Reset trip LIN-pump	Software reset button	HS 71200_Res	1		60				
11	P71200					61	1 UA 71200	Alarm OS	"Trip LIN-pump P71200"	
12						62				
13						63				
14	Trip cold box	from page no.101/91	US 20000_dyn	1		64	1 US 71200	to page no. 175/40	Trip LIN-pump P71200	
15						65				
16						66	1 US 71200	to page no. 173/7	Start conditions	
17	GAN temp. trip	Contact < Min2	1 UA 20025			67				
18						68	1 US 71200	to page no. 104/26	GAN-trip	
19						69				
20	GAN temp. trip	from page no.104/96	US 20025_dyn	1		70	1 US 71200	to page no 121/35	LIN-trip	
21						71				
22						72				
23	Fail pump	from page no.175/78	HS 71200_fail	1		73				
24						74				
25	Bearing temp.	Value < Min2	1 TLL 71240			75				
26						76	1 US 71200_dyn	to page no. 176/39	HS71210 off	
27	Bearing temp.	Value < Min2	1 TLL 71241			77				
28						78				
29	Bearing temp.	Value > Max2	1 THH 71241			79				
30						80				
31	ESD P71100/P71200	Contact ESD-relay	0 HA 71000_1			81				
32						82				
33						83				
34						84				
35	Electrical fail	Contact	0 EA 71200			85				
36	frequency converter					86				
37						87				
38						88				
39						89				
40						90				
41	LIN-pump P71100 on	Check back signal	1 EH 71200			91				
42						92				
43	LIN behind P71100	Value < Min2	1 PLL 71270			93				
44						94				
45						95	1 PALL 71270	Alarm OS	"Pump kavitated"	
46						96				
47						97				
48						98				

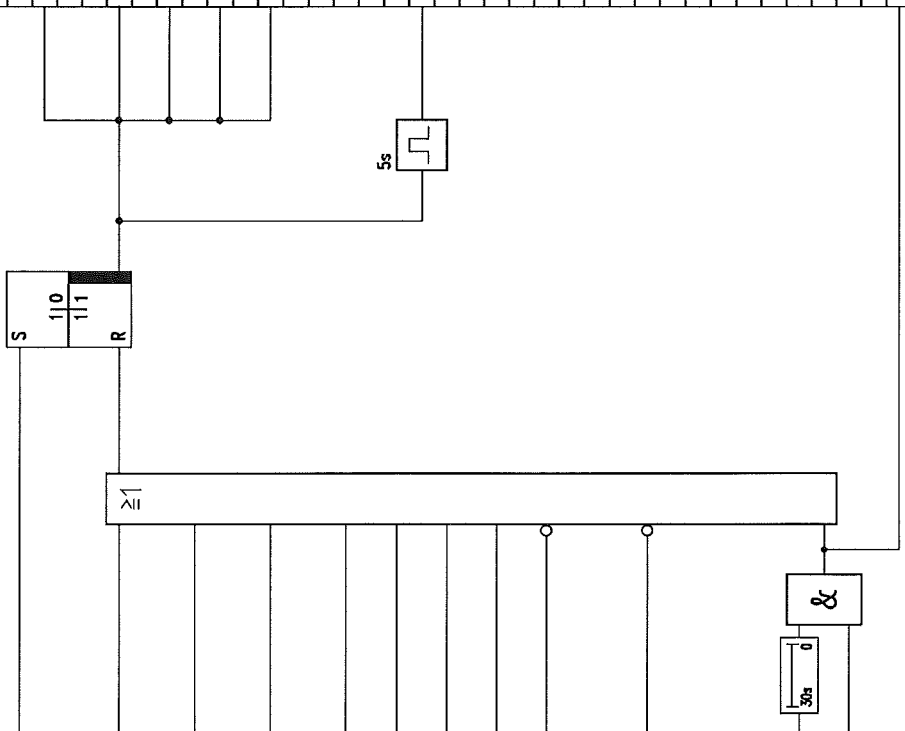

PROJECT NAME		ASU KOSICE		DRAWING NAME: LIN PUMP P71200 TRIP US71200		DATE 17.06.2005	
PLANT PART		LIN-PUMPS		FUNKTION DIAGRAM		AUTHOR: Frohn	
Rev3 08.6.07 "as built"				SIZE A3		CHECK: Eichler	
Rev2 02.2.06				DRVG. NO.		STD.	
NO. REV. DATE		REVISIONS BY		PRD.J. NO.		Page no. 172	
				K70101		Of 230 Pages	
				REPLACES:		BASED:	

Comment	Origin	Signal-/TAG-No.	Typ	Function	Signal-/TAG-No.	Destination	Comment
			1				
			2				
			3				
			4				
Start cool down pump	Software switch	1 HS 71201S	5				
Lock LIN-pump	from page no.175/	1 HS 71200_IL	6				
Trip LIN-pump	from page no.172/66	1 US 71200	7				
			8				
LIN-pump off	Check back signal	0 EH 71200	9				
			10				
Bearing temp.	Value < Min1	1 TL 71240	11				
Bearing temp.	Value < Min1	1 TL 71241	13				
Bearing temp.	Value > Max1	1 TH 71241	15				
PCV 71170 open	Y > 50%	1 P 71270_Y50	17				
HCV 71110 closed	from page no.176/69	0 HS 71210	19				
			20				
Cool down pump	Value < Min	1 TL 71230	21				
			22				
			23				
			24				
LIN-pump on	Check back signal	1 EH 71200	36				
			37				
			38				
			39				
			40				
			41				
			42				
			43				
			44				
			45				
			46				
Start pump	Software push button	1 HS 71201_S1	47				
			48				

Typ	Signal-/TAG-No.	Destination	Comment
51			
52			
53			
54			
55			
56			
57	1 UL 71200_A	to page no. 175/36	LIN-pump off from seq.
58			
59			
60			
61	1 TAH 71230	Alarm OS	"Cool down seq. fault"
62			
63			
64			
65			
66			
67			
68			
69			
70			
71			
72			
73	1 US 71203_A	to page no. 174/14	Start valve HH71203
74			
75			
76			
77			
78			
79	1 UH 71210_A	to page no. 176/27	Open HV 71210
80			
81			
82			
83			
84			
85	1 P 71270_A	to page no. 177/14	
86			
87			
88			
89			
90	1 UOH 71201	Monitoring OS	"LIN-Pump ready to start"
91			
92	1 UH 71201	to page no. 175/28	Ready to start
93			
94			
95	1 UH 71200_A	to page no. 175/30	LIN-pump on from sequence
96			
97			
98			

PROJECT NAME	ASU KOSICE
<div style="display: flex; align-items: center;"> <div> <p>AIR LIQUIDE</p> <p>Air Liquide AGS GmbH Friedrichsweg 34 47805 Krefeld</p> </div> </div>	

DRAWING NAME	FUNCTION DIAGRAM
LIN PUMP P71200	SIZE A3
START SEQUENCE US71201	DRVG. NO. K70101_173.dwg
	PRDJ. NO. K70101
	REPLACES: BASED:

[illegible]

[illegible]

[illegible]

Comment	Origin	Signal-/TAG-No.	Function	Typ	Signal-/TAG-No.	Destination	Comment
		1		51			
		2		52			
		3		53			
		4		54			
Cascade P20001 to LIN-pumps	Software buttion	1 HS 71140		55			
Selector for cascade	Software buttion	1 HS 71141		56			
	1=P71200			57			
				58			
End pressure LIN-pump P71200	P-transmitter	E PT 71270		59			
	from page no.107/90	E PIC20002_Y		60			
				61			
				62			
				63			
				64			
LIN-pump i. operation	from page no.173/85	1 P71270_Y60		65			
				66			
				67			
				68			
				69			
				70			
				71			
				72			
				73			
				74			
				75			
				76			
				77	E PV 71270	Positioner 0-100% = 20-4mA	Control valve
				78			Recycled LIN
				79			product PV 71270
				80			
				81			
				82			
				83			
				84			
				85			
				86			
				87			
				88			
				89			
				90			
				91	E HC 71200	Frequency converter	Speed control
				92		0-100% = 4-20mA	
				93			
				94			
				95			
				96			
				97			
				98			

Signal-/TAG-No.	Destination	Comment
1		
2		
3		
ASU KOSICE

PLANT

Rev3 08.6.07 "as built"

Rev2 02.2.06

Rev1 01.1.06

Rev0 01.1.06

Rev4 01.1.06

Rev5 01.1.06

Rev6 01.1.06

Rev7 01.1.06

Rev8 01.1.06

Rev9 01.1.06

Rev10 01.1.06

Rev11 01.1.06

Rev12 01.1.06

Rev13 01.1.06

Rev14 01.1.06

Rev15 01.1.06

Rev16 01.1.06

Rev17 01.1.06

Rev18 01.1.06

Rev19 01.1.06

Rev20 01.1.06

Rev21 01.1.06

Rev22 01.1.06

Rev23 01.1.06

Rev24 01.1.06

Rev25 01.1.06

Rev26 01.1.06


Rev27 01.1.06

Rev28 01.1.06

Rev29 01.1.06

Rev30 01.1.0

Function				Page	Signal-/TAG-No.	Destination	Comment
				51			
Bearing temp. P71200 PH100		E 171241_J		52			
				53			
				54			
Limit value	Constanl	E 20.0°C		55			
				56			
				57			
				58			
				59			
Limit value	Constanl	E 0.0°C		60			
				61			
				62			
				63			
				64			
				65			
				66			
				67			
				68			
				69			
				70	1 US 71210	Signal to MCC	Heating M71110 on
				71			
Heating on	Check back signal	1 EH 71210		72			
				73			
				74			
				75			
				94	1 US 71210_FRITEP	Alarm OS	Heating fail
				95			
				96			
				97			
				98			

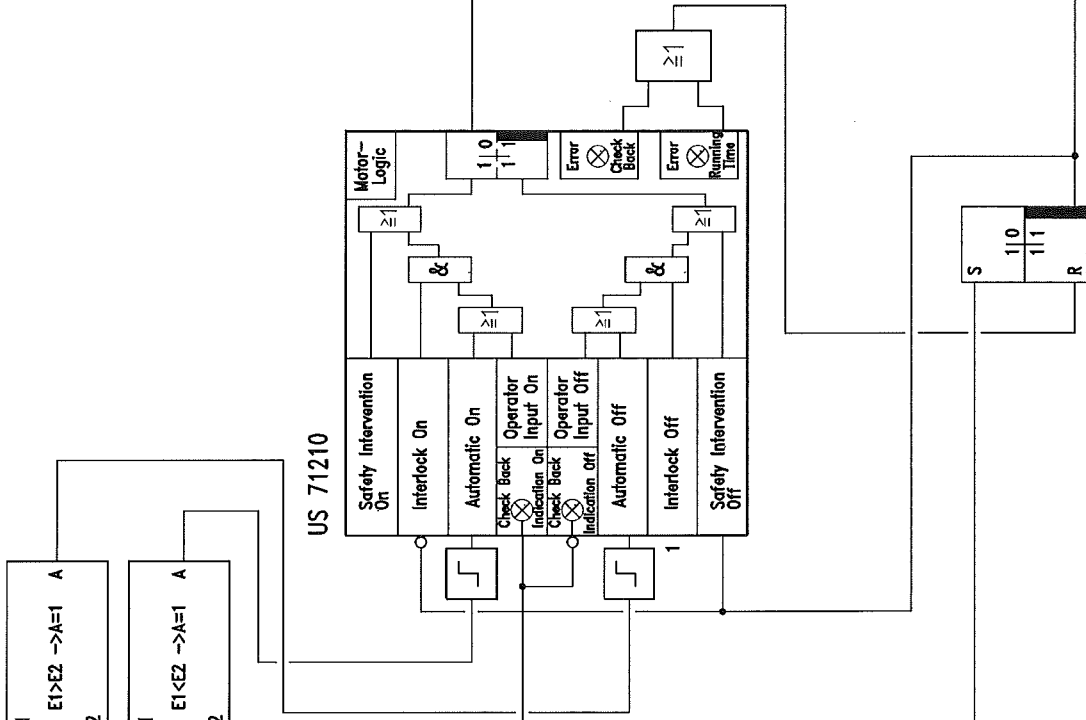

PROJECT				DRAWING NAME:				DATE: 17.06.2005			
NAME				LIN PUMP P71200				AUTHOR: Frohn			
PLANT				BEARING HEATING M71200				CHECK: Echler			
PART				US 71210				STL:			
Rev3 08.06.07 as built				Air Liquide AGS GmbH				K70101_178.dwg			
Rev2 02.2.06				Fillingweg 34				K70101			
Rev1 02.2.06				47805 Krefeld				Page no. 178			
Rev0 02.2.06				LOX-PUMPS				230 Pages			
Rev0 02.2.06				ASU KOSICE				REPLACES:			
Rev0 02.2.06				AIR LIQUIDE				FUNCTION DIAGRAM			
Rev0 02.2.06				SIZE A3				K70101			
Rev0 02.2.06				DRVG. NO.				REPLACES:			
Rev0 02.2.06				PRJ. NO.				BASED:			
Rev0 02.2.06				REPLACES:				DATE: 17.06.2005			
Rev0 02.2.06				REPLACES:				CHECK: Echler			
Rev0 02.2.06				REPLACES:				STL:			
Rev0 02.2.06				REPLACES:				Page no. 178			
Rev0 02.2.06				REPLACES:				230 Pages			
Rev0 02.2.06				REPLACES:				BASED:			

[illegible]

Function									
Comment	Origin	Type	Signal-/TAG-No.	Typ	Signal-/TAG-No.	Destination	Comment		
					51				
					52				
					53				
				DRAWING NAME:		FUNKTION DIAGRAM		DATE: 17.06.2005	
				PROJECT NAME:		ASU KOSICE		AUTHOR: Frohn	
								CHECK: Eichler	
								STD:	
								DRWG. NO.: K70101_180.dwg	
								PROJ. NO.: K70101	
								REPLACES: REPLACED BY:	
								Page no. 180 of 230 Pages	
								BASED:	

[illegible]

[illegible]

DATE	17.06.2005
AUTHOR	Frohn
CHECK	Eichler
STBL	
FUNKTION	DIAGRAM
SIZE	A3
DRWG. NO.	K70101_182.dwg
PROJ. NO.	K70101
REPLACES	REPLACED BY
BASED	BASED
PAGES	230 Pages

[illegible]

Function				Type	Signal-/TAG-No.	Destination	Comment
				51			
				52			
				53			
				54			
				55			
				56			
				57			
				58			
				59			
				60	E TV 90004	Positioner 0-100% = 4..20mA	Steam to vaporizer
				61			
				62			
TIC 9008

PI - controller

X process value

W ext. set point

W ext. on

Y Manipulated variable

Y manipulated variable on

Manual on

Automatic on

Output

PI-Algorithm. Y

Control deviation

Manual mode

Automatic mode

Slave mode

≥1

1

2

3

E TE 90008

from page no.120/84 1 US 22001

from page no.121/84 1 US 23013

from page no.148/75 1 US 43023

PH100

Dump vaporizer

Trip LOX-product

Trip LIN-product

Trip LAr-product

from page no.120/84 1 US 22001

from page no.121/84 1 US 23013

from page no.148/75 1 US 43023

PROJECT NAME				DRAWING NAME				DATE 17.06.2005			
ASU KOSICE				DUMP VAPORIZER				AUTHOR Frohn			
DUMP VAPORIZER				STEAM CONTROLLER				CHECK Eicher			
Rev3 08.6.07 "as built"				Air Liquide ACS GmbH				STD.			
Rev2 02.2.06				Füllingsweg 34				K70101_184.dwg			
Rev1 02.2.06				47805 Krefeld				K70101			
NO FILE NO				PLANT PART				Page no. 184			
NO				Stopplicht				If			
NO				Frohn				230 Pages			
NO				Frohn				REPLACES			
NO				Eicher				REPLACED BY:			
NO				BY				BASED:			
NO				CHKD:							

Function									
Comment	Origin	Type	Signal-/TAG-No.	Pin		Type	Signal-/TAG-No.	Destination	Comment
				1					
				2					
				3					
Pages no. 185 to no. 200: Spare!									
PROJECT NAME: ASU KOSICE									
DRAWING NAME: AIR LIQUIDE									
SPARE									
Air Liquide ACS GmbH Fidlingsweg 34 47805 Krefeld									
PLANT PART									
Frohn Stippich Frohn Eichler									
Rev3 08.6.07* as built* Rev2 02.2.06 Rev1 01.1.06									
DATE REVISIONS BY CHKD									
DATE 17.06.2005									
AUTHOR Frohn									
CHECK Eichler									
STD.									
K70101_180.dwg									
K70101									
Page no. 185-200 Of 230 Pages									
REPLACES: REPLACED BY:									
BASED:									

Function

Function				Function			
Comment	Origin	Signal-/TAG-No.	Typ	Signal-/TAG-No.	Destination	Comment	
Reset Trip NC1	Software reset button	HS 70000	51				
Main motor NC1 off	fr. page no. 203/55	EH70001_dyn	52				
Oil temp. NC1	Value > Max2	THH 70854	53		Alarm OS	Trip NC1	
Oil pressure NC1	Value < Min2	PLL 70854	54	1 UA 70000			
			55				
			56				
			57	1 US 70000	to page no. 201/44	Trip N2 compressor 1	
			58				
			59	1 US 70000	to page no. 205/23	Ready to start	
			60				
			61	1 US 70000	to page no. 210/7	Open recycle valve	
			62			UV 70074	
			63	1 US 70000	to page no. 211/7	Open blow off valve	
			64			UV 70035	
			65	1 US 70000	to page no. 214/28	Open blow off valve	
			66			HV 70035	
			67	1 US 70000	HIC70036, Y=0%	Close MP-GAN	
			68			HK 70036	
			69				
			70				
ASU KOSICE

Rev3 08.6.07 "as built"

Rev2 02.2.06

Rev1 01.1.05

Rev0 01.1.05

ASU KOSICE

Rev3 08.6.07 "as built"

Rev2 02.2.06

Rev1 01.1.05

Rev0 01.1.05

ASU KOSICE

Rev3 08.6.07 "as built"

Rev2 02.2.06

Rev1 01.1.05</