



SECTION
SCALE 1/100

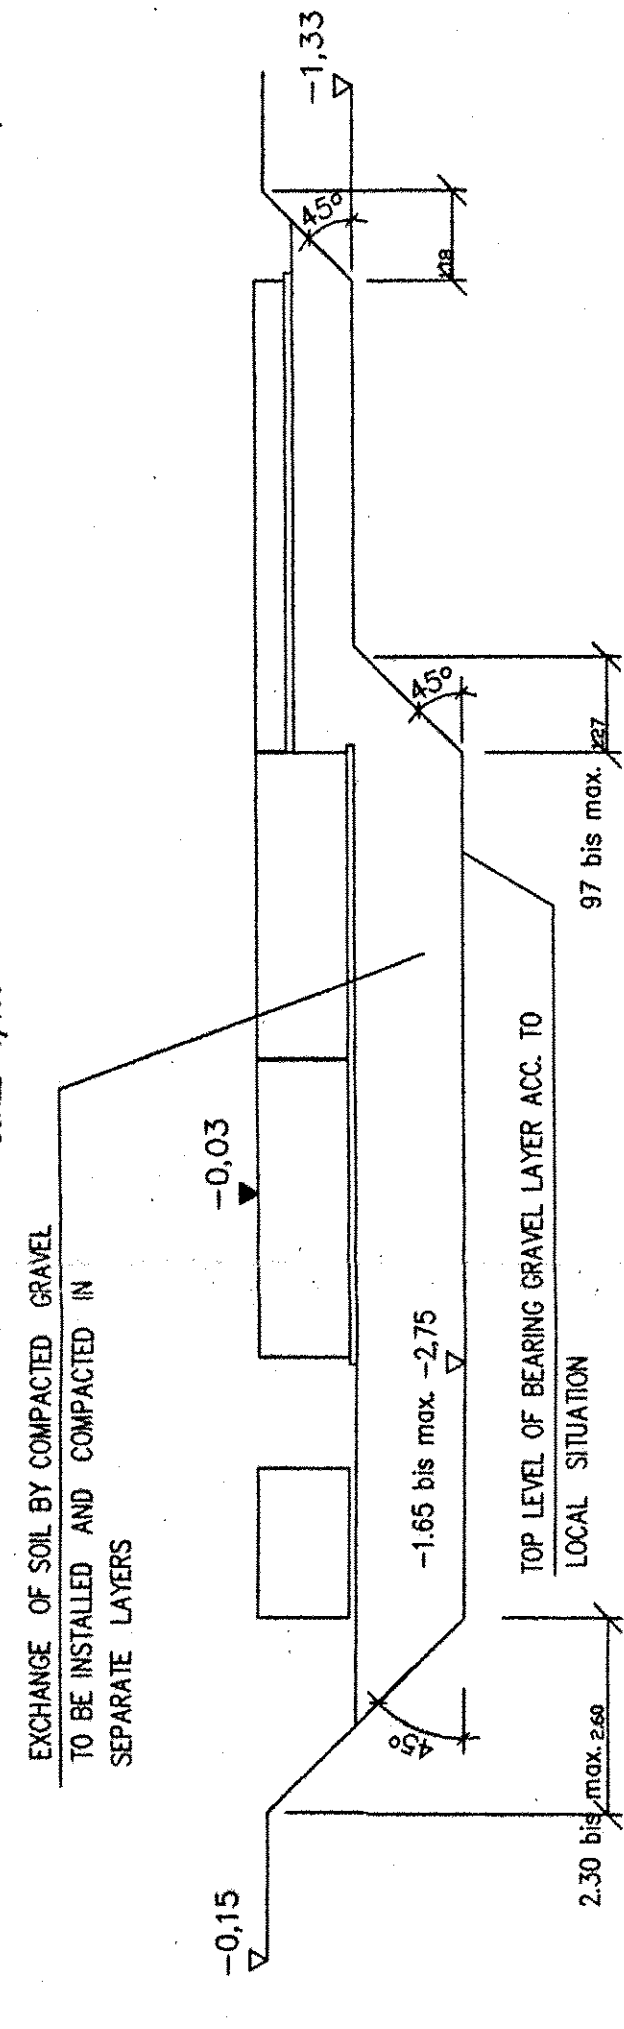

SECTION K1-K1
FLOOR SLAB (42)

SECTION K1-K1
FLOOR SLAB (42)

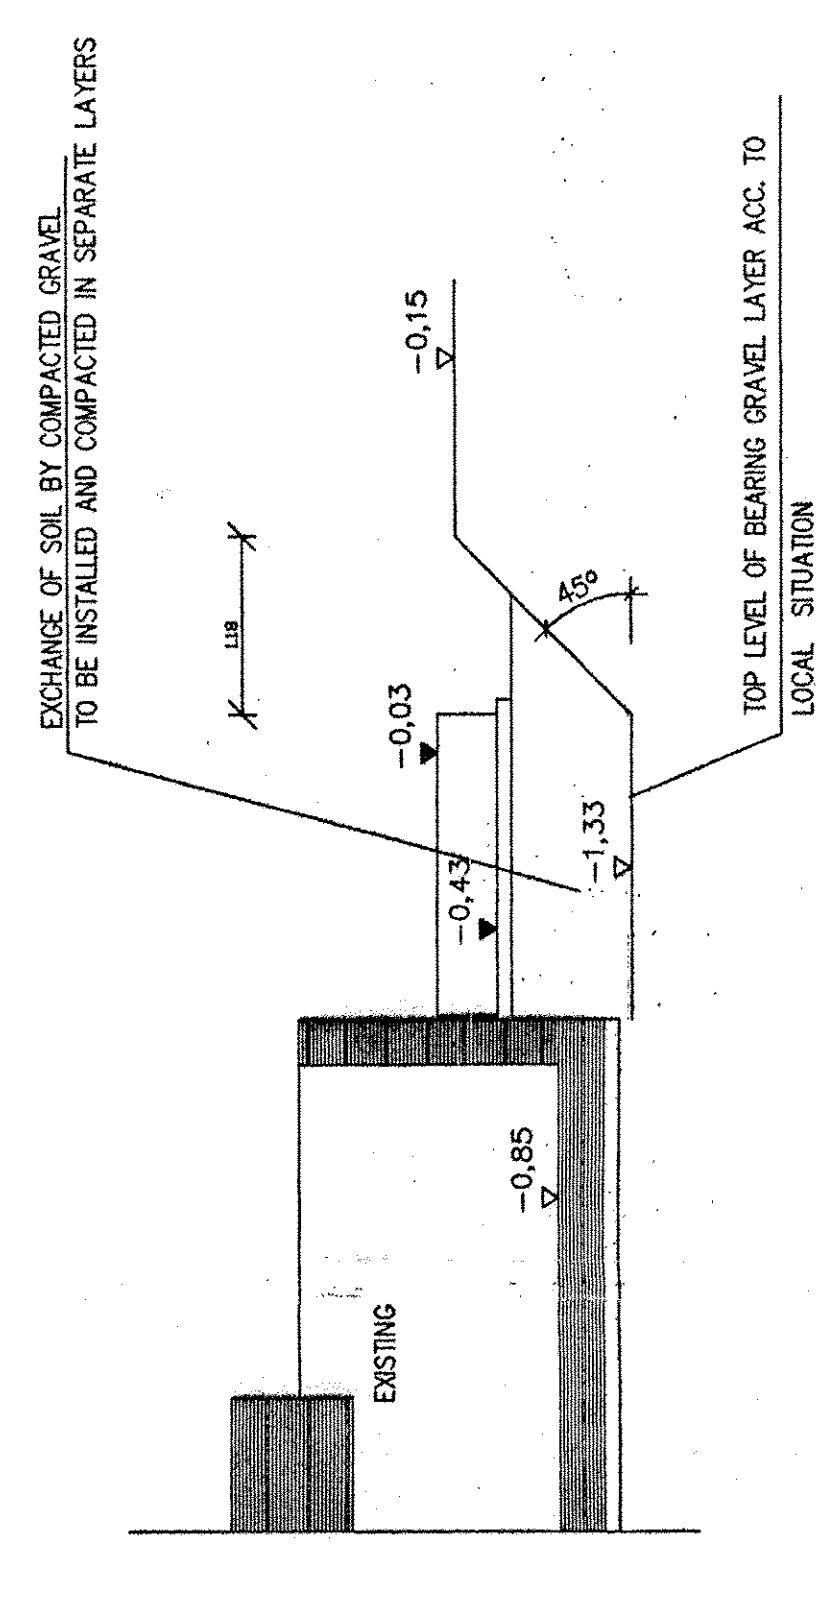

FORMWORK FOUNDATIONS-TYPE. 33..... 41
SEE DRAWING NO 7574-2

FORMWORK FOUNDATIONS—TYPE (42) AND (43)
SEE DRAWING NO 7574-8

FORMWORK FLOOR SLAB FOR CONTOUR-BOX
SEE DRAWING NO 7574-13

FORMWORK FOUNDATIONS—TYPE F1 F2 AND F3
SEE DRAWING NO. 7574-8

 $225,15\text{m NM.} = \pm 0,00$


LEVEL OF STRUCTURE
WITHOUT FINCH

LEVEL OF STRUCTURE
WITH FINISH

LEVEL OF STRUCTURE WITHOUT FINISH =
LEVEL OF STRUCTURE WITH FINISH


KEY-PLAN

KEY-PLAN

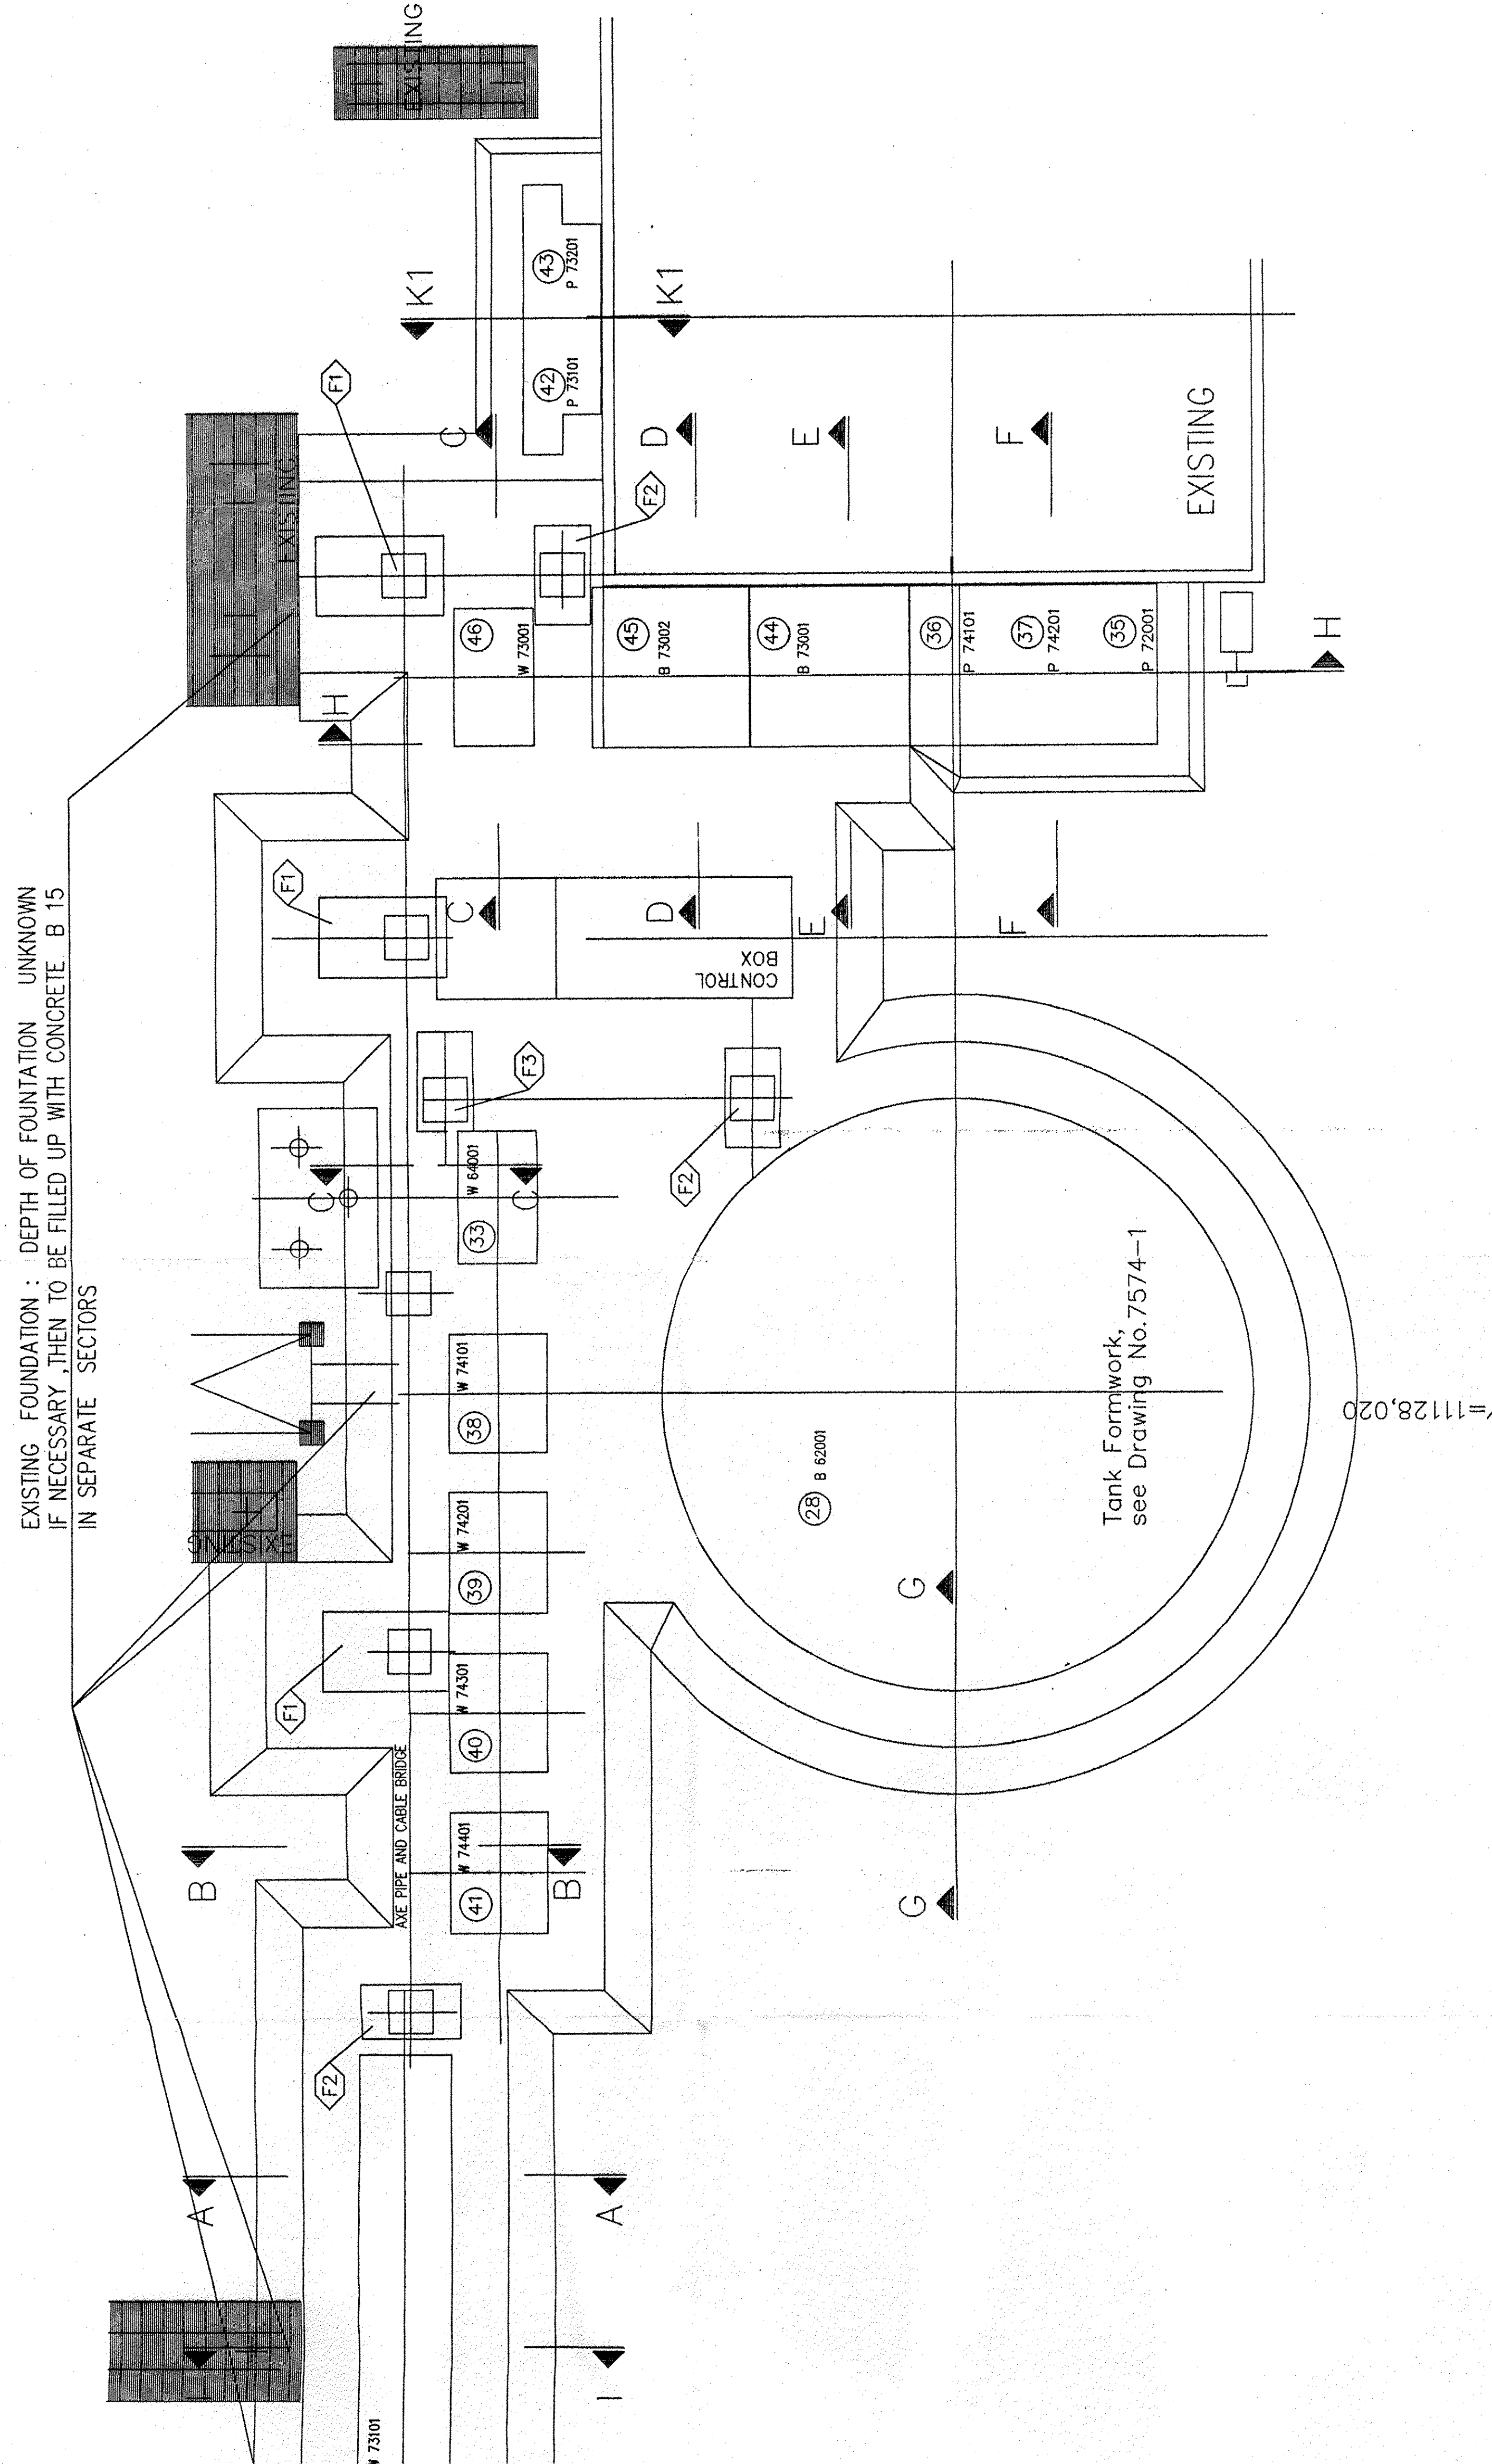

TOP VIEW FOUNDATION SCALE 1/5"
TYP (47) (LIN WATER BATH VAPORIZER)

TOP VIEW FOUNDATION SCALE 1/5"
TYP (47) (LIN WATER BATH VAPORIZER)

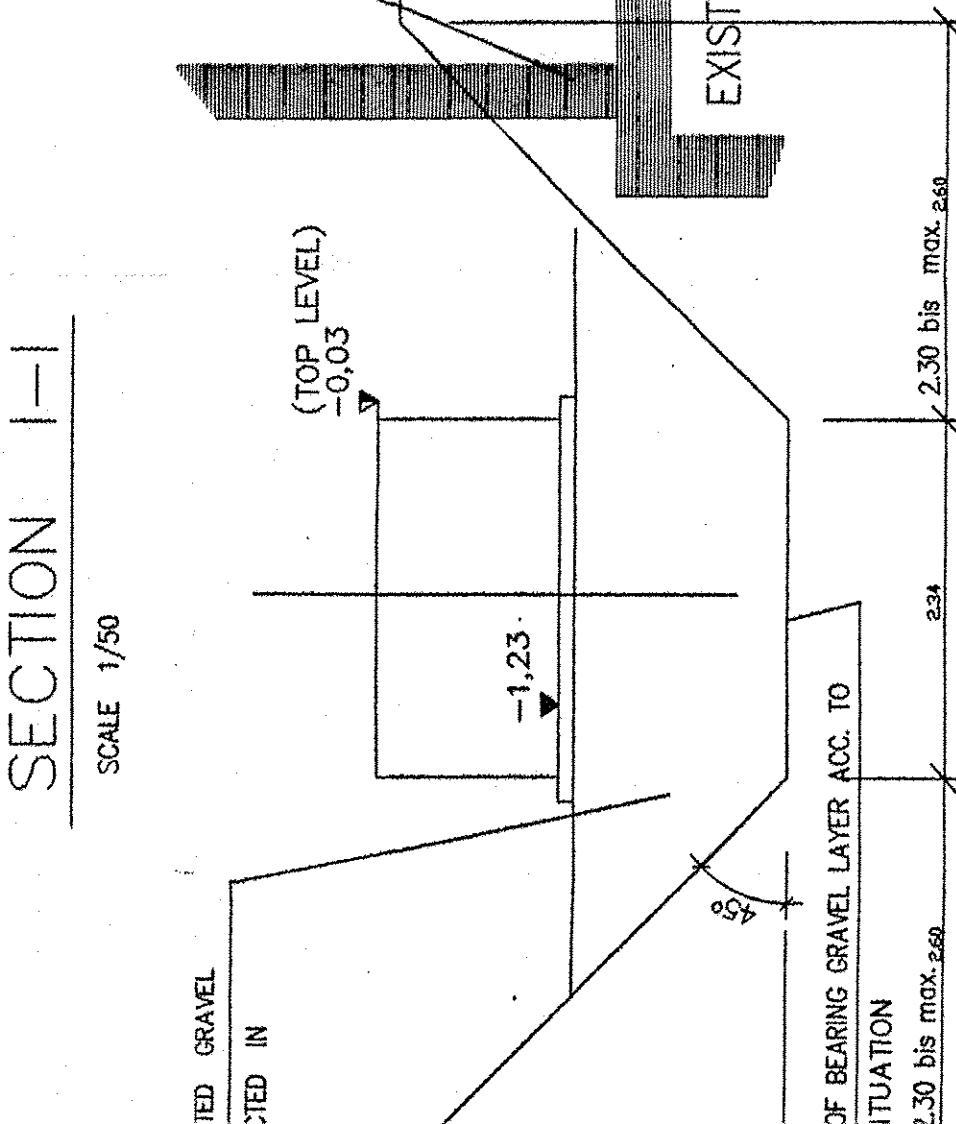


SECTION 1-1

SECTION 1-1

TOP VIEW FOUNDATION

TOP VIEW FOUNDATION

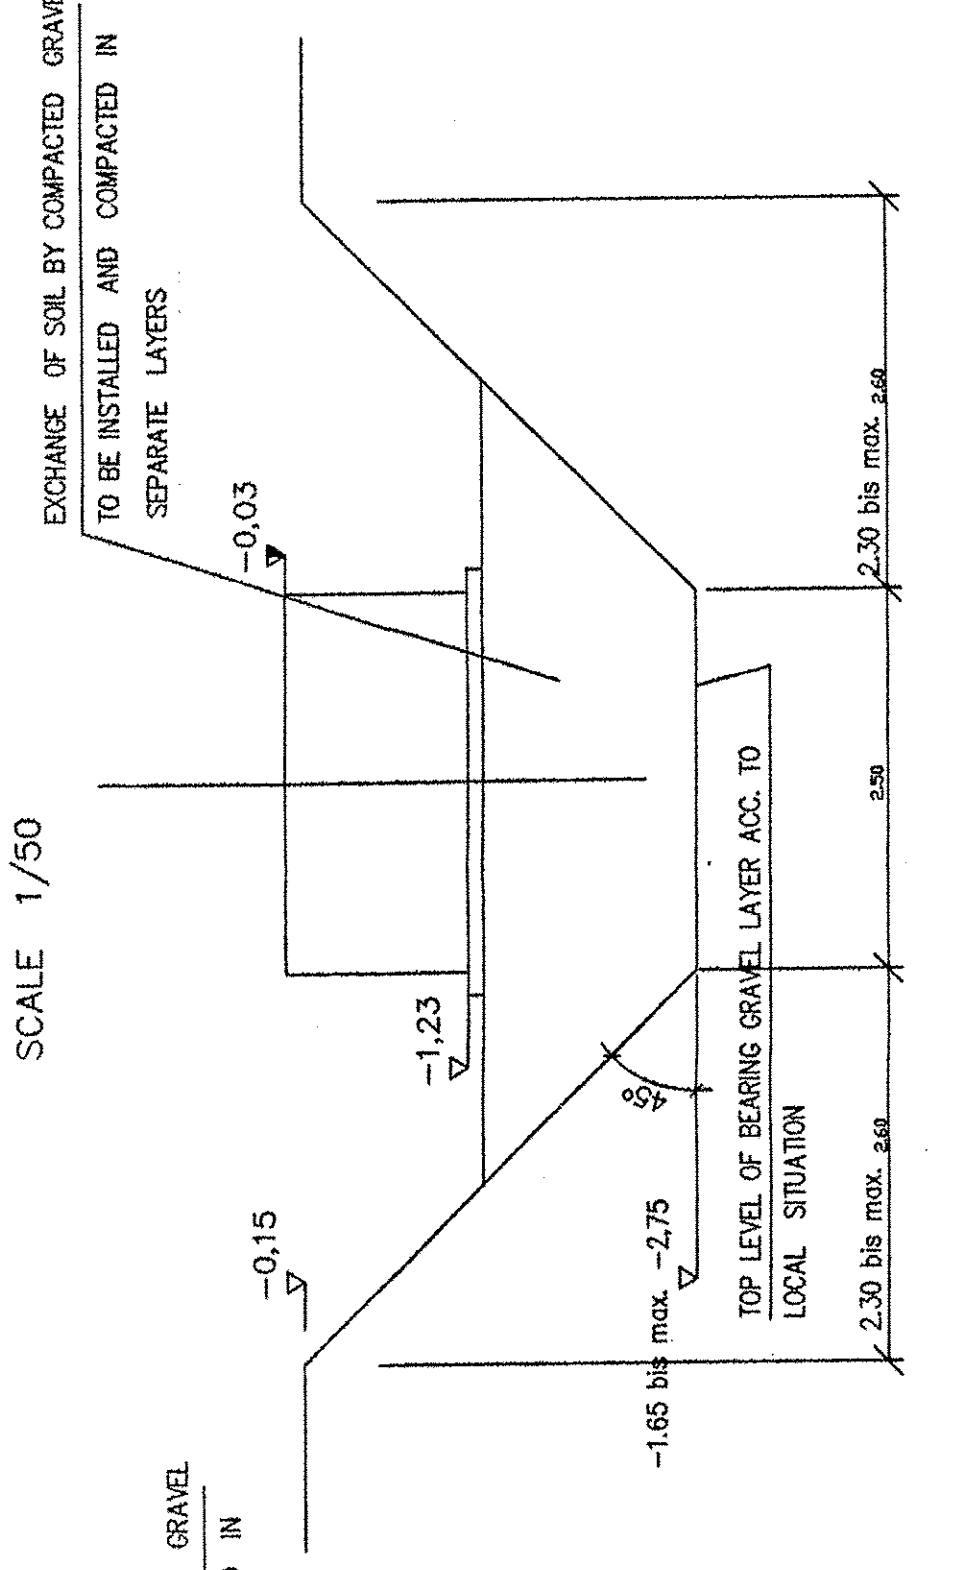


SECTION B-B

SECTION B-B

TOP VIEW FOUNDATION

TOP VIEW FOUNDATION

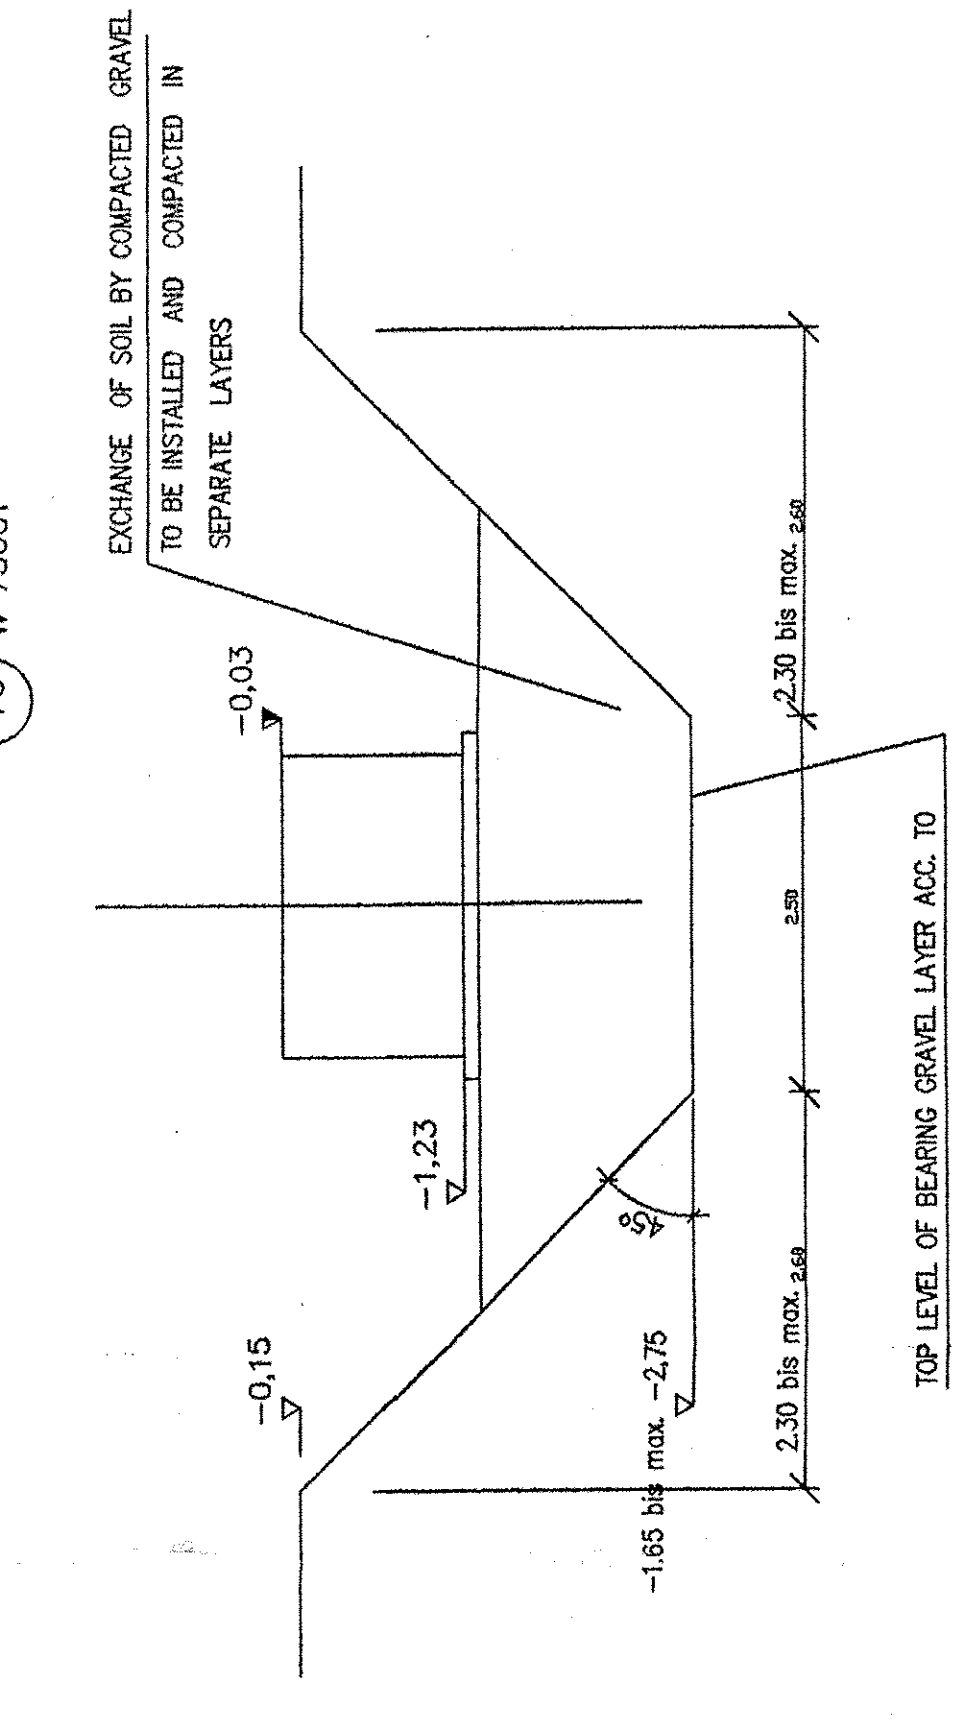


SECTION C-C

SECTION C-C


B 73002

B 73002

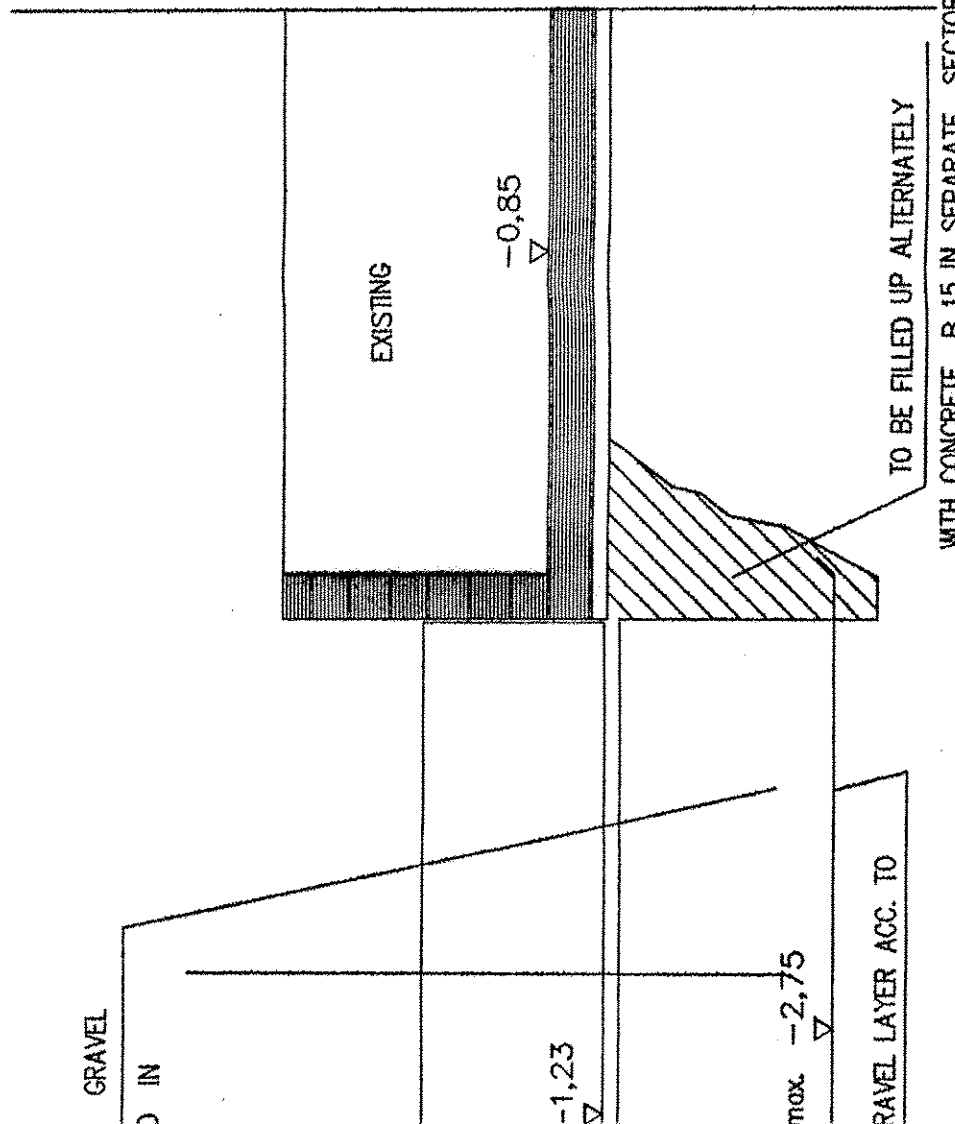


SECTION E-E

SECTION E-E

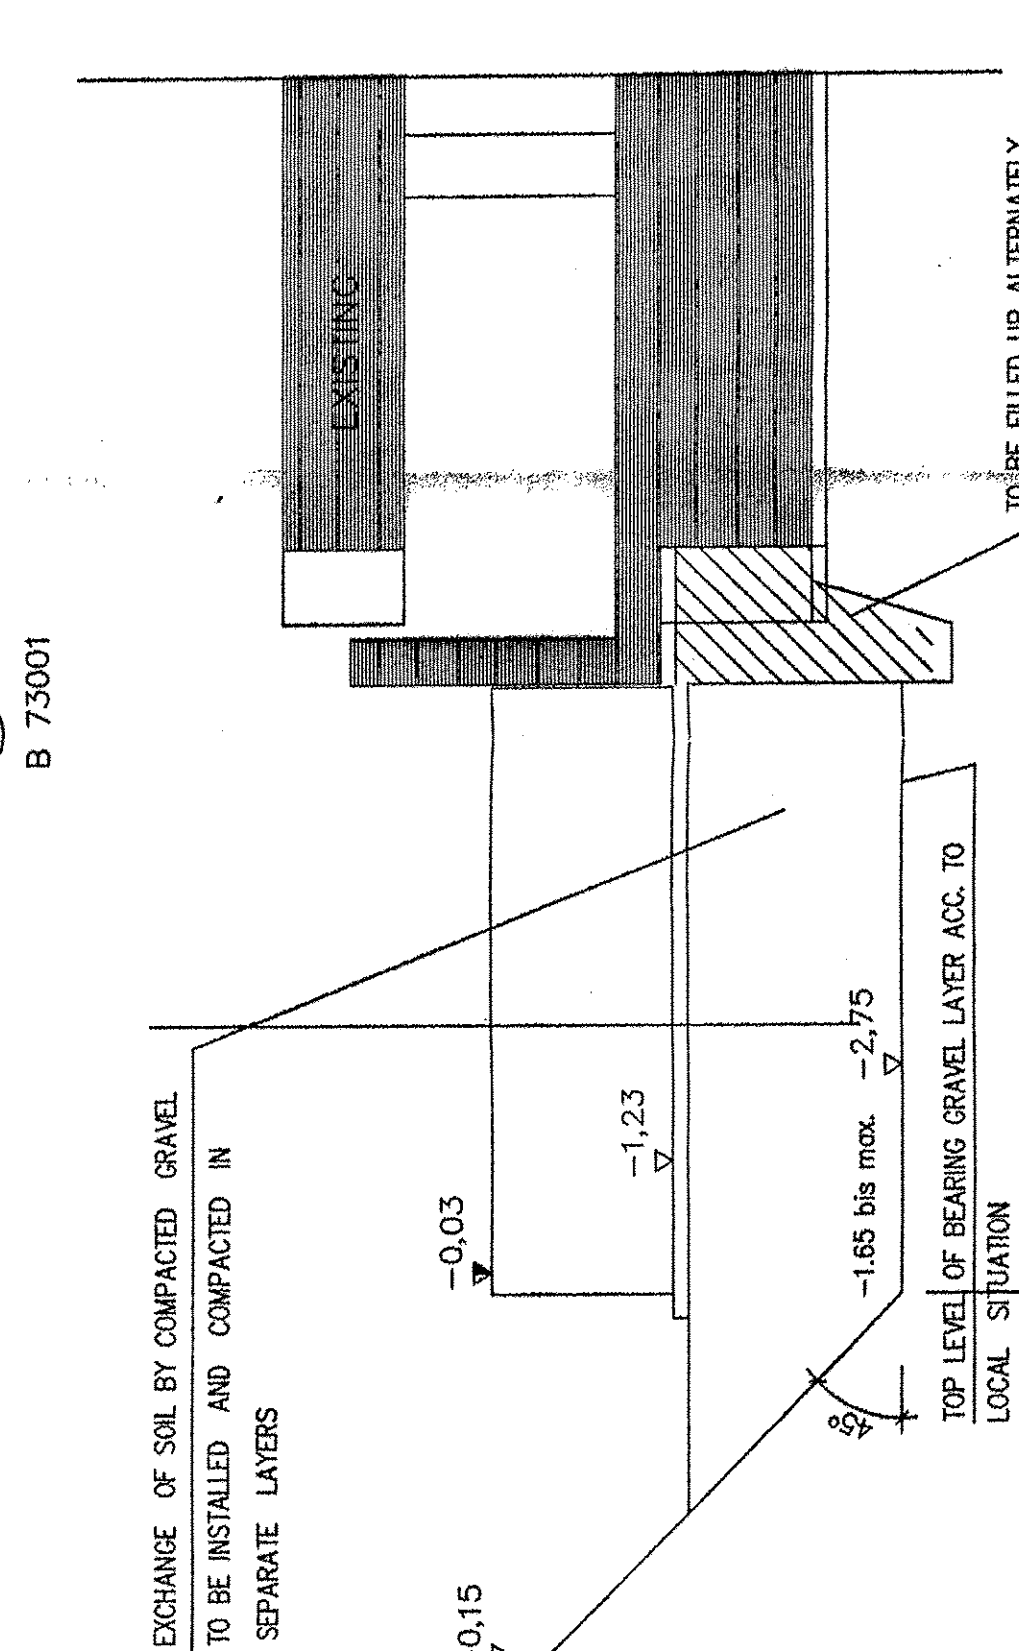


SECTION F-1

SECTION F-1

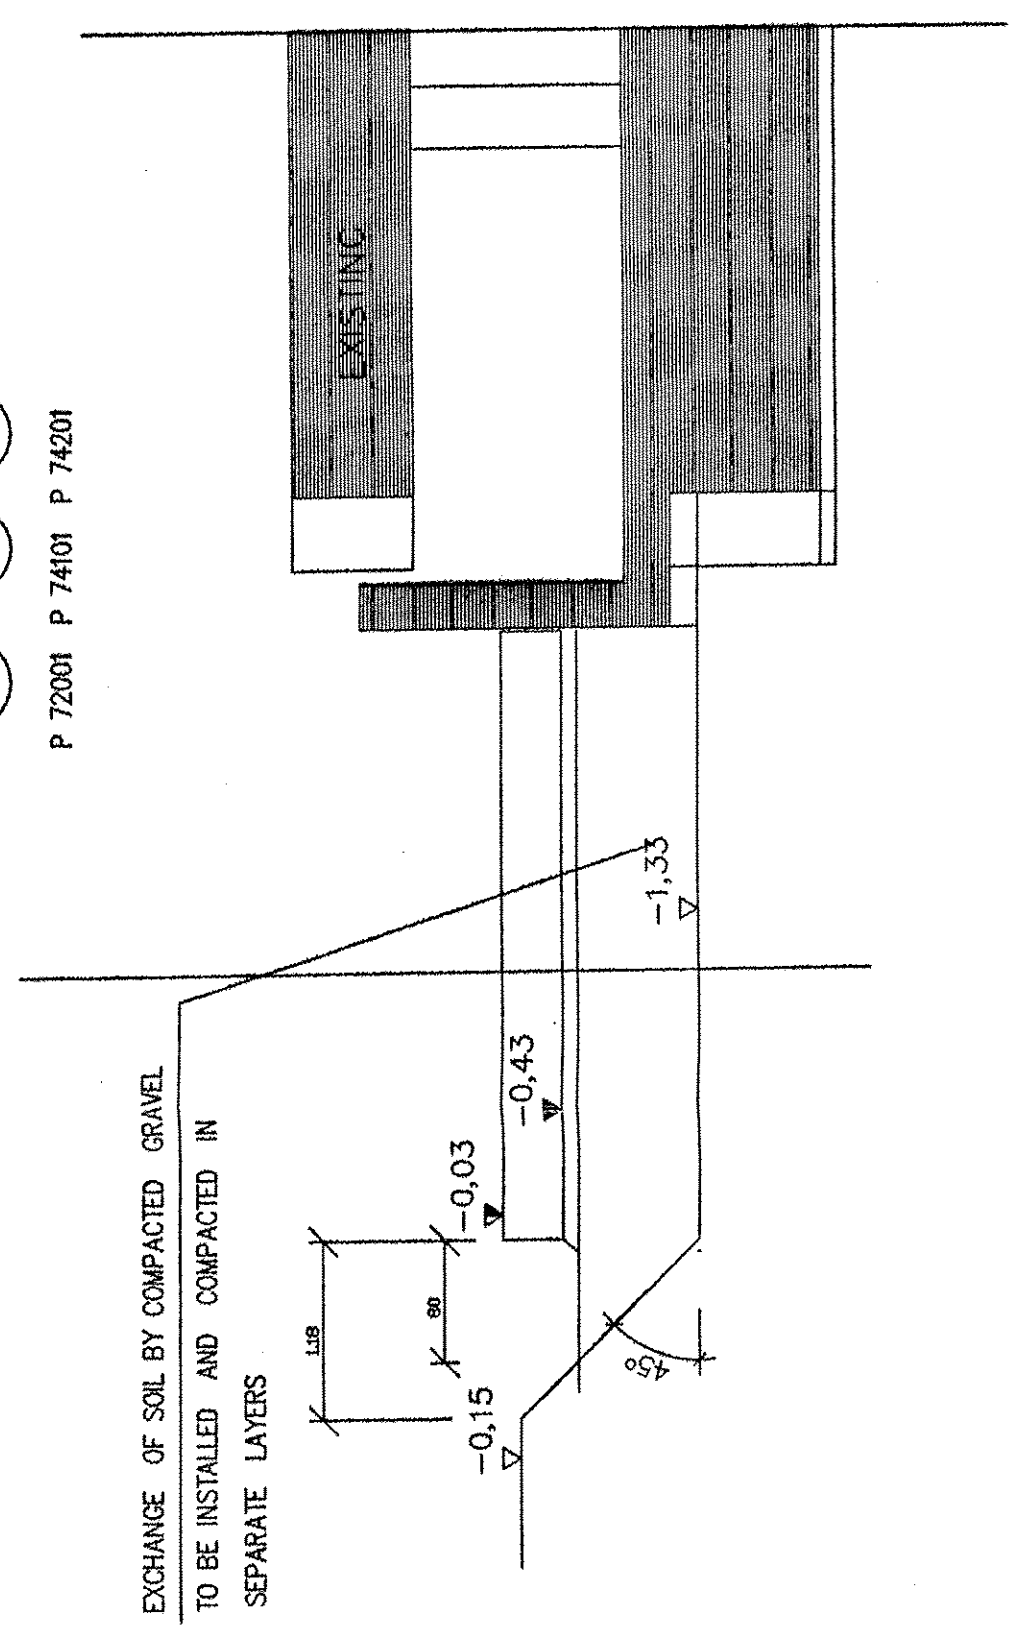

SECTION G-G SCALE 1/50

SECTION G-G SCALE 1/50

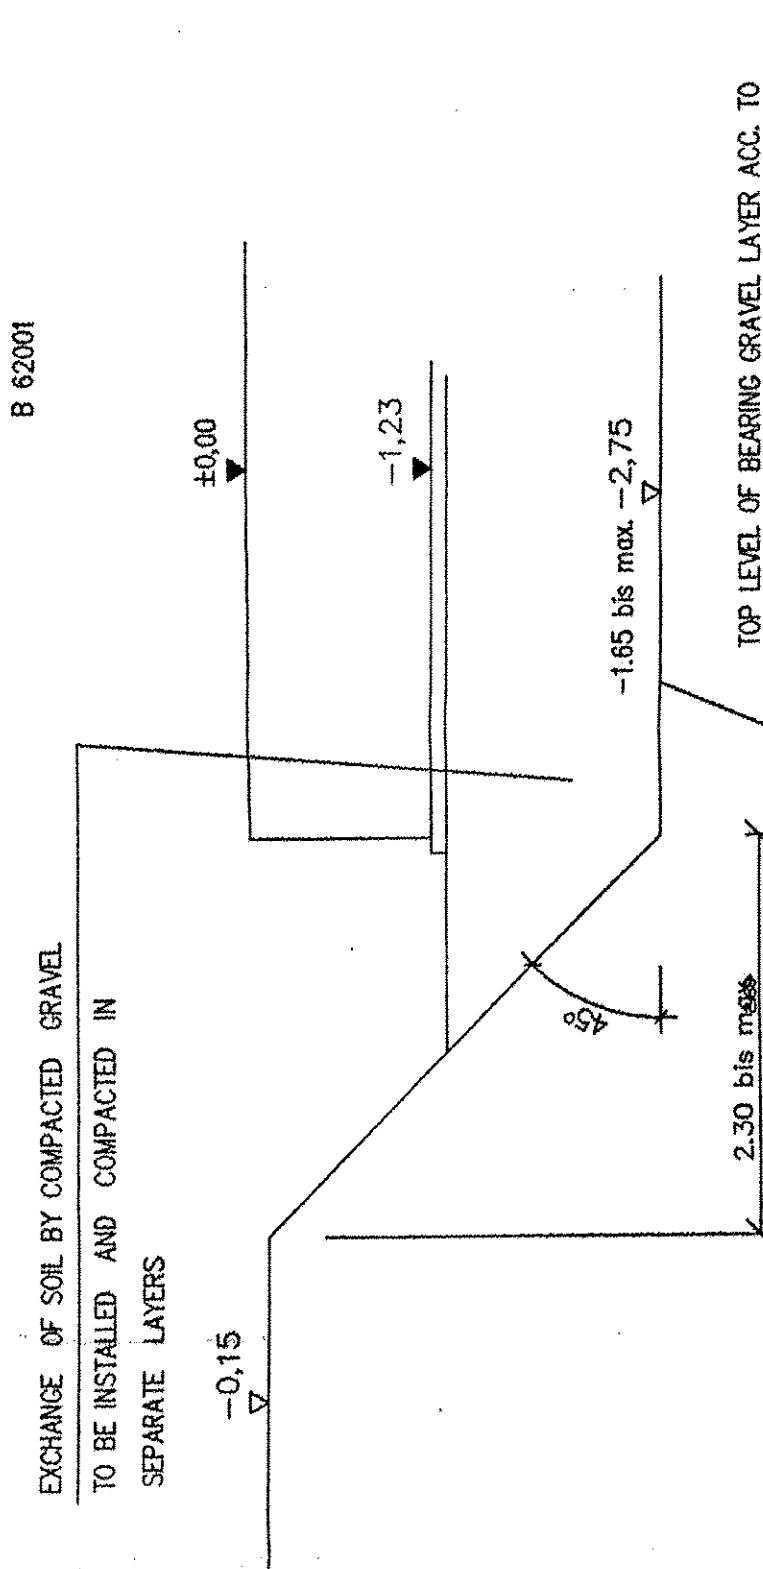

**FREIGABE
FÜR CONSTRUCTION**

PROJEKT SKUTOČNÉHO
VYHOTOVENIA

Plan-No.: 7574-6
Bauteil TANK FARM
FOUNDATION EXCAVATION

B	DATE-3800C	10/1/54	SP	M. 0th
C	DATE-5000C	10/1/54	SP	M. 0th
D	DATE-5000C	10/1/54	SP	M. 0th
E	DATE-5000C	10/1/54	P. 0th	M. 0th
F	DATE-5000C	10/1/54	P. 0th	M. 0th
