


X
↓


FOUNDATION-TYP (35) (LIN TRUCK FILLING PUMP)




SECTION F1-F1

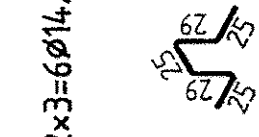

CURING AFTER CASTING OF CONCRETE ACC. TO THE RESPECTIVE DIRECTIONS.
(FREE SURFACES OF CONCRETE TO BE COVERED AND MOISTENED DURING TWO WEEKS)

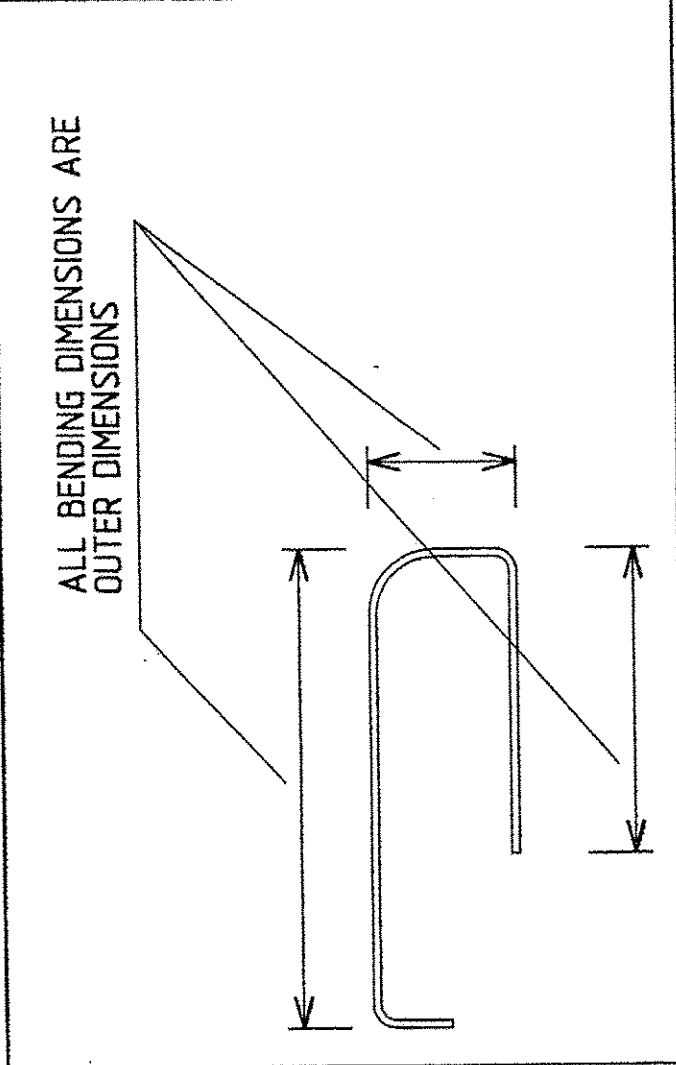

CONCRETE COVER FOR REINFORCEMENT : 4CM

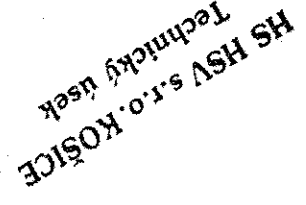

**FREIGABE
FÜR CONSTRUCTION**


SKUPINA SKUTOČNOSTI
KATEGORIE

0	First delivery	06.12.2004	Speicher	M.O.rth
Day	Business	Date	Name	checked

SUBJECT: REINFORCEMENT
FOUNDATION TYPE 35
(HP -LIN BACKUP PUMPS)

Dipl.-Ing. Mülhäußer
Dipl.-Ing. Weisang
KIMM

Saarbrücker Strasse 9 - 10
66130 SAARBRÜCKEN-BREBACH
Tel.: (0681) 88313-0 Fax: (0681) 8831388

 AIR LIQUIDE <small>SAFETY</small>	Air Liquide AGS GmbH		Date :	Name :	Checked :	History file :	
			06.12.2004	Speicher	M-Orth	792.87057-018.doc	
Job code: K70101			Reference: ASU No. 9 KOSICE			Scale 1:50	Original format A2
Title: TANK FARM			Drawing No.: 792,870,57			Sheet: of	Sheet: Rev.
Replaces: 79_-----			Replaced by: 79_-----				