


FORMWORK DEBEHNE

TOP VIEW FLOOR SLAB

CONTROL-BOX

SCALE 1/50

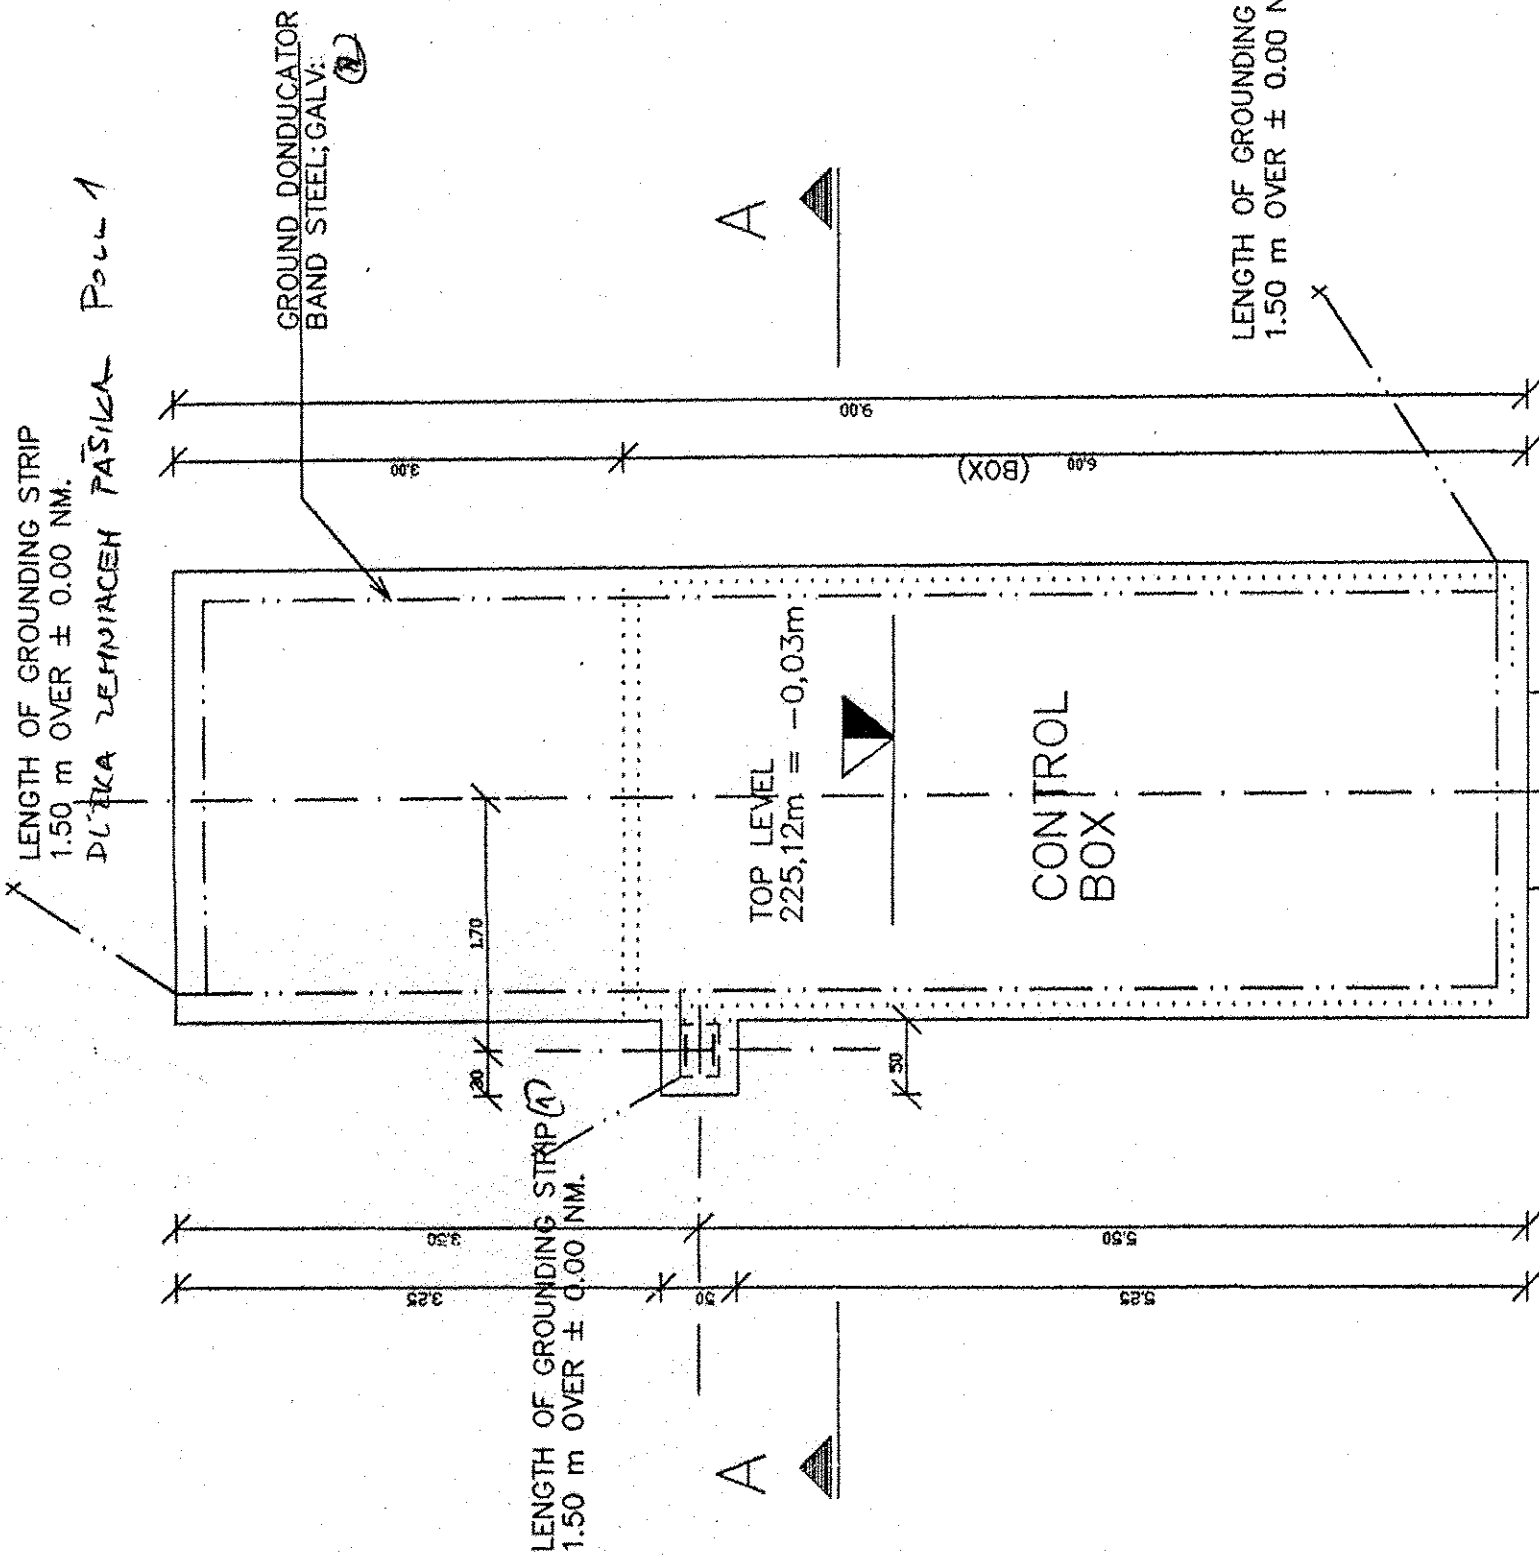


REINFORCEMENT VYSTUČ

TOP VIEW FLOOR SLAB


CONTROL-BOX

SCALE 1/50

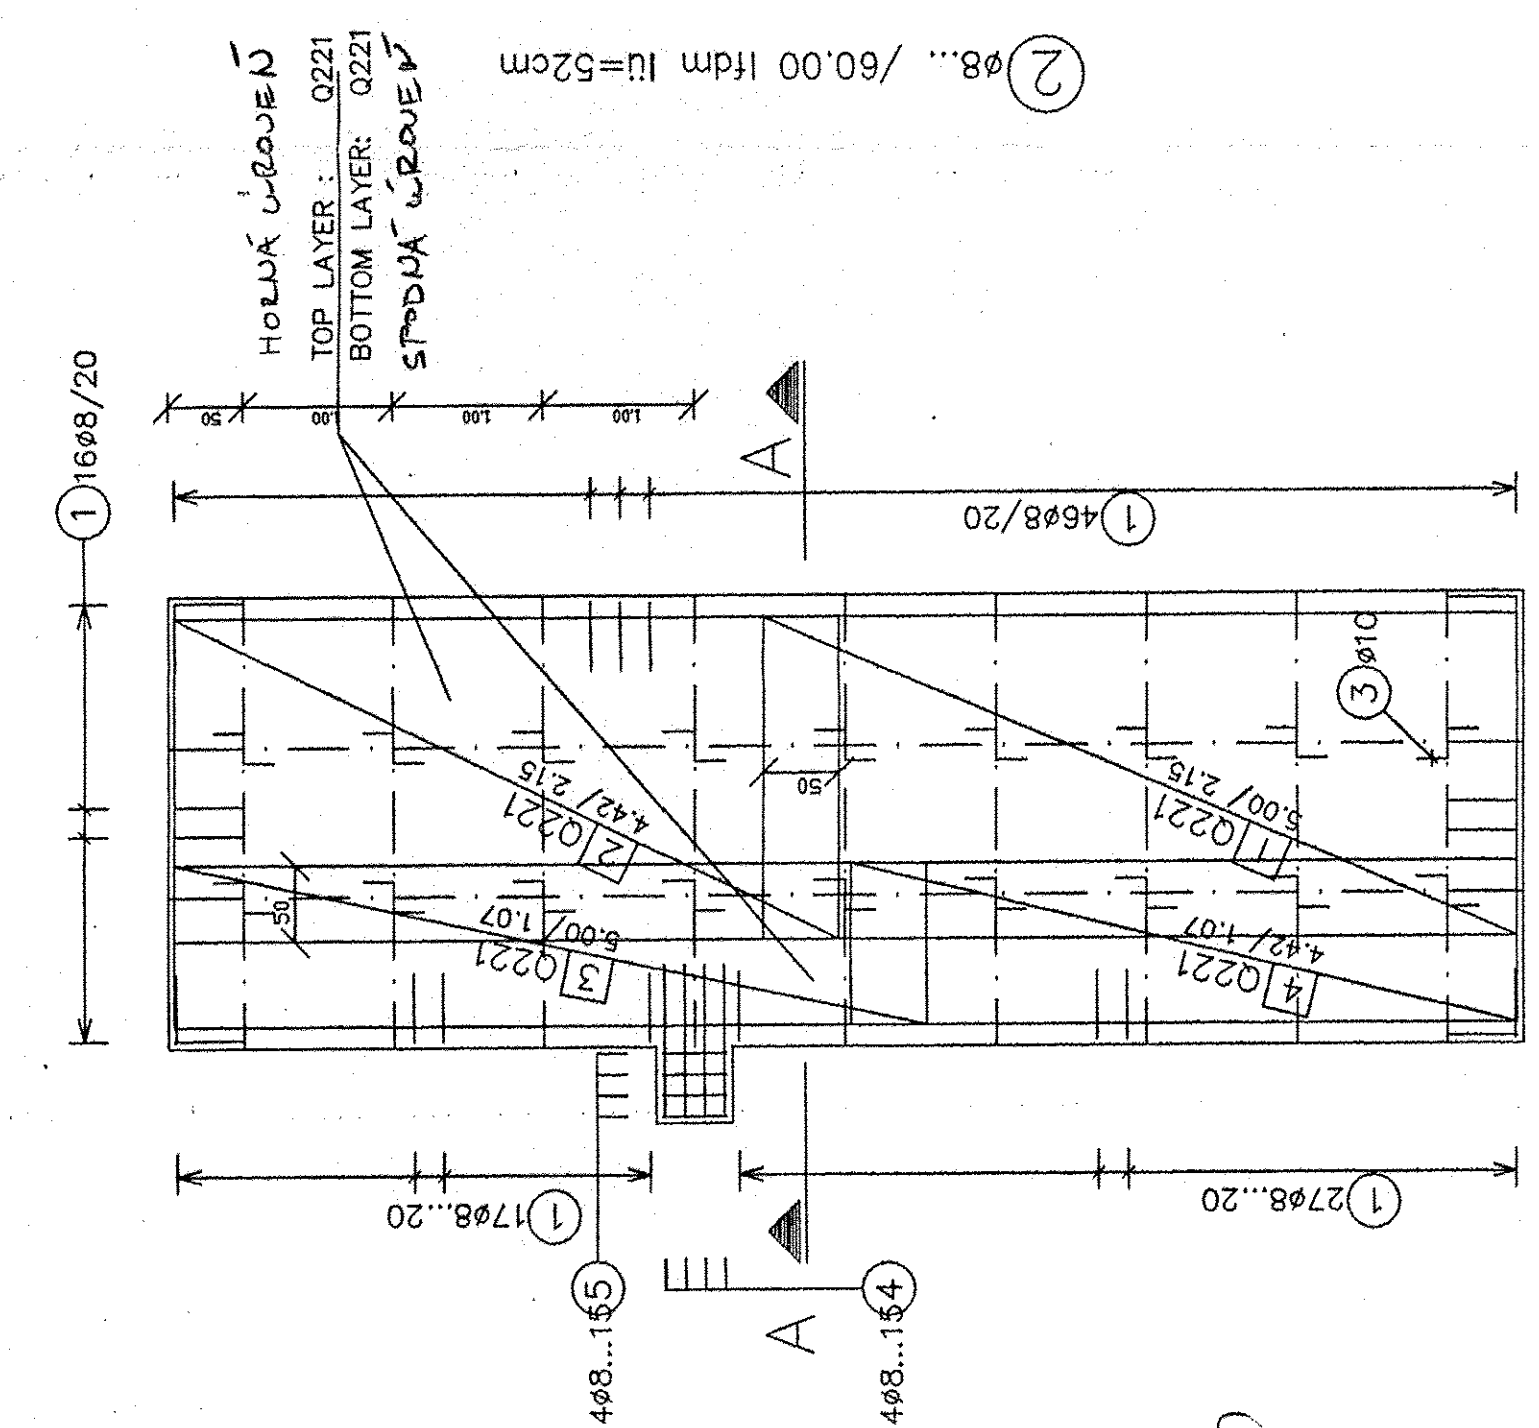


KEY PLAN


SCALE 1/200 STUČIA

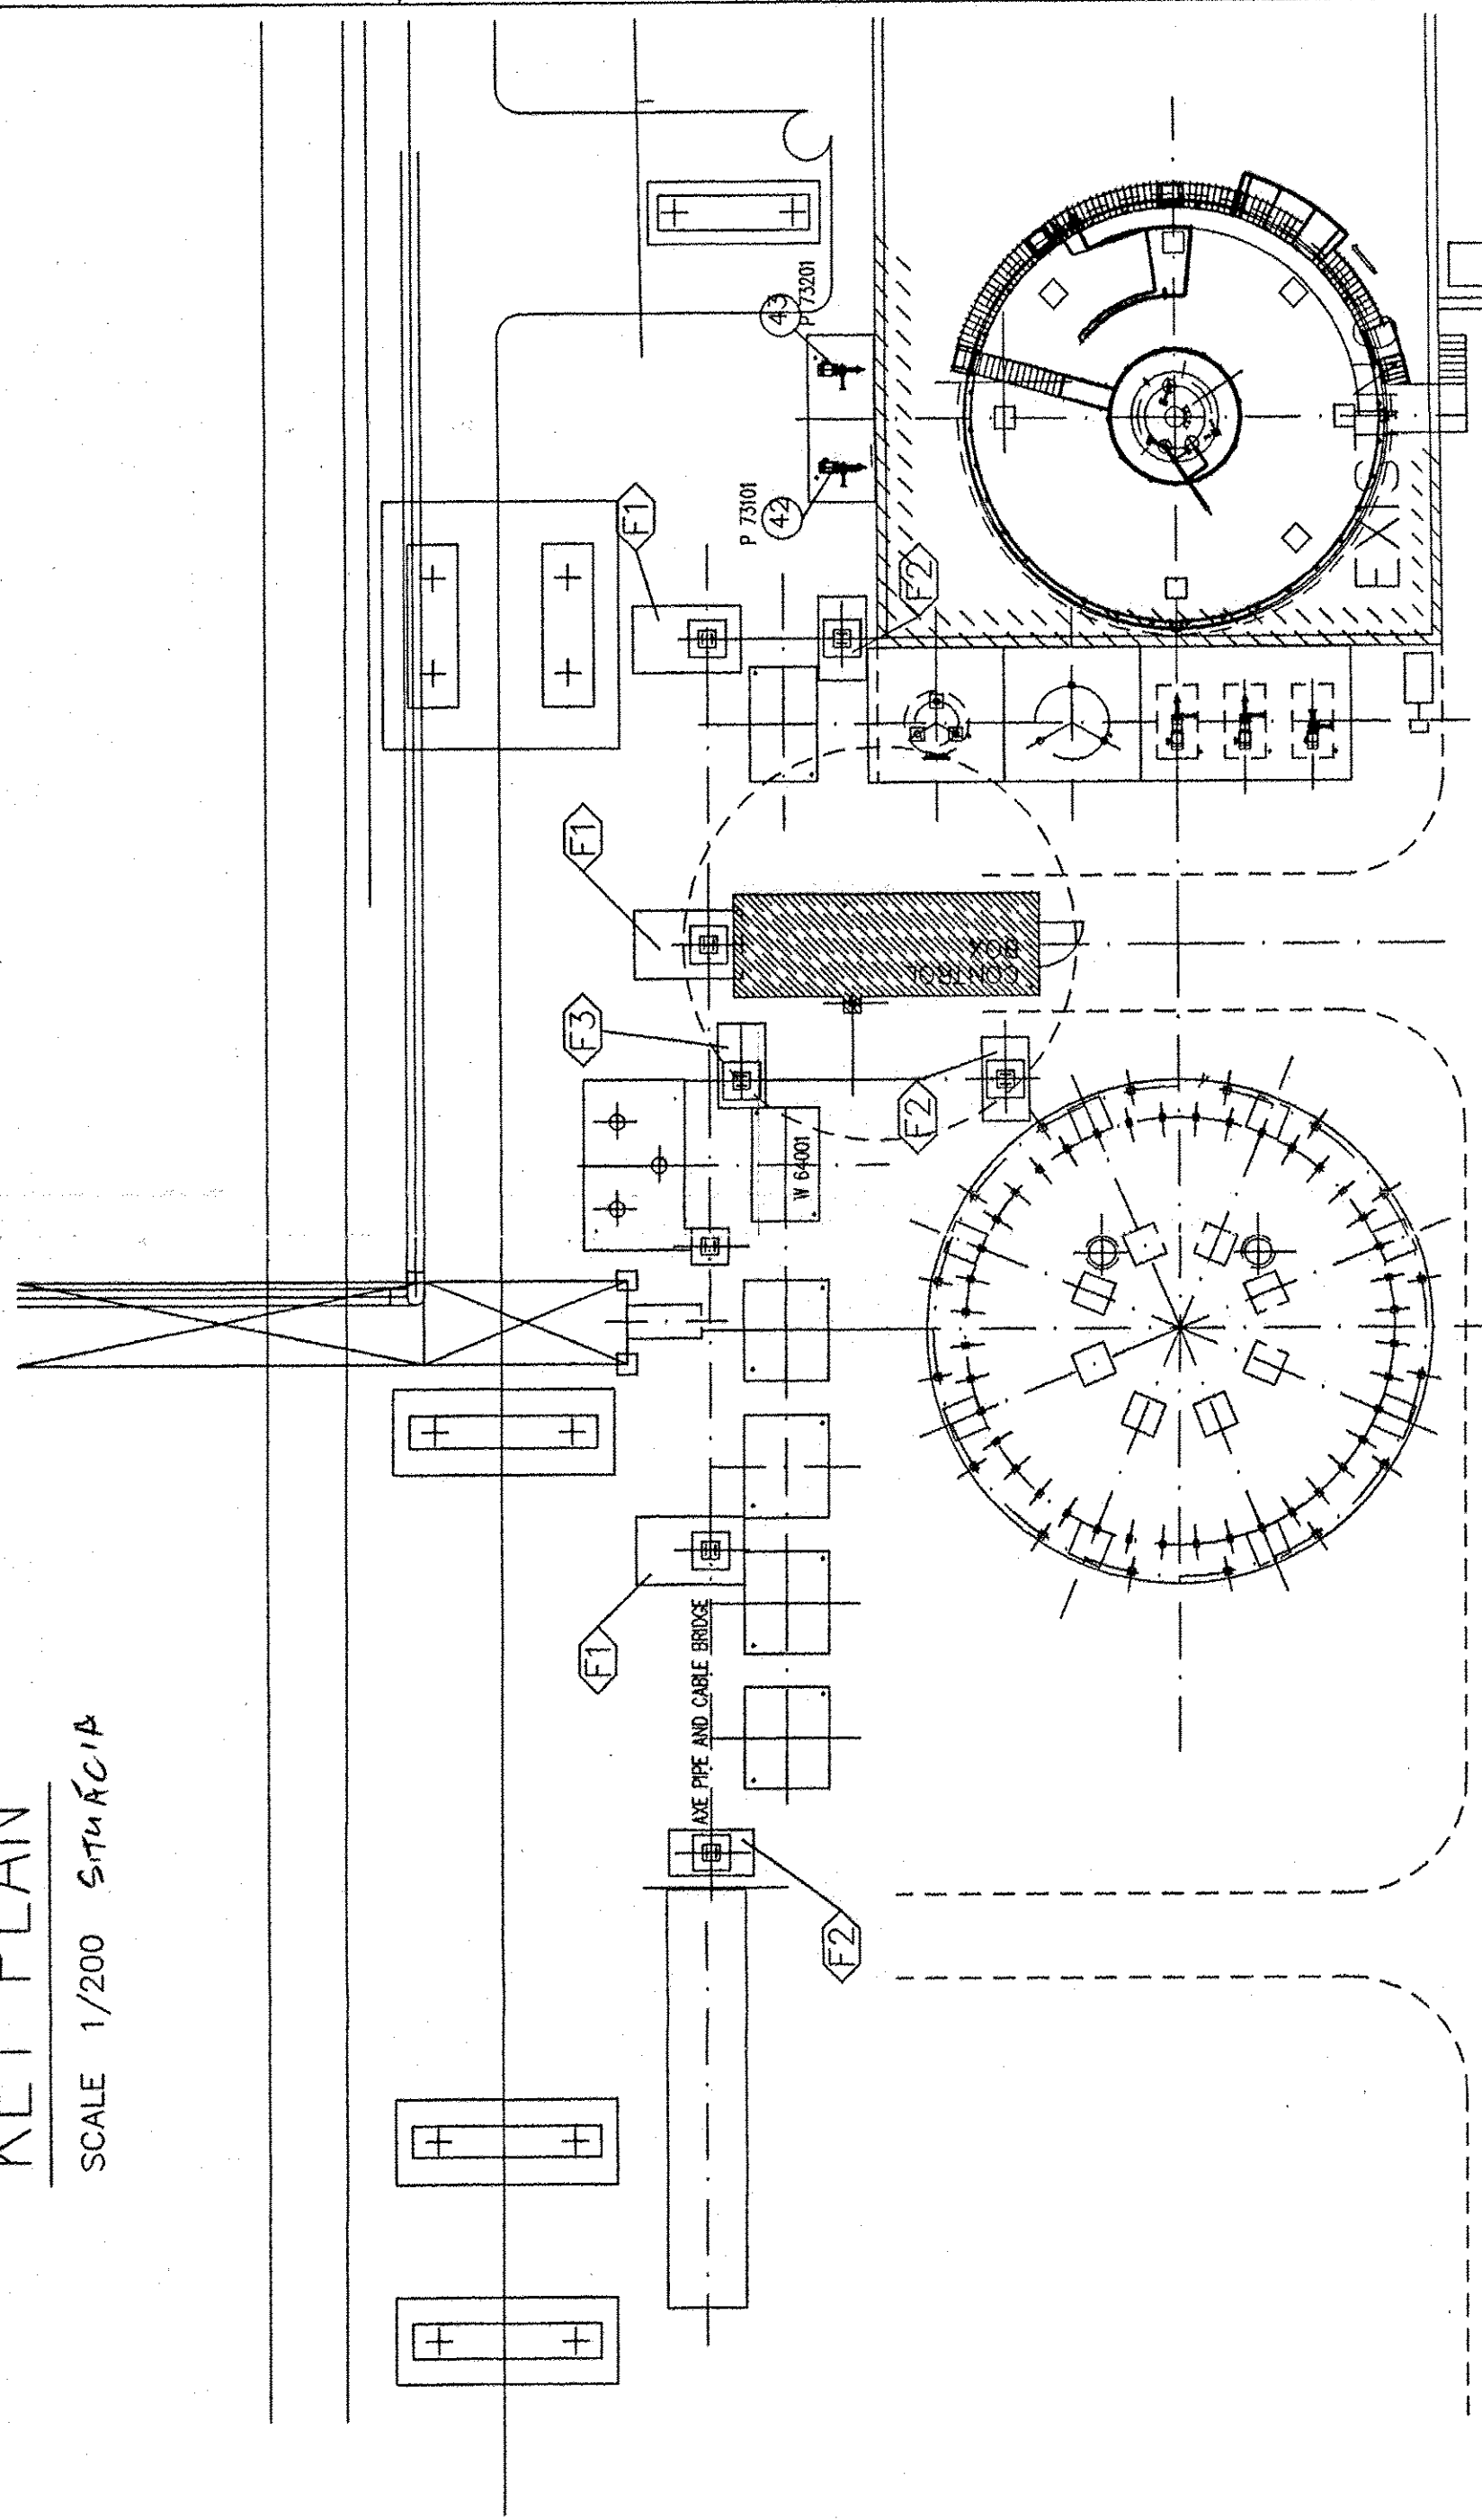

SECTION A-A

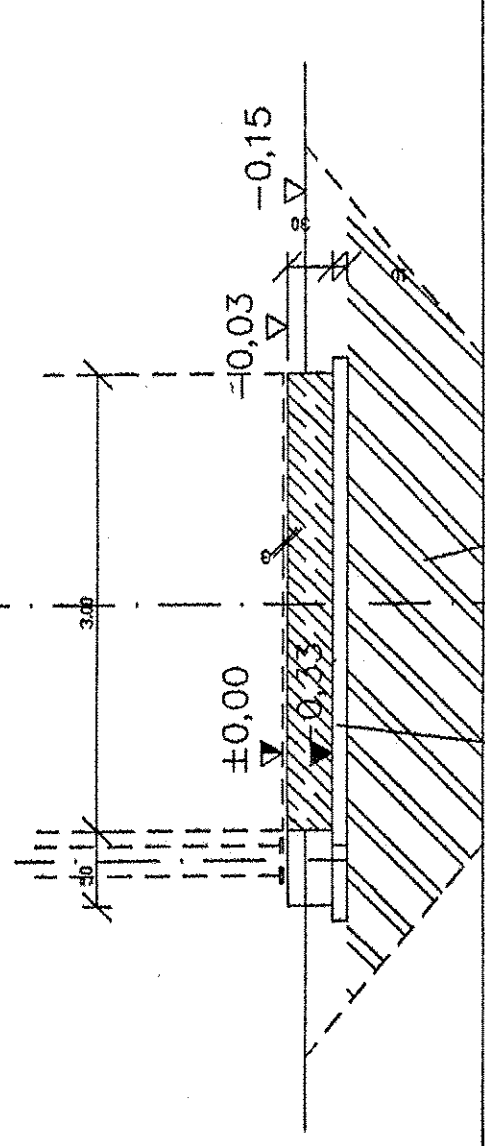

SECTION A-A

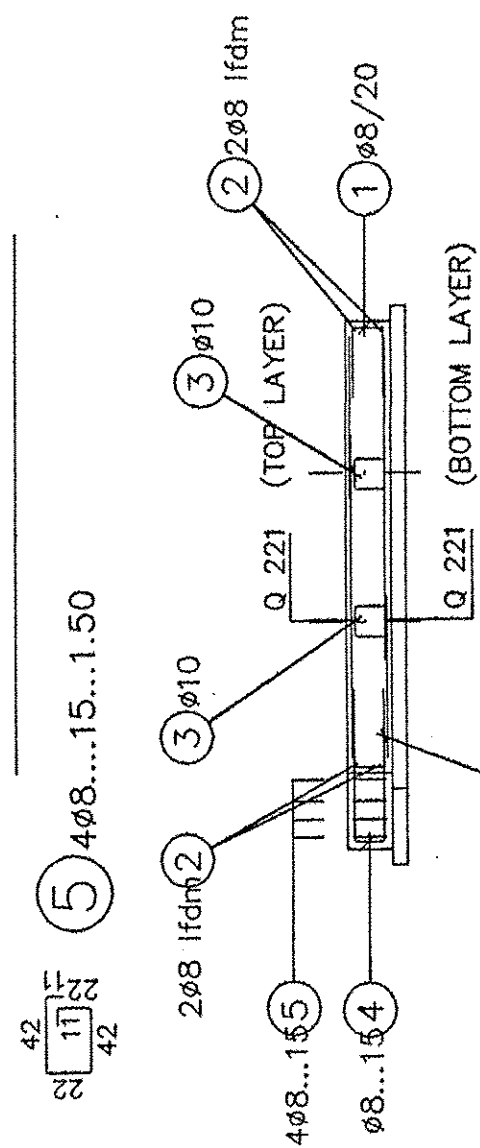

| Pos.          | Anz.   | Ø      | Länge | Bem.: |
|---------------|--------|--------|-------|-------|
| 1             | 122    | 8      | 1.10  |       |
| 2             | 1      | 8      | 60.00 | fdm   |
| 3             | 18     | 10     | 0.98  |       |
| 4             | 4      | 8      | 2.20  |       |
| 5             | 4      | 8      | 1.50  |       |
| Ø (mm)        | L (m)  | G (kg) |       |       |
| 8             | 209.00 | 82.555 |       |       |
| 10            | 17.64  | 10.884 |       |       |
| Ø (mm)        | G (kg) |        |       |       |
| 6 - 28        | 93.439 |        |       |       |
| Gesamtgewicht | 93.439 | kg     |       |       |

| Pos.          | Anz.    | Bez./Typ | Breite | Länge |
|---------------|---------|----------|--------|-------|
| 1             | 2       | Q221     | 2.15   | 5.00  |
| 2             | 2       | Q221     | 2.15   | 4.42  |
| 3             | 2       | Q221     | 1.07   | 5.00  |
| 4             | 2       | Q221     | 1.07   | 4.42  |
| Gesamtgewicht | 190.490 | kg       |        |       |

POUL VÝKRES  
SEE DRAWING-NO 7574-8  
(FORMWORK PIPE AND CABLE BRIDGE)

- 1, DŮŤKA ZEMNIAČEHO PÁŠIKU
- 2, ZEMNIAČI VODIČ

PROJEKT SKUTOČNÉHO  
VÝKRESU



HS HSV s.r.o. KOŠICE  
Technický úsek

FREIGABE  
FOR CONSTRUCTION  
S.R.A. Ra 10.11.04

MATERIAL:  
CONCRETE GRADE: B 25  
BST 500 (BST. IV)  
CONCRETE COVER - 40mm  
FOR REINFORCEMENT : 40M

Plan-Nr. : 7574-13  
SUBJECT: FORMWORK AND REINFORCEMENT  
FLOOR SLAB FOR CONTROL-BOX

|   |               |            |                  |              |            |
|---|---------------|------------|------------------|--------------|------------|
| 0   | FIRST DELIVER | 08.11.2004 | SP               | M.Oth        | checked    |
| 1   | REV           | Revisions  | Date             | Name         | checked    |
| Dipl.-Ing. Mithhäuser<br>Dipl.-Ing. Welsch<br><b>KMM</b><br>Saurbrücker Strasse 9 - 10<br>66130 SAARBRÜCKEN-BREBACH<br>Tel.: (0681) 98313-0 Fax: (0681) 9831338 |               |            |                  |              |            |
| Date:   | 05.11.2004    | Name:      | Speicher         | Scale:       | 1:50 1:200 |
| Job code:   | K70101        | Reference: | ASU No. 9 KOSICE | Sheet:       | A1         |
| Released by:  | 79            | Title:     | CONTROL-BOX      | Drawing No.: | 792.87051  |
| Revised by:   | 79            |            |                  |              |            |

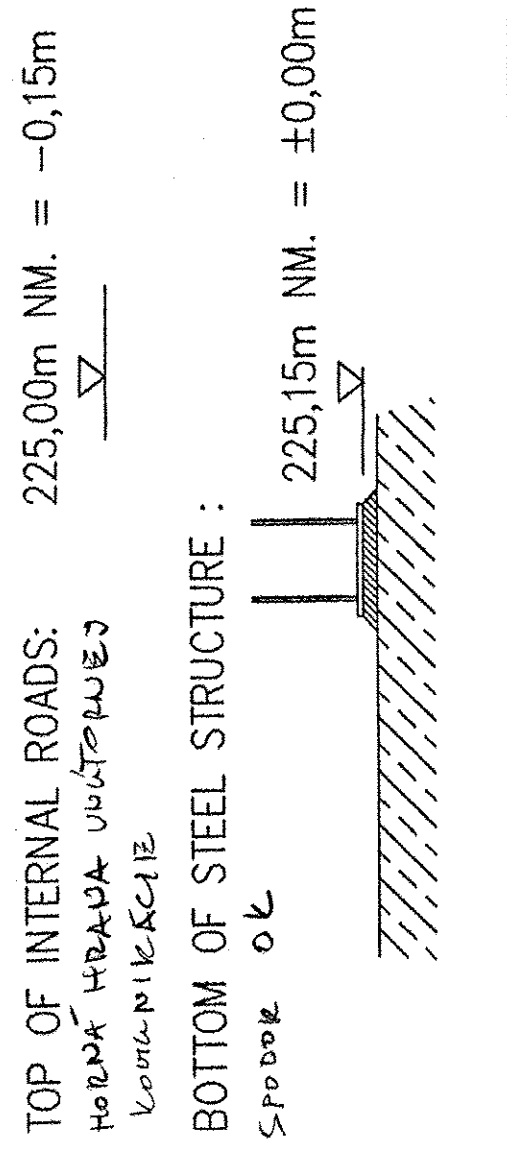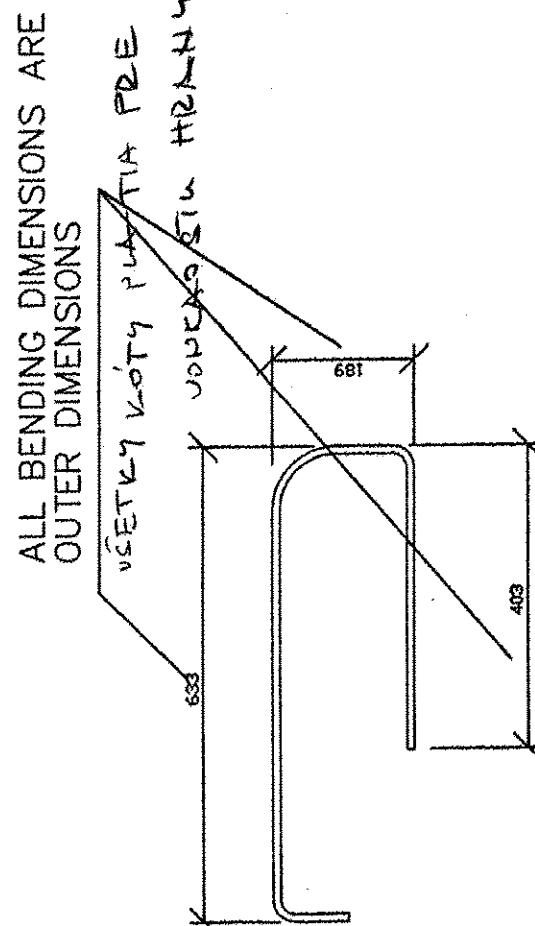

VÁŽEJTE SPRACOVANIE BETÓNU - PODA STU  
SUBSEQUENT TREATMENT OF CONCRETE ACC. TO PARTICULAR  
SLOVAKIAN REGULATIONS.

REQUIRED FOUNDATION PRESSURE  
APPROVAL = 250 KN/m?  
APPROVED MASS TOLERANCE ±0.5cm OF CONCRETE  
CONCRETE GRADE : B 25

- LEVEL OF STRUCTURE - WITHOUT FINISH
- LEVEL OF STRUCTURE - WITH FINISH
- LEVEL OF STRUCTURE WITHOUT FINISH =
- LEVEL OF STRUCTURE WITH FINISH