



PŌDORYS ZAKLADOV/PLANE OF FOUNDATIONS

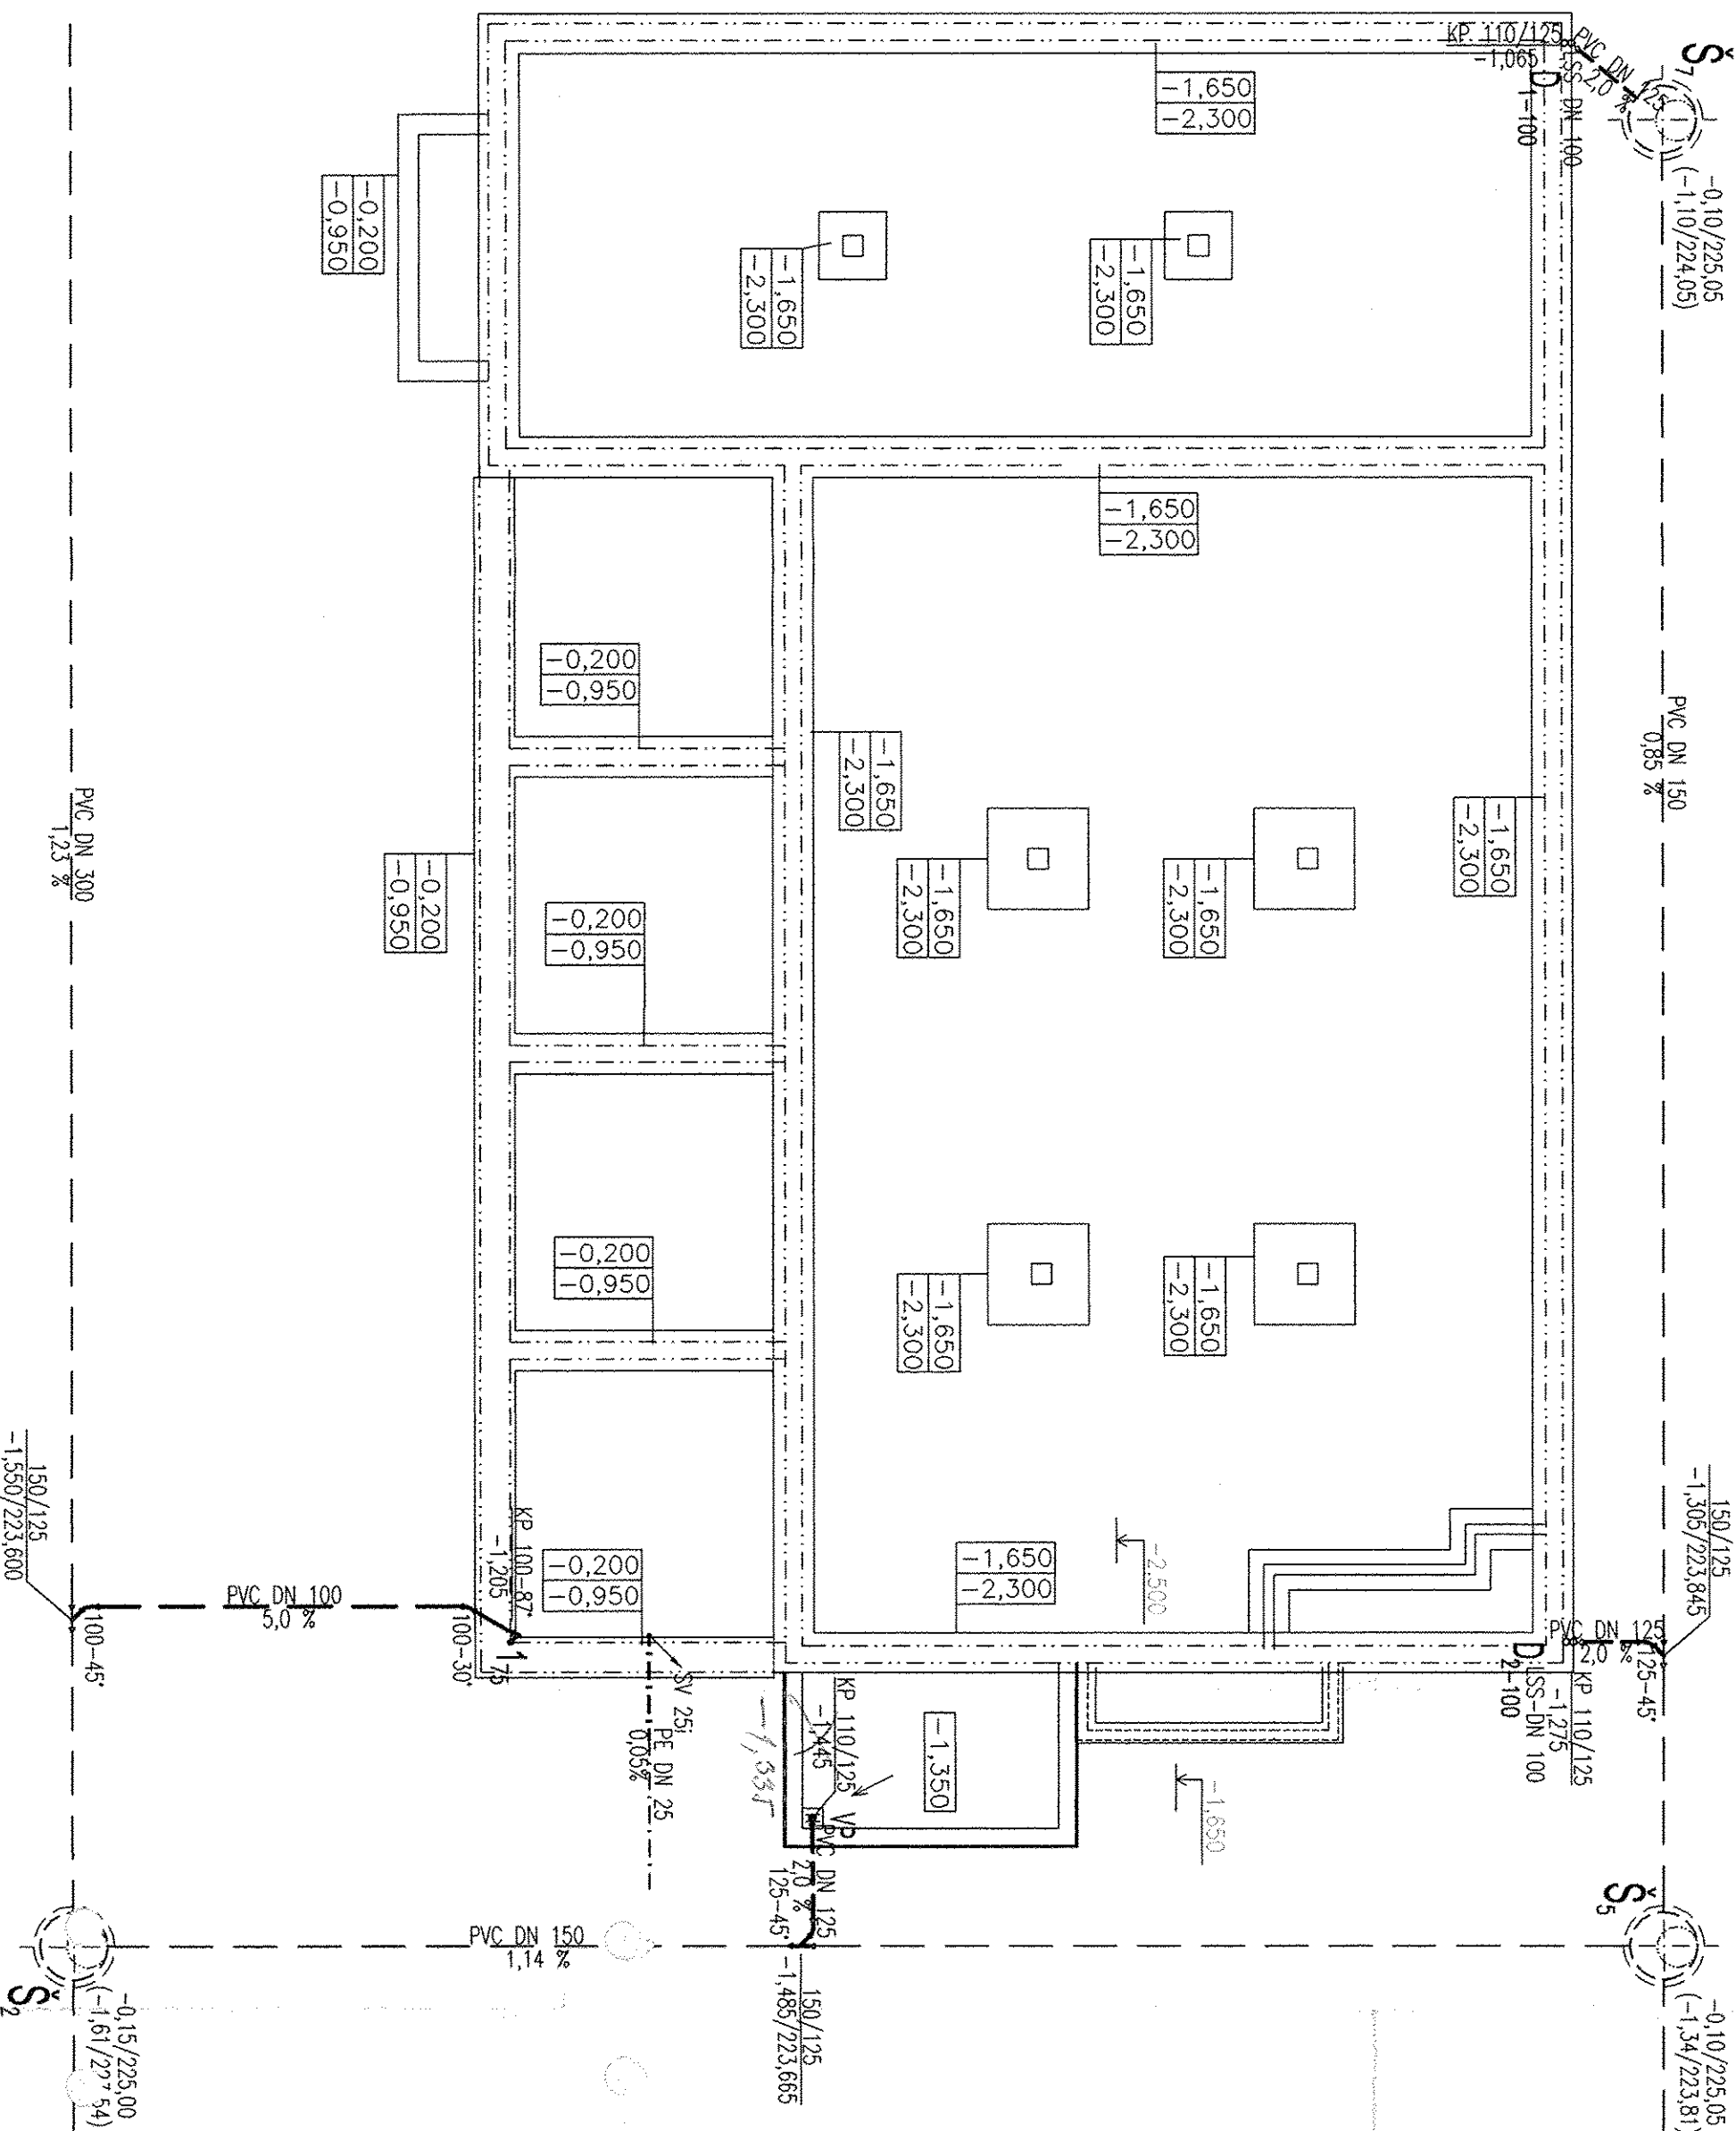

PROJEKT SKUTOČNÉHO
VYHOVENIA

PLANT
NORTH

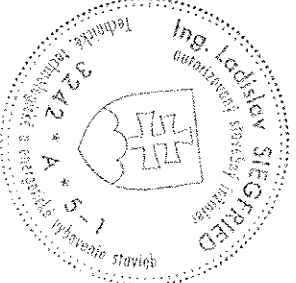

±0.000=225.150m.n.m
SPRACOVANÉ POD ZÁKAZKOVÝM ČÍSLOM:158/2004/SO/



REFLEX-PRO spol. s r.o.		ING. SIEGFRIED		ING. SIEGFRIED		ING. SIEGFRIED	
AIR LIQUIDE		ING. SIEGFRIED		ING. SIEGFRIED		ING. SIEGFRIED	
Air Liquide AGS GmbH		ING. SIEGFRIED		ING. SIEGFRIED		ING. SIEGFRIED	
Replaces: 792.87412		ING. SIEGFRIED		ING. SIEGFRIED		ING. SIEGFRIED	
Replaced by: 792.87412		ING. SIEGFRIED		ING. SIEGFRIED		ING. SIEGFRIED	
Title: ROZVODNÁ T81/ELECT. ROOM T81		ING. SIEGFRIED		ING. SIEGFRIED		ING. SIEGFRIED	
ZBRAVOTECHNICKÁ INŠTALÁCIA/PUBLIC HEALTH ENGINEERING		ING. SIEGFRIED		ING. SIEGFRIED		ING. SIEGFRIED	
Job code: K 70101		ING. SIEGFRIED		ING. SIEGFRIED		ING. SIEGFRIED	
Reference: ASU No.9 KOSICE		ING. SIEGFRIED		ING. SIEGFRIED		ING. SIEGFRIED	
Scale 1:100		ING. SIEGFRIED		ING. SIEGFRIED		ING. SIEGFRIED	
Drawing No.: 792.87412		ING. SIEGFRIED		ING. SIEGFRIED		ING. SIEGFRIED	
Rev. A		ING. SIEGFRIED		ING. SIEGFRIED		ING. SIEGFRIED	