



REZ 1-1/SECTION 1-1

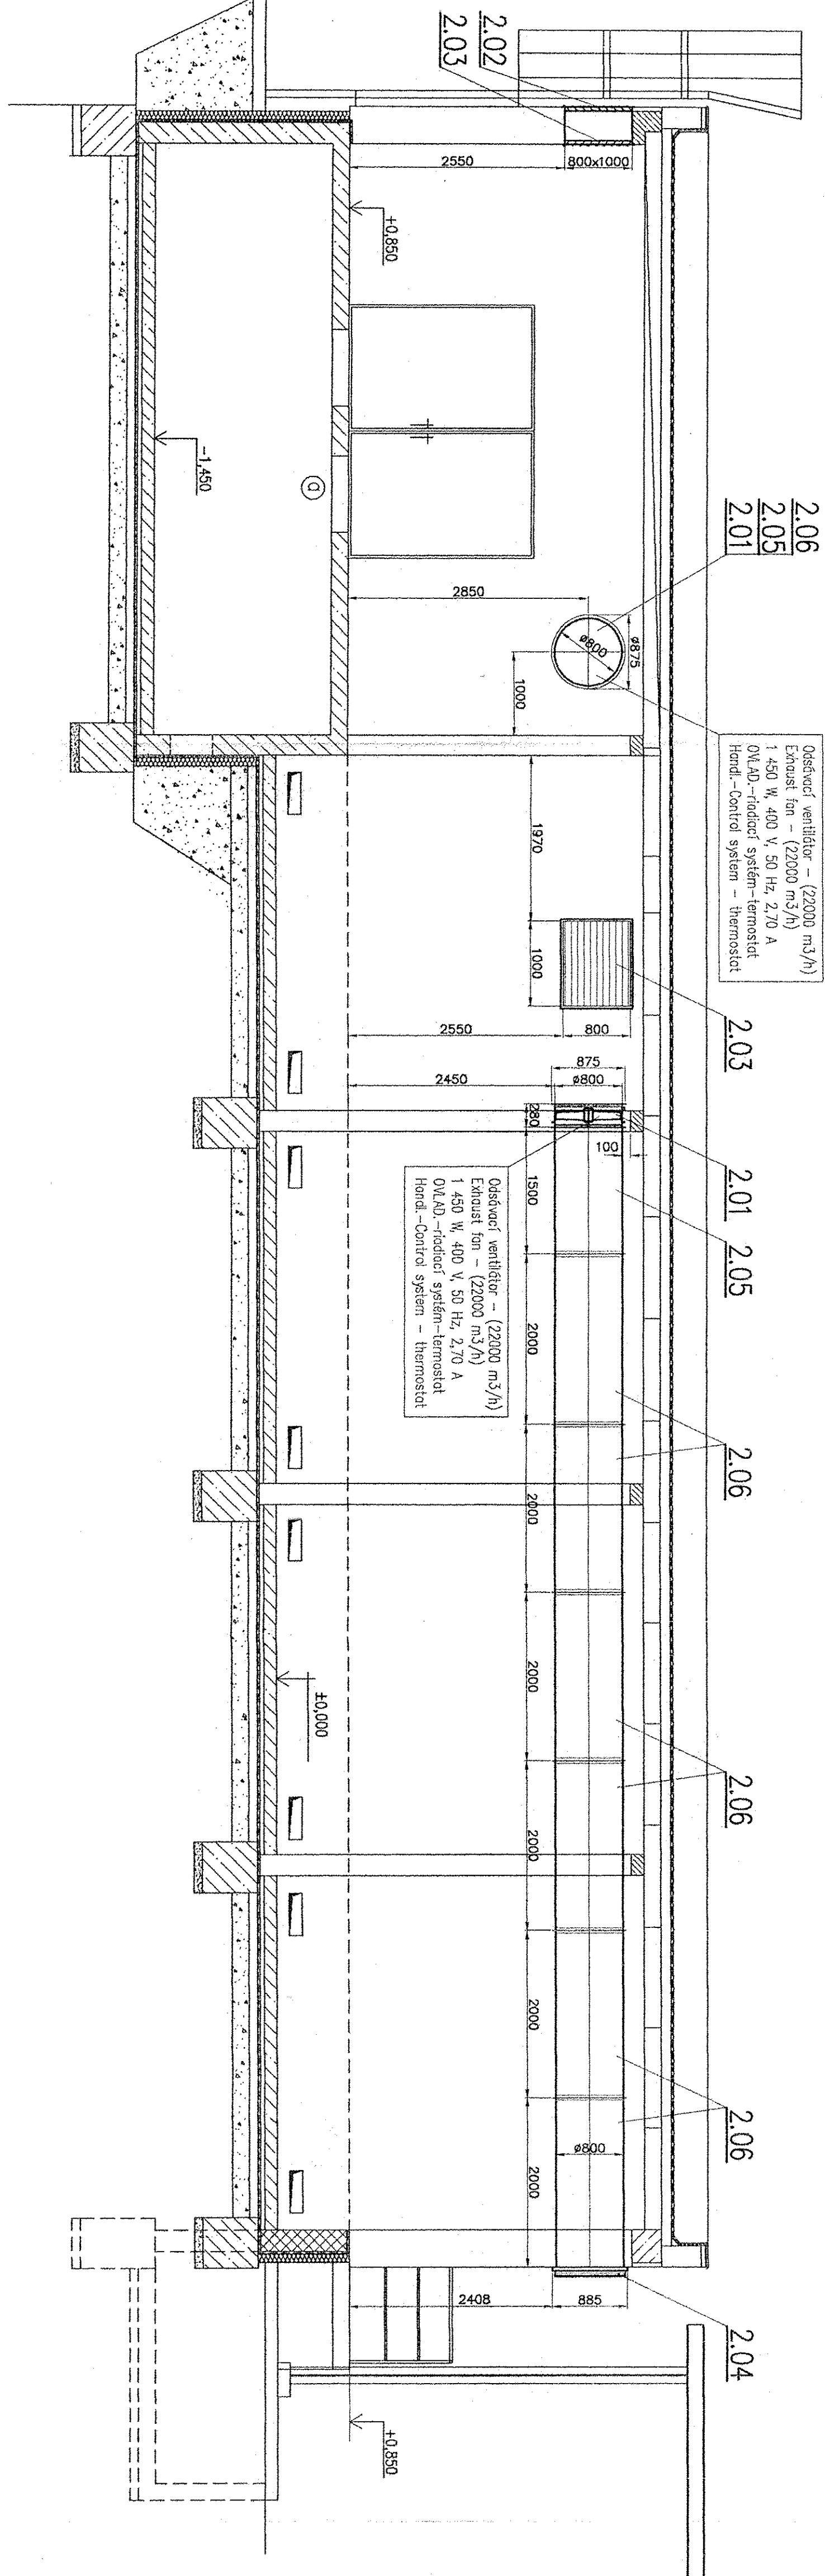

REZ 2-2/SECTION 2-2

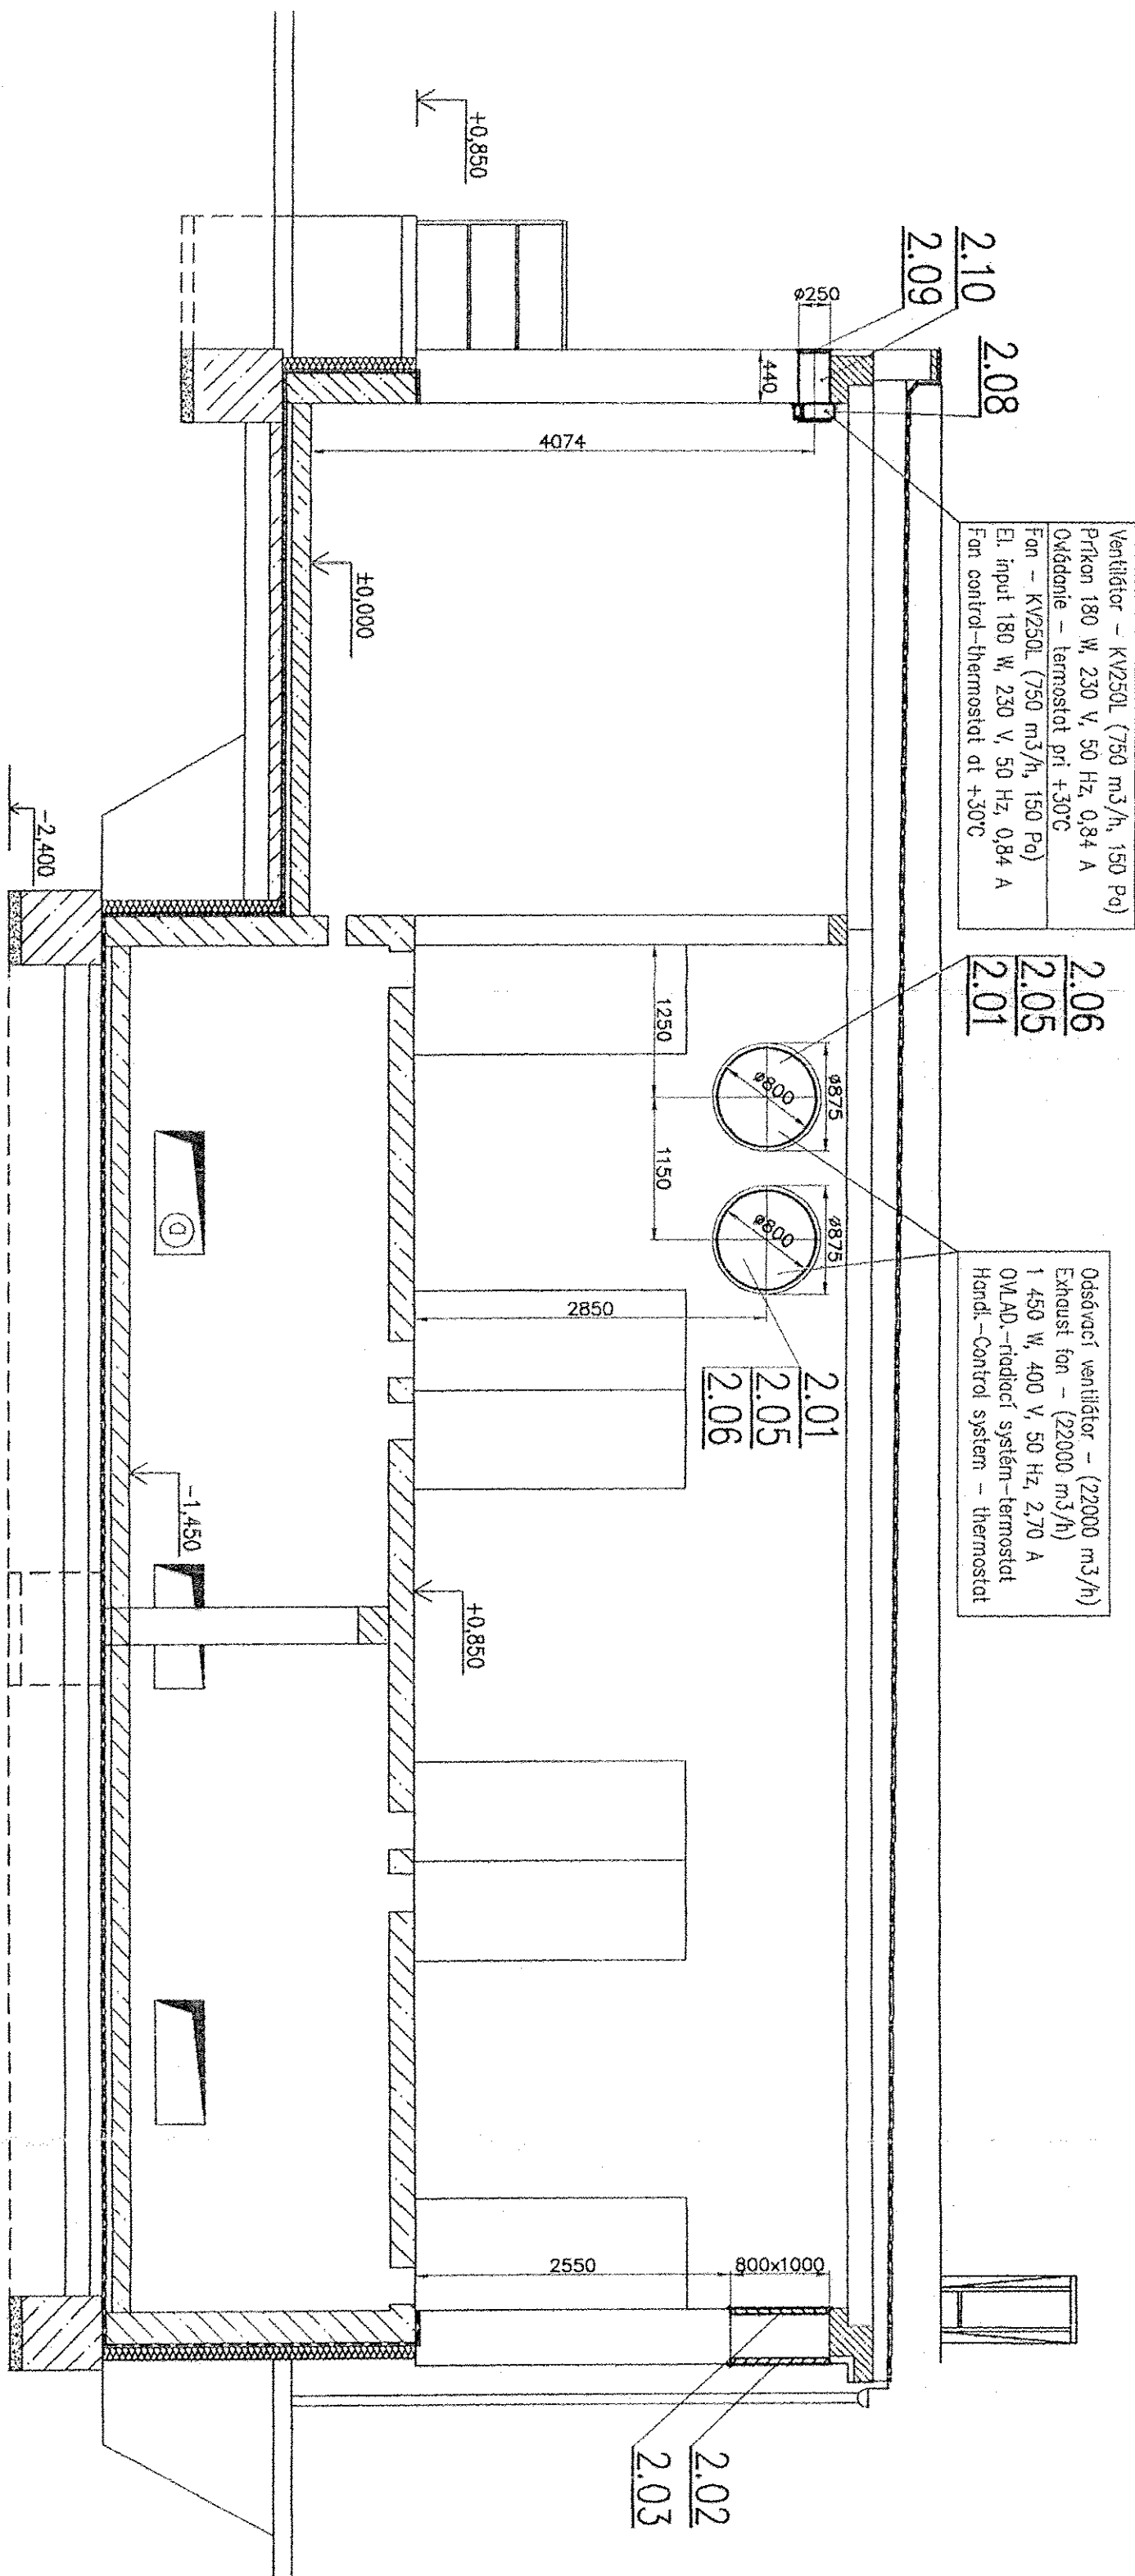

This drawing is protected by copyright.
It may not be copied or used without our written
authorization and it is strictly prohibited
to disclose it to any third parties.

±0,000=225,150m.n.m

SPRACOVANÉ POD ZAKAZKOVÝM ČÍSLOM:138/2004/50/

10

AIR LIQUIDE		Name :		Checked:		History file:		Rev.	
Job code: K 70101		Inch:		Inch:		Scale 1:50		Original format DIN A1	
Reference: ASU No.9 KOSICE		Sheet: ---		Drawing No.:		Rev.		0	
Title: ROZNOUŠNÁ 181 /ELECTRICAL ROOM 181		VZDUCHOVÉNIKA/VENTILATION		792.87421		0			

FREIGABE
FOR CONSTRUCTION

PROJEKT SKUTOČNÝ
VÝKONOVANÝ

