

VÝKOPY/EXCAVATIONS

POZNÁMKY/NOTES

- ZEMINA ŤAŽITELNOSTI 3
- K VÝKOPOVÝM PRÁCAM JE NUTNÉ PRIZVAŤ MAJITEĽOV
- VŠETKÝCH PODZEMNÝCH ROZVODOV K ICH VYTÝČENIU
- TOWARD GENERAL SITE EXCAVATION IS URGENT CALL UP PROPRIETORS UNDERGROUND WIRING TOWARD LAYOUT
- VÝKOP Z SO 55 JE NUTNÉ ZASYPAT KAMENIVOM FRAKCIOU 0-63 V HR.0,20m.ZHUTNIŤ NA $E_{ref}=50MPa$
- CUTTING FROM OBJECT 55 STRIPE TO BE REFILLED BY STONY GRAVEL 0-63mm IN THICKNES 0,20m
- FILL TO BE FIRMEDE $E_{ref}=50MPa$
- ROZMERY VÝKOPU PŮ SO 55 SÚ
- LEN INFORMATIVE,VÝKOP MÔŽE BYŤ VÄČŠÍ
- PROPORTIONS OF CUTTING IN OBJECT 55
- ARE ONLY INFORMATION,CUTTING CAN BY BIGGER


PROJEKT SKUTOČNÉHO

VÝKOPOVENIA

FREE GABE

FOR CONSTRUCTION

Ra 15.04.05

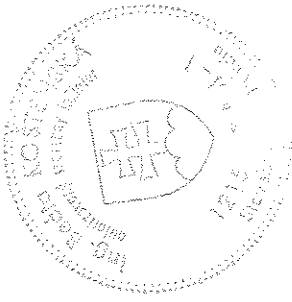

H&S s.r.o. KOSICE
Technický úsek


PLANT NORTH

$\pm 0,000 = 225,150m.n.m$

SPRACOVANÉ POD ZÁKAZKOVÝM ČÍSLOM:158/2004/SO/

LEVELS

TOP OF INTERNAL ROADS: 225,00m n.m.
TOP OF FOUNDATION: 225,10m
BOTTOM OF STEEL STRUCTURE: 225,15m = $\pm 0,00$

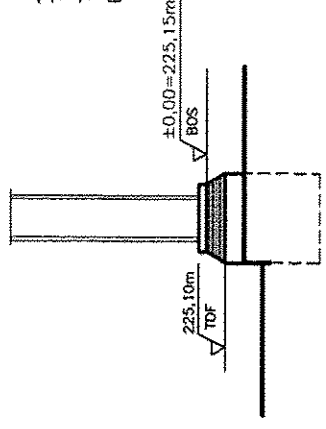

AIR LIQUIDE

Air Liquide ACS GmbH

Replaces: 79...
Replaced by: 79...

APRIL 2005	ING.KOŠŤENSKÁ	ING. RAČEK	ZMENA TVARU VÝKOPOV MODIFICATION OF FASHION EXCAVATIONS	B
MAREC 2005	ING.KOŠŤENSKÁ	ING. RAČEK	ZMENA TVARU VÝKOPOV MODIFICATION OF FASHION EXCAVATIONS	A
Date :	Name :	Checked:	History file:	Rev.
10.02. 2005	ING.KOŠŤENSKÁ	ING. RAČEK		0
Job code: K 70101	Scale 1:100	Original format DIN A3	Sheet: --- of ---	Sheets
Reference: ASU No.9 KOSICE	Drawing No.: 792.87372	Rev. B		
Title: VELÍN CONTROL BUILDING VÝKOPY/EXCAVATIONS				

This drawing is protected by copyright.
It may not be copied or used without our written
authorization and it is strictly prohibited
to disclose it to any third parties.