


Essener Hochdruck-
Rohrleitungsbau
Original
10. OKT. 2005
ist in rot gestempelt

Original
10. OKT. 2005
ist in rot gestempelt

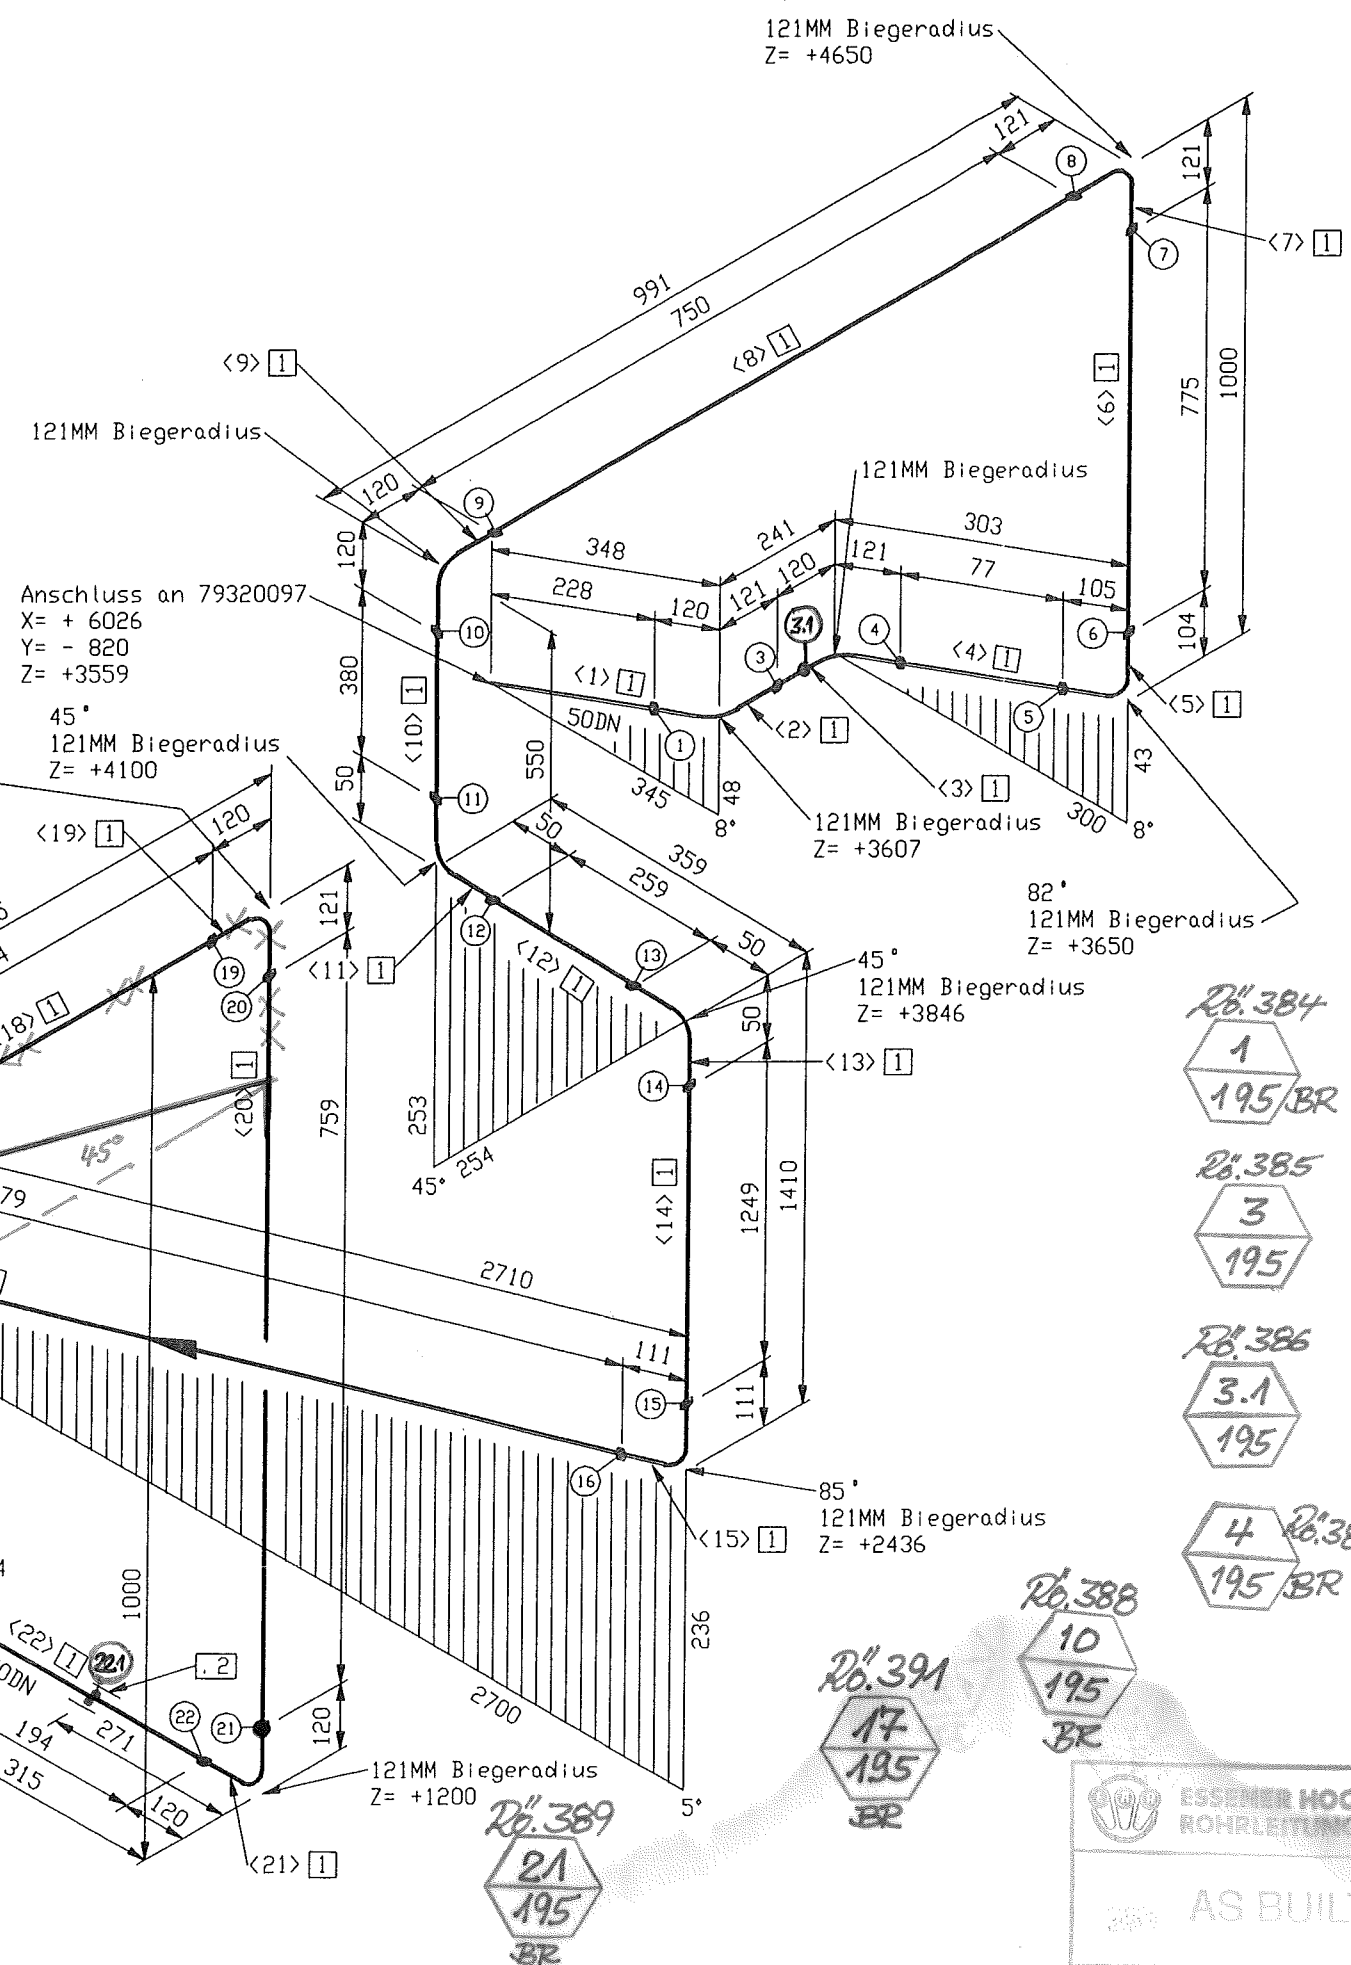


Stückliste

Lfd Nr.	Benennung	DN (MM)	Sachnummer	Menge	Gewicht (kg)
1	RDHR 60,3 X 3,9 ALMG4,5MN W27	50	77038146	9119 MM	17.0
2	Bordscheibe gez. auf 79313040	50	79313042	1	0.6
Summe Masse					17.6

Rohrzuschnitt

Rohr Stk.	Länge (MM)	DN (MM)	Bemerkung	Rohr Ende 1	Rohr Ende 2	Sachnummer
<1>	228	50				77038146
<2>	189	50	PLD BEND(1)			77038146
<3>	189	50	PLD BEND(1)			77038146
<4>	77	50				77038146
<5>	172	50	PLD BEND(1)			77038146
<6>	775	50				77038146
<7>	190	50	PLD BEND(1)			77038146
<8>	750	50				77038146
<9>	188	50	PLD BEND(1)			77038146
<10>	380	50				77038146
<11>	95	50	PLD BEND(1)			77038146
<12>	259	50				77038146
<13>	95	50	PLD BEND(1)			77038146
<14>	1249	50				77038146
<15>	180	50	PLD BEND(1)			77038146
<16>	2479	50				77038146
<17>	189	50	PLD BEND(1)			77038146
<18>	104	50				77038146
<19>	189	50	PLD BEND(1)			77038146
<20>	759	50				77038146
<21>	188	50	PLD BEND(1)			77038146
<22>	195	50				77038146

pipng support, piping guides
View from top

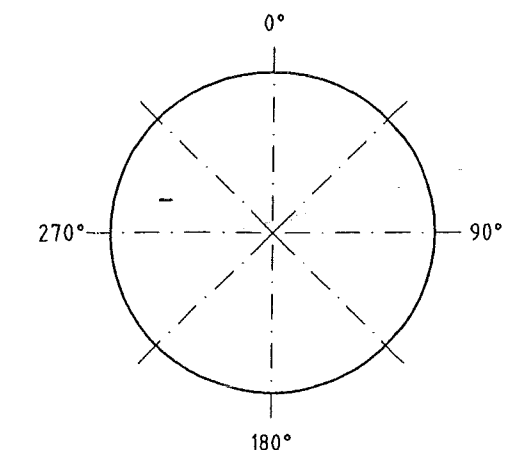

Rohr DN (MM) 50
CL Länge (MM) 9120

E			MATERIAL: HANAU AL		All components cleaned for oxygen	
D			Workpiece edges		TOLERANCES:	
C			-0.5		DN 28005	
B			outside		DN 8570	
A			inside		DN 7168 mittel	
I			ISO-Methode E		DATE: 06.09.2005	
Rev. No.			Date		NAME: H.Schneider	
By					CHECK: Frickhöfer 06/09/05	
This drawing is not to be reproduced, copied or used directly or indirectly in any way detrimental to our interests unless specifically authorized in writing by			JOB CODE / REFERENCE:		SHEET: 1 OF SHEET: 1	
Air Liquide AGS GmbH Hanau			K70101, ASU No.9 Kosice		DRAWING No.: 79319782	
			Title: 61103		F Z C	