



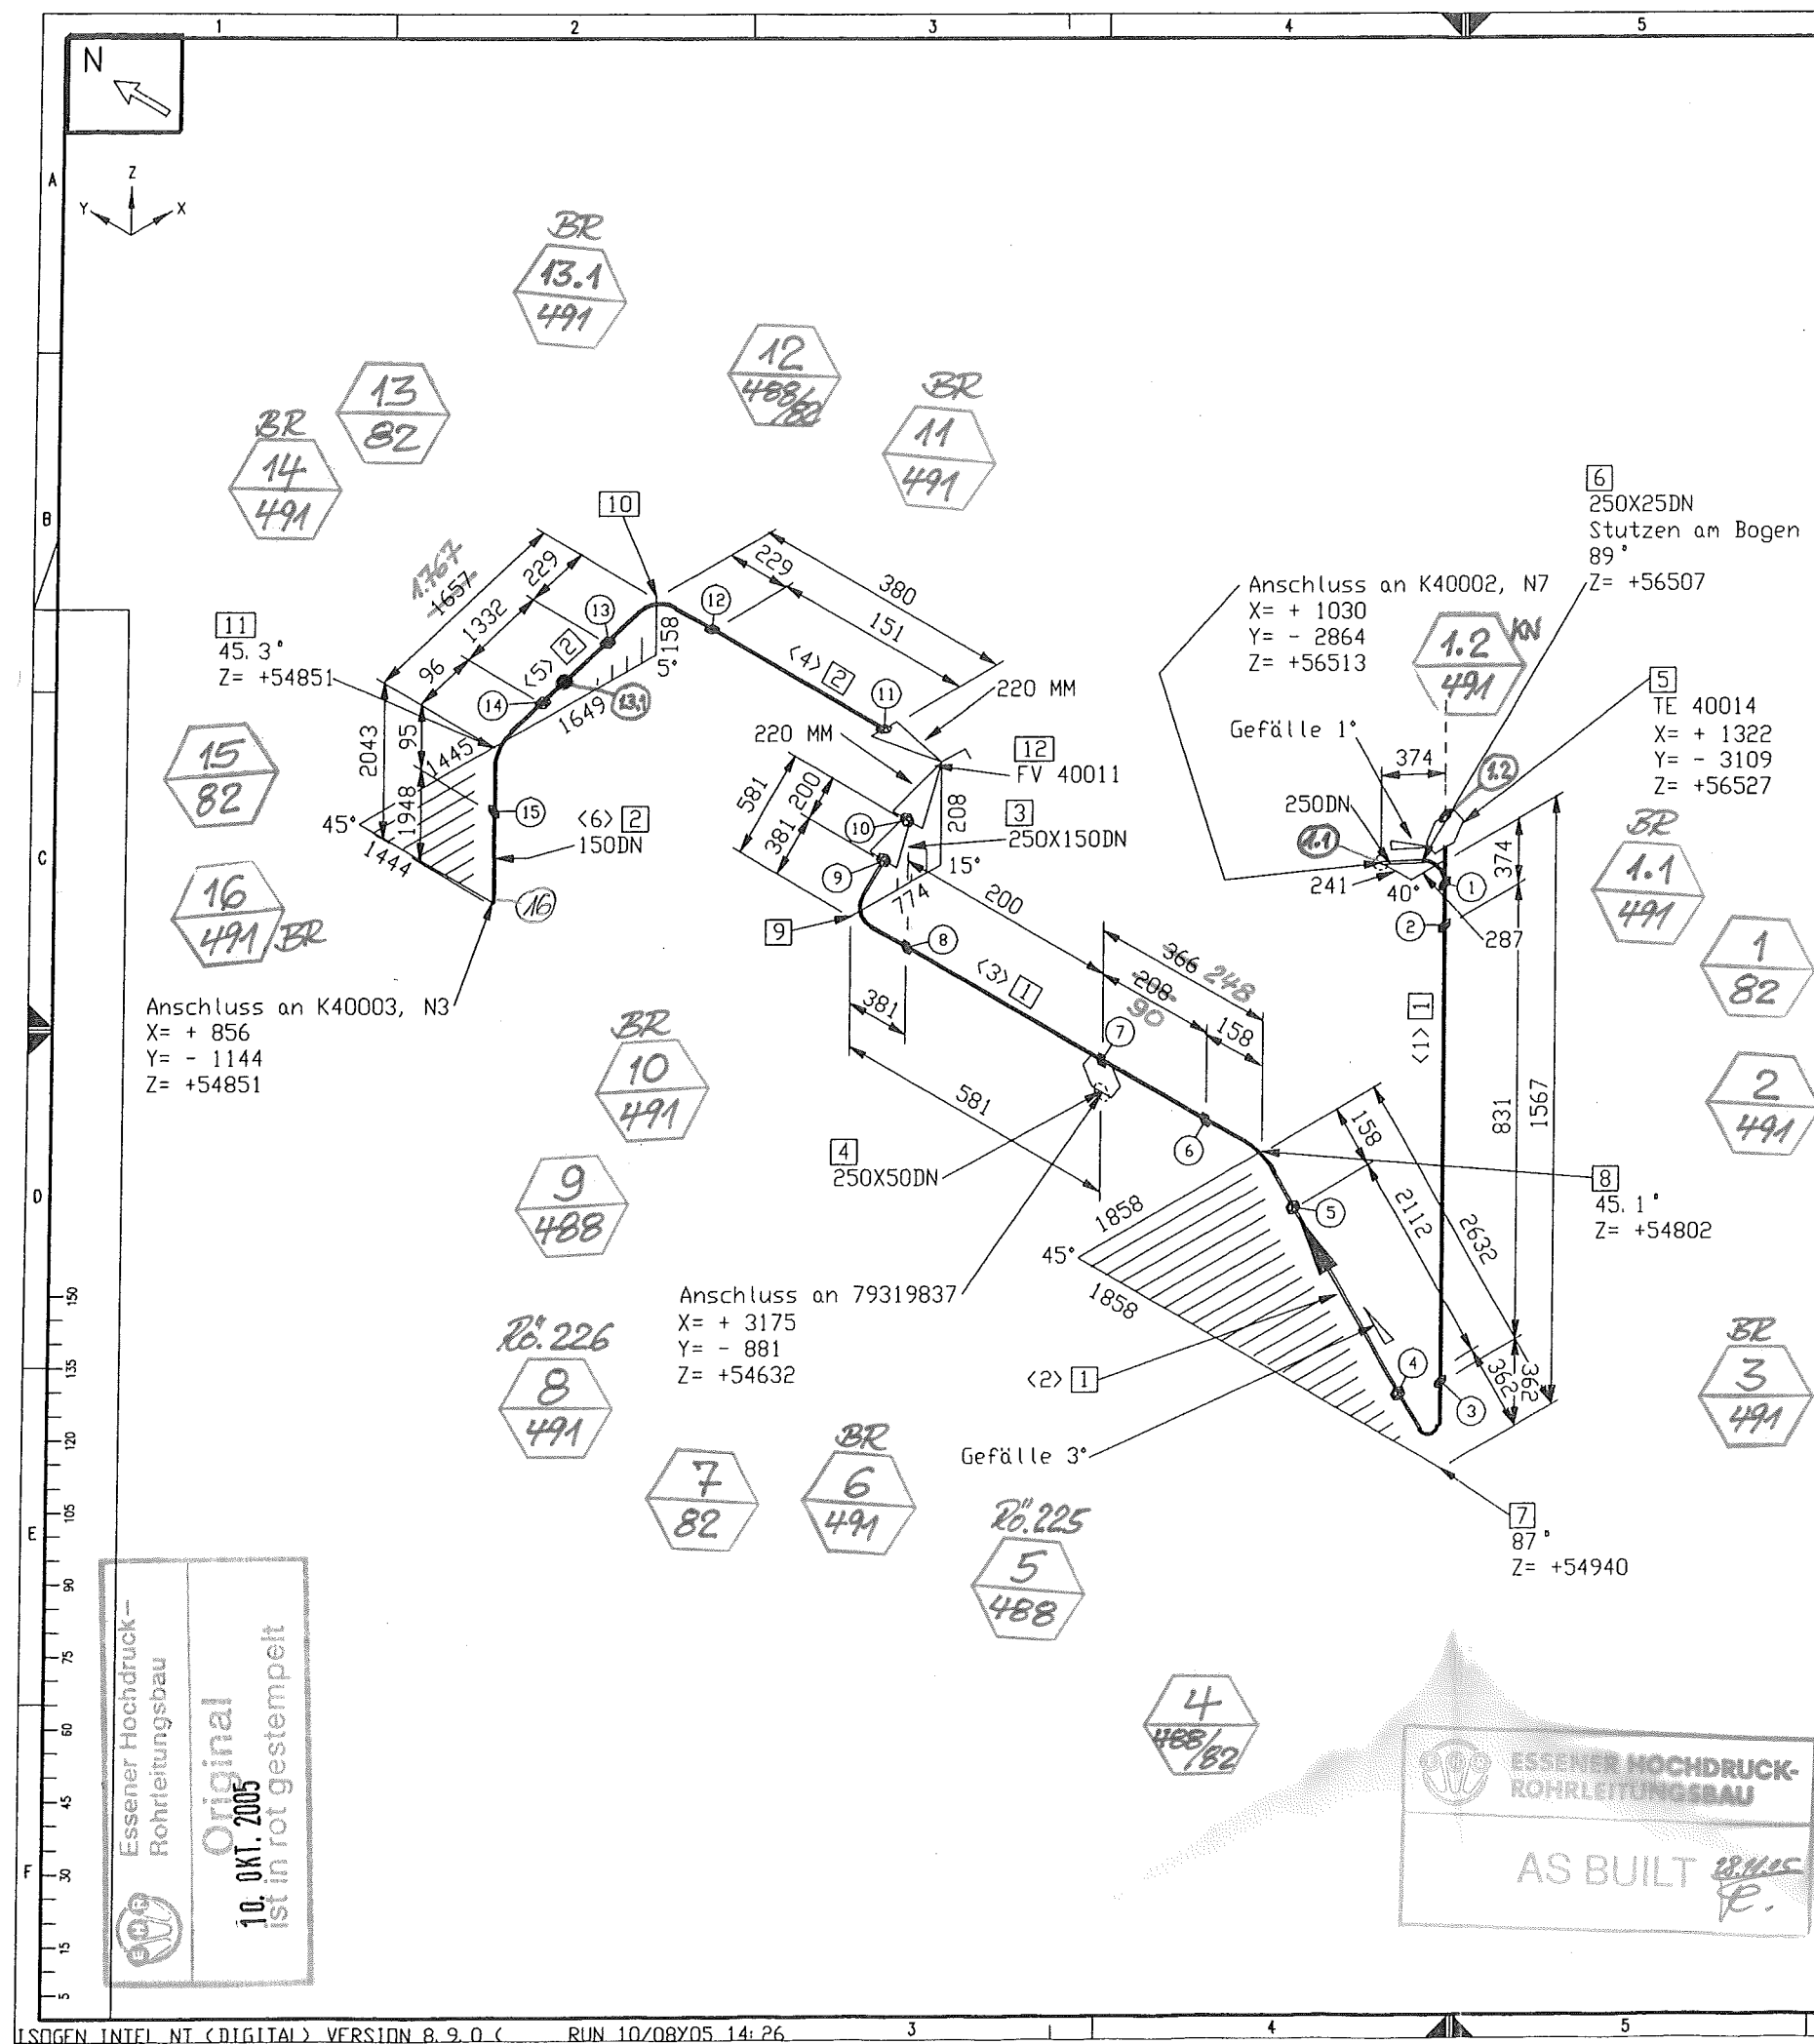

Stückliste						
Lfd Nr.	Benennung	DN (MM)	Sachnummer	Menge	Gewicht (kg)	
Rohr						
1	ROHR 273 X 4 ALMG4, 5MN W27	250	77038152	3351 MM	30.6	
2	ROHR 168,3 X 7,1 ALMG4, 5MN W27	150	77038150	3431 MM	33.3	
Fitting						
3	RED. -STÜCK-K-273,0 x 6,0-168,3 x 6,0 gez. auf 79312884	250X150	79316266	1	2.3	
4	T-Stutzen 273x4 - 60,3x3,9 gez. auf 79311532	250X50	79314088	1	0.1	
5	THERMOMETEREINBAU AB DN125	250X25	79312132	1	0.3	
6	BOGEN 273 x4 DIN2605-2-90-3 ALMG4, 5MN Stutzen auf 89	250	77038160_3	1	5.5	
7	BOGEN 273 x4 DIN2605-2-90-3 ALMG4, 5MN Stutzen auf 87	250	77038160_2	1	5.5	
8	BOGEN 273 x4 DIN2605-2-90-3 ALMG4, 5MN Stutzen auf 45.08	250	77038160_1	1	5.5	
9	BOGEN 273 x4 DIN2605-2-90-3 ALMG4, 5MN	250	77038160	1	5.5	
10	BOGEN 168,3x7,1 DIN2605-2-90-3 ALMG4, 5MN	150	77038158_1	1	3.5	
11	BOGEN 168,3x7,1 DIN2605-2-90-3 ALMG4, 5MN Stutzen auf 45.26	150	77038158	1	3.5	
Ventil						
12	Eck-Ventil AL DN 150 / PN 40 (Kümmen)	150	77038869	1	100.0	
Summe Masse					195.4	

Rohrzuschnitt						
Rohr Stk.	Länge (MM)	DN (MM)	Bemerkung	Rohr Ende 1	Rohr Ende 2	Sachnummer
<1>	831	250				77038152
<2>	2112	250				77038152
<3>	408	250				77038152
<4>	151	150				77038150
<5>	1332	150				77038150
<6>	1948	150				77038150

pipng support, piping guides
View from top

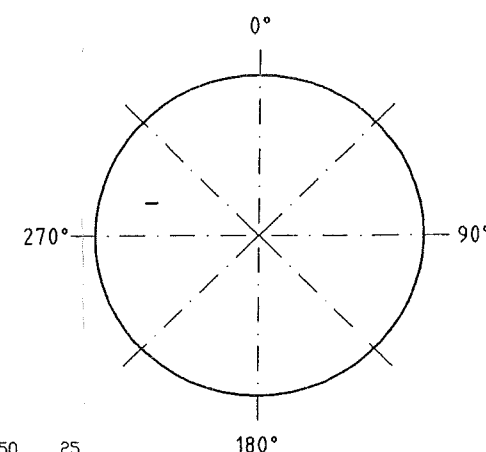

Rohr DN (MM)	250	150	50	25
CL Länge (MM)	6101	4520	170	44

E		MATERIAL: HANAU AL		All components cleaned for oxygen	
D		Workpiece edges		SCALE	
C		-0.5		TOLERANCES:	
B		outside		DN 28005	
A		inside		DN 8570	
1	Rev. No.	Date	By	DATE: 10.08.2005	
ISO-Methode E				NAME: H.Schneider	
This drawing is not to be reproduced, copied or used directly or indirectly in any way detrimental to our interests unless specifically authorized in writing by				CHECK: Frickhöfer 10/08/05	
Air Liquide ACS GmbH Hanau				JOB CODE / REFERENCE:	
				K70101, ASU No.9 Kosice	
				Title:	
				RL 40003	
				SHEET: 1 OF SHEET: 1	
				DRAWING No:	
				79319823	
				F Z	
				C	