



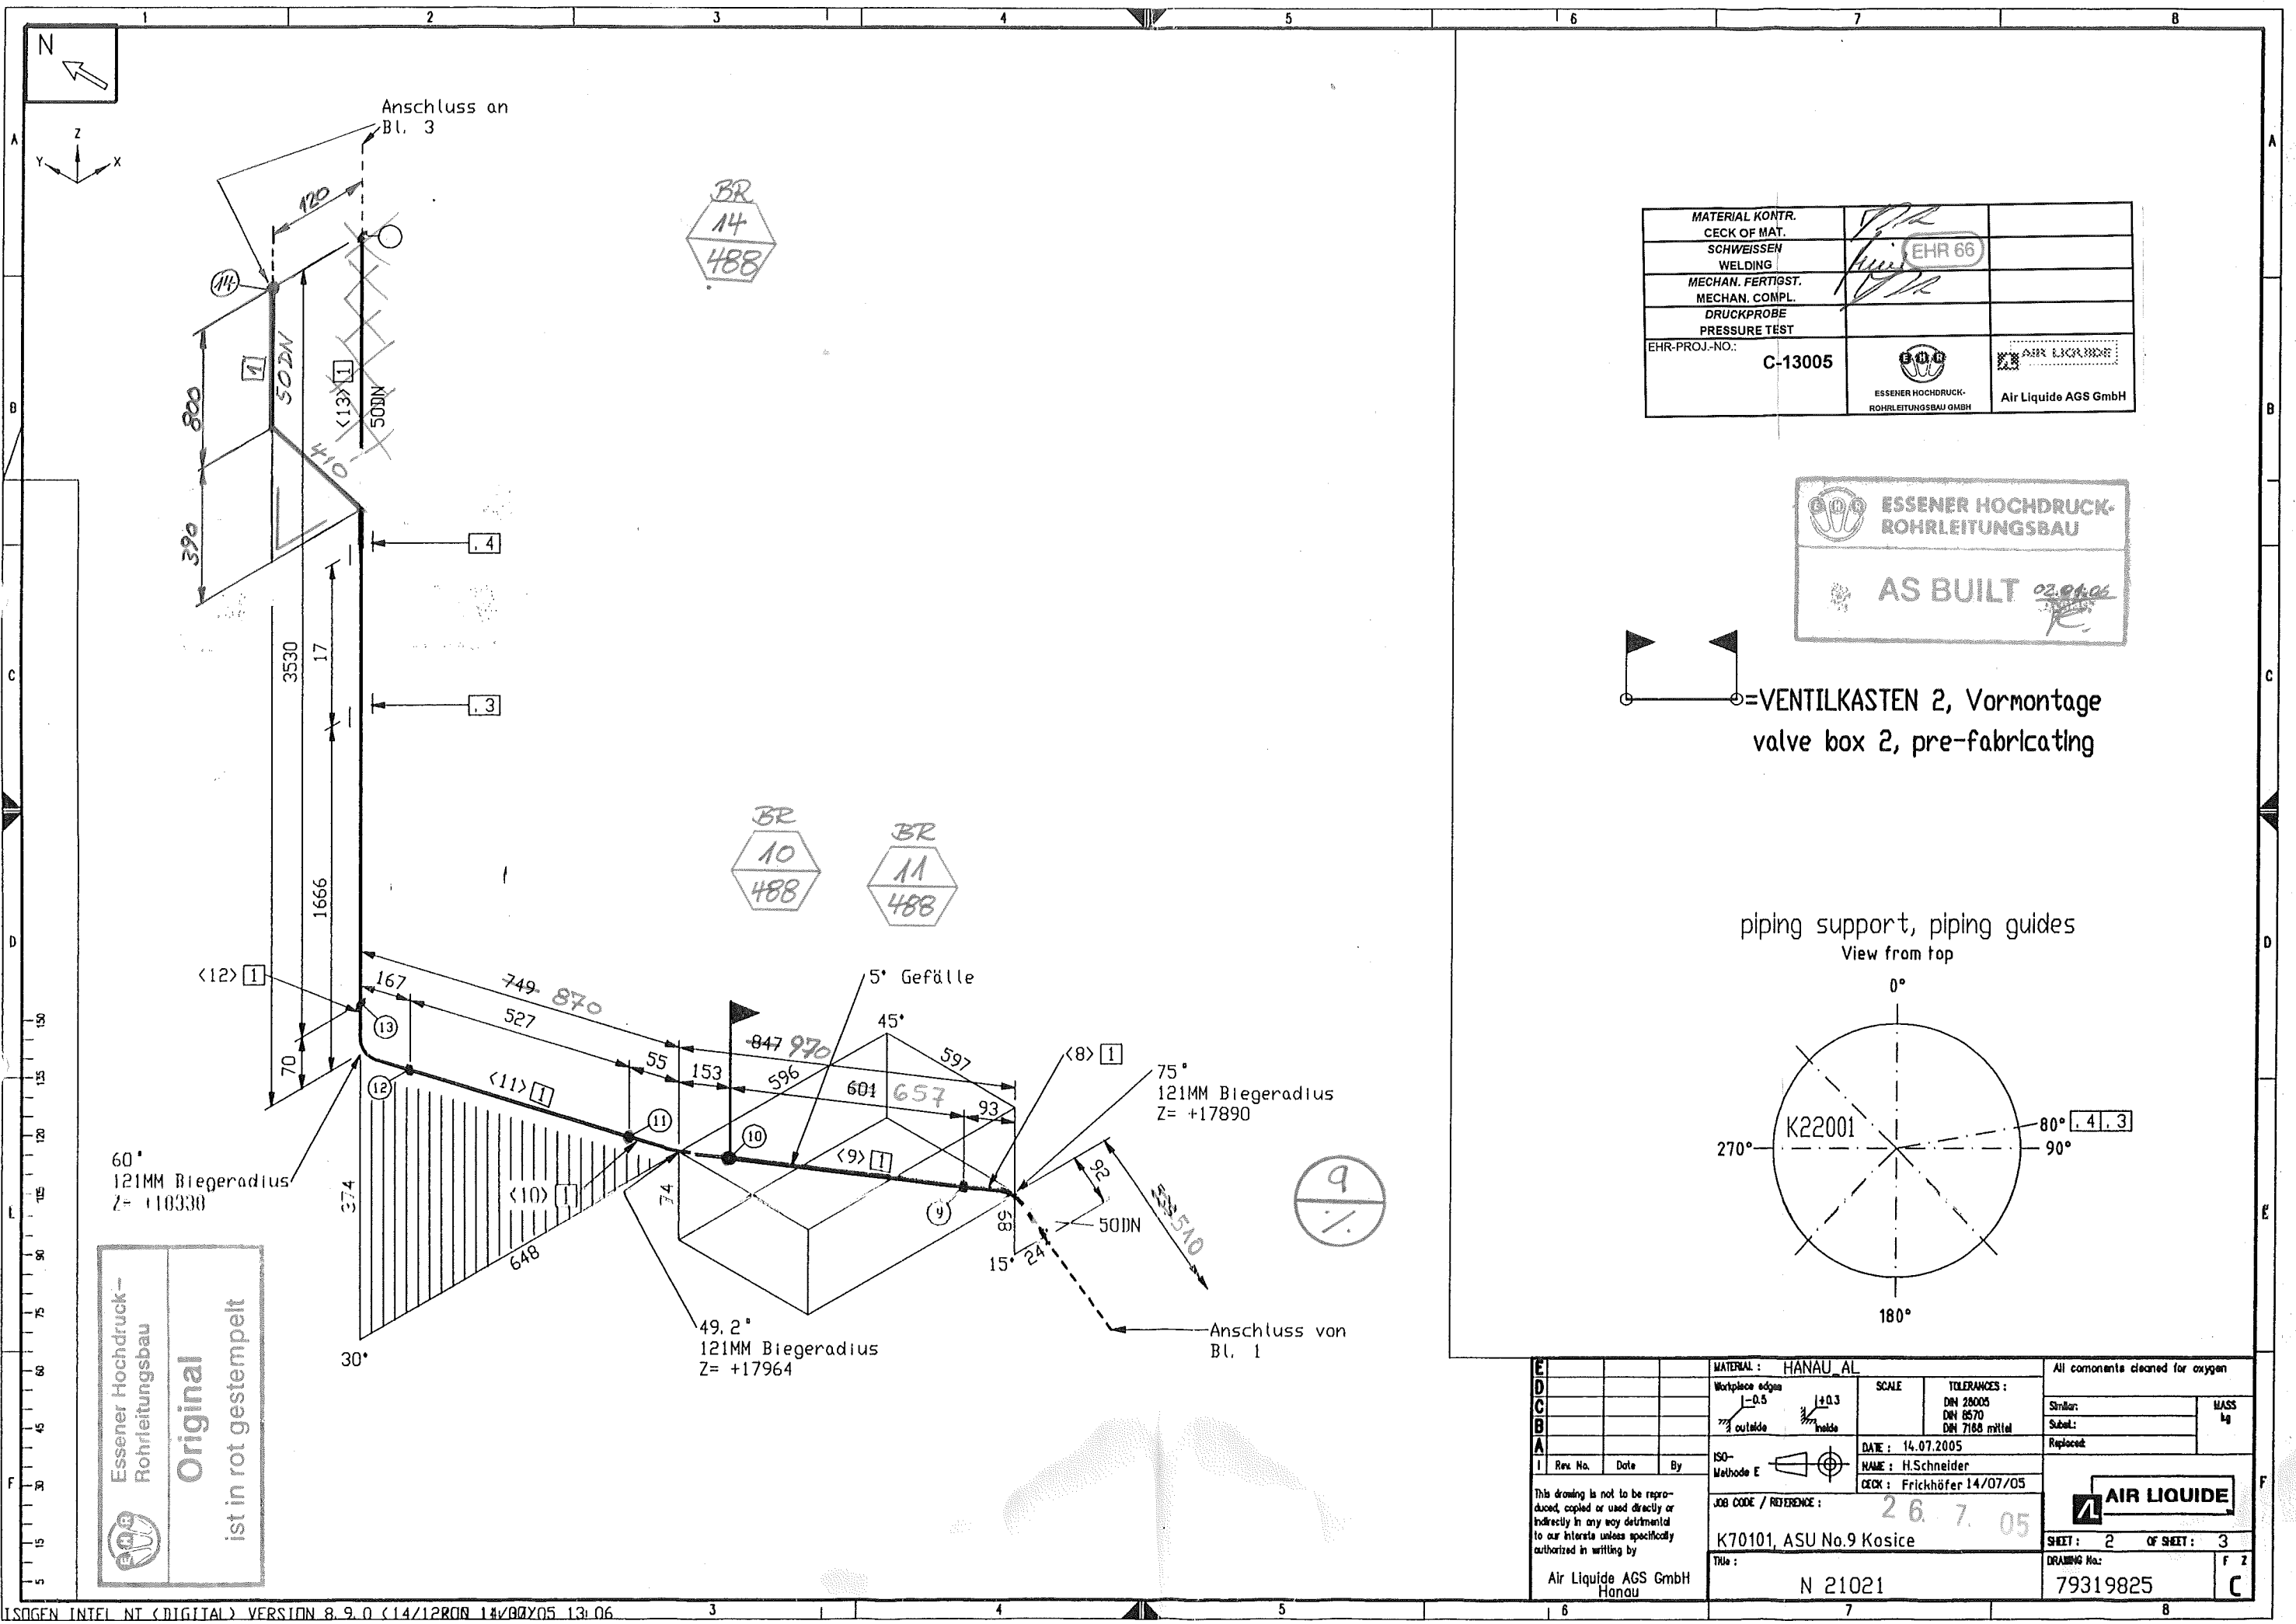


MATERIAL KONTR.		
CECK OF MAT.		
SCHWEISSEN		
WELDING		
MECHAN. FERTIGST.		
MECHAN. COMPL.		
DRUCKPROBE		
PRESSURE TEST		
EHR-PROJ.-NO.:	C-13005	

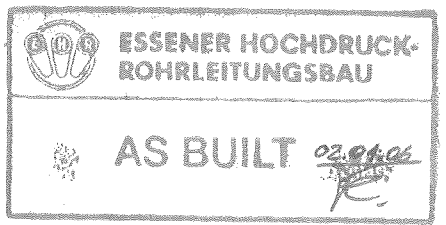

= VENTILKASTEN 2, Vormontage
valve box 2, pre-fabricating

piping support, piping guides
View from top

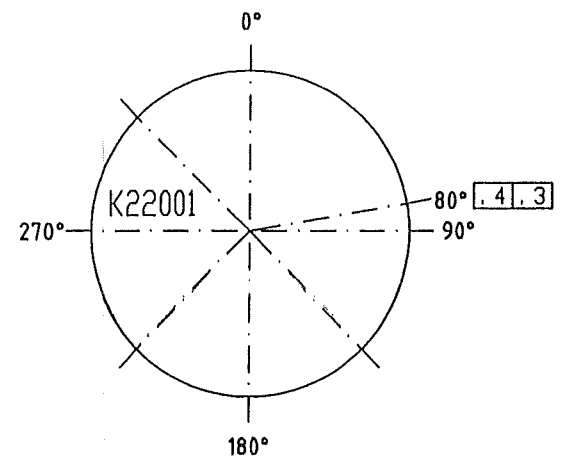

Essener Hochdruck-
Rohrleitungsbau
Original
ist in rot gestempelt

MATERIAL : HANAU AL				All components cleaned for oxygen	
Workpiece edges 1-0.5		SCALE		TOLERANCES :	
2 outside		1/0.3		DIN 28005	
ISO- Methode E		DATE : 14.07.2005		Similar:	
NAME : H.Schneider		CHECK : Frickhöfer 14/07/05		Subst.:	
JOB CODE / REFERENCE :		26.7.05		Replaced:	
K70101, ASU No.9 Kosice		AIR LIQUIDE		SHEET : 2 OF SHEET : 3	
Title :		N 21021		DRAWING No.:	
Air Liquide AGS GmbH Hanau		79319825		F 2	