


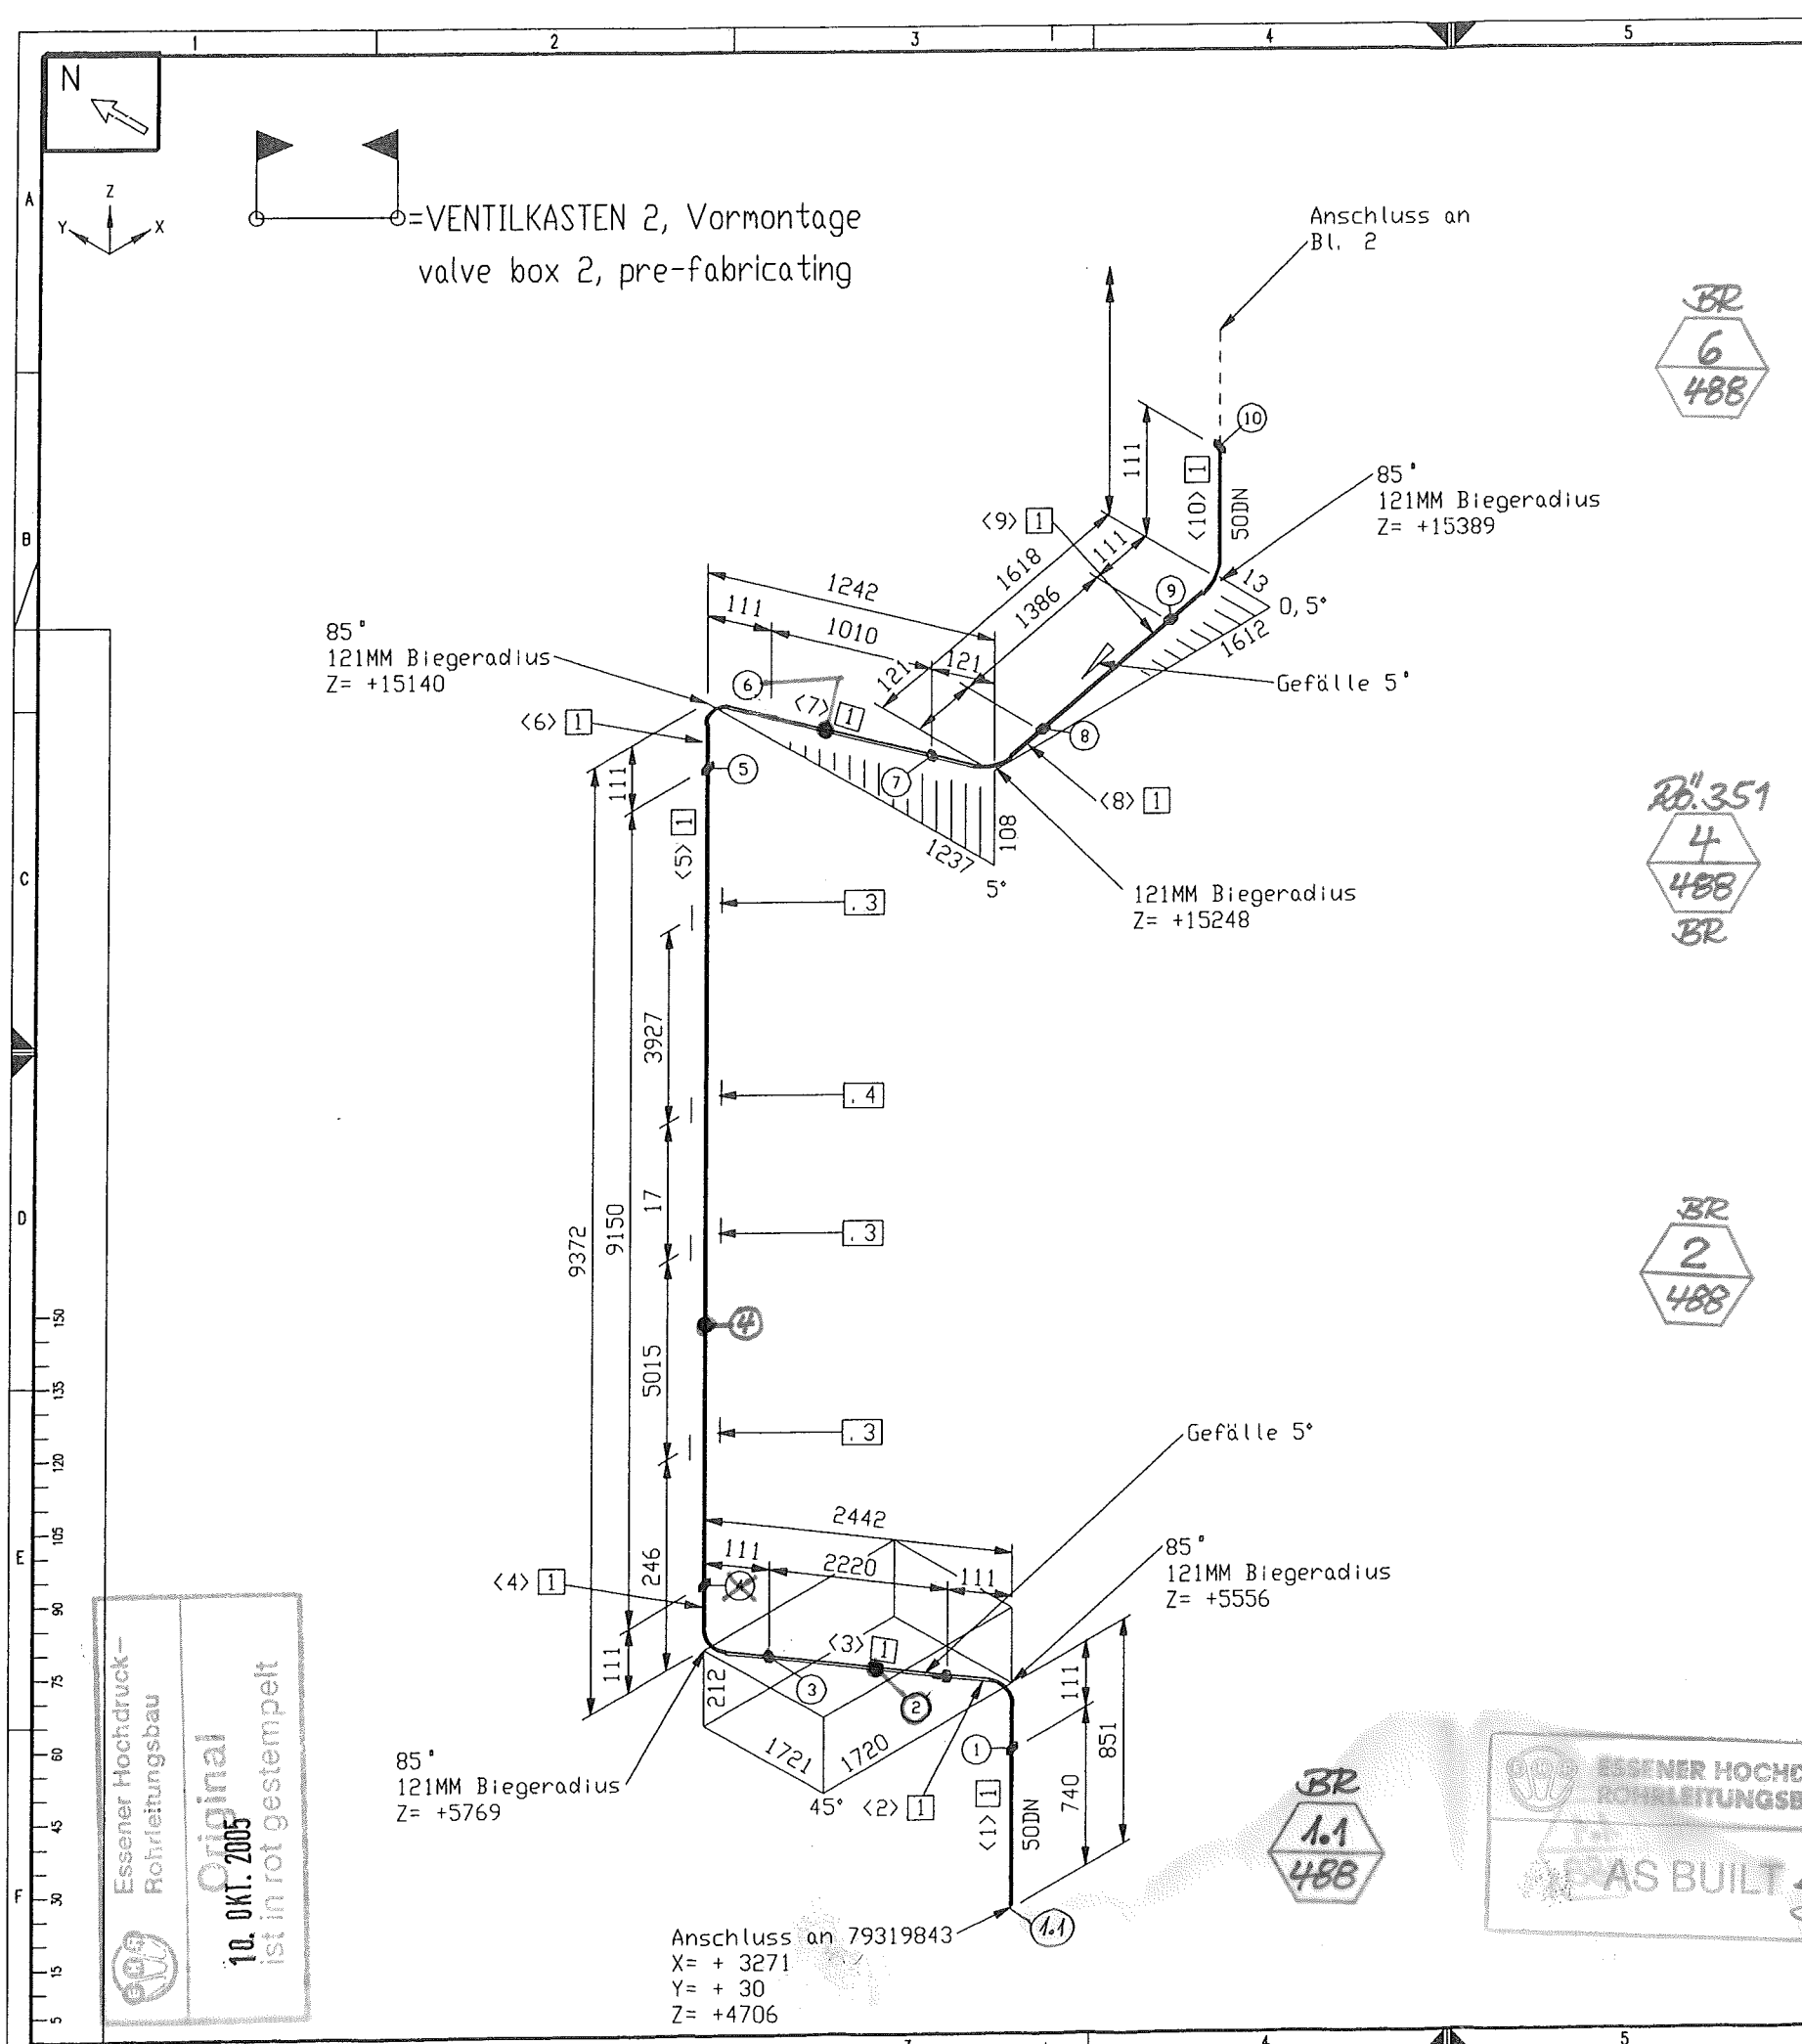

Stückliste

Lfd Nr.	Benennung	DN (MM)	Sachnummer	Menge	Gewicht (kg)
Rohr					
1	ROHR 60,3 X 3,9 ALMG4,5MN W27	50	77038146	29209 28359 MM	52.9
Ventil					
2	Eck-Ventil AL DN 50 / PN 40 Handrad	50	770.38860	1	50.0
Halterung					
3	Rohrführung gezeichnet auf 79319400	50	79319428	3	1.2
4	Rohrhalterung gezeichnet auf 79312892	50	79319419	1	0.3
Summe Masse					104.4

Rohrzuschnitt

Rohr Stk.	Länge (MM)	DN (MM)	Bemerkung	Rohr Ende 1	Rohr Ende 2	Sachnummer
<1>	740	50				77038146
<2>	180	50	PLD BEND<1>			77038146
<3>	2220	50				77038146
<4>	180	50	PLD BEND<1>			77038146
<5>	9150	50				77038146
<6>	180	50	PLD BEND<1>			77038146
<7>	1010	50				77038146
<8>	190	50	PLD BEND<1>			77038146
<9>	1386	50				77038146
<10>	180	50	PLD BEND<1>			77038146
<11>	883	50				77038146
<12>	159	50	PLD BEND<1>			77038146
<13>	32	50	PLD BEND<1>			77038146
<14>	1129	50				77038146
<15>	180	50	PLD BEND<1>			77038146
<16>	1023	50				77038146
<17>	190	50	PLD BEND<1>			77038146
<18>	1532	50				77038146
<19>	179	50	PLD BEND<1>			77038146
<20>	29	50				77038146
<21>	180	50	PLD BEND<1>			77038146
<22>	118	50				77038146
<23>	190	50	PLD BEND<1>			77038146
<24>	103	50				77038146
<25>	190	50	PLD BEND<1>			77038146
<26>	118	50				77038146
<27>	180	50	PLD BEND<1>			77038146
<28>	274	50				77038146
<29>	6000	50				77038146
<30>	190	50	PLD BEND<1>			77038146
<31>	64	50				77038146

piping support, piping guides
 View from top

Rohr DN (MM) 50		CL Länge (MM) 28572	
-----------------	--	---------------------	--

E MATERIAL: HANAU AL D Workpiece edges C 1-0.5 1+0.3 B 1 outside 1 inside A		TOLERANCES: DN 28005 DN 8570 DN 7168 mltl DATE: 15.07.2005 NAME: H.Schneider CHECK: Frickhöfer 15/07/05		All components cleaned for oxygen Simor: Subst.: Replaced:	
ISO-Methode E JOB CODE / REFERENCE: K70101, ASU No.9 Kosice Title: A 21004		AIR LIQUIDE SHEET: 1 OF SHEET: 3 DRAWING No.: 79319826 F Z C		Air Liquide AGS GmbH Hanau	