


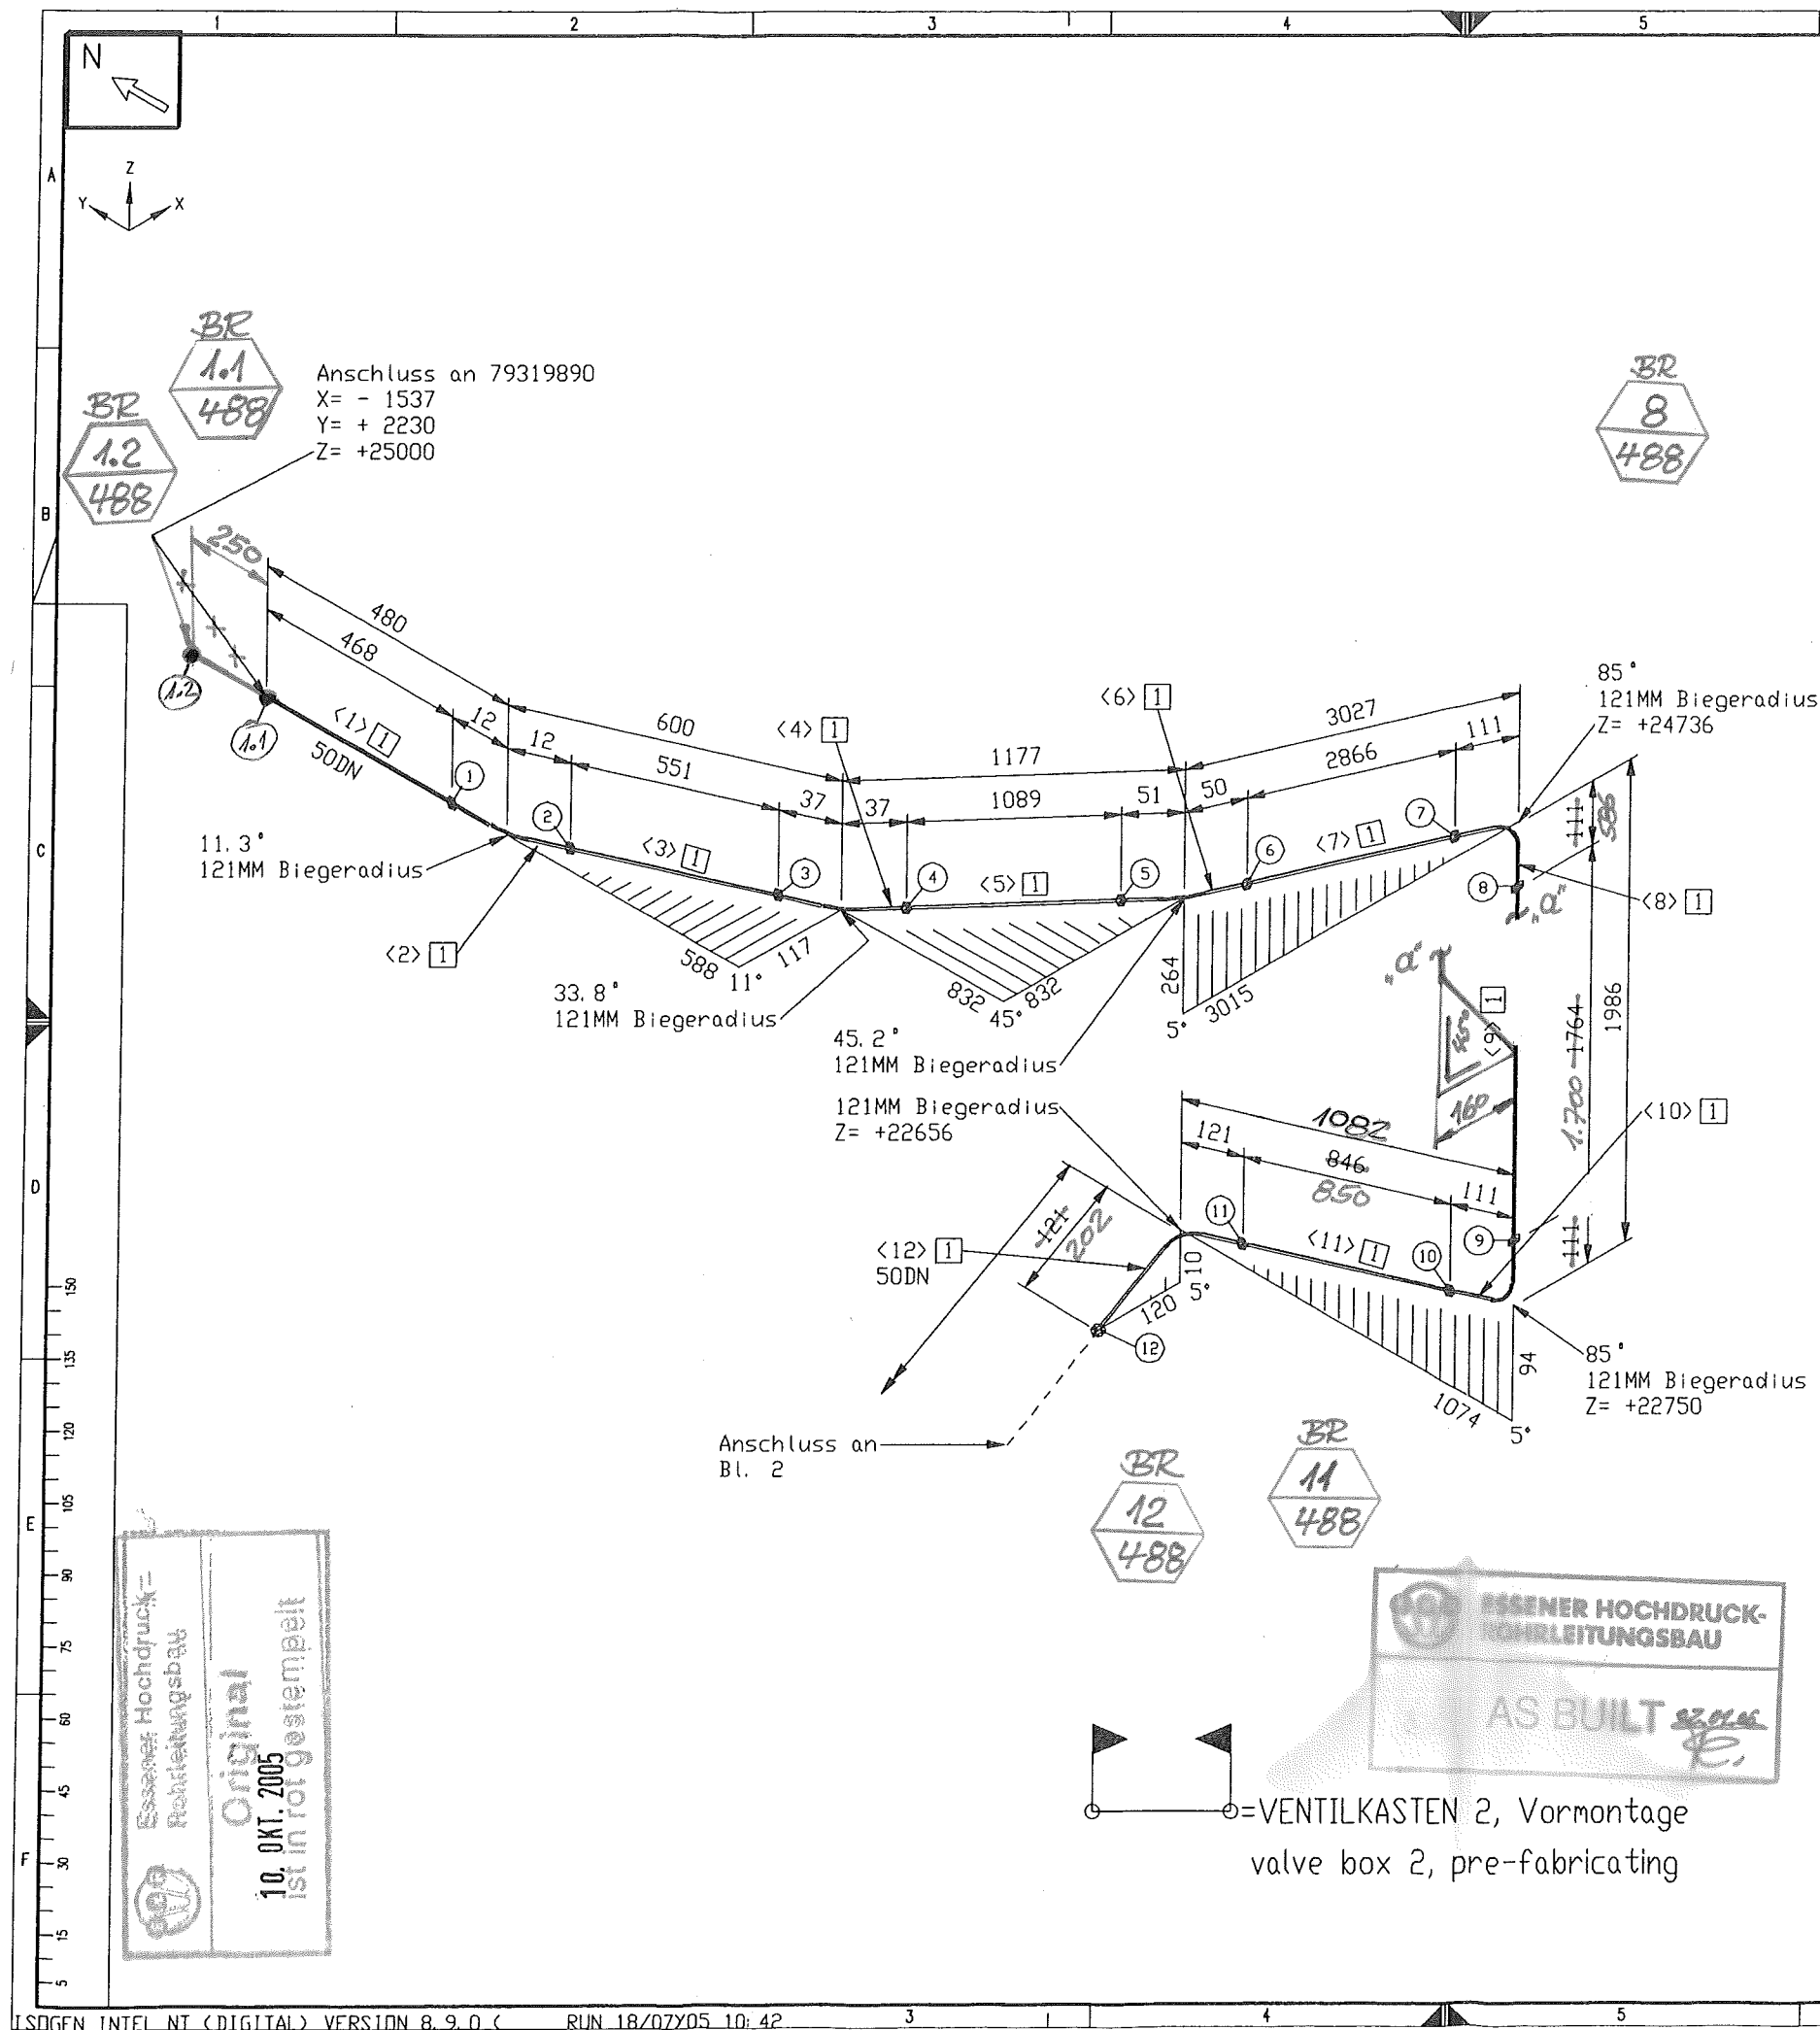

6

7

8

Stückliste

Lfd Nr.	Benennung	DN (MM)	Sachnummer	Menge	Gewicht (kg)
Rohr					
1	ROHR 60,3 X 3,9 ALMG4,5MN W27	50	77038146	32300 MM	60.3
Ventil					
2	Eck-Ventil AL DN 50 / PN 40 Handrad	50	770.38860	1	50.0
Halterung					
3	Rohrhalterung gezeichnet auf 79312892	50	79319419	2	0.6
4	Rohrführung gezeichnet auf 79319400	50	79319421	2	0.8
5	Rohrführung gezeichnet auf 79319400	50	79319428	3	1.2
Summe Masse					112.9

Rohrzuschnitt

Rohr Stk.	Länge (MM)	DN (MM)	Bemerkung	Rohr Ende 1	Rohr Ende 2	Sachnummer
<1>	468	50				77038146
<2>	24	50	PLD BEND<1>			77038146
<3>	551	50				77038146
<4>	72	50	PLD BEND<1>			77038146
<5>	1089	50				77038146
<6>	96	50	PLD BEND<1>			77038146
<7>	2866	50				77038146
<8>	180	50	PLD BEND<1>			77038146
<9>	1764	50				77038146
<10>	180	50	PLD BEND<1>			77038146
<11>	846	50				77038146
<12>	190	50	PLD BEND<1>			77038146
<13>	232	50				77038146
<14>	180	50	PLD BEND<1>			77038146
<15>	3880	50				77038146
<16>	180	50	PLD BEND<1>			77038146
<17>	845	50				77038146
<18>	63	50	PLD BEND<1>			77038146
<19>	316	50				77038146
<20>	180	50	PLD BEND<1>			77038146
<21>	1627	50				77038146
<22>	32	50	PLD BEND<1>			77038146
<23>	159	50	PLD BEND<1>			77038146
<24>	600	50				77038146
<25>	179	50	PLD BEND<1>			77038146
<26>	1410	50				77038146
<27>	190	50	PLD BEND<1>			77038146
<28>	615	50				77038146
<29>	180	50	PLD BEND<1>			77038146
<30>	6000	50				77038146
<31>	3465	50				77038146
<32>	180	50	PLD BEND<1>			77038146
<33>	2570	50				77038146
<34>	180	50	PLD BEND<1>			77038146
<35>	711	50				77038146

pipng support, piping guides

View from top

0°

90°

180°

270°

Rohr DN (MM) 50

CL Länge (MM) 32511

D

C

B

A

1

Rev. No.

Date

By

This drawing is not to be reproduced, copied or used directly or indirectly in any way detrimental to our interests unless specifically authorized in writing by

Air Liquide AGS GmbH Hanau

MATERIAL : HANAU AL

Workpiece edges

+0.3

outside

inside

SCALE

TOLERANCES :
DN 28005
DN 8570
DN 7168 mittel

DATE : 18.07.2005

NAME : H.Schneider

CHECK : Frickhöfer 18/07/05

ISO-Methode E

JOB CODE / REFERENCE :
K70101, ASU No.9 Kosice

Title :
N 21027

All comonents cleaned for oxygen

Similar:

Subst:

Replaced:

AIR LIQUIDE

SHEET : 1

OF SHEET : 3

DRAWING No.: 79319827

F 2

C

6

7

8