



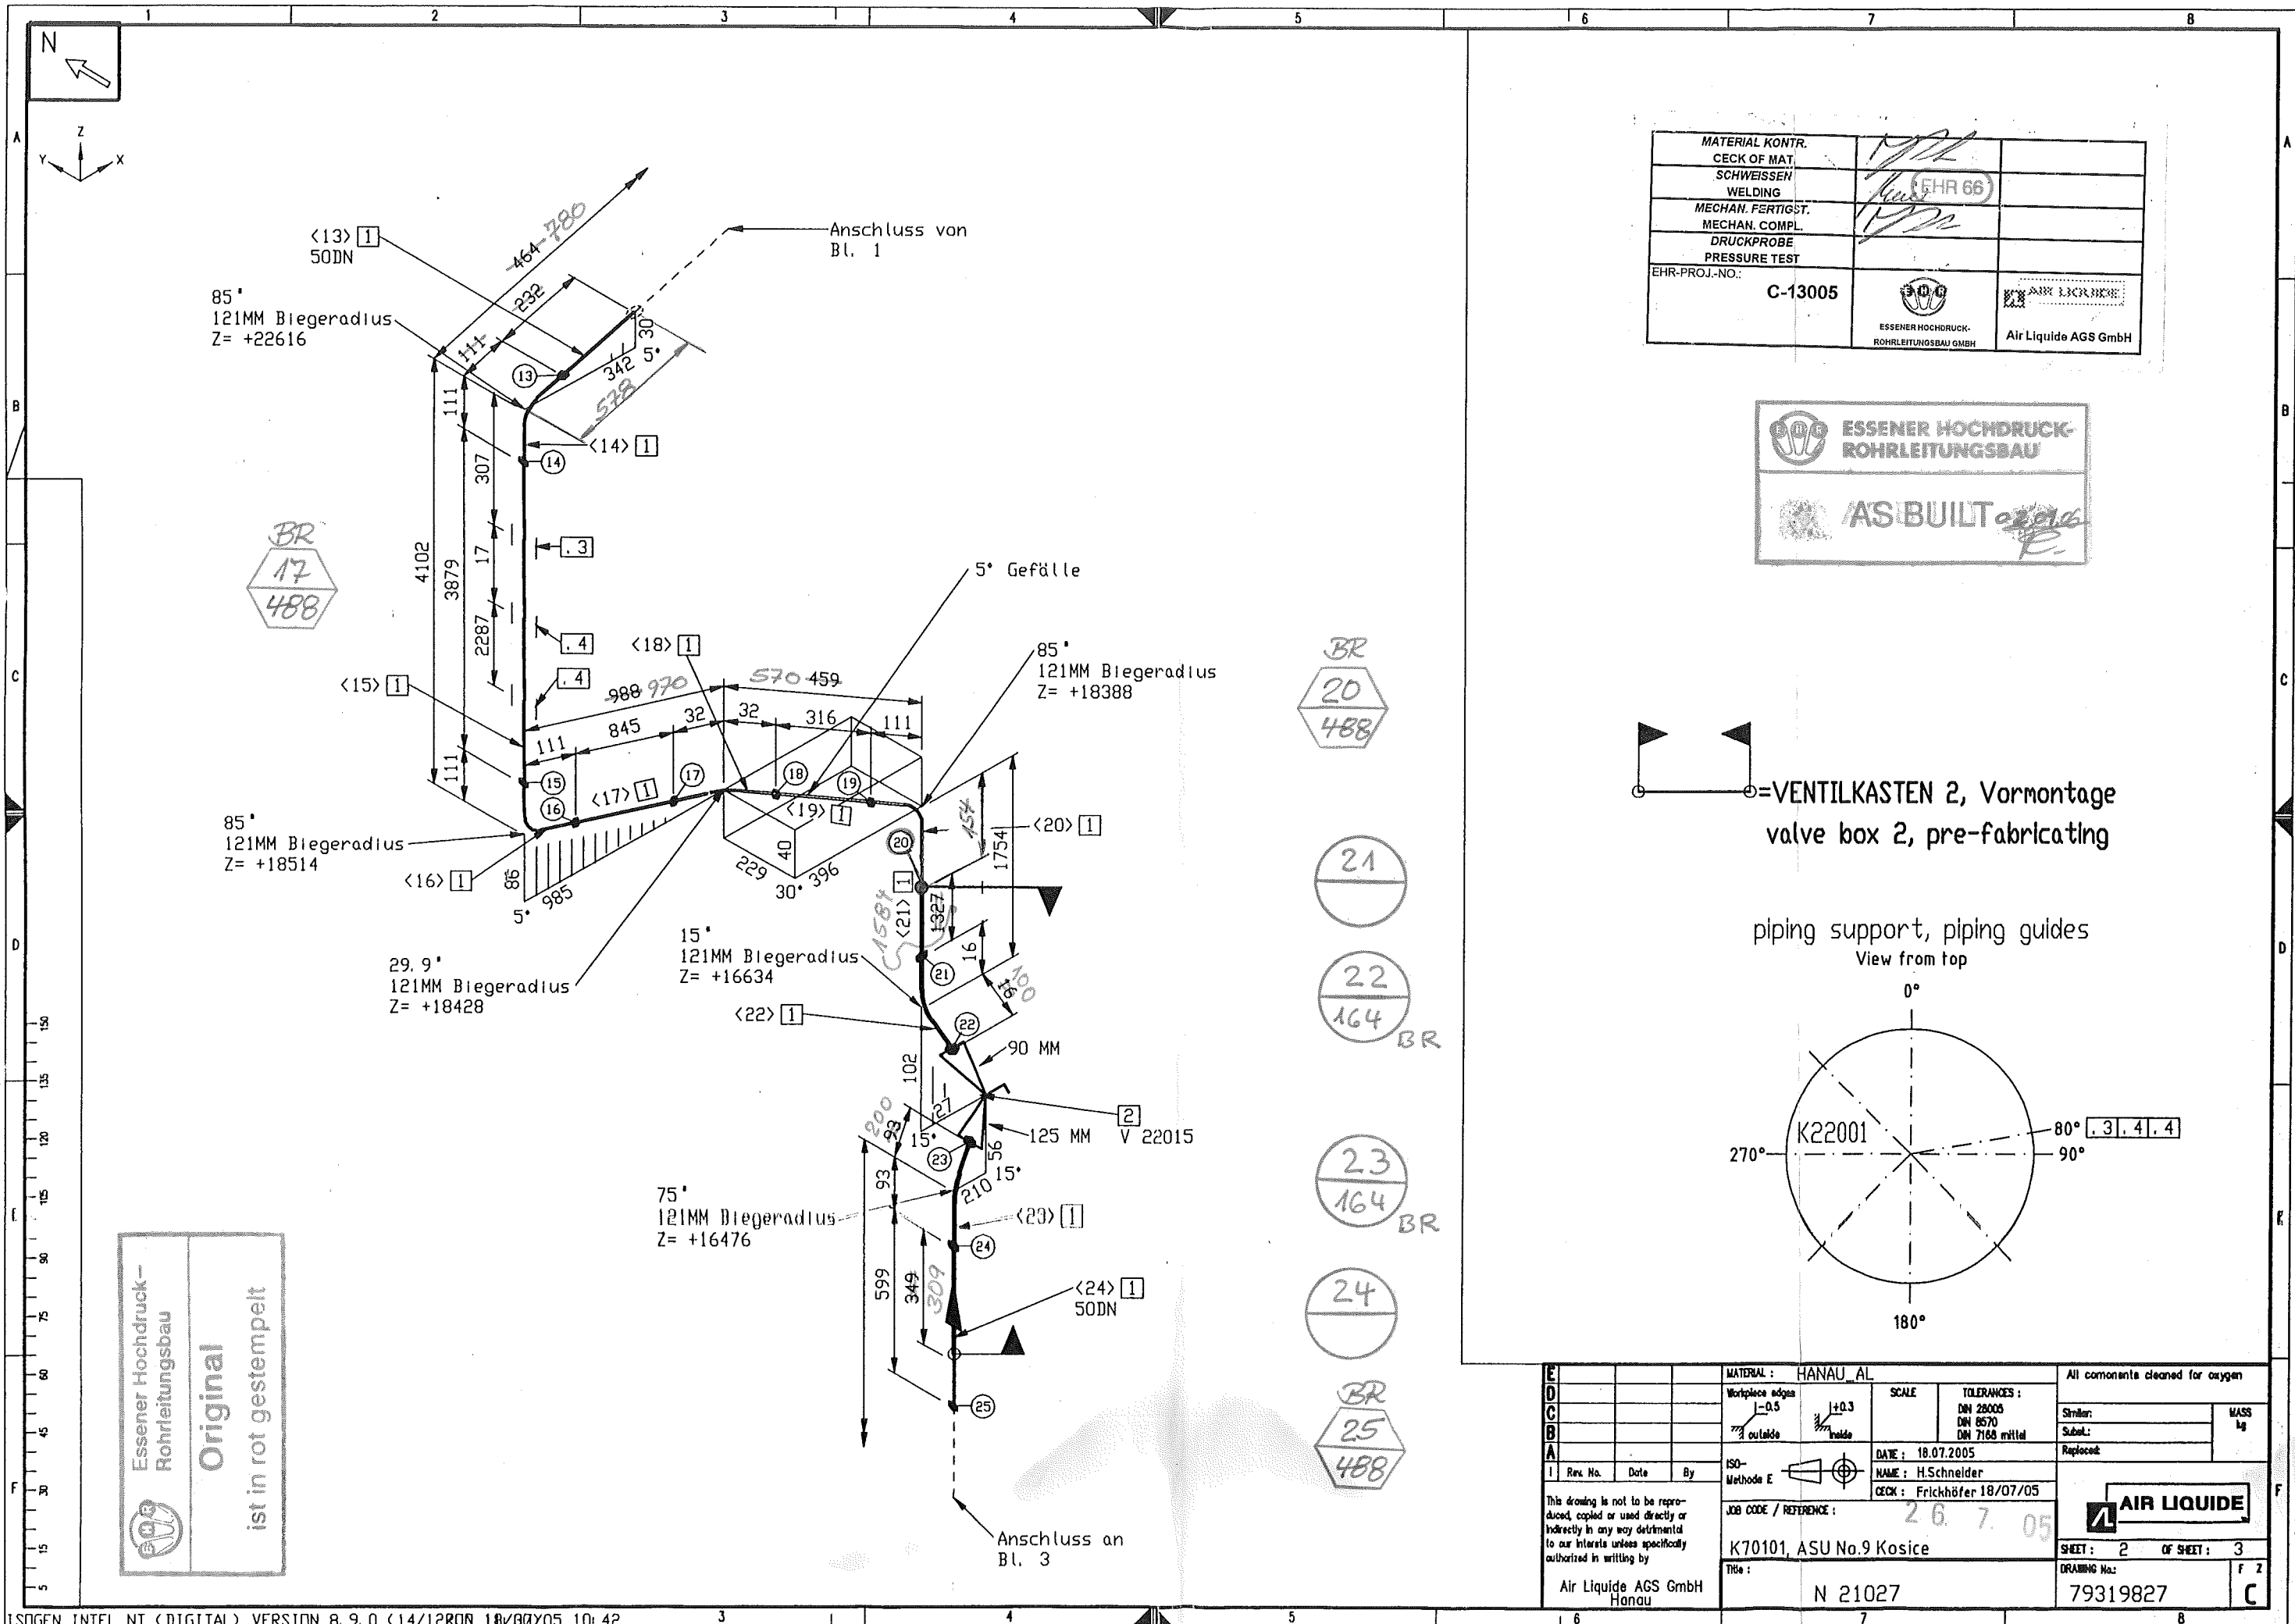


MATERIAL KONTR.		
CHECK OF MAT.		
SCHWEISSEN		
WELDING		
MECHAN. FERTIGST.		
MECHAN. COMPL.		
DRUCKPROBE		
PRESSURE TEST		
EHR-PROJ.-NO.:	C-13005	
	ESSENER HOCHDRUCK- ROHRLEITUNGSBAU GMBH	Air Liquide AGS GmbH

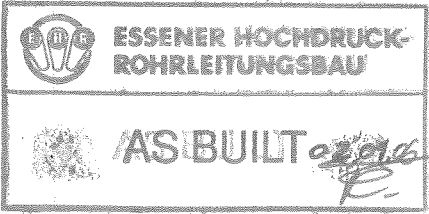

VENTILKASTEN 2, Vormontage
valve box 2, pre-fabricating

piping support, piping guides
View from top

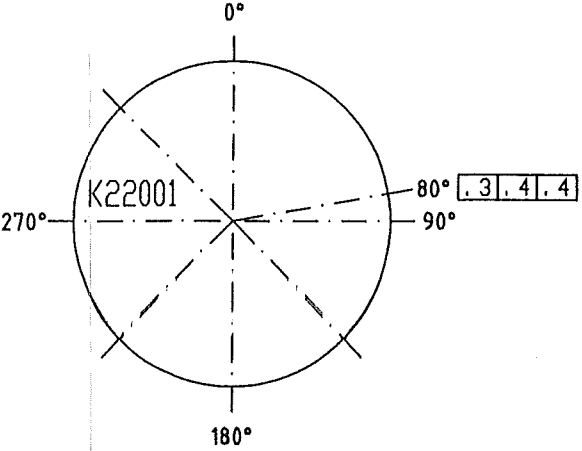

E D C B A				MATERIAL : HANAU AL	All components cleaned for oxygen		
				Workpiece edges  -0.5 outside  +0.3 inside	SCALE	TOLERANCES : DIN 28005 DIN 8570 DIN 7168 mittel	Simlar: MASS kg
				ISO- Methode E 	DATE : 18.07.2005	Replaced:	
					NAME : H.Schneider		
1 Rev. No. Date By				CHECK : Frickhöfer 18/07/05			
This drawing is not to be reproduced, copied or used directly or indirectly in any way detrimental to our interests unless specifically authorized in writing by Air Liquide AGS GmbH Hanau				JOB CODE / REFERENCE : K70101, ASU No.9 Kosice	AIR LIQUIDE		
				SHEET : 2 OF SHEET : 3			
				DRAWING No.: 79319827			
Title : N 21027				f 2 C			